


**SECTION A-A**  
NO SCALE

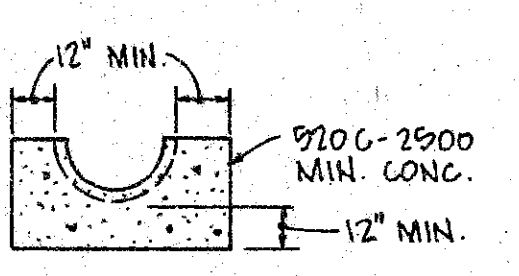

**SECTION B-B**  
NO SCALE

**NOTE:**  
THE LOCATION OF EXISTING IRRIGATION LINES & CONTROLS SHALL BE FIELD VERIFIED BEFORE THE COMMENCEMENT OF ANY GRADING. RELOCATION OF THE EXISTING SYSTEM SHALL BE COMPLETE BEFORE GRADING. DISCREPANCIES SHALL BE BROUGHT TO THE ATTENTION OF THE CIVIL ENGINEER AND LANDSCAPE ARCHITECT. THE EXISTING IRRIGATION SYSTEM SHALL BE KEPT SEPARATE FROM THE PROPOSED IRRIGATION SYSTEM FOR THE OFFICE / STORAGE BUILDING.

A-1  
1-29-90  
AS-BUILT SURVEY

SCALE: 1" = 10' POZZO CONSTRUCTION CO.

<b>PRIVATE CONTRACT</b>	
SHEET 3	CITY OF OCEANSIDE 5 SHEETS
PRECISE GRADING & PRIVATE IMPROVEMENT PLANS FOR:	
<b>TRI-CITY HOSPITAL WAREHOUSE-OFFICE BUILDING</b>	
CALIFORNIA COORDINATE INDEX 372-1692 D-49-88	
CITY ENGINEER DATE: 6-22-87 RONALD A. BECKMAN P.C.E. 17911	ENGINEER OF WORK MICHAEL A. WUNDERLIN P.C.E. 80971
CHECKED BY: APPROVAL DATE:	1344

CITY APPROVED CHANGES			
NO	DESCRIPTION	APPROVED BY	DATE
1	REMOVE D-19 DITCH, ADD D-29 CURB OUTLET, ADD G-29 PEDESTRIAN RAMP	Joe	12/18/89