

TCMC OBSERVATION ROOM

TRI-CITY MEDICAL CENTER

4002 VISTA WAY
OCEANSIDE,
CALIFORNIA 92056



100% CONSTRUCTION DOCUMENTS
09/22/16

△1 OSHPD COMMENTS
01/18/2017

△2 DESIGN CHANGES
01/18/2017

△3 OSHPD COMMENTS
04/20/2017

△4 OSHPD COMMENTS
06/14/2017

STRUCTURAL:

SUN STRUCTURAL ENGINEERING

2091 Las Palmas Drive, Suite D
Carlsbad, CA 92011


P: 760-438-1188

ARCHITECTURE:

S F E I R
A R C H I T E C T S

1350 Columbia Street, Suite 603
San Diego, CA 92101

P: 619-299-3917
F: 619-299-5084
www.sfeirarch.com

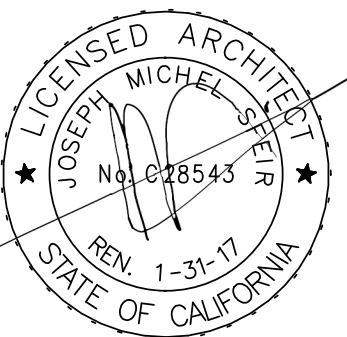

OSHPD PROJECT NUMBER:

S162581-37-00

MEP:

P2S ENGINEERING, INC.

9265 CHESAPEAKE DRIVE, SUITE 230
San Diego, CA 92123

P: 619-618-2347
F: 619-330-0668



07/06/2017 10:48:54 AM
#[S162581-37-00]

TCMC OBSERVATION ROOM

TRI-CITY MEDICAL
CENTER
4002 VISTA WAY
OCEANSIDE, CALIFORNIA
92056

OWNER: TRI-CITY MEDICAL CENTER
4002 VISTA WAY
OCEANSIDE, CALIFORNIA 92056
TEL(760)724-8411

ARCHITECT: SFEIR ARCHITECTS
1350 COLUMBIA STREET, SUITE 603
SAN DIEGO, CALIFORNIA 92101
TEL(619)299-3917 FAX(619)299-5084

STRUCTURAL: SUN STRUCTURAL ENGINEERING, INC.
2091 LAS PALMAS DRIVE, SUITE D
CARLSBAD, CALIFORNIA 92011
TEL(760)438-1188

ME&P: P2S
9665 CHESAPEAKE, SUITE 230
SAN DIEGO, CALIFORNIA 92123
TEL(619)618-2347

1	OSHDP COMMENTS 01/18/2017
2	DESIGN CHANGES 01/18/2017
3	OSHDP COMMENTS 04/20/2017
4	OSHDP COMMENTS 06/14/2017
REV: DESCRIPTION: DATE:	
CONSULTANT	

OSHDP APPROVAL STAMP:
OSHDP #: S162581-37-00



SHEET TITLE:
SITE - ZONING - CODE

PROJECT TITLE:
TCMC OBSERVATION ROOM

PROJECT #
01643.00

DRAWN BY:
Author

CHECKED BY:
Checker

SCALE:
As indicated

DATE:
10/11/16

SHEET NUMBER:
A1-00

GENERAL NOTES:

- THE GENERAL CONTRACTOR SHALL VERIFY ALL EXISTING CONDITIONS AND MEASUREMENTS IN THE FIELD PRIOR TO STARTING CONSTRUCTION.
- REFER TO GENERAL NOTES ON SHEET A0-00 FOR INFORMATION NOT INDICATED ON THIS SHEET.

PARTITION LEGEND:


- ACCESSIBLE PATH OF TRAVEL.
- EGRESS PATH OF TRAVEL.
- ONE-HOUR RATED CORRIDOR.
- INDICATES AN EXISTING MEMBRANE OF PARTITION OR PARTITION TO BE REMOVED. REFER TO DEMOLITION PLAN FOR FURTHER REQUIREMENTS.
- INDICATES AN EXISTING PARTITION TO REMAIN. REFER TO PLAN FOR UPGRADE REQUIREMENTS.
- INDICATES AN EXISTING 1 HOUR SMOKE BARRIER
- INDICATES AN EXISTING SMOKE PARTITION
- INDICATES AN EXISTING ONE HOUR FIRE RATED PARTITION TO REMAIN. ALL PENETRATIONS SHALL BE PROTECTED WITH A U.L LISTED FIRE STOP SYSTEM.
- INDICATES AN EXISTING ONE HOUR RATED FIRE BARRIER TO REMAIN. ALL PENETRATIONS SHALL BE PROTECTED WITH A U.L LISTED FIRE STOP SYSTEM.
- INDICATES AN EXISTING TWO HOUR RATED FIRE BARRIER TO REMAIN. ALL PENETRATIONS SHALL BE PROTECTED WITH A U.L LISTED FIRE STOP SYSTEM.
- INDICATES A NEW SMOKE BARRIER
- INDICATES A NEW SMOKE PARTITION
- INDICATES A NEW ONE HOUR RATED FIRE PARTITION EXTENDING TO THE UNDERSIDE OF THE STRUCTURE ABOVE. ALL PENETRATIONS SHALL BE PROTECTED WITH A U.L LISTED FIRE STOP SYSTEM.
- INDICATES A NEW ONE HOUR RATED FIRE BARRIER EXTENDING TO THE UNDERSIDE OF THE STRUCTURE ABOVE. ALL PENETRATIONS SHALL BE PROTECTED WITH A U.L LISTED FIRE STOP SYSTEM.
- THICK LINE INDICATES NEW SURFACE FINISH.
- INDICATES AN EXISTING STRUCTURAL CONCRETE WALL TO REMAIN. LOCATE REINFORCING STEEL AND OBTAIN APPROVAL FROM STRUCTURAL ENGINEER PRIOR TO CORING AND/ OR CUTTING.
- WALL TYPE REFERENCE REFER TO SHEET A5-00.

PARTITION NOTES:

- ALL DIMENSIONS SHOWN ARE TO FINISHED FACE OF GYP. BOARD. TYPICAL U.O.N. REFER TO SHEET A5-00 FOR GENERAL NOTES AND REQUIREMENTS FOR PARTITIONS.
- EXISTING WALL'S WERE CONSTRUCTED WITH MANY PERMITS AND/OR CONTRACTS. FIELD VERIFY CONSTRUCTION AND WIDTH PRIOR TO FABRICATION OF DOOR FRAMES OR COMPONENTS WHICH REQUIRE THE WIDTH OF WALL TO BE SET.

1 SITE PLAN
1" = 60'-0"



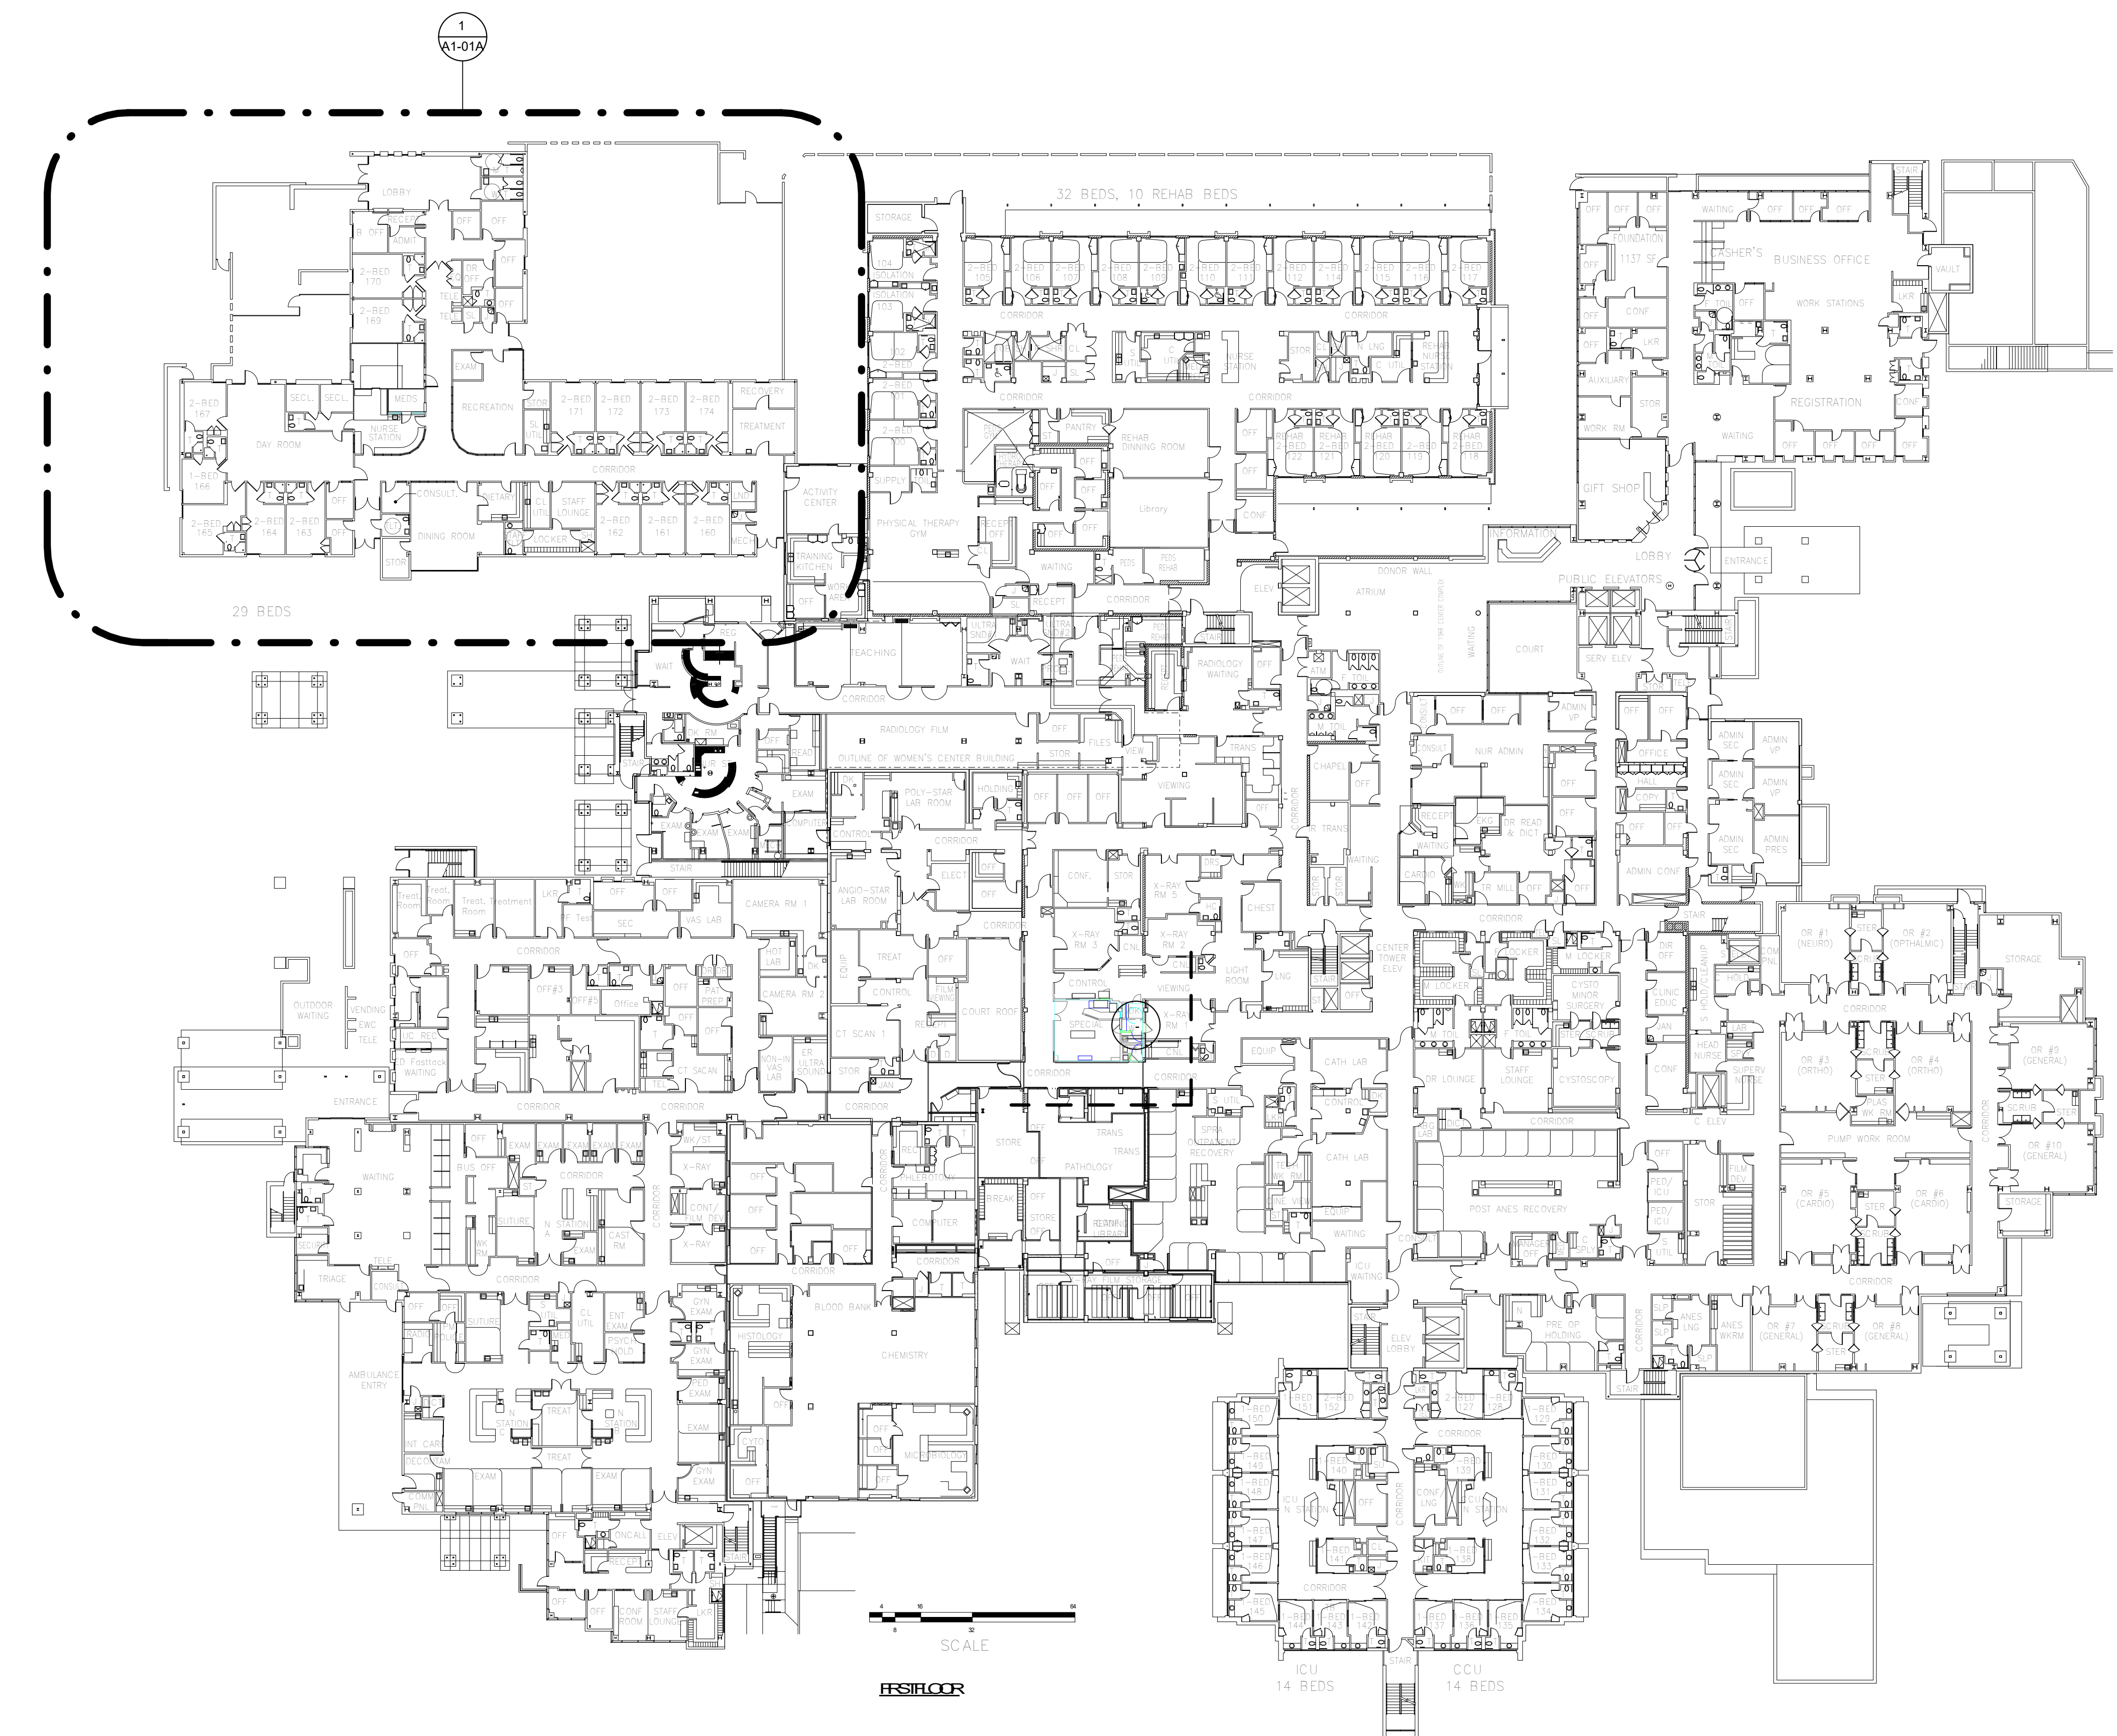

1 OVERALL FIRST FLOOR PLAN
1" = 30'-0"

GENERAL NOTES:

1. THE GENERAL CONTRACTOR SHALL VERIFY ALL EXISTING CONDITIONS AND MEASUREMENTS IN THE FIELD PRIOR TO STARTING CONSTRUCTION.
2. REFER TO GENERAL NOTES ON SHEET A0-00 FOR INFORMATION NOT INDICATED ON THIS SHEET.

PARTITION LEGEND:

- ACCESSIBLE PATH OF TRAVEL.
- - - → EGRESS PATH OF TRAVEL.
- [Pattern] ONE-HOUR RATED CORRIDOR.
- - - - - INDICATES AN EXISTING MEMBRANE OF PARTITION OR PARTITION TO BE REMOVED. REFER TO DEMOLITION PLAN FOR FURTHER REQUIREMENTS.
- - - - - INDICATES AN EXISTING PARTITION TO REMAIN. REFER TO PLAN FOR UPGRADE REQUIREMENTS.
- SB - - - - - SB - INDICATES AN EXISTING 1 HOUR SMOKE BARRIER
- SP - - - - - SP - INDICATES AN EXISTING SMOKE PARTITION
- FP - - - - - FP - INDICATES AN EXISTING ONE HOUR FIRE RATED PARTITION TO REMAIN. ALL PENETRATIONS SHALL BE PROTECTED WITH A U.L LISTED FIRE STOP SYSTEM.
- FB - - - - - FB - INDICATES AN EXISTING ONE HOUR RATED FIRE BARRIER TO REMAIN. ALL PENETRATIONS SHALL BE PROTECTED WITH A U.L LISTED FIRE STOP SYSTEM.
- FB - - - - - FB - INDICATES AN EXISTING TWO HOUR RATED FIRE BARRIER TO REMAIN. ALL PENETRATIONS SHALL BE PROTECTED WITH A U.L LISTED FIRE STOP SYSTEM.
- SB - - - - - SB - INDICATES A NEW SMOKE BARRIER
- SP - - - - - SP - INDICATES A NEW SMOKE PARTITION
- FP - - - - - FP - INDICATES A NEW ONE HOUR RATED FIRE PARTITION EXTENDING TO THE UNDERSIDE OF THE STRUCTURE ABOVE. ALL PENETRATIONS SHALL BE PROTECTED WITH A U.L LISTED FIRE STOP SYSTEM.
- FB - - - - - FB - INDICATES A NEW ONE HOUR RATED FIRE BARRIER EXTENDING TO THE UNDERSIDE OF THE STRUCTURE ABOVE. ALL PENETRATIONS SHALL BE PROTECTED WITH A U.L LISTED FIRE STOP SYSTEM.
- THICK LINE INDICATES NEW SURFACE FINISH.
- [Pattern] INDICATES AN EXISTING STRUCTURAL CONCRETE WALL TO REMAIN. LOCATE REINFORCING STEEL AND OBTAIN APPROVAL FROM STRUCTURAL ENGINEER PRIOR TO CORING AND/ OR CUTTING.
- [X] WALL TYPE REFERENCE REFER TO SHEET A5-00.

PARTITION NOTES:

1. ALL DIMENSIONS SHOWN ARE TO FINISHED FACE OF GYP. BOARD, TYPICAL U.O.N. REFER TO SHEET A5-00 FOR GENERAL NOTES AND REQUIREMENTS FOR PARTITIONS.
2. EXISTING WALL'S WERE CONSTRUCTED WITH MANY PERMITS AND/OR CONTRACTS. FIELD VERIFY CONSTRUCTION AND WIDTH PRIOR TO FABRICATION OF DOOR FRAMES OR COMPONENTS WHICH REQUIRE THE WIDTH OF WALL TO BE SET.

S F E I R ARCHITECTS

1350 Columbia Street, Suite 603
San Diego, CA 92101

P: 619-299-3917
F: 619-299-5084
www.sfeirarch.com

TCMC OBSERVATION ROOM


TRI-CITY MEDICAL CENTER 4002 VISTA WAY OCEANSIDE, CALIFORNIA 92056

OWNER: TRI-CITY MEDICAL CENTER
4002 VISTA WAY
OCEANSIDE, CALIFORNIA 92056
TEL(760)724-8411

ARCHITECT: SFEIR ARCHITECTS
1350 COLUMBIA STREET, SUITE 603
SAN DIEGO, CALIFORNIA 92101
TEL(619)299-3917 FAX(619)299-5084

STRUCTURAL: SUN STRUCTURAL ENGINEERING, INC.
2091 LAS PALMAS DRIVE, SUITE D
CARLSBAD, CALIFORNIA 92011
TEL(760)438-1188

ME&P: P2S
9665 CHESAPEAKE, SUITE 230
SAN DIEGO, CALIFORNIA 92123
TEL(619)618-2347

		
1	OSHPD COMMENTS	01/18/2017
2	DESIGN CHANGES	01/18/2017
3	OSHPD COMMENTS	04/20/2017
4	OSHPD COMMENTS	06/14/2017

REV: DESCRIPTION: DATE:

CONSULTANT

OSHPD APPROVAL STAMP:
OSHPD #: S162581-37-00



REVIEWED IN ACCORDANCE WITH
THE REQUIREMENTS OF T24, CCR

APPROVED

Laura Baldrati, Sr. Architect

Office of Statewide Health
Planning & Development

FACILITIES DEVELOPMENT DIVISION

SHEET TITLE:
OVERALL FIRST FLOOR
PLAN

PROJECT TITLE:
TCMC OBSERVATION ROOM

PROJECT #
01643.00

DRAWN BY:
Author

CHECKED BY:
Checker

SCALE:
As indicated

DATE:
10/11/16

SHEET NUMBER:
A1-01



DEMOLITION KEYNOTES:

- 1

REMOVE EXISTING PARTITION.
- 2

REMOVE EXISTING DOOR AND DOOR FRAME.
- 3

REMOVE EXISTING COUNTERTOP, BACKSPLASH, BASE & OVERHEAD CABINETS & SALVAGE.
- 4

REMOVE EXISTING PLUMBING FIXTURE.
- 5

REMOVE EXISTING FLOOR TILE, MORTAR BED & FLOOR DRAIN.
- 6

REMOVE EXISTING FLOOR FINISH & BASE.
- 7

TEMPORARILY REMOVE EXISTING WINDOW FOR CONSTRUCTION ACCESS AND EXHAUST FILTERED CONSTRUCTION DUCT. CLOSE OFF OPENING SECURELY WITH PLYWOOD AT THE END OF EVERY DAY.
- 8

1 HOUR RATED TEMPORARY GYPSUM WALL BOARD PARTITION FROM FLOOR TO UNDERSIDE OF PARTITION ABOVE AND 20 MINUTE RATED TEMPORARY DOOR. TEMPORARY CONSTRUCTION BARRIER IS TO MEET THE REQUIREMENTS OF OSHPD CAN 9-3301.

- 9

INFECTION CONTROL VISQUEEN SHEETING WITH ZIPPER. TEMPORARY CONSTRUCTION BARRIER IS TO MEET THE REQUIREMENTS OF OSHPD CAN 9-3301.
- 10

REMOVE GWB FROM EXISTING PARTITION IN ITS ENTIRETY.
- 11

REMOVE PORTION OF EXISTING PARTITION FOR NEW WINDOW.
- 12

REMOVE EXISTING PUSH-BUTTON NURSE CALL & SALVAGE.
- 13

REMOVE EXISTING NURSE CALL.
- 14

SAWCUT EXISTING SLAB TO INSTALL NEW WASTE LINE.
- 15

ADD VISQUEEN SHEETING FROM TOP OF CEILING TO UNDERSIDE OF DECK ABOVE DURING CONSTRUCTIONTEMPORARY CONSTRUCTION BARRIER IS TO MEET THE REQUIREMENTS OF OSHPD CAN 9-3301.
- 16

REMOVE EXISTING FLOOR FINISH AS REQUIRED FOR WORK TO EXISTING CORRIDOR PARTITION.


PARTITION LEGEND:

- ACCESSIBLE PATH OF TRAVEL.
- EGRESS PATH OF TRAVEL.
- ONE-HOUR RATED CORRIDOR.
- INDICATES AN EXISTING MEMBRANE OF PARTITION OR PARTITION TO BE REMOVED. REFER TO DEMOLITION PLAN FOR FURTHER REQUIREMENTS.
- INDICATES AN EXISTING PARTITION TO REMAIN. REFER TO PLAN FOR UPGRADE REQUIREMENTS.
- INDICATES AN EXISTING 1 HOUR SMOKE BARRIER
- INDICATES AN EXISTING SMOKE PARTITION
- INDICATES AN EXISTING ONE HOUR FIRE RATED PARTITION TO REMAIN. ALL PENETRATIONS SHALL BE PROTECTED WITH A U.L LISTED FIRE STOP SYSTEM.
- INDICATES AN EXISTING ONE HOUR RATED FIRE BARRIER TO REMAIN. ALL PENETRATIONS SHALL BE PROTECTED WITH A U.L LISTED FIRE STOP SYSTEM.
- INDICATES AN EXISTING TWO HOUR RATED FIRE BARRIER TO REMAIN. ALL PENETRATIONS SHALL BE PROTECTED WITH A U.L LISTED FIRE STOP SYSTEM.
- INDICATES A NEW SMOKE BARRIER
- INDICATES A NEW SMOKE PARTITION
- INDICATES A NEW ONE HOUR RATED FIRE PARTITION EXTENDING TO THE UNDERSIDE OF THE STRUCTURE ABOVE. ALL PENETRATIONS SHALL BE PROTECTED WITH A U.L LISTED FIRE STOP SYSTEM.
- INDICATES A NEW ONE HOUR RATED FIRE BARRIER EXTENDING TO THE UNDERSIDE OF THE STRUCTURE ABOVE. ALL PENETRATIONS SHALL BE PROTECTED WITH A U.L LISTED FIRE STOP SYSTEM.
- THICK LINE INDICATES NEW SURFACE FINISH.
- INDICATES AN EXISTING STRUCTURAL CONCRETE WALL TO REMAIN. LOCATE REINFORCING STEEL AND OBTAIN APPROVAL FROM STRUCTURAL ENGINEER PRIOR TO CORING AND/ OR CUTTING.
- X

WALL TYPE REFERENCE REFER TO SHEET A5-00.

PARTITION NOTES:

1. ALL DIMENSIONS SHOWN ARE TO FINISHED FACE OF GYP. BOARD, TYPICAL U.O.N. REFER TO SHEET A5-00 FOR GENERAL NOTES AND REQUIREMENTS FOR PARTITIONS.
2. EXISTING WALL'S WERE CONSTRUCTED WITH MANY PERMITS AND/OR CONTRACTS. FIELD VERIFY CONSTRUCTION AND WIDTH PRIOR TO FABRICATION OF DOOR FRAMES OR COMPONENTS WHICH REQUIRE THE WIDTH OF WALL TO BE SET.

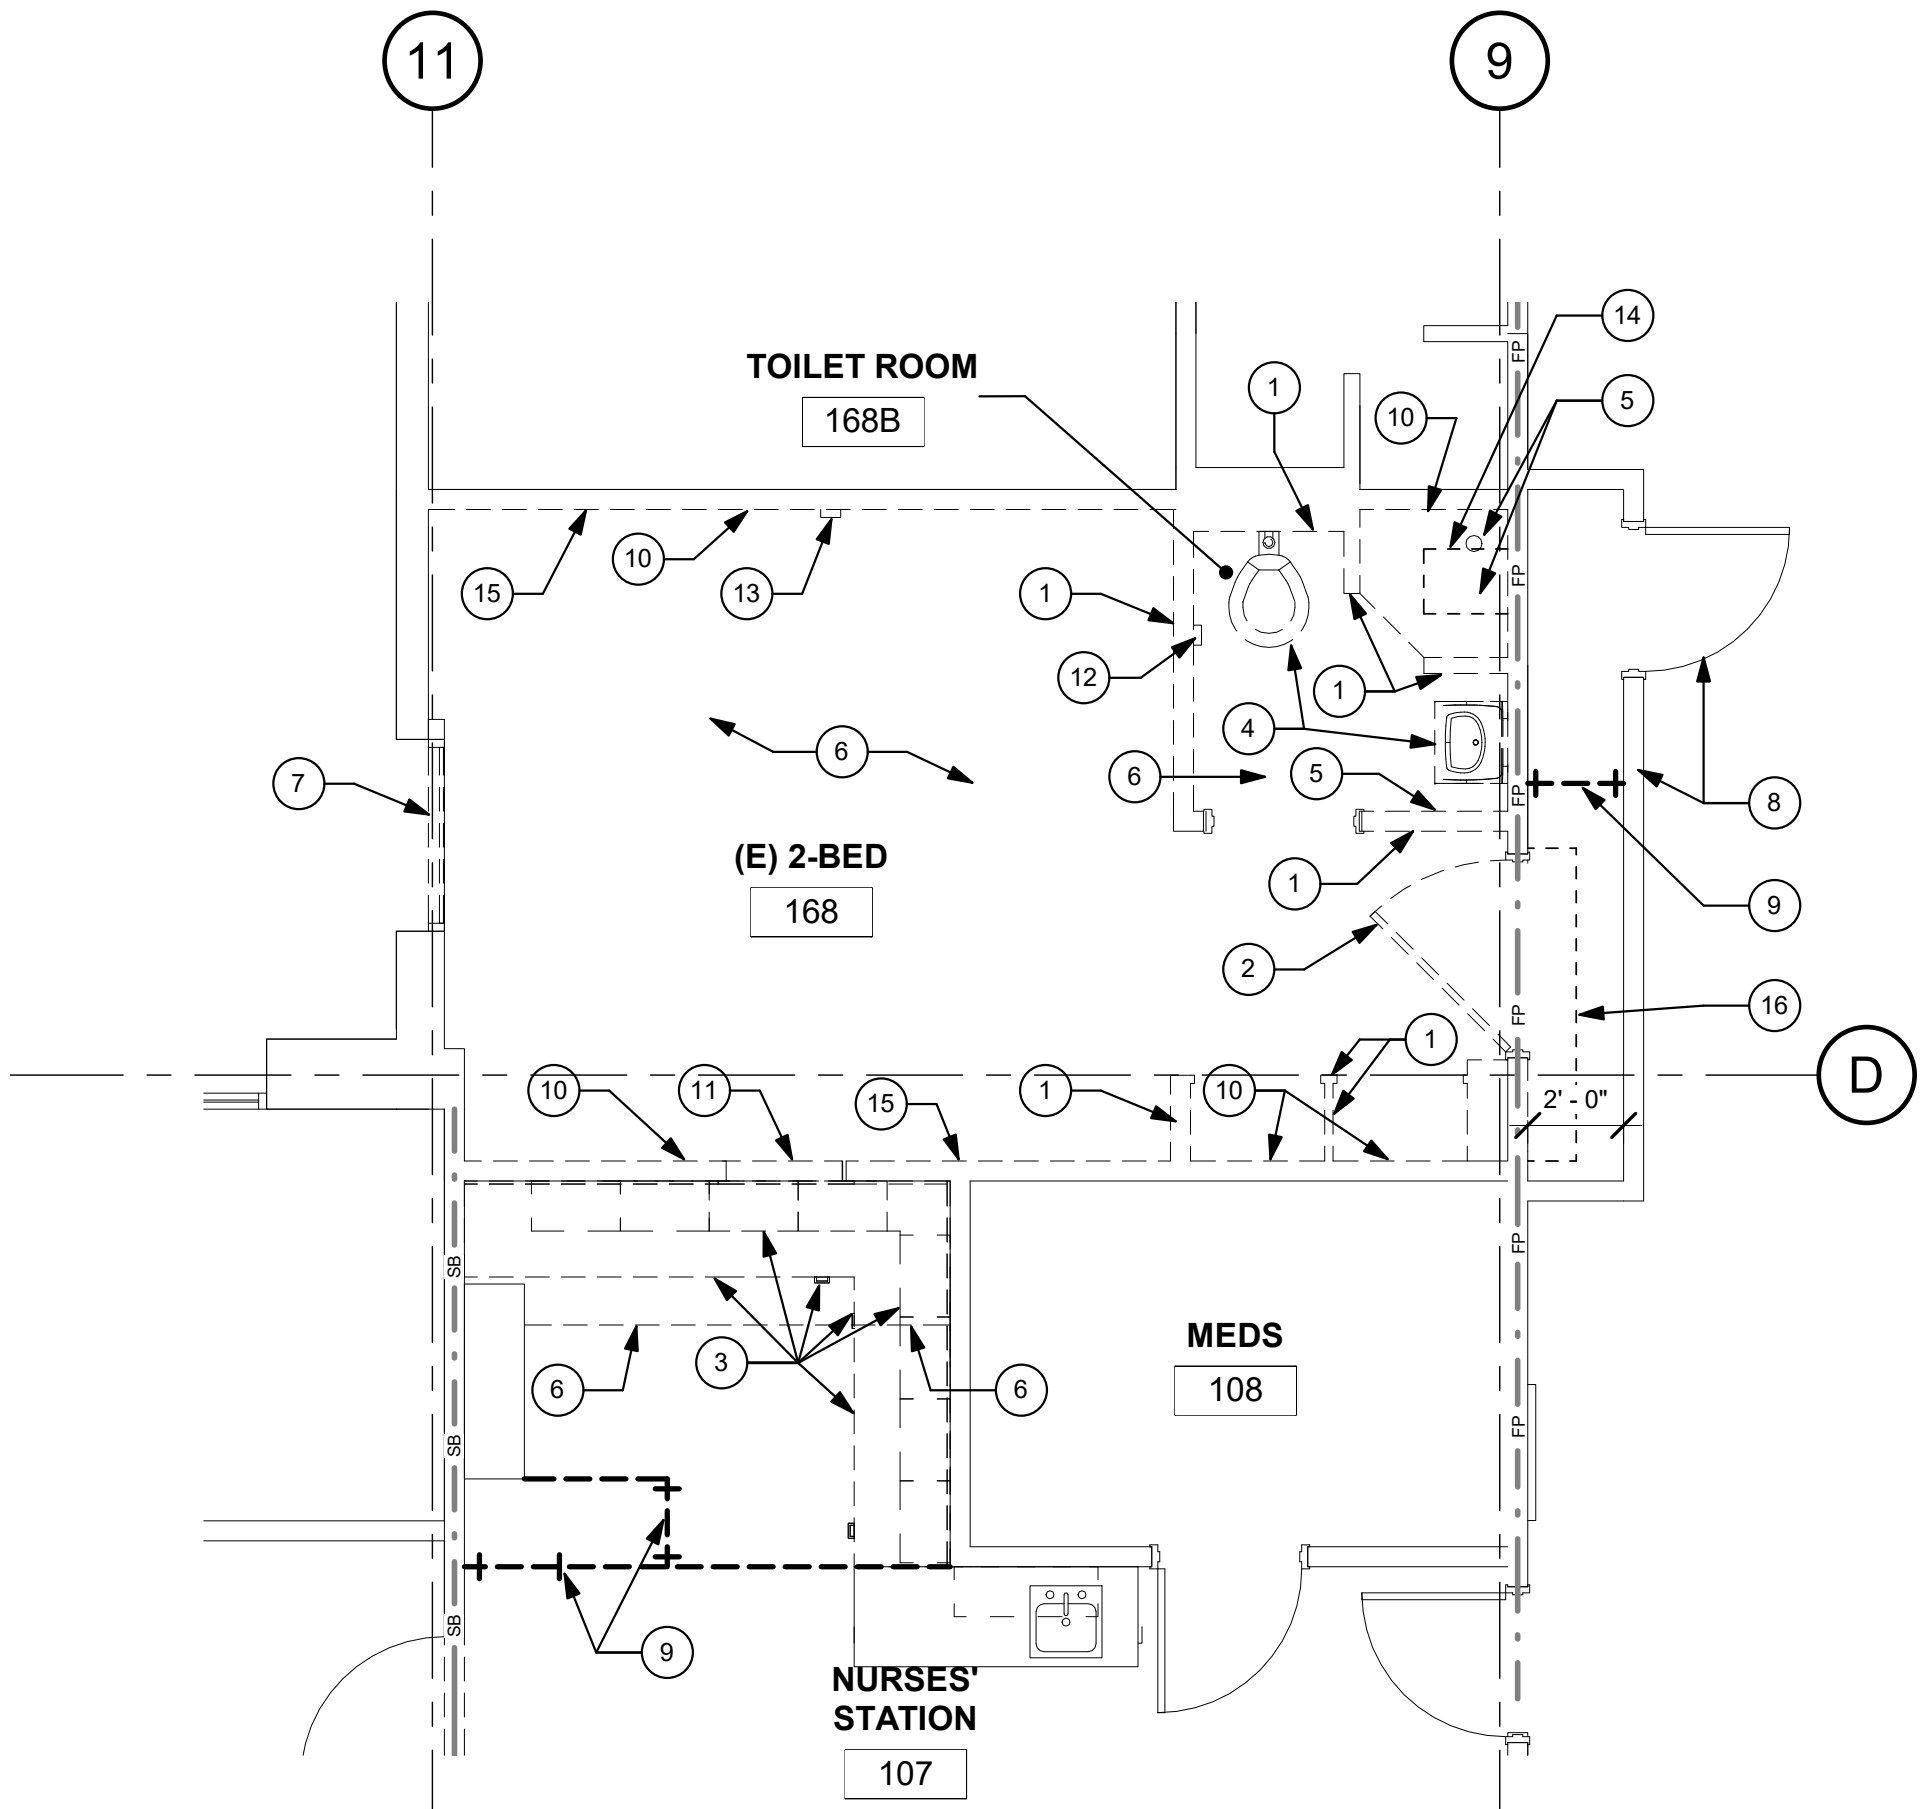

1 FIRST LEVEL DEMOLITION PLAN
1/4" = 1'-0"

GENERAL NOTES:

1. THE GENERAL CONTRACTOR SHALL VERIFY ALL EXISTING CONDITIONS AND MEASUREMENTS IN THE FIELD PRIOR TO STARTING CONSTRUCTION.
2. REFER TO GENERAL NOTES ON SHEET A0-00 FOR INFORMATION NOT INDICATED ON THIS SHEET.

DEMOLITION GENERAL NOTES:

1. THE GENERAL CONTRACTOR SHALL VERIFY ALL EXISTING CONDITIONS AND MEASUREMENTS IN THE FIELD PRIOR TO STARTING DEMOLITION.
2. THE GENERAL CONTRACTOR SHALL COORDINATE ALL PHASING, ACCESS, DEBRIS REMOVAL, STAGING AREAS AND HOURS OF CONSTRUCTION WITH OWNER PRIOR TO START OF DEMOLITION.
3. THE GENERAL CONTRACTOR SHALL COORDINATE WITH STRUCTURAL, MEP, FIRE ALARM, FIRE PROTECTION, NURSE CALL, INTERIORS AND EQUIPMENT DRAWINGS PRIOR TO STARTING DEMOLITION. THE PROJECT MANUAL AND ALL DRAWINGS IN THE CONSTRUCTION DRAWINGS SHALL BE PART OF THE CONSTRUCTION DOCUMENTS.
4. THE GENERAL CONTRACTOR SHALL SEPARATE DISSIMILAR METALS WITH BUILDING PAPER OR PLASTIC SHIM.
5. THE GENERAL CONTRACTOR SHALL X-RAY AND/OR ULTRASOUND THE EXISTING CONCRETE FLOORS AND FLOOR ABOVE FOR ANY POSSIBLE EMBEDDED CONDUITS, STRUCTURAL REBAR OR UNFORESEEN CONDITION THAT MIGHT IMPEDE THE ANCHORING OF EQUIPMENT OR CONFLICT WITH CORE DRILLING PRIOR TO START OF CONSTRUCTION.
6. REFER TO GENERAL NOTES ON SHEET A0-00 FOR INFORMATION NOT INDICATED ON THIS SHEET.
7. CONTRACTOR STAGING TO BE IN THE ROOMS UNDER REMODEL.
8. CONTRACTOR PARKING TO BE IN CONTRACTOR DESIGNATED PARKING AREA.
9. THE CONTRACTOR SHALL ENSURE THAT THE AREA UNDER REMODEL IS LOCKED AND OTHERWISE SECURED AFTER HOURS.
10. UNLESS OTHERWISE NOTED, CONTRACTOR SHALL COORDINATE WITH THE OWNER THE REMOVAL OF EXISTING EQUIPMENT INDICATED ON DRAWINGS.
11. DASHED LINES INDICATE ITEMS TO BE DEMOLISHED OR REMOVED. REFER TO FLOOR PLAN, CEILING PLAN AND ROOM FINISH SCHEDULE ALONG WITH MECHANICAL, PLUMBING, ELECTRICAL, FIRE PROTECTION, AND FIRE ALARM SECTIONS FOR FURTHER DESCRIPTION OF SCOPE OF WORK.
12. REFER TO DEMOLITION PLAN FOR NOTES INDICATING TYPE OF FINISHES WITHIN THE EXISTING SPACE TO BE REMOVED.
13. REFER TO RELATED PLANS FOR PORTIONS OF EXISTING CONSTRUCTION SCHEDULED TO REMAIN.
14. PATCH NEW WORK TO MATCH AND ALIGN WITH THE EXISTING. COMPLETELY REMOVE EXISTING FINISHES WHERE NEW FINISHES ARE SCHEDULED.
15. CONTRACTOR SHALL PRESERVE AND PROTECT THE EXISTING AREA, EQUIPMENT, CABINETRY ETC. ADJACENT TO THE AREA OF WORK
16. REFER TO NEW PLAN AND INTERIOR ELEVATIONS FOR LOCATION OF NEW WALL CONNECTIONS, OPENINGS, RECESSED ITEMS, BACKING PLATES, ETC. AT EXISTING WALLS. REMOVE GYPSUM BOARD WHERE NEEDED TO ACCOMMODATE FOR THE ABOVE WORK.
17. CAP AND CLOSE ALL ABANDONED OPENINGS AT EXISTING SLAB. FILL AND PATCH TO LEVEL FLOOR. REFER TO STRUCTURAL DETAIL FOR INFILL OPENING DETAIL. NOTE THAT THE NUMBER OF EXISTING OPENINGS TO BE FILLED IS ONLY INDICATIVE. REFER TO MEP FOR MORE INFORMATION. NOTIFY ARCHITECT OF UNCOVERED EXISTING CONDITIONS.
18. CONTRACTOR SHALL PRESERVE AND PROTECT THE PORTIONS OF THE EXISTING OVERHEAD PAGING, TELEPHONE, DATA AND ELECTRICAL LINES DURING THE COURSE OF CONSTRUCTION. MANY OF THE SYSTEMS ARE SCHEDULED FOR REUSE BY THE OWNER UNDER THIS OR SEPERATE CONTRACTS.
19. GENERAL CONTRACTOR TO PROVIDE NEGATIVE PRESSURE IN EACH PHASE AND FILTER THE AIR WITH HEPA FILTRATION AND EXHAUST FILTER AIR THROUGH EXTERIOR WINDOWS. G.C. TO SECURE AN INFECTION CONTROL PERMIT FROM TRI CITY MEDICAL CENTER PRIOR TO STARTING CONSTRUCTION.

S F E I R
A R C H I T E C T S

1350 Columbia Street, Suite 603
San Diego, CA 92101

P: 619-299-3917
F: 619-299-5084
www.sfeirarch.com

TCMC
OBSERVATION
ROOM

TRI-CITY MEDICAL
CENTER
4002 VISTA WAY
OCEANSIDE, CALIFORNIA
92056

OWNER:

TRI-CITY MEDICAL CENTER
4002 VISTA WAY
OCEANSIDE, CALIFORNIA 92056
TEL(760)724-8411

ARCHITECT:



SFEIR ARCHITECTS
1350 COLUMBIA STREET, SUITE 603
SAN DIEGO, CALIFORNIA 92101
TEL(619)299-3917 FAX(619)299-5084

STRUCTURAL:

SUN STRUCTURAL ENGINEERING, INC.
2091 LAS PALMAS DRIVE, SUITE D
CARLSBAD, CALIFORNIA 92011
TEL(760)438-1188

ME&P:

P2S
9665 CHESAPEAKE, SUITE 230
SAN DIEGO, CALIFORNIA 92123
TEL(619)618-2347

		
<div><div>1</div></div>	OSHPD COMMENTS	01/18/2017
<div><div>2</div></div>	DESIGN CHANGES	01/18/2017
<div><div>3</div></div>	OSHPD COMMENTS	04/20/2017
<div><div>4</div></div>	OSHPD COMMENTS	06/14/2017
REV:	DESCRIPTION:	DATE:
CONSULTANT		

OSHPD APPROVAL STAMP:
OSHPD #: S162581-37-00



07/06/2017 10:49:54 AM
#S162581-37-00

SHEET TITLE:
1/4" PARTIAL DEMO FIRST

PROJECT TITLE:
TCMC OBSERVATION ROOM

PROJECT #
01643.00

DRAWN BY:
Author

CHECKED BY:
Checker

SCALE:
As indicated

DATE:
10/11/16

SHEET NUMBER:

A4-00

FLOOR PLAN KEYNOTES:

- 1 NEW NON-RATED PARTITIONS.
- 2 NEW DOOR AND DOOR FRAME.
- 3 NEW DUAL ACTING DOOR AND DOOR FRAME.
- 4 NEW VANDAL RESISTANT WINDOW AND WINDOW FRAME.
- 5 NEW VANDAL/ SUICIDE RESISTANT LAVATORY.
- 6 NEW VANDAL/ SUICIDE RESISTANT WATER CLOSET FABRICATED FROM "CORIAN".
- 7 REINSTALL EXISTING WINDOW TO MATCH. INSTALL POLYCARBONATE COVERING OVER EXISTING EXTERIOR WINDOW.
- 8 INFILL OPENING IN EXISTING RATED CORRIDOR PARTITION. SEE DETAILS 4/A5-01 AND 10/A5-60.
- 9 EXISTING REINSTALLED MODIFIED BASE AND OVERHEAD CABINETS.
- 10 EXISTING REINSTALLED PUSH-BUTTON NURSE CALL.
- 11 PATCH WALL AND BASE (SEE 2/ID-2) TO MATCH EXISTING. PRIME AND PAINT WALL TO MATCH EXISTING.
- 12 PATCH EXPOSED FACES OF RE-INSTALLED CASEWORK TO MATCH.
- 13 INSTALL NEW NURSE CALL AT EXISTING LOCATION.
- 14 REFER TO DETAIL 8/SD-1 FOR SLAB INFILL.
- 15 PATCH FLOOR FINISH TO MATCH EXISTING.

GENERAL NOTES:


- 1. THE GENERAL CONTRACTOR SHALL VERIFY ALL EXISTING CONDITIONS AND MEASUREMENTS IN THE FIELD PRIOR TO STARTING CONSTRUCTION.
- 2. REFER TO GENERAL NOTES ON SHEET A0-00 FOR INFORMATION NOT INDICATED ON THIS SHEET.
- 3. THE GENERAL CONTRACTOR SHALL VERIFY ALL EXISTING CONDITIONS AND MEASUREMENTS IN THE FIELD PRIOR TO STARTING CONSTRUCTION.
- 4. THE GENERAL CONTRACTOR SHALL COORDINATE ALL PHASING, ACCESS, DEBRIS REMOVAL, STAGING AREAS AND HOURS OF CONSTRUCTION WITH OWNER PRIOR TO START OF CONSTRUCTION.
- 5. THE GENERAL CONTRACTOR SHALL COORDINATE WITH STRUCTURAL, MEP, FIRE ALARM, FIRE PROTECTION, NURSE CALL, INTERIORS AND EQUIPMENT DRAWINGS PRIOR TO STARTING CONSTRUCTION. THE PROJECT MANUAL AND ALL DRAWINGS IN THE CONSTRUCTION DRAWINGS SHALL BE PART OF THE CONSTRUCTION DOCUMENTS.
- 6. THE GENERAL CONTRACTOR SHALL SEPARATE DISSIMILAR METALS WITH BUILDING PAPER OR PLASTIC SHIM.
- 7. THE GENERAL CONTRACTOR SHALL X-RAY AND/OR ULTRASOUND THE EXISTING CONCRETE FLOORS AND FLOOR ABOVE FOR ANY POSSIBLE EMBEDDED CONDUITS, STRUCTURAL REBAR OR UNFORESEEN CONDITION THAT IS OUTSIDE THE SCOPE OF WORK AND MIGHT IMPEDE THE ANCHORING OF EQUIPMENT OR CONFLICT WITH TRENCHING PRIOR TO CONSTRUCTION.
- 8. REFER TO GENERAL NOTES ON SHEET A0-00 FOR INFORMATION NOT INDICATED ON THIS SHEET.
- 9. CONTRACTOR STAGING TO BE IN THE ROOMS UNDER REMODEL.
- 10. CONTRACTOR PARKING TO BE IN CONTRACTOR DESIGNATED PARKING AREA.
- 11. THE CONTRACTOR SHALL ENSURE THAT THE AREA UNDER REMODEL IS LOCKED AND OTHERWISE SECURED AFTER HOURS.
- 12. VERIFY ALL DIMENSIONS WITH EQUIPMENT SCHEDULE PRIOR TO START OF CONSTRUCTION.
- 13. REFER TO EQUIPMENT PLAN, CEILING PLAN, INTERIOR ELEVATIONS AND ROOM FINISH SCHEDULE ALONG WITH MECHANICAL, ELECTRICAL, PLUMBING, FIRE PROTECTION, AND FIRE ALARM SECTIONS FOR FURTHER DESCRIPTION OF SCOPE OF WORK.
- 14. REFER TO FINISH PLAN AND SCHEDULE AND INTERIOR DESIGN DOCUMENTS FOR TYPES OF FINISHES.
- 15. FOR DOOR INFORMATION REFER TO DOOR SCHEDULE, SHEET A6-00.
- 16. REFER TO SHEETS A1-00, A1-02 AND A1-04 FOR ACCESSIBILITY REQUIREMENTS.
- 17. PROVIDE ACOUSTICAL INSULATION IN ALL NEW WALL ASSEMBLIES.
- 18. THE GENERAL CONTRACTOR SHALL VERIFY THE LEVELNESS OF THE SLAB AT ALL NEW DOOR LOCATIONS PRIOR TO CONSTRUCTION. APPLY LEVELING MATERIAL AS NECESSARY DURING CONSTRUCTION TO ACHIEVE MAX. OF 3/8" CLEARANCE FROM FINISH FLOOR TO UNDERSIDE OF NEW DOOR. REPLACE FINISHES TO MATCH EXISTING AS NEEDED.
- 19. THE GENERAL CONTRACTOR SHALL SEISMICALLY ANCHOR ALL EXISTING AND NEW BUILDING SYSTEMS ABOVE CEILING INCLUDING BUT NOT LIMITED TO DUCTWORK, ELECTRICAL CONDUITS AND TRAYS, SPRINKLER PIPES, PLUMBING PIPES, ETC. REFER TO A0-00 FOR MORE INFORMATION.

PARTITION LEGEND:

- ACCESSIBLE PATH OF TRAVEL.
- EGRESS PATH OF TRAVEL.
- ONE-HOUR RATED CORRIDOR.
- INDICATES AN EXISTING MEMBRANE OF PARTITION OR PARTITION TO BE REMOVED. REFER TO DEMOLITION PLAN FOR FURTHER REQUIREMENTS.
- INDICATES AN EXISTING PARTITION TO REMAIN. REFER TO PLAN FOR UPGRADE REQUIREMENTS.
- INDICATES AN EXISTING 1 HOUR SMOKE BARRIER
- INDICATES AN EXISTING SMOKE PARTITION
- INDICATES AN EXISTING ONE HOUR FIRE RATED PARTITION TO REMAIN. ALL PENETRATIONS SHALL BE PROTECTED WITH A U.L LISTED FIRE STOP SYSTEM.
- INDICATES AN EXISTING ONE HOUR RATED FIRE BARRIER TO REMAIN. ALL PENETRATIONS SHALL BE PROTECTED WITH A U.L LISTED FIRE STOP SYSTEM.
- INDICATES AN EXISTING TWO HOUR RATED FIRE BARRIER TO REMAIN. ALL PENETRATIONS SHALL BE PROTECTED WITH A U.L LISTED FIRE STOP SYSTEM.
- INDICATES A NEW SMOKE BARRIER
- INDICATES A NEW SMOKE PARTITION
- INDICATES A NEW ONE HOUR RATED FIRE PARTITION EXTENDING TO THE UNDERSIDE OF THE STRUCTURE ABOVE. ALL PENETRATIONS SHALL BE PROTECTED WITH A U.L LISTED FIRE STOP SYSTEM.
- INDICATES A NEW ONE HOUR RATED FIRE BARRIER EXTENDING TO THE UNDERSIDE OF THE STRUCTURE ABOVE. ALL PENETRATIONS SHALL BE PROTECTED WITH A U.L LISTED FIRE STOP SYSTEM.
- THICK LINE INDICATES NEW SURFACE FINISH.
- INDICATES AN EXISTING STRUCTURAL CONCRETE WALL TO REMAIN. LOCATE REINFORCING STEEL AND OBTAIN APPROVAL FROM STRUCTURAL ENGINEER PRIOR TO CORING AND/ OR CUTTING.
- WALL TYPE REFERENCE REFER TO SHEET A5-00.

PARTITION NOTES:

- 1. ALL DIMENSIONS SHOWN ARE TO FINISHED FACE OF GYP. BOARD. TYPICAL U.O.N. REFER TO SHEET A5-00 FOR GENERAL NOTES AND REQUIREMENTS FOR PARTITIONS.
- 2. EXISTING WALL'S WERE CONSTRUCTED WITH MANY PERMITS AND/OR CONTRACTS. FIELD VERIFY CONSTRUCTION AND WIDTH PRIOR TO FABRICATION OF DOOR FRAMES OR COMPONENTS WHICH REQUIRE THE WIDTH OF WALL TO BE SET.

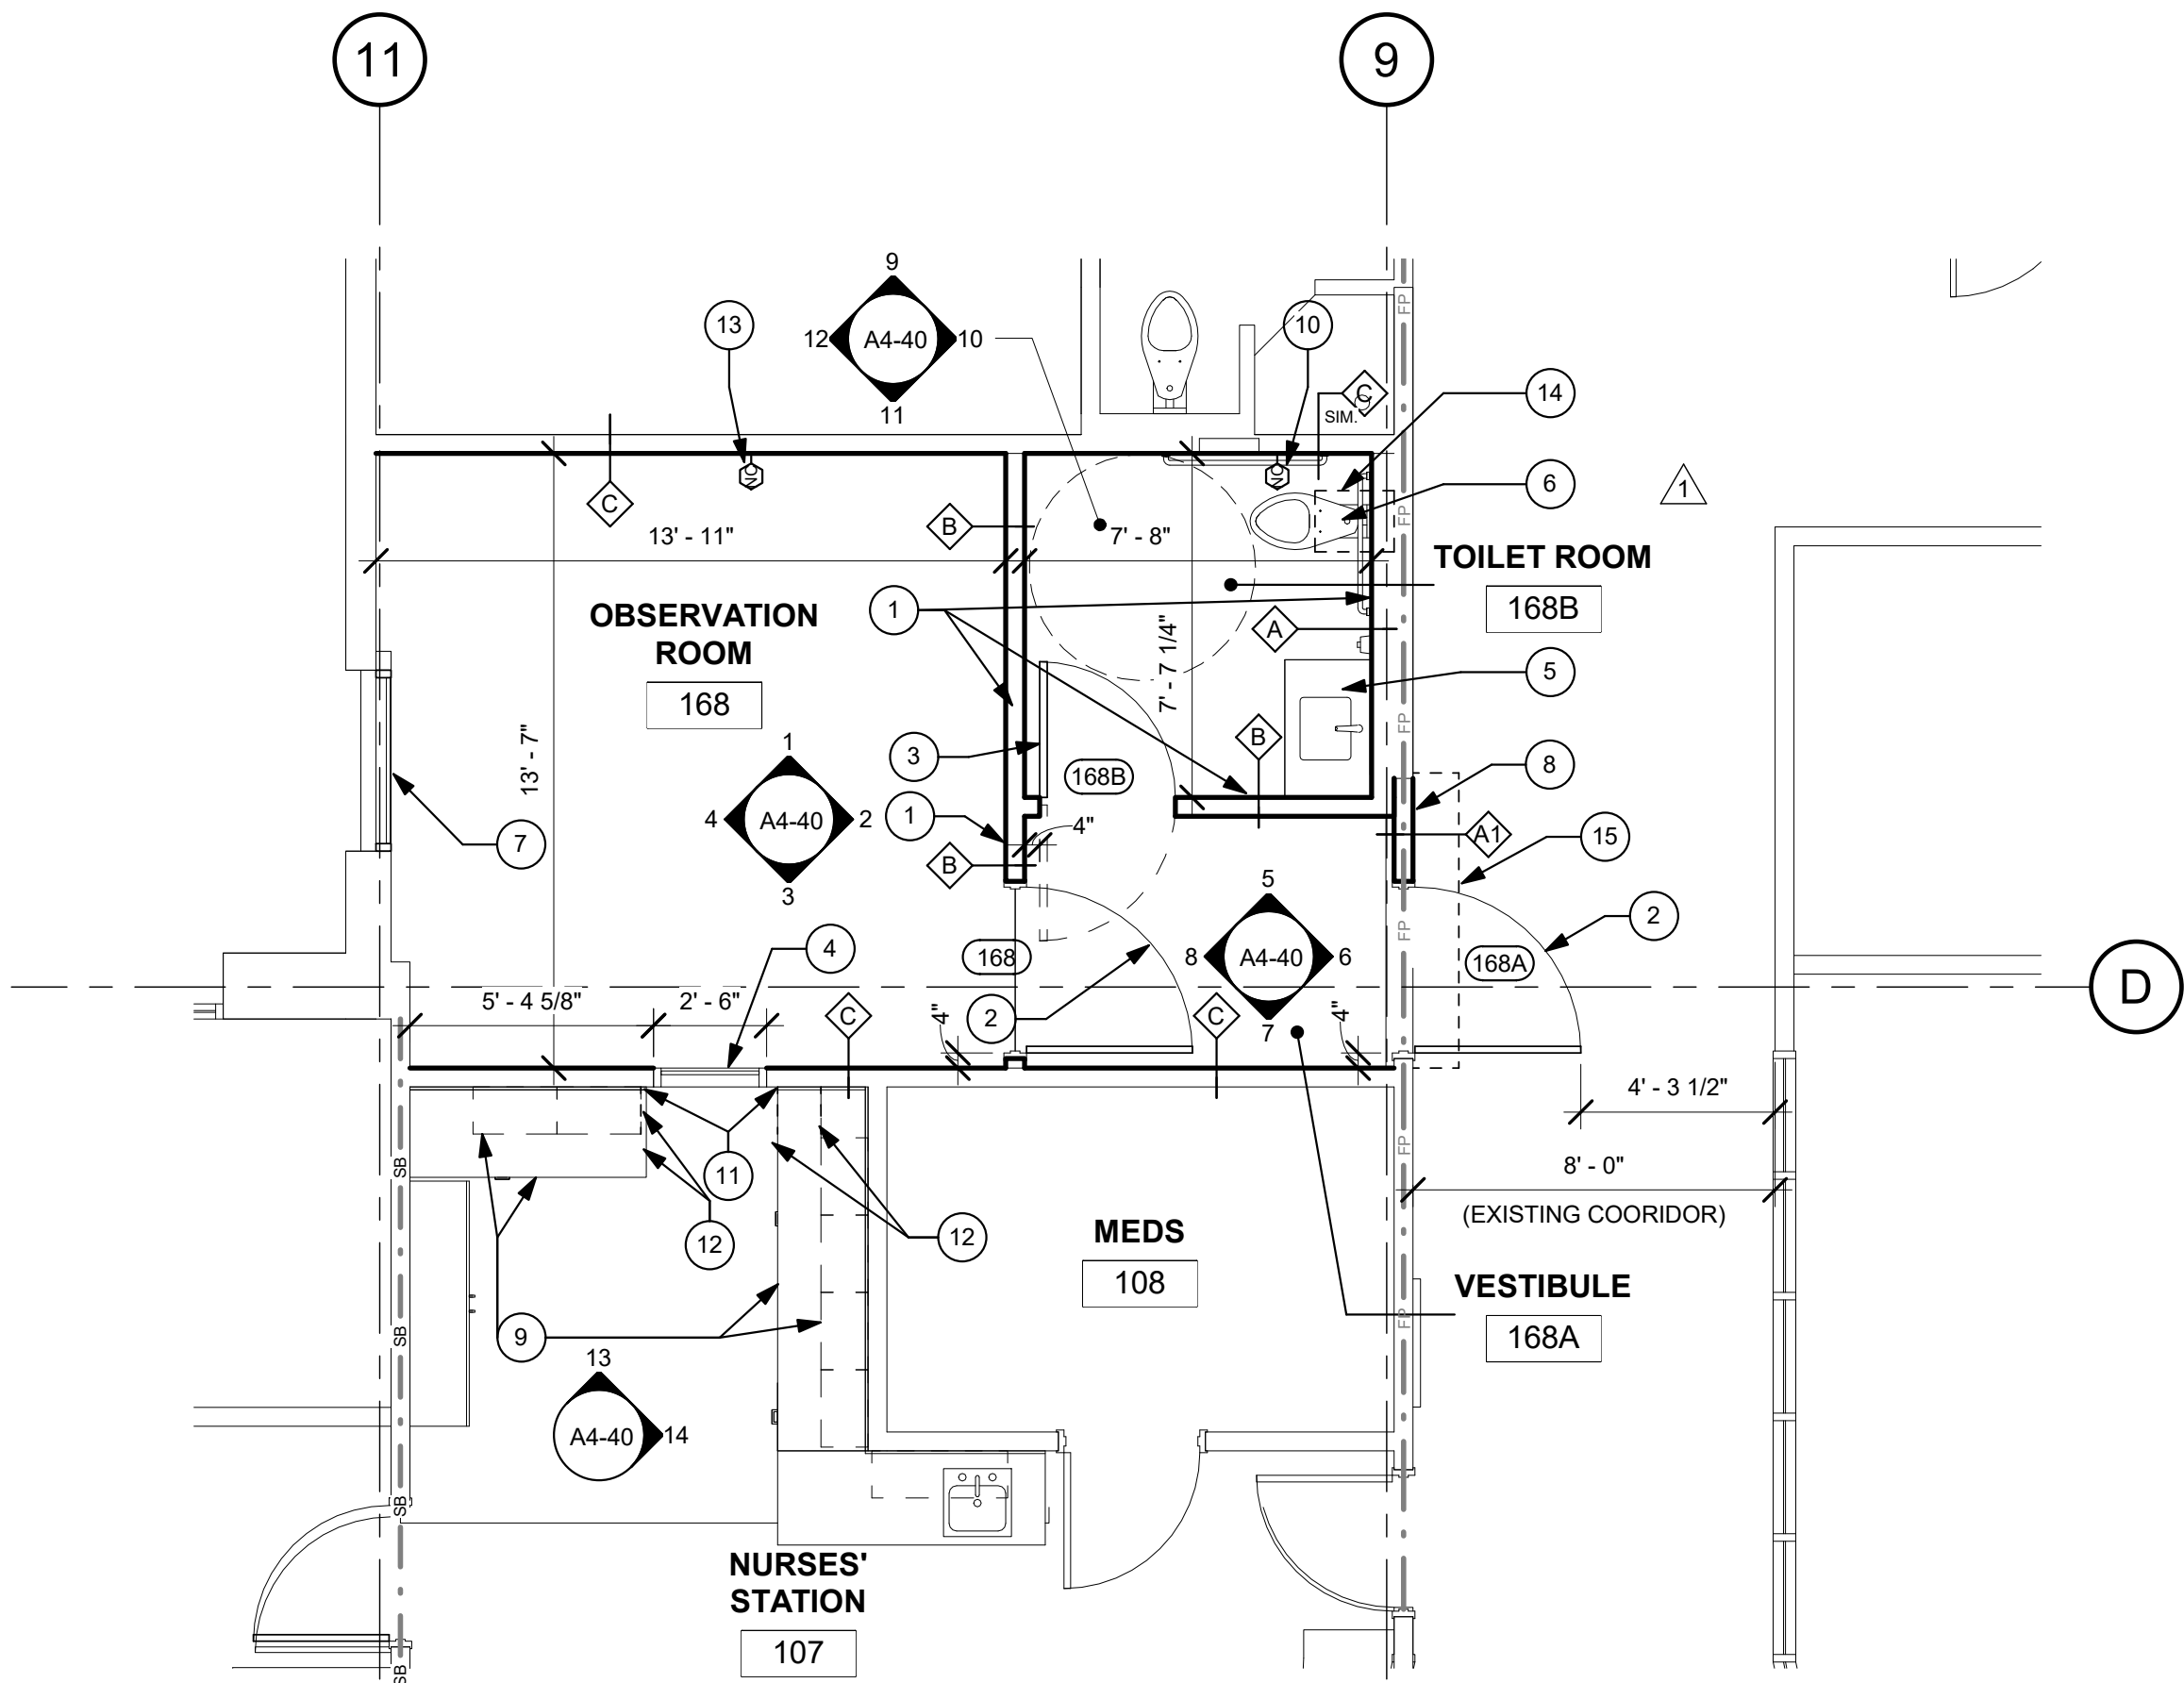

1 FIRST LEVEL NEW PLAN
1/4" = 1'-0"

S F E I R
A R C H I T E C T S

1350 Columbia Street, Suite 603
San Diego, CA 92101

P: 619-299-3917
F: 619-299-5084
www.sfeirarch.com

TCMC
OBSERVATION
ROOM


TRI-CITY MEDICAL
CENTER
4002 VISTA WAY
OCEANSIDE, CALIFORNIA
92056

OWNER: TRI-CITY MEDICAL CENTER
4002 VISTA WAY
OCEANSIDE, CALIFORNIA 92056
TEL(760)724-8411

ARCHITECT: SFEIR ARCHITECTS
1350 COLUMBIA STREET, SUITE 603
SAN DIEGO, CALIFORNIA 92101
TEL(619)299-3917 FAX(619)299-5084

STRUCTURAL: SUN STRUCTURAL ENGINEERING, INC.
2091 LAS PALMAS DRIVE, SUITE D
CARLSBAD, CALIFORNIA 92011
TEL(760)438-1188

ME&P: P2S
9665 CHESAPEAKE, SUITE 230
SAN DIEGO, CALIFORNIA 92123
TEL(619)618-2347

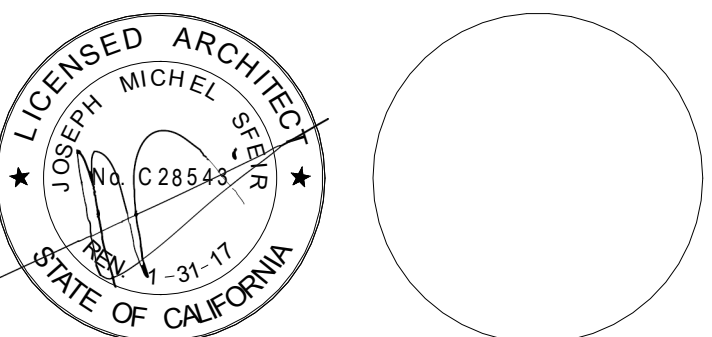

1	1	OSHPD COMMENTS	01/18/2017
2	2	DESIGN CHANGES	01/18/2017
3	3	OSHPD COMMENTS	04/20/2017
4	4	OSHPD COMMENTS	06/14/2017

REV: DESCRIPTION: DATE:

CONSULTANT

OSHPD APPROVAL STAMP:
OSHPD #: S162581-37-00



SHEET TITLE:
1/4" PARTIAL FIRST

PROJECT TITLE:
TCMC OBSERVATION ROOM

PROJECT #
01643.00

DRAWN BY:
Author

CHECKED BY:
Checker

SCALE:
As indicated

DATE:
10/11/16

SHEET NUMBER:
A4-10

RCP DEMOLITION KEYNOTES:

- 1

REMOVE EXISTING 12"x12" ACT CEILING.
- 2

REMOVE EXITSING LIGHT FIXTURE, REFER TO ELEC. DWGS.
- 3

REMOVE EXISTING MECH. AIR REGISTER - REFER TO MECH. DWGS.
- 4

REMOVE EXISTING CEILING MOUNTED CURTAIN TRACK.
- 5

REMOVE EXISTING CEILING MOUNTED FIXTURE.
- 6

REMOVE EXISTING CERAMIC TILE CEILING.
- 7

REMOVE EXISTING CASEWORK SOFFIT TO CEILING AND SALVAGE FOR REUSE.
- 8

REMOVE EXISTING GWB CEILING.
- 9

REMOVE EXISTING ACCESS PANEL.
- 10

REMOVE EXISTING NURSE CALL DOME LIGHT AND SALVAGE FOR RE-USE.
- 11

REMOVE PORTION OF EXISTING ACP CEILING AND SALVAGE FOR RE-USE.
- 12

ONE-HOUR RATED TEMPORARY PARTITION. SEE A/A4-00 FOR ADDITIONAL INFORMATION
- 13


TEMPORARILY REMOVE EXISTING WINDOW FOR CONSTRUCTION ACCESS AND EXHAUST FILTERED CONSTRUCTION DUCT.

GENERAL NOTES:

1. THE GENERAL CONTRACTOR SHALL VERIFY ALL EXISTING CONDITIONS AND MEASUREMENTS IN THE FIELD PRIOR TO STARTING CONSTRUCTION.
2. REFER TO GENERAL NOTES ON SHEET A0-00 FOR INFORMATION NOT INDICATED ON THIS SHEET.
- RCP DEMOLITION NOTES:
1. THE GENERAL CONTRACTOR SHALL VERIFY ALL EXISTING CONDITIONS AND MEASUREMENTS IN THE FIELD PRIOR TO STARTING DEMOLITION.
2. THE GENERAL CONTRACTOR SHALL COORDINATE ALL PHASING, ACCESS, DEBRIS REMOVAL, STAGING AREAS AND HOURS OF CONSTRUCTION WITH OWNER PRIOR TO START OF DEMOLITION.
3. THE GENERAL CONTRACTOR SHALL COORDINATE WITH STRUCTURAL, MEP, FIRE ALARM, FIRE PROTECTION, NURSE CALL, INTERIORS AND EQUIPMENT DRAWINGS PRIOR TO STARTING DEMOLITION. THE PROJECT MANUAL AND ALL DRAWINGS IN THE CONSTRUCTION DRAWINGS SHALL BE PART OF THE CONSTRUCTION DOCUMENTS.
4. THE GENERAL CONTRACTOR SHALL SEPARATE DISSIMILAR METALS WITH BUILDING PAPER OR PLASTIC SHIM.
5. THE GENERAL CONTRACTOR SHALL X-RAY AND/OR ULTRASOUND THE EXISTING CONCRETE FLOORS FOR ANY POSSIBLE EMBEDDED CONDUITS, STRUCTURAL REBAR OR UNFORESEEN CONDITION THAT IS OUTSIDE THE SCOPE OF WORK AND MIGHT IMPEDE THE ANCHORING OF EQUIPMENT OR CONFLICT WITH TRENCHING PRIOR TO CONSTRUCTION.
6. REFER TO GENERAL NOTES ON SHEET A0-00 FOR INFORMATION NOT INDICATED ON THIS SHEET.
7. CONTRACTOR STAGING TO BE IN THE ROOMS UNDER REMODEL.
8. CONTRACTOR PARKING TO BE IN CONTRACTOR DESIGNATED PARKING AREA.
9. THE CONTRACTOR SHALL ENSURE THAT THE AREA UNDER REMODEL IS LOCKED AND OTHERWISE SECURED AFTER HOURS.
10. UNLESS OTHERWISE NOTED, CONTRACTOR SHALL COORDINATE WITH THE OWNER THE REMOVAL OF EXISTING EQUIPMENT INDICATED ON DRAWINGS.
11. DASHED LINES INDICATE ITEMS TO BE DEMOLISHED OR REMOVED. REFER TO CEILING PLAN, ROOM FINISH SCHEDULE ALONG WITH MECHANICAL AND ELECTRICAL SECTIONS FOR FURTHER DESCRIPTION OF SCOPE OF WORK.
12. REFER TO DEMOLITION PLAN FOR NOTES INDICATING TYPE OF FINISHES WITHIN THE EXISTING SPACE TO BE REMOVED.
13. REFER TO RELATED PLANS FOR PORTIONS OF EXISTING CONSTRUCTION SCHEDULED TO REMAIN.
14. PATCH NEW WORK TO MATCH AND ALIGN WITH THE EXISTING. COMPLETELY REMOVE EXISTING FINISHES WHERE NEW FINISHES ARE SCHEDULED.
15. CONTRACTOR SHALL PRESERVE AND PROTECT THE EXISTING OVERHEAD EQUIPMENT, LIGHTING, FIRE ALARM, FIRE SPRINKLER, PAGING, PHONE, DATA, ELECTRICAL LINES, ETC. SCHEDULED TO REMAIN DURING THE COURSE OF DEMOLITION. MANY OF THE SYSTEMS ARE SCHEDULED FOR REUSE BY THE OWNER UNDER THIS OR SEPERATE CONTRACTS.

MATERIAL LEGEND:

- 2' X 2' ACOUSTICAL CEILING PANEL WITH TEGULAR EDGE
- 1' X 1' ACOUSTICAL CEILING TILE
- SUSPENDED GYP. BOARD CEILING
- 2X4 RECESSED LAY-IN FLOURESCENT LIGHT FIXTURE PROVIDE (2) SLACK SAFETY WIRES AT DIAGONAL CORNERS
- 2X2 RECESSED LAY-IN FLOURESCENT LIGHT FIXTURE PROVIDE (2) SLACK SAFETY WIRES AT DIAGONAL CORNERS
- RECESSED "CAN" LIGHT PROVIDE (1) SLACK SAFETY WIRE
- RECESSED "CAN" LIGHT DIRECTED TOWARD WALL PROVIDE (1) SLACK SAFETY WIRE
- EXIT SIGN PROVIDE (1) SLACK SAFETY WIRE
- SMOKE DETECTOR EXISTING PROVIDE (1) SLACK SAFETY WIRE
- PAGING SPEAKER PROVIDE (1) SLACK SAFETY WIRE
- 2'-0" RETURN AIR
- RETURN AIR OR EXHAUST PROVIDE (2) SLACK SAFETY WIRES AT DIAGONAL CORNERS
- 3'-0" SUPPLY AIR DIFFUSER
- SUPPLY AIR DIFFUSER PROVIDE (2) SLACK SAFETY WIRES AT DIAGONAL CORNERS
- 2'x2' CEILING ACCESS PANEL
- 1'x1' CEILING ACCESS PANEL
- 1'x1' CEILING EXHAUST
- 1' x 1' CEILING HVAC SUPPLY
- 1' x 1' CEILING HVAC SUPPLY
- 1' x 4' FLOURESCENT CEILING LIGHT
- DOME CAMERA
- SPRINKLER
- AUDIBLE NURSE CALL
- DOME LIGHT NURSE CALL EXISTING
- CHIME STROBE

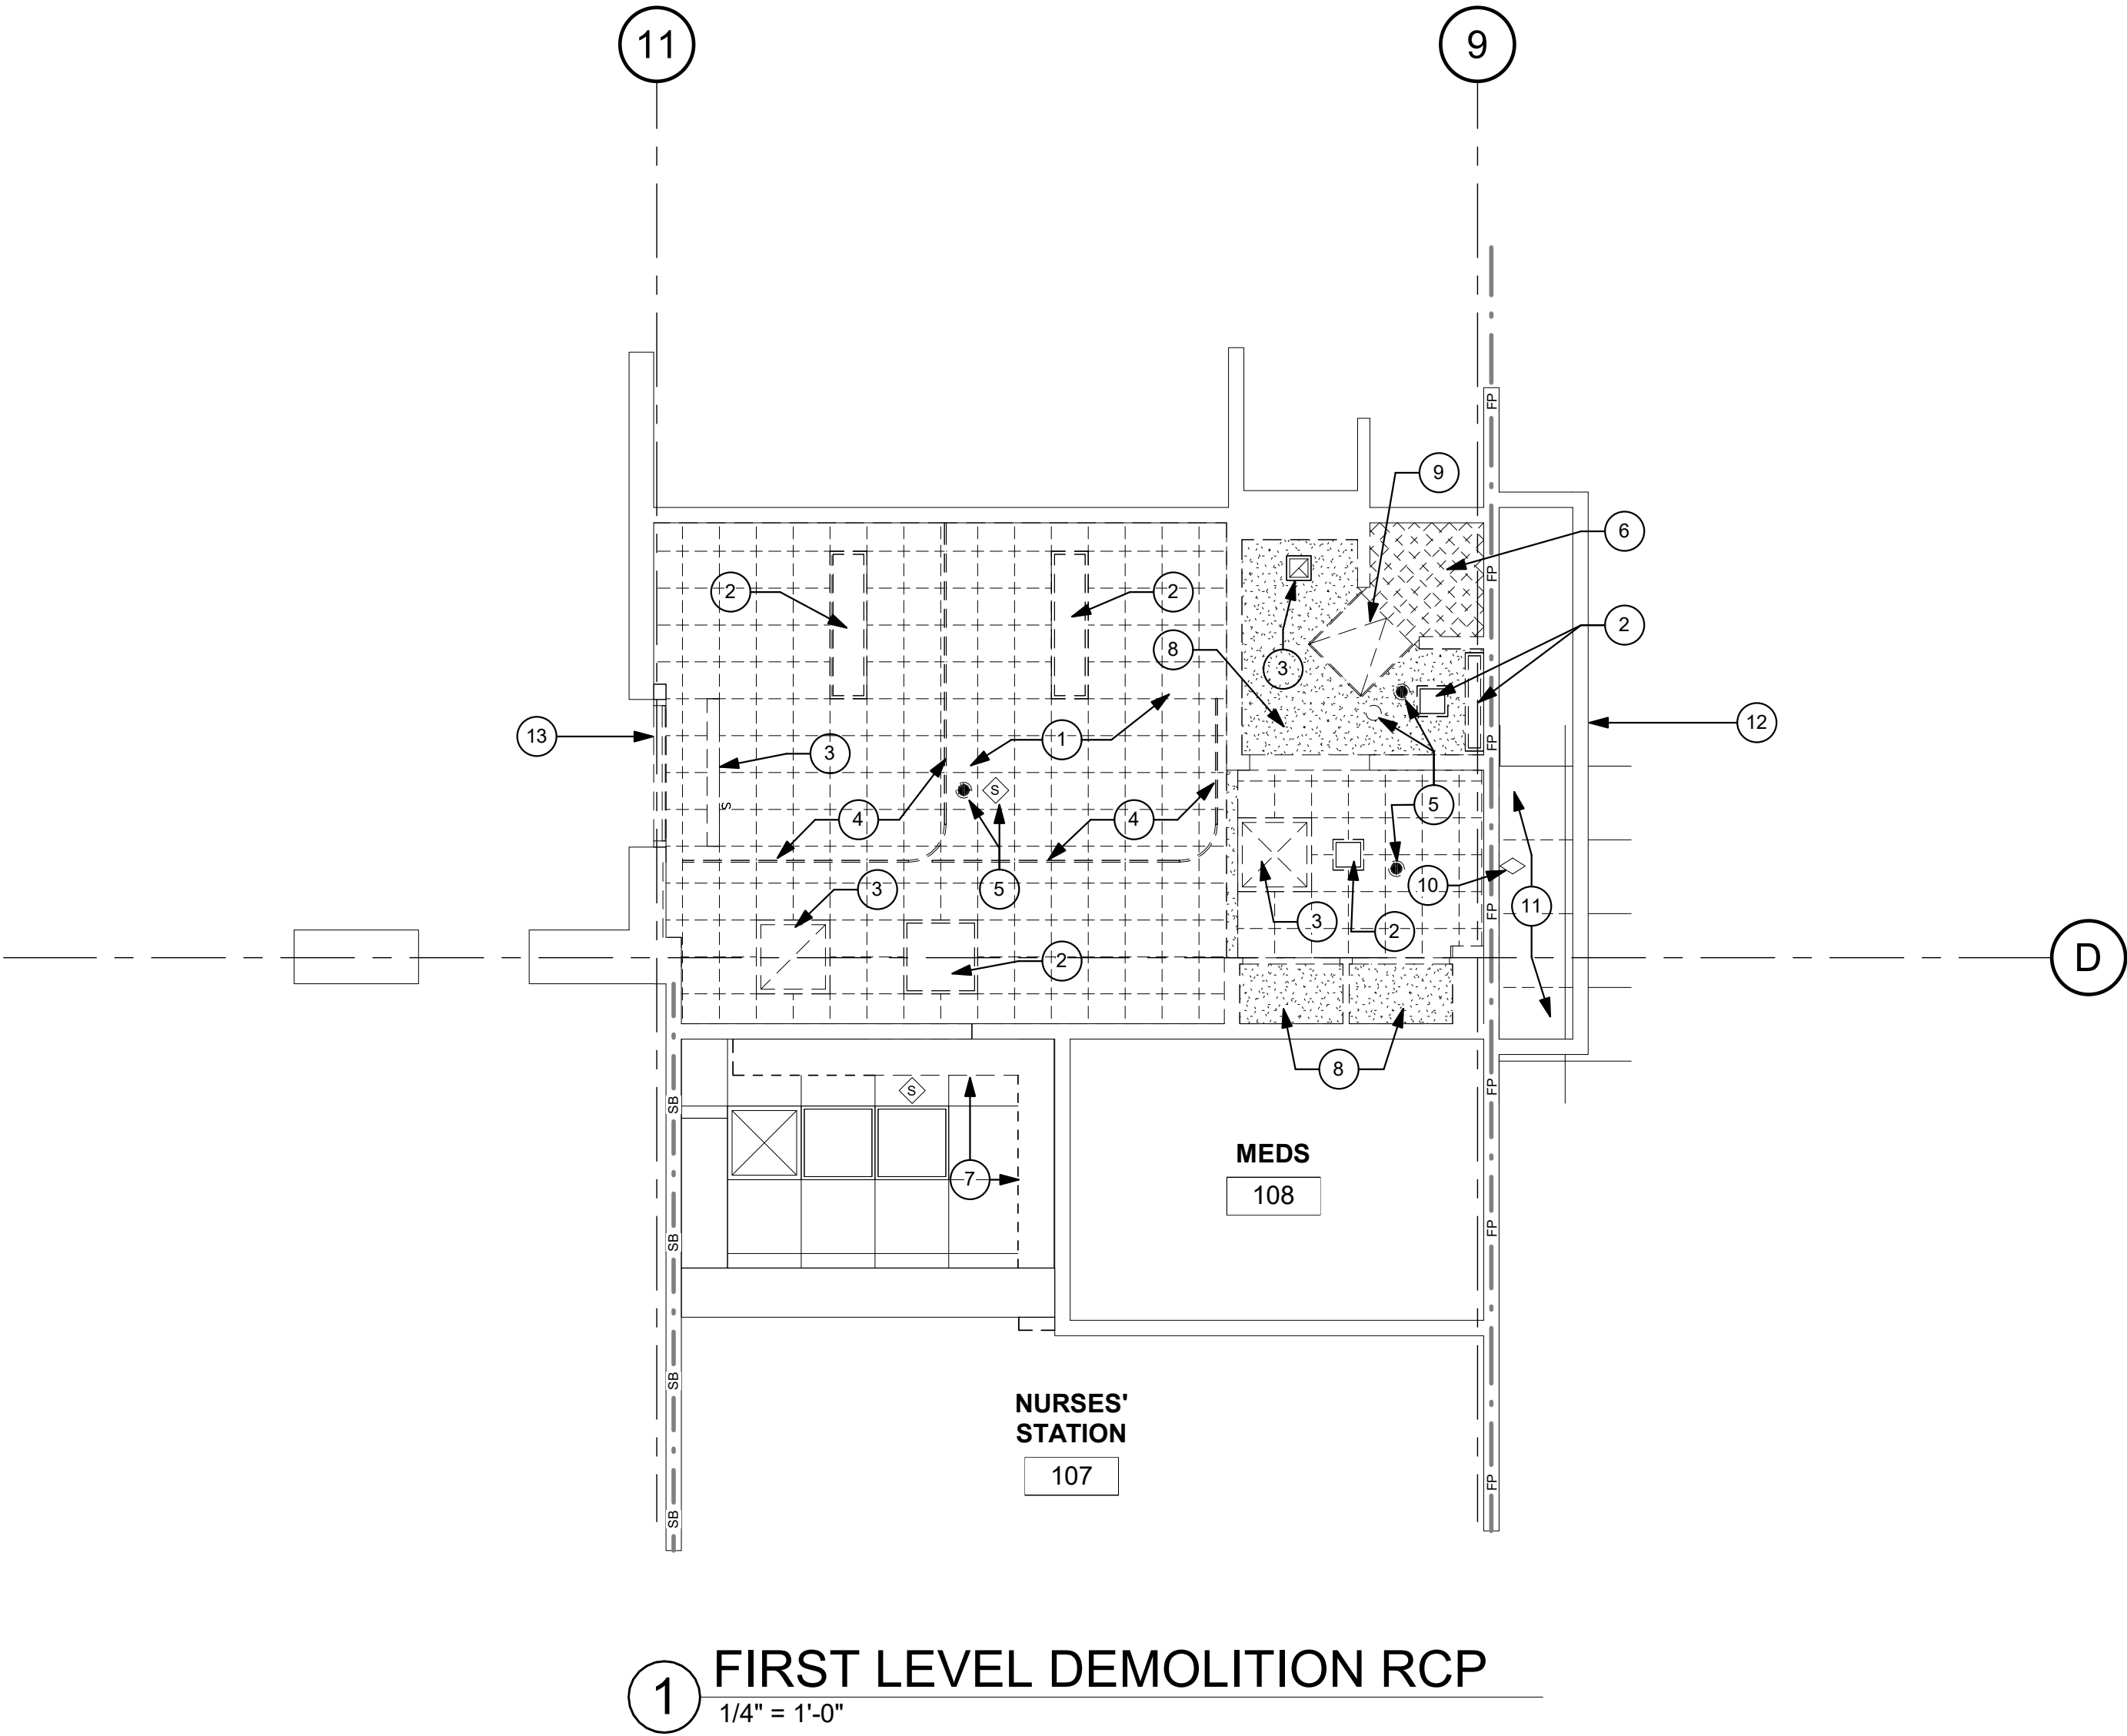

SFEIR ARCHITECTS

1350 Columbia Street, Suite 603
San Diego, CA 92101

P: 619-299-3917
F: 619-299-5084
www.sfeirarch.com

TCMC OBSERVATION ROOM

TRI-CITY MEDICAL CENTER
4002 VISTA WAY
OCEANSIDE, CALIFORNIA 92056

OWNER: TRI-CITY MEDICAL CENTER
4002 VISTA WAY
OCEANSIDE, CALIFORNIA 92056
TEL(760)724-8411

ARCHITECT: SFEIR ARCHITECTS
1350 COLUMBIA STREET, SUITE 603
SAN DIEGO, CALIFORNIA 92101
TEL(619)299-3917 FAX(619)299-5084

STRUCTURAL: SUN STRUCTURAL ENGINEERING, INC.
2091 LAS PALMAS DRIVE, SUITE D
CARLSBAD, CALIFORNIA 92011
TEL(760)438-1188

ME&P: P2S
9665 CHESAPEAKE, SUITE 230
SAN DIEGO, CALIFORNIA 92123
TEL(619)618-2347

LICENSED ARCHITECT
JOSEPH MICHEL
No. C28543
EXPI. 1-31-17
STATE OF CALIFORNIA

1	1	OSHPD COMMENTS	01/18/2017
2	2	DESIGN CHANGES	01/18/2017
3	3	OSHPD COMMENTS	04/20/2017
4	4	OSHPD COMMENTS	06/14/2017

REV:	DESCRIPTION:	DATE:
CONSULTANT		

OSHPD APPROVAL STAMP:
OSHPD #: S162581-37-00

REVIEWED IN ACCORDANCE WITH
THE REQUIREMENTS OF T24, CCR

APPROVED

Laura Baldrati, Sr. Architect

Office of Statewide Health
Planning & Development
FACILITIES DEVELOPMENT DIVISION

SHEET TITLE:
1/4" PARTIAL DEMO RCP
FIRST

PROJECT TITLE:
TCMC OBSERVATION ROOM

PROJECT #:
01643.00

DRAWN BY:
AR/HT

CHECKED BY:
JS

SCALE:
As indicated


DATE:
10/11/16

SHEET NUMBER:
A4-20

TCMC OBSERVATION ROOM

TRI-CITY MEDICAL CENTER 4002 VISTA WAY OCEANSIDE, CALIFORNIA 92056

OWNER:	TRI-CITY MEDICAL CENTER 4002 VISTA WAY OCEANSIDE, CALIFORNIA 92056 TEL(760)724-8411
ARCHITECT:	SFEIR ARCHITECTS 1350 COLUMBIA STREET, SUITE 603 SAN DIEGO, CALIFORNIA 92101 TEL(619)299-3917 FAX(619)299-5084
STRUCTURAL:	SUN STRUCTURAL ENGINEERING, INC. 2091 LAS PALMAS DRIVE, SUITE D CARLSBAD, CALIFORNIA 92011 TEL(760)438-1188
ME&P:	P2S 9665 CHESAPEAKE, SUITE 230 SAN DIEGO, CALIFORNIA 92123 TEL(619)618-2347

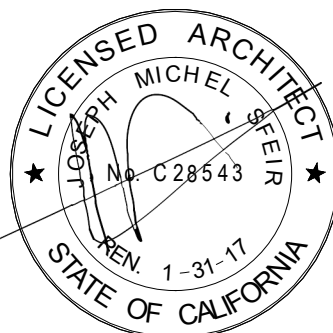

1	1	OSHDP COMMENTS	01/18/2017
2	2	DESIGN CHANGES	01/18/2017
3	3	OSHDP COMMENTS	04/20/2017
4	4	OSHDP COMMENTS	06/14/2017

REV:	DESCRIPTION:	DATE:
CONSULTANT		

OSHDP APPROVAL STAMP:
OSHDP #: S162581-37-00



SHEET TITLE:
1/4" PARTIAL RCP FIRST

PROJECT TITLE:
TCMC OBSERVATION ROOM

PROJECT #
01643.00
DRAWN BY:
Author
CHECKED BY:
Checker
SCALE:
As indicated
DATE:
10/11/16

SHEET NUMBER:

A4-30

GENERAL NOTES:

- THE GENERAL CONTRACTOR SHALL VERIFY ALL EXISTING CONDITIONS AND MEASUREMENTS IN THE FIELD PRIOR TO STARTING CONSTRUCTION.
- REFER TO GENERAL NOTES ON SHEET A0-00 FOR INFORMATION NOT INDICATED ON THIS SHEET.

RCP GENERAL NOTES:

- THE GENERAL CONTRACTOR SHALL VERIFY ALL EXISTING CONDITIONS AND MEASUREMENTS IN THE FIELD PRIOR TO STARTING CONSTRUCTION.
- THE GENERAL CONTRACTOR SHALL COORDINATE ALL PHASING, ACCESS, DEBRIS REMOVAL, STAGING AREAS AND HOURS OF CONSTRUCTION WITH OWNER PRIOR TO START OF CONSTRUCTION.
- THE GENERAL CONTRACTOR SHALL COORDINATE WITH STRUCTURAL, MEP, FIRE ALARM, FIRE PROTECTION, NURSE CALL, INTERIORS AND EQUIPMENT DRAWINGS PRIOR TO STARTING CONSTRUCTION. THE PROJECT MANUAL AND ALL DRAWINGS IN THE CONSTRUCTION DRAWINGS SHALL BE PART OF THE CONSTRUCTION DOCUMENTS.
- THE GENERAL CONTRACTOR SHALL SEPARATE DISSIMILAR METALS WITH BUILDING PAPER OR PLASTIC SHIM.
- THE GENERAL CONTRACTOR SHALL X-RAY AND/OR ULTRASOUND THE EXISTING CONCRETE FLOORS FOR ANY POSSIBLE EMBEDDED CONDUITS, STRUCTURAL REBAR OR UNFORESEEN CONDITION THAT IS OUTSIDE THE SCOPE OF WORK AND MIGHT IMPEDE THE ANCHORING OF EQUIPMENT OR CONFLICT WITH TRENCHING PRIOR TO CONSTRUCTION.
- REFER TO GENERAL NOTES ON SHEET A0-00 FOR INFORMATION NOT INDICATED ON THIS SHEET.
- CONTRACTOR STAGING TO BE IN THE ROOMS UNDER REMODEL.
- CONTRACTOR PARKING TO BE IN CONTRACTOR DESIGNATED PARKING AREA.
- THE CONTRACTOR SHALL ENSURE THAT THE AREA UNDER REMODEL IS LOCKED AND OTHERWISE SECURED AFTER HOURS.
- CEILING HEIGHTS TO MATCH EXISTING UNLESS OTHERWISE NOTED (NOT LESS THAN 8'-0")
- REFER TO SHEET A5-60 AND A5-70 FOR CEILING DETAILS.
- REFER TO ELECTRICAL DRAWINGS FOR LIGHT FIXTURE TYPES.
- FIRE SPRINKLER HEAD LAYOUT MUST BE APPROVED BY ARCHITECT PRIOR TO INSTALLATION. ALL EXPOSED SPRINKLER HEAD COMPONENTS SHALL BE WHITE.
- REPLACE EXISTING LENSES FOR 2X2 AND 2X4 LIGHT FIXTURES.
- REPLACE ALL GRILLES, DIFFUSERS AND REGISTERS WITH NEW.

MATERIAL LEGEND:

2' X 2' ACOUSTICAL CEILING PANEL WITH TEGULAR EDGE

1' X 1' ACOUSTICAL CEILING TILE

SUSPENDED GYP. BOARD CEILING

2X4 RECESSED LAY-IN FLOURESCENT LIGHT FIXTURE
PROVIDE (2) SLACK SAFETY WIRES AT DIAGONAL CORNERS

2X2 RECESSED LAY-IN FLOURESCENT LIGHT FIXTURE
PROVIDE (2) SLACK SAFETY WIRES AT DIAGONAL CORNERS

RECESSED "CAN" LIGHT PROVIDE (1) SLACK SAFETY WIRE
RECESSED "CAN" LIGHT DIRECTED TOWARD WALL PROVIDE (1) SLACK SAFETY WIRE

EXIT SIGN
PROVIDE (1) SLACK SAFETY WIRE

SMOKE DETECTOR EXISTING
PROVIDE (1) SLACK SAFETY WIRE

PAGING SPEAKER
PROVIDE (1) SLACK SAFETY WIRE
2'-0" RETURN AIR

RETURN AIR OR EXHAUST
PROVIDE (2) SLACK SAFETY WIRES AT DIAGONAL CORNERS

3'-0" SUPPLY AIR DIFFUSER

SUPPLY AIR DIFFUSER
PROVIDE (2) SLACK SAFETY WIRES AT DIAGONAL CORNERS

2'x2' CEILING ACCESS PANEL

1'x1' CEILING ACCESS PANEL

1'x1' CEILING EXHAUST

1' x 1' CEILING HVAC SUPPLY

1' x 1' CEILING HVAC SUPPLY

1' x 4' FLOURESCENT CEILING LIGHT

DOVE CAMERA

SPRINKLER


AUDIBLE NURSE CALL

DOVE LIGHT NURSE CALL EXISTING

CHIME STROBE

RCP KEYNOTES:

- CEILING IS NOT FIRE RATED. ROOF ABOVE CEILING IS RATED 1 1/2 HOURS AND COMPOSED OF 3" METALIC DECK WITH 3 1/4" LIGHT WEIGHT CONCRETE FILL.
- NEW LIGHT FIXTURE WITH VANDAL PROOF ANCHORAGE AND SURFACE ATTACHMENT, REFER TO ELEC. DWGS.
- NEW CEILING MOUNTED FIXTURE WITH VANDAL PROOF ANCHORAGE AND SURFACE ATTACHMENT, REFER TO MEP. DWGS.
- NEW ACCESS PANEL.
- NEW MECHANICAL AIR REGISTER, REFER TO MECH. DRAWINGS.
- NEW 2' X 2' ACP CEILING TILE & GRID TO MATCH EXISTING.
- RE-INSTALL SALVAGED CEILING TILES AND GRID TO MATCH EXISTING.
- RELOCATED NURSE CALL DOME LIGHT.
- EXISTING RE-INSTALLED MODIFIED CASEWORK.
- PATCHED EXPOSED FACES OF RE-INSTALLED CASEWORK TO MATCH.
- POLYCARBONATE COVERING OVER EXISTING EXTERIOR WINDOW.

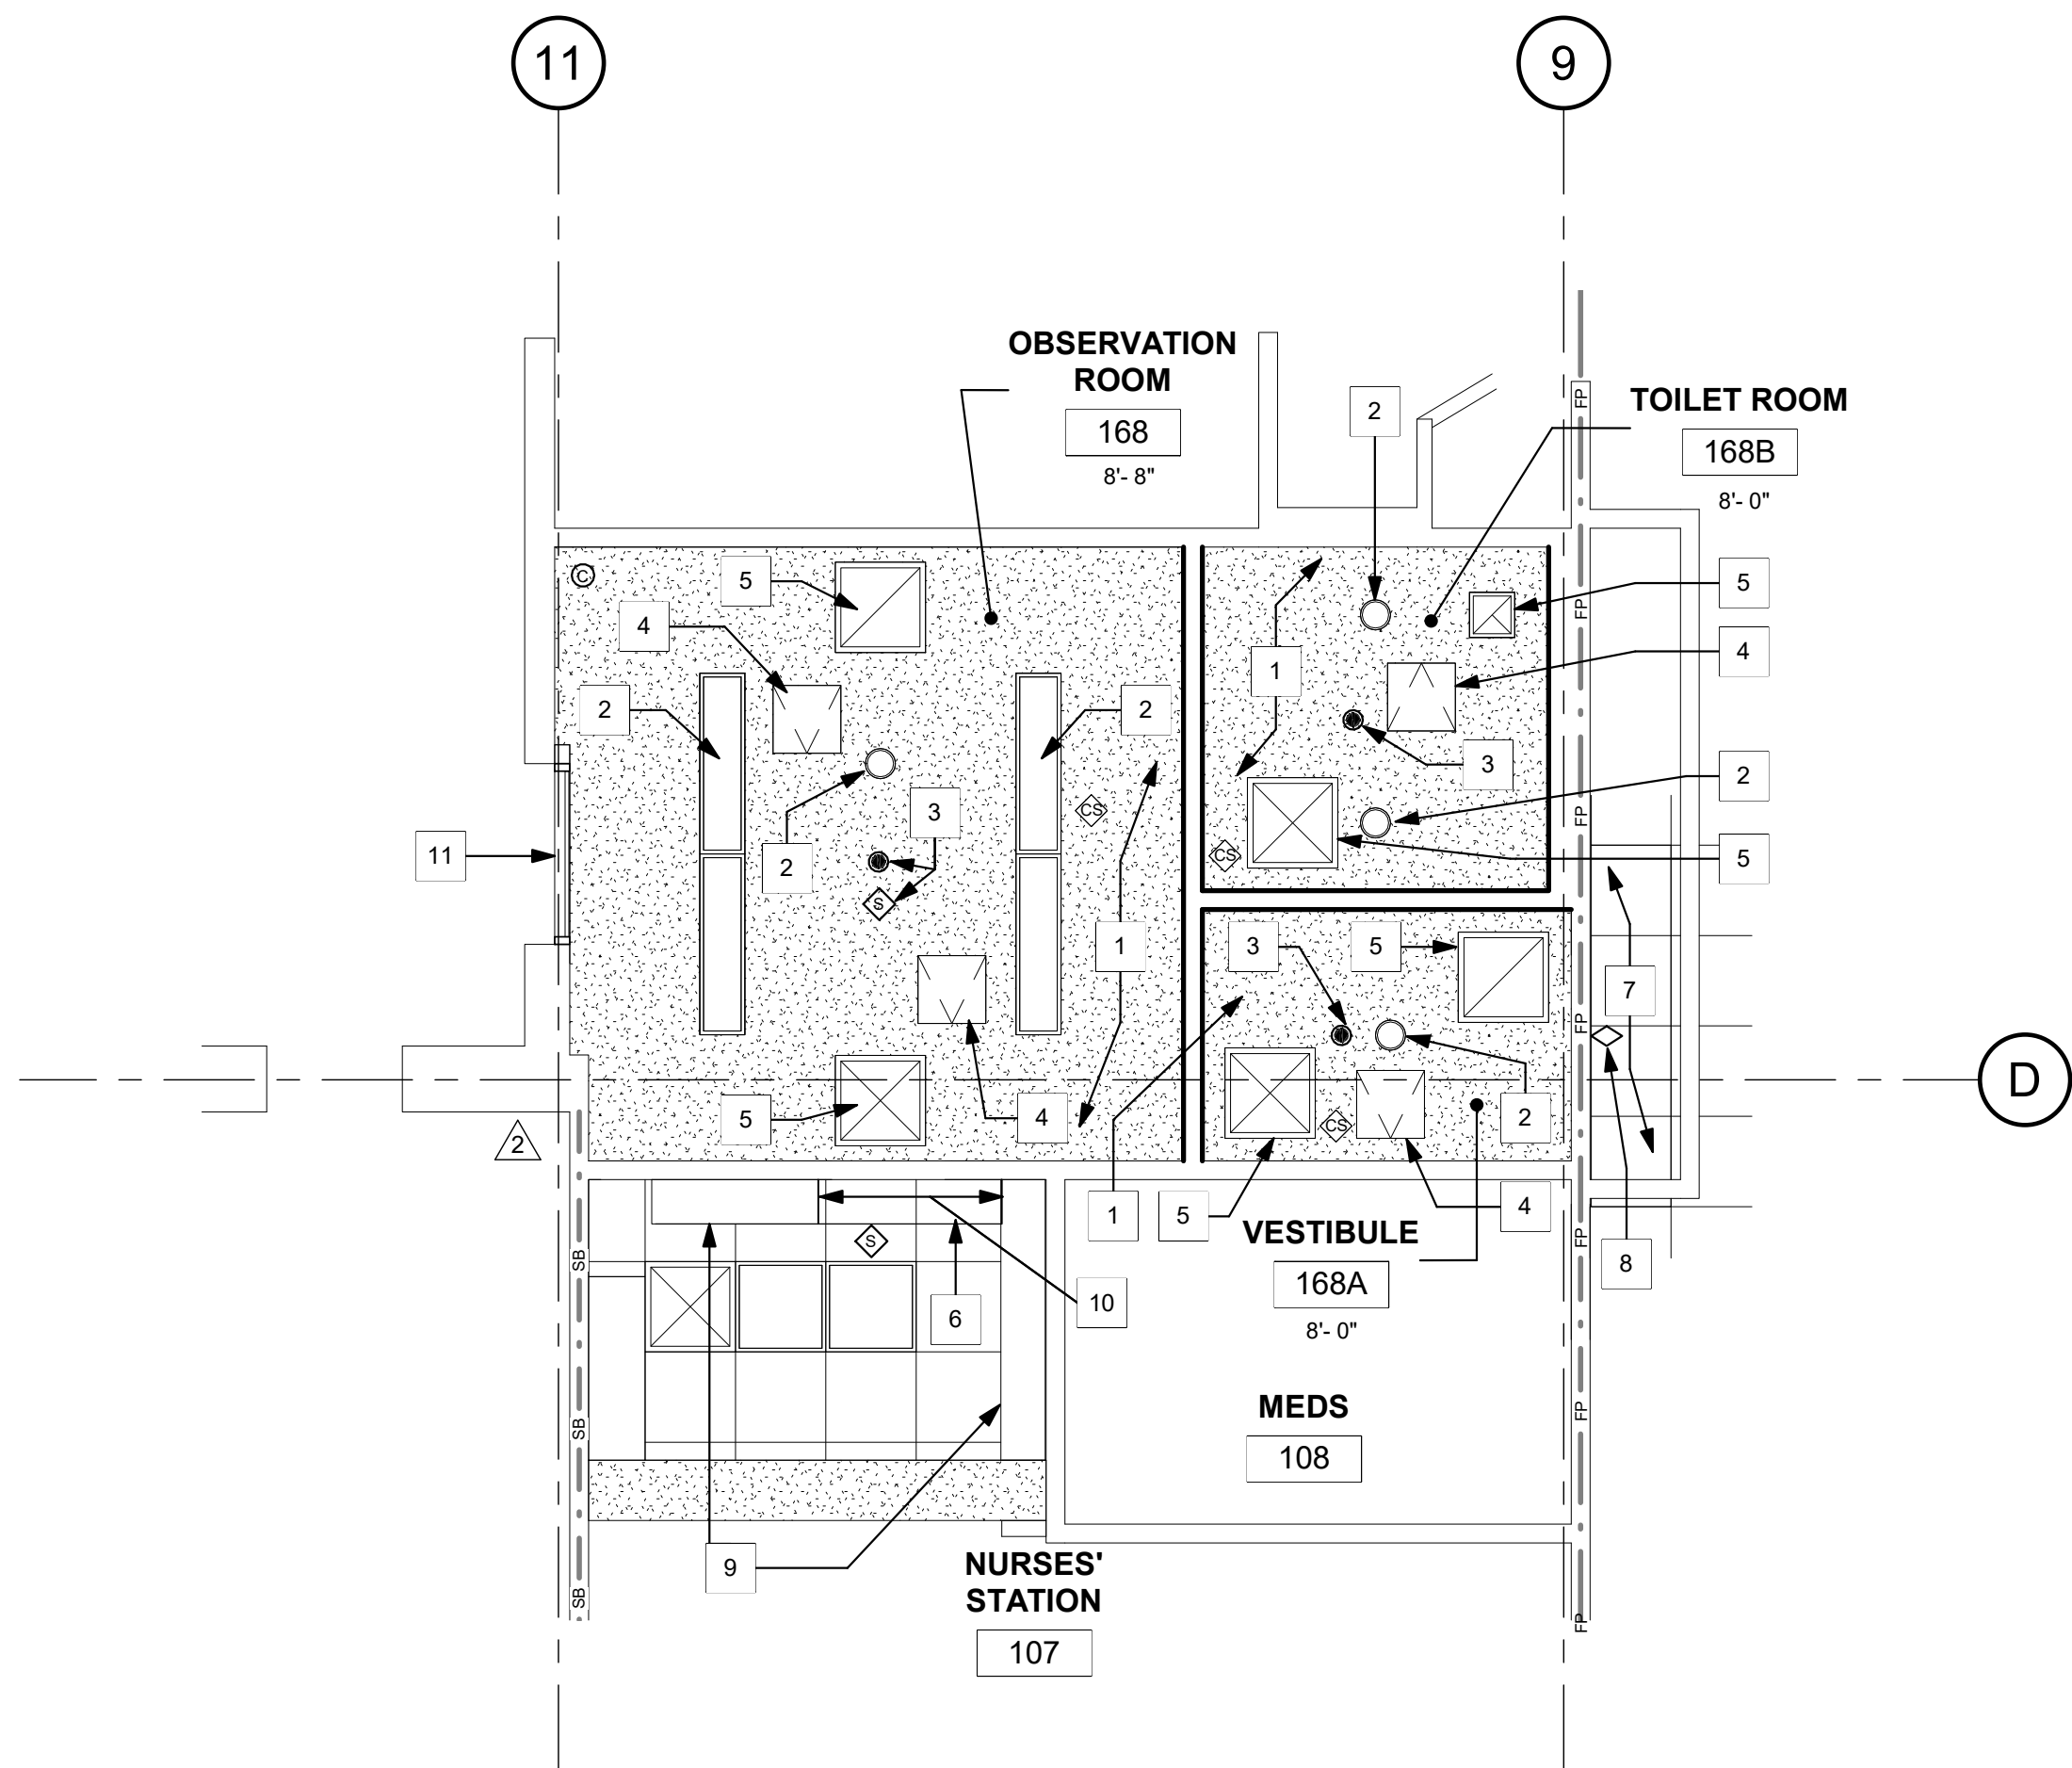

1 FIRST LEVEL NEW RCP
1/4" = 1'-0"

ACCESSORY SCHED. - TOILET

NOTE: MODEL NUMBERS REFERENCED REFER TO "BOBRICK WASHROOM EQUIPMENT CO."

TAG	MODEL NUMBER	DESCRIPTION
A	B-353	RECESSED SANITARY NAPKIN DISPENSER
B	B-38034	RECESSED PAPER TOWEL DISPENSER & WASTE REC. (600 C-FOLD)
C	B-166 2436	24"x36" ANGLE FRAME MIRROR W/ 5" SHELF
D	B-3574	RECESSED SEAT COVER DISP. NAPKIN DISP. TISSUE DISPENSER
E	B-3474	RECESSED SEAT COVER DISPENSER
F	B-6806X36	36" GRAB BAR W/ CONCEALED MOUNTING
G	B-3888	RECESSED MULTI-ROLL TOILET TISSURE DISPENSER
H	B-4369	RECESSED PAPER TOWEL DISPENSER & WASTE REC. (300 C-FOLD)
J	B-155	SURFACE MOUNTED SOAP DISPENSER (OFC)
K	B-212	CLOTHES HOOK AND BUMPER
L	B-6806X42	42" GRAB BAR W/ CONCEALED MOUNTING.

ELEVATION KEYNOTES:

- EXISTING MODIFIED COUNTER, BASE AND UPPER CABINETS.
- PADDED WALL PROTECTION.
- PRIME AND PAINT.
- NEW INTEGRAL 6" SHEET VINYL COVE BASE. OMIT METAL TRIM AT TOP EDGE OF BASE. SEE 2 10-1.
- WALL MOUNTED ACCESSORY. SEE TOILET ACCESSORY SCHEDULE ON THIS SHEET.
- NOT USED.
- CLEAR POLYCARBONATE LEXAN GLAZING.
- CLEAR POLYCARBONATE LEXAN GLAZING PANEL. ANCHOR TO EXISTING ALUMINUM FRAME WITH VANDAL PROOF ANCHORS @ 12" O.C.
- PRIME AND PAINT THE WINDOW FRAMES.
- PRIME AND PAINT THE DOOR AND DOOR FRAMES.

- PRIME AND PAINT EXISTING WINDOW FRAMES.
- ACROVYN WAINSCOT.
- INSTALL NEW TAMPER-RESISTANT PUSH-BUTTON NURSE CALL AT EXISTING LOCATION.
- NEW VANDAL/ SUICIDE RESISTANT LAVATORY.
- NEW VANDAL/ SUICIDE RESISTANT WATER CLOSET "CORIAN".
- 1/4" DIAMETER VENT HOLES @ 6" O.C.
- POLYCARBONATE VANDAL RESISTANT WINDOW IN DOOR. SEE A6-00 FOR ADDITIONAL INFORMATION.
- NEW BASE TO MATCH EXISTING.
- EXISTING RELOCATED PUSH-BUTTON NURSE CALL.

GENERAL NOTES:

- THE GENERAL CONTRACTOR SHALL VERIFY ALL EXISTING CONDITIONS AND MEASUREMENTS IN THE FIELD PRIOR TO STARTING CONSTRUCTION.
- REFER TO GENERAL NOTES ON SHEET A0-00 FOR INFORMATION NOT INDICATED ON THIS SHEET.

LEGEND:

1i REFER TO EQUIPMENT SCHEDULE.

NOTES

CASEWORK LEGEND:

CASE ID NUMBER

D100G24
CASE WIDTH (INCHES) (- = AS REQ'D.)
CASE HEIGHT
CASE TYPE (REFER TO W.I.C.)
SPECIAL PREFIX
D = DOUBLE
M = MODIFY

TASK24 = 24" TASK LIGHT MODULE

TASK36 = 36" TASK LIGHT MODULE

TASK48 = 48" TASK LIGHT MODULE

FTPED = SINK FOOT CONTROL PEDALS

DEPTH (U.O.N. ON ELEVATIONS)

LOWER CASE: 24" DEEP U.O.N.
UPPER CASE: 14" DEEP U.O.N.
TALL CASE: 14" DEEP U.O.N.

OUTLET DESCRIPTION

A - MEDICAL COMPRESSED AIR	N - NURSE CALL
C - CODE BLUE	NO - NITROUS OXIDE
D - DATA	O - OXYGEN
DP - DICTAPHONE	PS - NURSE CALL PULL STATION
DS - DIMMER SWITCH	S - SWITCH
E - DUPLEX ELECT. OUTLET	T - TELEPHONE
F - FAX MACHINE	TL - TASK LIGHT
IC - INTERCOM	TV - TELEVISION
J - JUNCTION BOX	V - VACUUM
	VC - VOLUME CONTROL
	VS - VACUUM SLIDE

GENERAL NOTES:

- ALL CASEWORK SHALL BE "CUSTOM" GRADE AS DEFINED BY THE WOODWORK INSTITUTE OF CALIFORNIA.
- FINISH ALL EXPOSED AND SEMI-EXPOSED SURFACES OF CASEWORK INCLUDING THE INTERIOR OF OPEN CASEWORK AND SHELVING WITH PLASTIC LAMINATE. ALL COUNTERTOPS SHALL BE PLASTIC LAMINATE UNLESS NOTED OTHERWISE.
- PROVIDE PLASTIC LAMINATE SOFFIT TO ENCLOSE SPACE BETWEEN CEILING AND TOP OF CABINET. TYPICAL UNLESS NOTED OTHERWISE.
- BASES ON CASEWORK SHALL BE 6" UNLESS OTHERWISE NOTED. PROVIDE SAME FINISH BASE MATERIAL AS ADJACENT WALLS. EXTEND BASE TO WALL AT ALL CABINET RETURNS AND END PANELS.
- IN CASES OF CABINET INSTALLATIONS BETWEEN WALLS, VERIFY DIMENSIONS IN FIELD AND PROVIDE FILLER PANEL STRIPS AT ENDS OR REDUCE END CABINETS WIDTH AS REQUIRED TO FIT SPACE AS INDICATED.
- ALL CABINET DOORS AND DRAWERS SHALL HAVE PULLS. UPPER AND LOWER CABINET DOORS AND FULL HEIGHT CABINETS SHALL HAVE PULLS MOUNTED VERTICALLY. DRAWERS SHALL HAVE HORIZONTAL PULLS.
- ALL FILE DRAWERS SHALL BE SIZED FOR 8 1/2" x 11" FORMS. PROVIDE FILE RODS EXTENDING FRONT TO BACK OF DRAWER UNIT, TYPICAL.
- COORDINATE HEIGHT AND LOCATION OF BACKING PLATES FOR CASEWORK WITH STUD FRAMING CONTRACTOR. REF ALSO TO DETAIL 10 ON SHEET S-1 FOR FURTHER INFO.
- REFER TO DETAILS 2 & 3 ON SHEET A5-80 FOR WALL CABINET ANCHORAGE/ BACKING TRACK CONNECTION.
- GENERAL CONTRACTOR SHALL VERIFY ALL DIMENSIONS OF ROUGH OPENINGS AND COORDINATE W/OWNER FOR ALL EQUIPMENT CLEARANCES PRIOR TO PREPARING SHOP DRAWINGS AND FABRICATION.

S F E I R A R C H I T E C T S

1350 Columbia Street, Suite 603
San Diego, CA 92101

P: 619-299-3917
F: 619-299-5084
www.sfeirarch.com

TCMC OBSERVATION ROOM


TRI-CITY MEDICAL
CENTER
4002 VISTA WAY
OCEANSIDE, CALIFORNIA
92056

OWNER: TRI-CITY MEDICAL CENTER
4002 VISTA WAY
OCEANSIDE, CALIFORNIA 92056
TEL(760)724-8411

ARCHITECT: SFEIR ARCHITECTS
1350 COLUMBIA STREET, SUITE 603
SAN DIEGO, CALIFORNIA 92101
TEL(619)299-3917 FAX(619)299-5084

STRUCTURAL: SUN STRUCTURAL ENGINEERING, INC.
2091 LAS PALMAS DRIVE, SUITE D
CARLSBAD, CALIFORNIA 92011
TEL(760)438-1188

ME&P: P2S
9665 CHESAPEAKE, SUITE 230
SAN DIEGO, CALIFORNIA 92123
TEL(619)618-2347

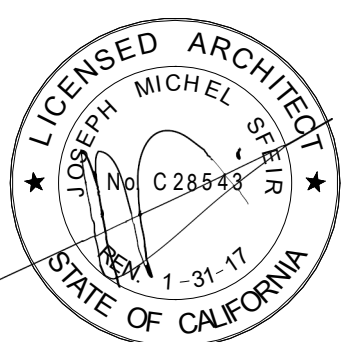

1	1	OSHPD COMMENTS	01/18/2017
2	2	DESIGN CHANGES	01/18/2017
3	3	OSHPD COMMENTS	04/20/2017
4	4	OSHPD COMMENTS	06/14/2017

REV: DESCRIPTION: DATE:
CONSULTANT

OSHPD APPROVAL STAMP:
OSHPD #: S162581-37-00




SHEET TITLE:
1/4" INTERIOR ELEVATIONS


PROJECT TITLE:
TCMC OBSERVATION ROOM

PROJECT #
01643.00
DRAWN BY:
Author
CHECKED BY:
Checker
SCALE:
As indicated
DATE:
10/11/16


A4-40

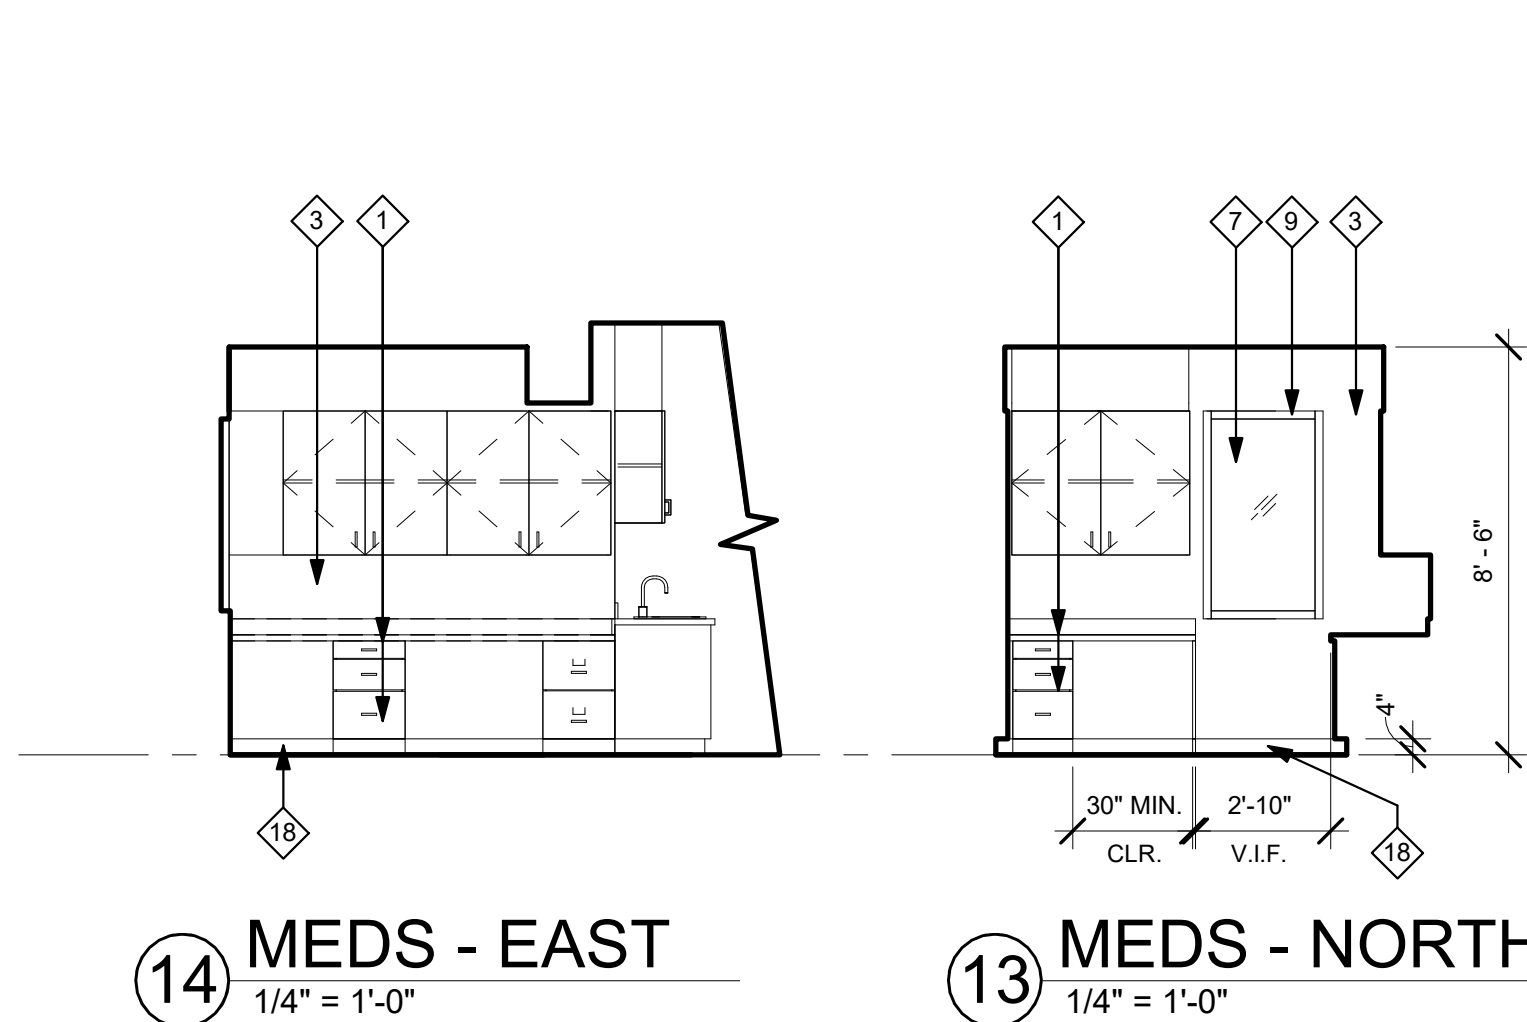


13 MEDS - NORTH
1/4" = 1'-0"

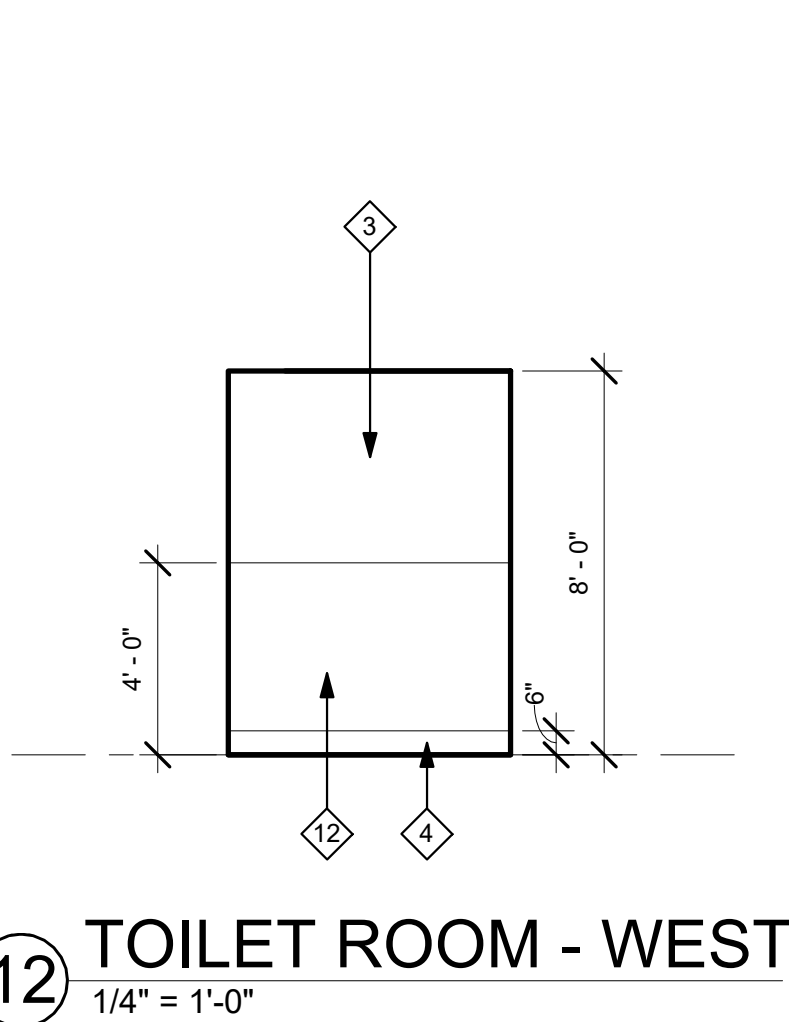


12 TOILET ROOM - WEST
1/4" = 1'-0"

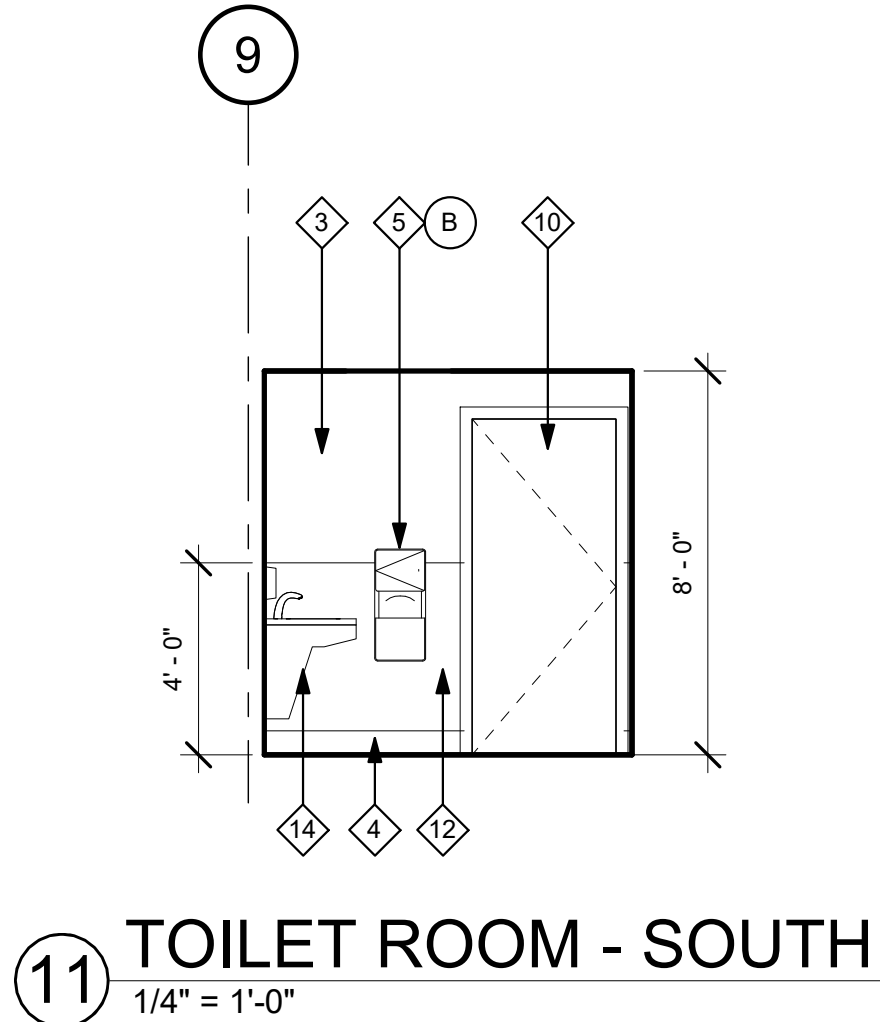


11 TOILET ROOM - SOUTH
1/4" = 1'-0"

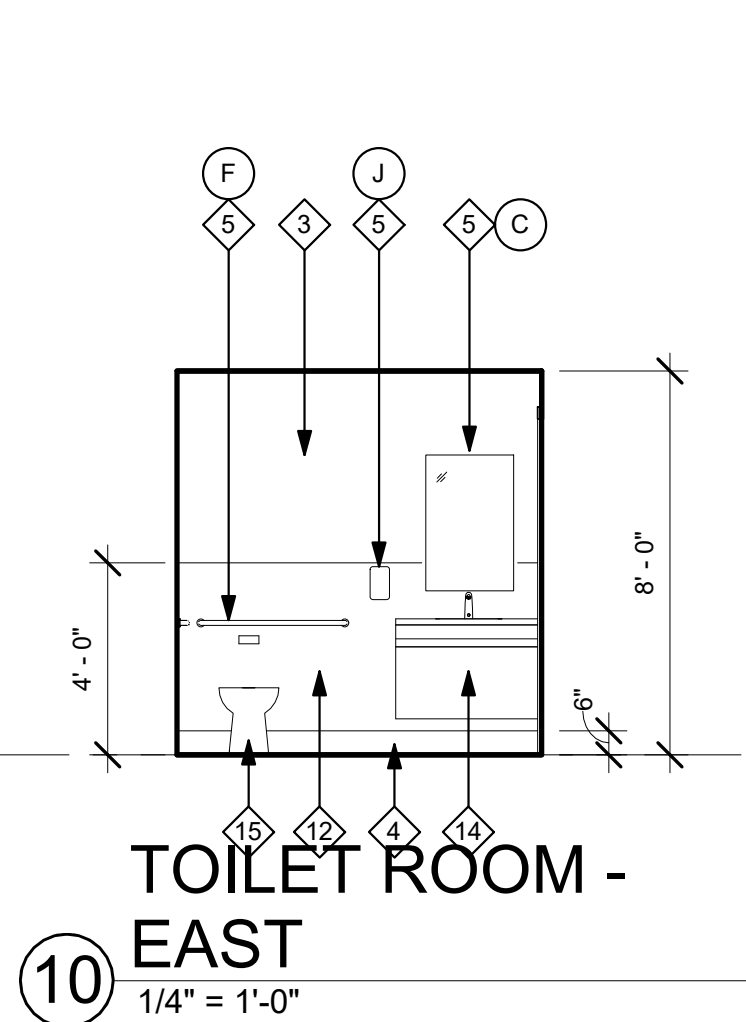


10 TOILET ROOM - EAST
1/4" = 1'-0"

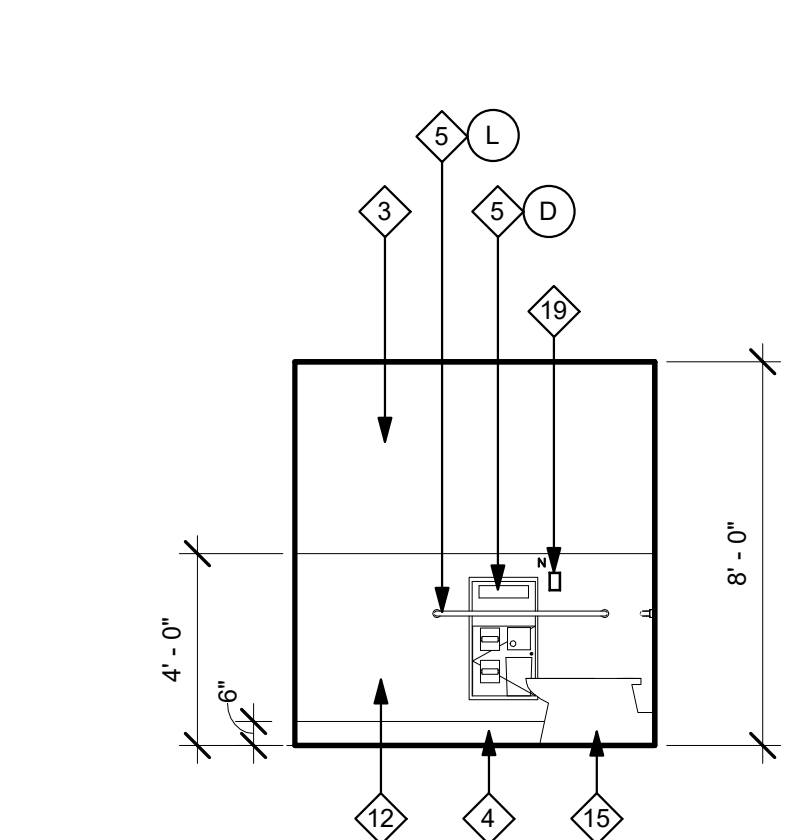


9 TOILET ROOM - NORTH
1/4" = 1'-0"

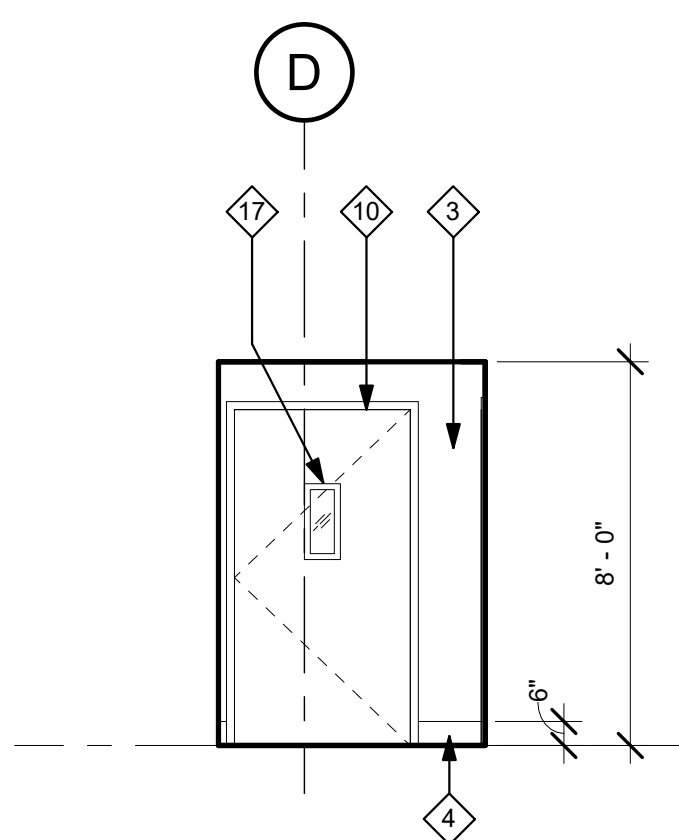


8 VESTIBULE - WEST
1/4" = 1'-0"

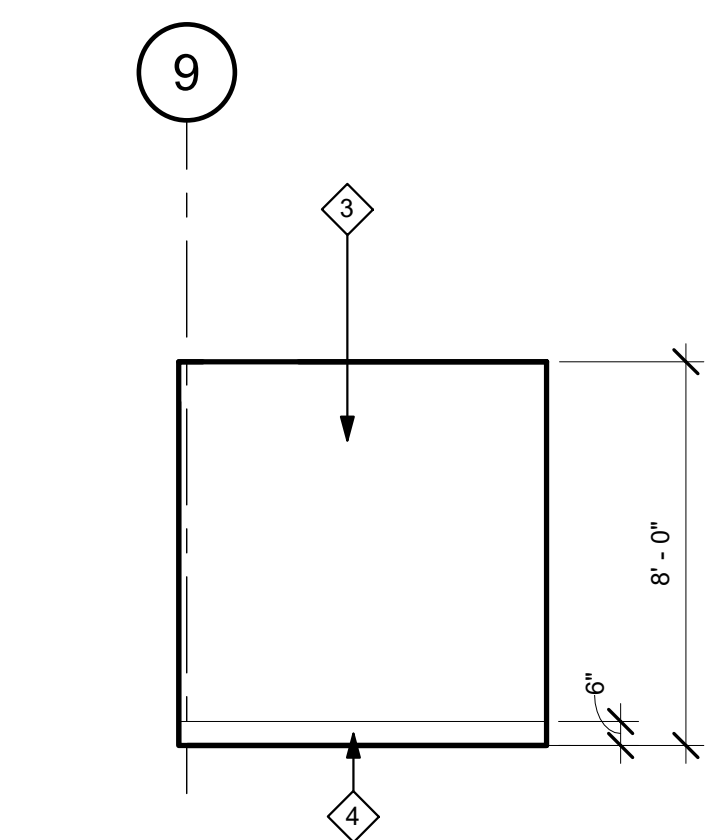


7 VESTIBULE - SOUTH
1/4" = 1'-0"

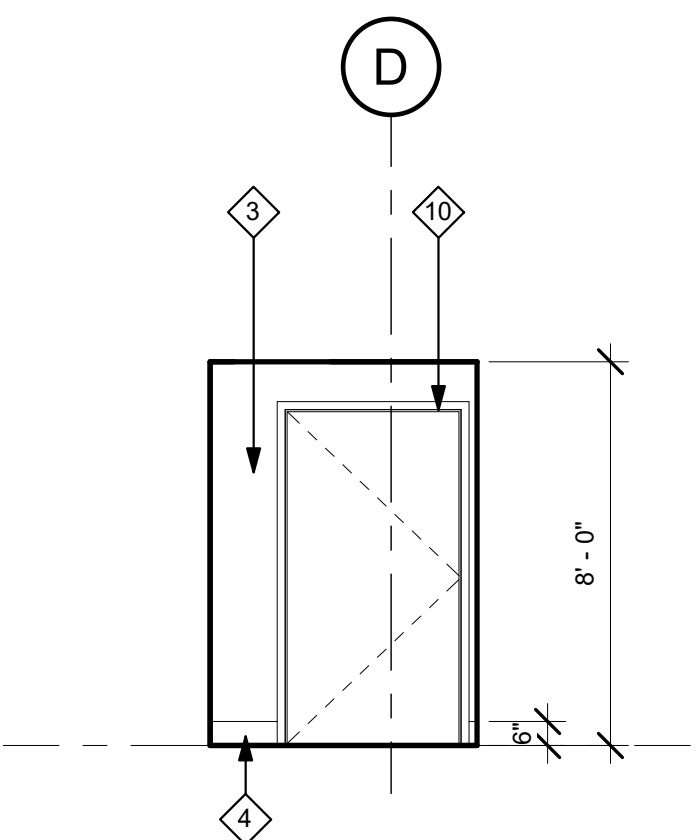


6 VESTIBULE - EAST
1/4" = 1'-0"

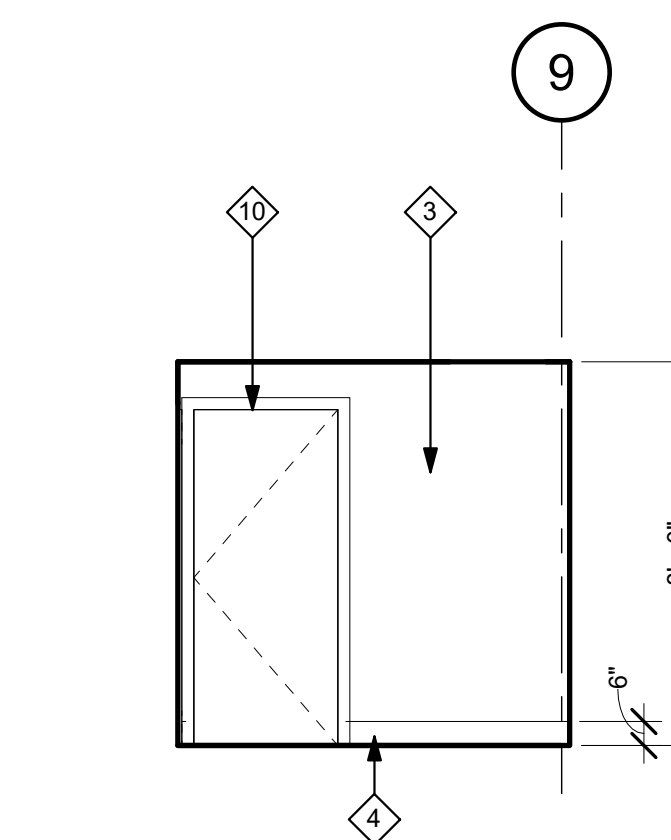


5 VESTIBULE - NORTH
1/4" = 1'-0"

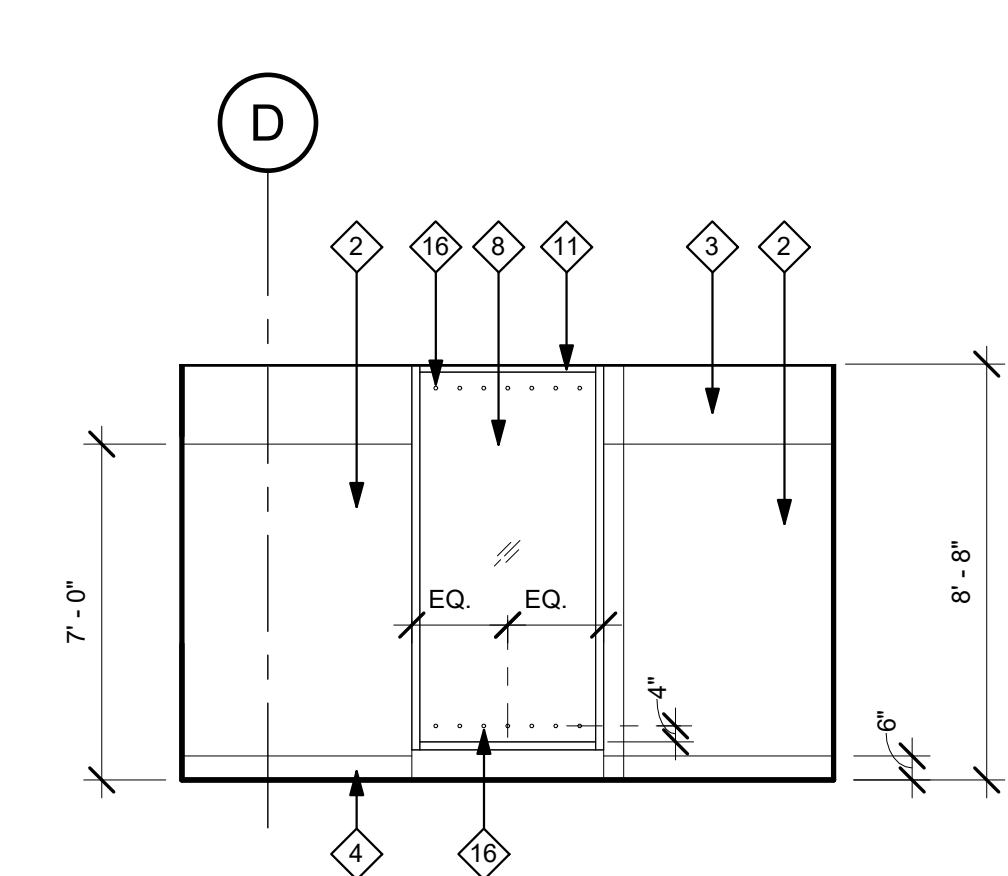


4 OBSERVATION ROOM - WEST
1/4" = 1'-0"

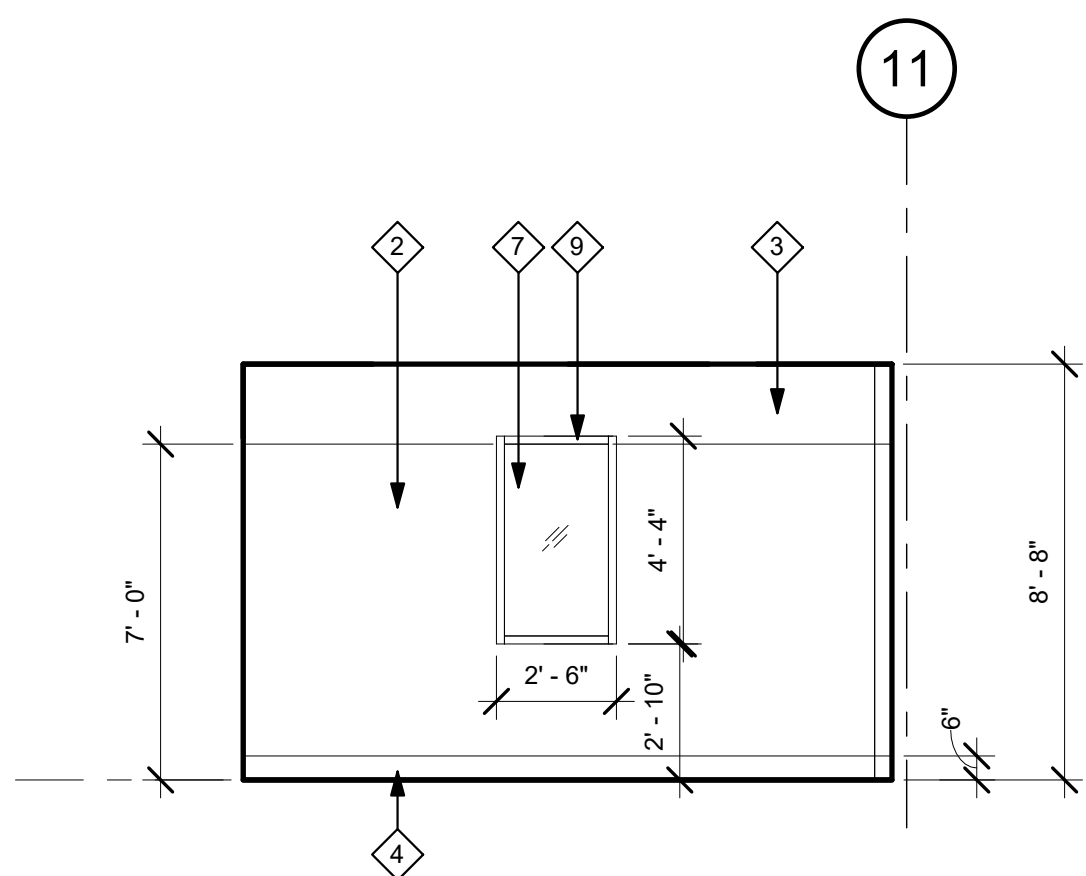

3 OBSERVATION ROOM - SOUTH
1/4" = 1'-0"

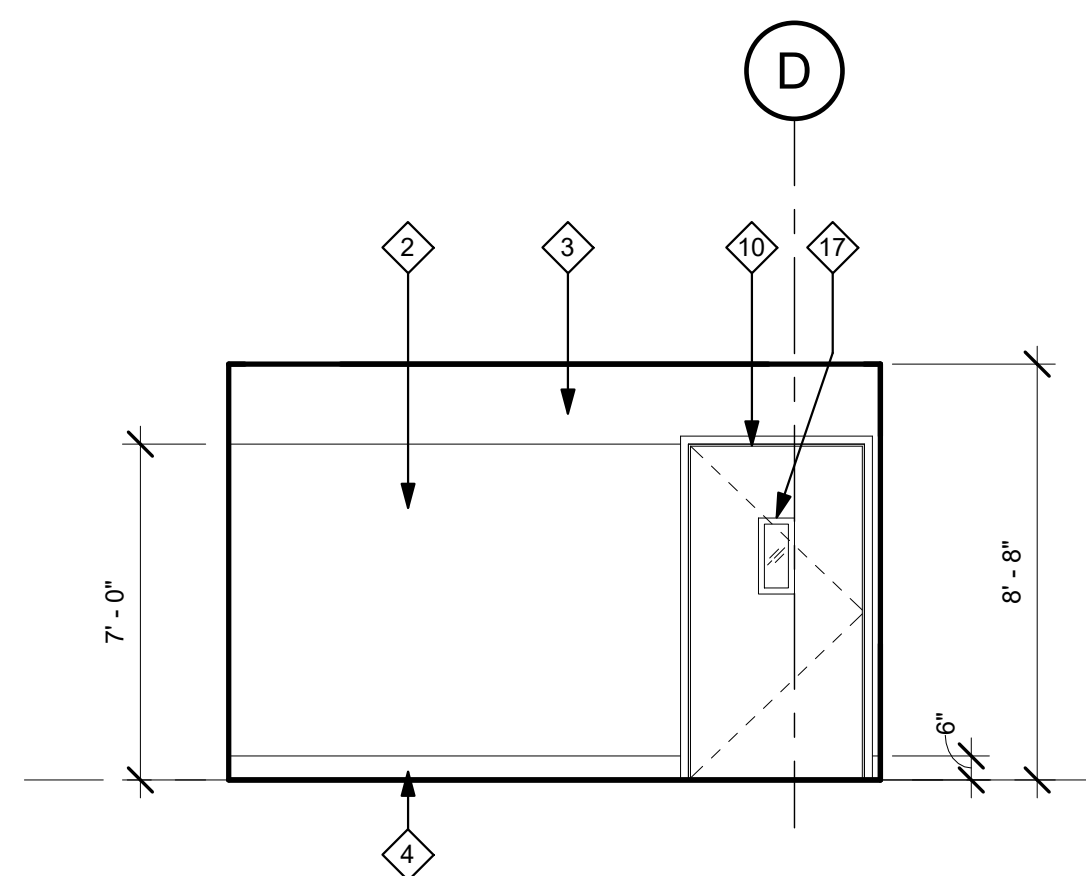

2 OBSERVATION ROOM - EAST
1/4" = 1'-0"

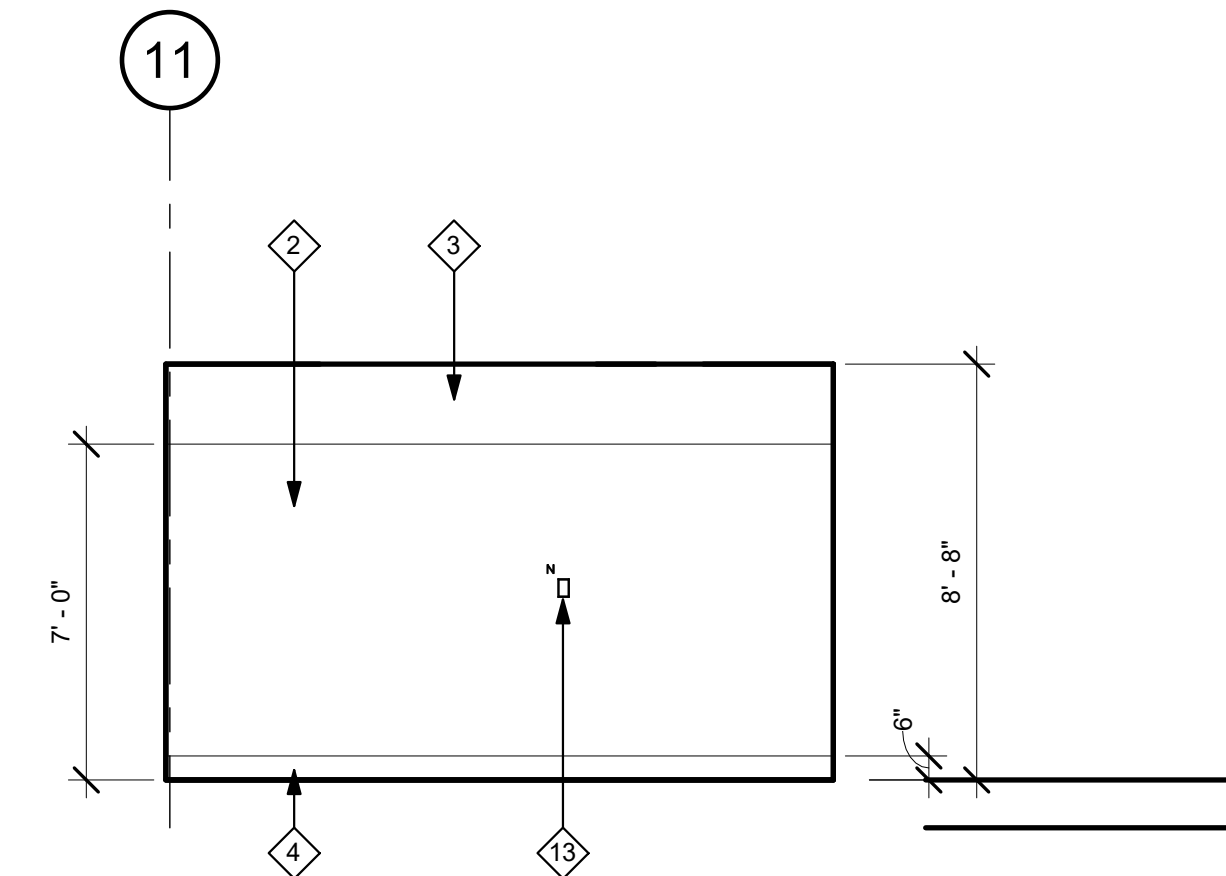

1 OBSERVATION ROOM - NORTH
1/4" = 1'-0"

TCMC OBSERVATION ROOM

TRI-CITY MEDICAL
CENTER
4002 VISTA WAY
OCEANSIDE, CALIFORNIA
92056

OWNER:	TRI-CITY MEDICAL CENTER 4002 VISTA WAY OCEANSIDE, CALIFORNIA 92056 TEL(760)724-8411
ARCHITECT:	SFEIR ARCHITECTS 1350 COLUMBIA STREET, SUITE 603 SAN DIEGO, CALIFORNIA 92101 TEL(619)299-3917 FAX(619)299-5084
STRUCTURAL:	SUN STRUCTURAL ENGINEERING, INC. 2091 LAS PALMAS DRIVE, SUITE D CARLSBAD, CALIFORNIA 92011 TEL(760)438-1188
ME&P:	P2S 9665 CHESAPEAKE, SUITE 230 SAN DIEGO, CALIFORNIA 92123 TEL(619)618-2347

1	1	OSHPD COMMENTS	01/18/2017
2	2	DESIGN CHANGES	01/18/2017
3	3	OSHPD COMMENTS	04/20/2017
4	4	OSHPD COMMENTS	06/14/2017
REV:		DESCRIPTION:	DATE:
CONSULTANT			


OSHPD APPROVAL STAMP:	
OSHPD #: S162581-37-00	
REVIEWED IN ACCORDANCE WITH THE REQUIREMENTS OF T24, CCR	
APPROVED	
Laura Baldrati, Sr. Architect	
Office of Statewide Health Planning & Development	
FACILITIES DEVELOPMENT DIVISION	

SHEET TITLE:
FIRE RATED ASSEMBLIES

PROJECT TITLE:
TCMC OBSERVATION ROOM

PROJECT # 01643.00	SHEET NUMBER:
DRAWN BY: Author	
CHECKED BY: Checker	
SCALE: 12" = 1'-0"	
DATE: 10/11/16	

A5-00

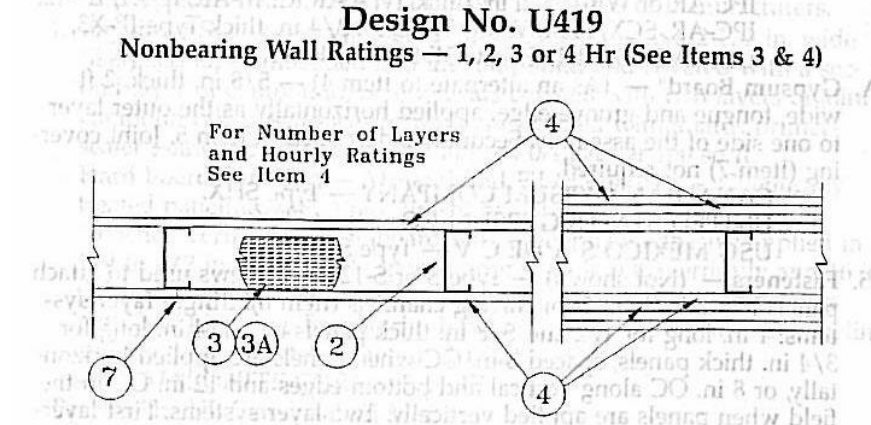

- Floor and Ceiling Runners** — (Not shown) — Channel shaped, fabricated from min 25 MSG corrosion-protected steel, min width to accommodate stud size, with min 1 in. long legs, attached to floor and ceiling with fasteners 24 in. OC max.
- Steel Studs** — Channel shaped, fabricated from min 25 MSG corrosion-protected steel, min width as indicated under Item 4, min 1-1/4 in. flanges and 1/4 in. return, spaced a max of 24 in. OC. Studs to be cut 3/8 to 3/4 in. less than assembly height.
- Batts and Blankets** — (Required as indicated under Item 4) — Mineral wool batts, friction fitted between studs and runners. Min nom thickness as indicated under Item 4. See Batts and Blankets (BKNV or BZJZ) Categories for names of Classified companies.
- Batts and Blankets*** — (Optional) — Placed in stud cavities, any glass fiber or mineral wool insulation bearing the UL Classification Marking was to Surface Burning Characteristics and/or Fire Resistance. See Batts and Blankets (BKNV or BZJZ) Categories for names of Classified companies.
- Gypsum Board*** — Gypsum panels with beveled, square or tapered edges, applied vertically or horizontally. Vertical joints centered over studs and staggered one stud cavity on opposite sides of studs. Vertical joints in adjacent layers (multilayer systems) staggered one stud cavity. Horizontal joints need not be backed by steel framing. Horizontal edge joints and horizontal butt joints on opposite sides of studs need not be staggered. Horizontal edge joints and horizontal butt joints in adjacent layers (multilayer systems) staggered a min of 12 in. The thickness and number of layers for the 1 hr, 2 hr, 3 hr and 4 hr ratings are as follows:
Wallboard Protection on Each Side of Wall


Rating	Min Stud Depth	No. of Layers & Thkns of Panel	Min Thkns of Insulation (Item 3)
1	3-1/2	1 layer, 5/8 in. thick	Optional
1	2-1/2	1 layer, 1/2 in. thick	1-1/2 in.
1	1-5/8	1 layer, 3/4 in. thick	Optional
1	1-5/8	2 layers, 1/2 in. thick	Optional
2	1-5/8	2 layers, 5/8 in. thick	Optional
2	3-1/2	1 layer, 3/4 in. thick	3 in.
3	1-5/8	3 layers, 1/2 in. thick	Optional
3	1-5/8	2 layers, 3/4 in. thick	Optional
3	1-5/8	3 layers, 5/8 in. thick	Optional
4	1-5/8	4 layers, 5/8 in. thick	Optional
4	1-5/8	4 layers, 1/2 in. thick	Optional
4	2-1/2	2 layers, 3/4 in. thick	2 in.

- CANADIAN GYPSUM COMPANY** — 1/2 in. thick Type C, IP-X2, IPC-AR, WRC, 5/8 in. thick Type AR, C, IP-AR, IP-X1, IP-X2, IPC-AR, SCX, SHX, WRX or WRC; 3/4 in. thick Type IP-X3, ULTRACODE, ULTRACODE SHC or ULTRACODE WRC.
- UNITED STATES GYPSUM CO** — 1/2 in. thick Type C, IP-X2, IPC-AR or WRC; 5/8 in. thick Type SCX, SHX, WRX, IP-X1, AR, C, WRC, FRX-G, IP-AR, IP-X2, IPC-AR; 3/4 in. thick Type IP-X3, ULTRACODE, ULTRACODE SHC or ULTRACODE WRC.
- USG MEXICO S A DE C V** — 1/2 in. thick Type C, IP-X2, IPC-AR or WRC; 5/8 in. thick Type AR, C, IP-AR, IP-X1, IP-X2, IPC-AR, SCX, SHX, WRX, WRC or 3/4 in. thick Type IP-X3, ULTRACODE, ULTRACODE SHC or ULTRACODE WRC.
- 4A. Gypsum Board*** — (As an alternate to Item 4) — 5/8 in. thick, 2 ft. wide, tongue and groove edge, applied horizontally as the outer layer to one side of the assembly. Secured as described in Item 5. Joint covering (Item 7) not required.
- CANADIAN GYPSUM COMPANY** — Type SHX.
UNITED STATES GYPSUM CO — Type SHX.
USG MEXICO S A DE C V — Type SHX.
- 5. Fasteners** — (Not shown) — Type 5 or S-12 steel screws used to attach panels to studs (Item 2) or furring channels (Item 6). Single layer systems: 1 in. long for 1/2 and 5/8 in. thick panels or 1-1/4 in. long for 3/4 in. thick panels, spaced 8 in. OC when panels are applied horizontally, or 8 in. OC along vertical and bottom edges and 12 in. OC in the field when panels are applied vertically. Two layer systems: First layer: 1 in. long for 1/2 and 5/8 in. thick panels or 1-1/4 in. long for 3/4 in. thick panels, spaced 16 in. OC. Second layer: 1-5/8 in. long for 1/2 in., 5/8 in. thick panels or 2-1/4 in. long for 3/4 in. thick panels, spaced 16 in. OC with screws offset 6 in. from first layer. Three-layer systems: First layer: 1 in. long for 1/2 in., 5/8 in. thick panels, spaced 24 in. OC. Second layer: 1-5/8 in. long for 1/2 in., 5/8 in. thick panels, spaced 24 in. OC. Third layer: 2-1/4 in. long for 1/2 in., 5/8 in. thick panels or 2-5/8 in. long for 5/8 in. thick panels, spaced 12 in. OC. Screws offset min 6 in. from layer below. Four-layer systems: First layer: 1 in. long for 1/2 in., 5/8 in. thick panels, spaced 24 in. OC. Second layer: 1-5/8 in. long for 1/2 in., 5/8 in. thick panels, spaced 24 in. OC. Third layer: 2-1/4 in. long for 1/2 in. thick panels or 2-5/8 in. long for 5/8 in. thick panels, spaced 24 in. OC. Fourth layer: 2-5/8 in. long for 1/2 in. thick panels or 3 in. long for 5/8 in. thick panels, spaced 12 in. OC. Screws offset min 6 in. from layer below.
- 6. Furring Channels** — (Optional, not shown, for single or double layer systems) — Resilient furring channels fabricated from min 25 MSG corrosion-protected steel, spaced vertically a max of 24 in. OC. Flange portion attached to each intersecting stud with 1/2 in. long Type S-12 steel screws. Not for use with Item 4A.
- 6A. Steel Framing Members (Not Shown)*** — (Optional on one or both sides, not shown, for single or double layer systems) — As an alternate to Item 6, furring channels and Steel Framing Members as described below:
- Furring Channels** — Formed of No. 25 MSG galv steel, 2-3/8 in. wide by 7/8 in. deep, spaced max. 24 in. OC perpendicular to studs. Channels secured to studs as described in Item 6. Gypsum board attached to furring channels as described in Item 5. Not for use with Item 4A.
 - Steel Framing Members*** — Used to attach furring channels (Item 6a) to studs (Item 2). Clips spaced max. 48 in. OC, and secured to studs with No. 8 x 1-1/2 in. minimum self-drilling, S-12 steel screw through the center grommet. Furring channels are friction fitted into clips.
- PAC INTERNATIONAL, INC** — Type RSIC-1.
- 7. Joint Tape and Compound** — Vinyl or casein, dry or premixed joint compound applied in two coats to joints and screw heads of outer layers. Paper tape, nom 2 in. wide, embedded in first layer of compound over all joints of outer layer panels. Paper tape and joint compound may be omitted when gypsum panels are supplied with a square edge.
- 8. Siding, Brick or Stucco** — (Optional, not shown) — Aluminum, vinyl, or steel siding, brick veneer or stucco, meeting the requirements of local code agencies, installed over gypsum panels. Brick veneer attached to studs with corrugated metal wall ties attached to each stud with steel screws, not more than each sixth course of brick.
- 9. Caulking and Sealants*** — (Optional, not shown) — A bead of acoustical sealant applied around the partition perimeter for sound control.
- UNITED STATES GYPSUM CO** — Type AS.
*Bearing the UL Classification Mark

System No. W-L-1001

June 15, 2005

F Ratings — 1, 2, 3 and 4 Hr (See Items 2 and 3)
T Ratings — 0, 1, 2, 3, and 4 Hr (See Item 5)
L Rating at Ambient — Less than 1 CFM/sq ft
L Rating at 400 F — Less than 1 CFM/sq ft

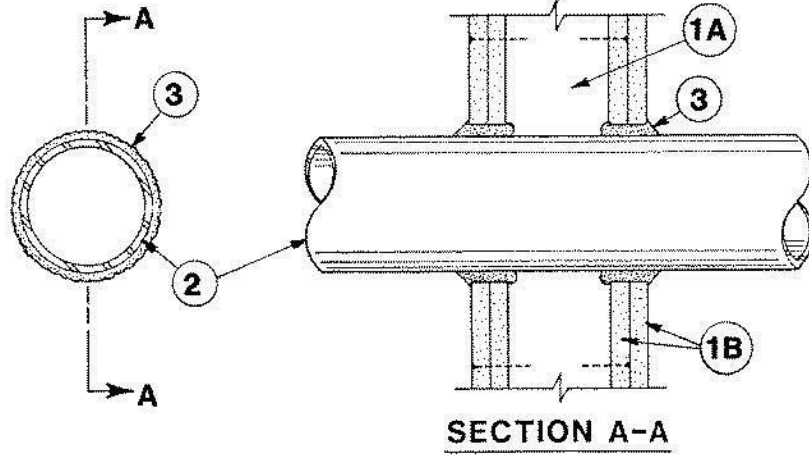

1. Wall Assembly — The 1, 2, 3 or 4 hr fire-rated gypsum wallboard/stud wall assembly shall be constructed of the materials and in the manner described in the individual U300 or U400 Series Wall or Partition Designs in the UL Fire Resistance Directory and shall include the following construction features:

A. Studs — Wall framing may consist of either wood studs (max 2 h fire rated assemblies) or steel channel studs. Wood studs to consist of nom 2 by 4 in. (51 by 102 mm) lumber spaced 16 in. (406 mm) OC with nom 2 by 4 in. (51 by 102 mm) lumber end plates and cross braces. Steel studs to be min 3-5/8 in. (92 mm) wide by 1-3/8 in. (35 mm) deep channels spaced max 24 in. (610 mm) OC.

B. Gypsum Board* — Nom 1/2 or 5/8 in. (13 or 16 mm) thick, 4 ft. (122 cm) wide with square or tapered edges. The gypsum wallboard type, thickness, number of layers, fastener type and sheet orientation shall be as specified in the individual U300 or U400 Series Design in the UL Fire Resistance Directory. Max diam of opening is 26 in. (660 mm).

2. Through-Penetrant — One metallic pipe, conduit or tubing installed either concentrically or eccentrically within the firestop system. The annular space between pipe, conduit or tubing and periphery of opening shall be min of 0 in. / (0 mm) (point contact) to max 2 in. (51 mm) Pipe conduit or tubing to be rigidly supported on both sides of wall assembly. The following types and sizes of metallic pipes, conduits or tubing may be used:

A. Steel Pipe — Nom 24 in. (610 mm) diam (or smaller) Schedule 10 (or heavier) steel pipe.

B. Iron Pipe — Nom 24 in. (610 mm) diam (or smaller) service weight (or heavier) cast iron soil pipe, nom 12 in (305 mm) diam (or smaller) or Class 50 (or heavier) ductile iron pressure pipe.

C. Conduit — Nom 6 in. (152 mm) diam (or smaller) steel conduit or nom 4 in (102 mm) diam (or smaller) steel electrical metallic tubing

D. Copper Tubing — Nom 6 in. (152 mm) diam (or smaller) Type L (or heavier) copper tubing

E. Copper Pipe — Nom 6 in. (152 mm) diam (or smaller) Regular (or heavier) copper pipe.

F. Through Penetrating Product* — Flexible Metal Piping The following types of steel flexible metal gas piping may be used:

1. Nom 2 in. (51 mm) diam (or smaller) steel flexible metal gas piping. Plastic covering on piping may or may not be removed on both sides of floor or wall assembly.

OMEGA FLEX INC
2. Nom 1 in. (25 mm) diam (or smaller) steel flexible metal gas piping. Plastic covering on piping may or may not be removed on both sides of floor or wall assembly.

GASTITE, DIV OF TITEFLEX

3. Nom 1 in. (25 mm) diam (or smaller) steel flexible metal gas piping. Plastic covering on piping may or may not be removed on both sides of floor or wall assembly.

WARD MFG L L C

3. Fill, Void or Cavity Material* — Caulk or Sealant — Min 5/8 in., 1-1/4, 1-7/8 and 2-1/2 in. (16, 32, 48 and 64 mm) thickness of caulk for 1, 2, 3 and 4 hr rated assemblies, respectively, applied within annulus, flush with both surfaces of wall. Min 1/4 in. (6 mm) diam bead of caulk applied to gypsum board/penetrant interface at point contact location on both sides of wall. The hourly F Rating of the firestop system is dependent upon the hourly fire rating of the wall assembly in which it is installed, as shown in the following table. The hourly T Rating of the firestop system is dependent upon the type or size of the pipe or conduit and the hourly fire rating of the wall assembly in which it is installed, as tabulated below.

Max Pipe or Conduit Diam In (mm)	F Rating Hr	T Rating Hr
1(25)	1 or 2	0+, 1 or 2
1(25)	3 or 4	3 or 4
4(102)	1 or 2	0
6(152)	3 or 4	0
12(305)	1 or 2	0

*When copper pipe is used, T Rating is 0 hr.

3M COMPANY — CP 25WB+ or FB-3000 WVT.

*Bearing the UL Classification Mark

2 METALLIC WALL PENETRATION
12" = 1'-0"

1 RATED WALL
12" = 1'-0"


GENERAL NOTES:

- 1. THE GENERAL CONTRACTOR SHALL VERIFY ALL EXISTING CONDITIONS AND MEASUREMENTS IN THE FIELD PRIOR TO STARTING CONSTRUCTION.
- 2. REFER TO GENERAL NOTES ON SHEET A0-00 FOR INFORMATION NOT INDICATED ON THIS SHEET.


GENERAL NOTES FOR PARTITIONS:

- 1. ALL GYP. BOARD SHALL BE TYPE 'X'. REFER TO FLOOR PLAN FOR LOCATION OF WALL TYPES.
- 2. REFER TO THE INTERIOR DESIGN SHEET AND RELATED DETAILS FOR FINISHES REQUIRED AND TO THE MANUFACTURER FOR SURFACE PREP. REQUIREMENTS.
- 3. REFER TO THE FLOOR PLAN, INTERIOR ELEVATIONS, DETAILS, MECHANICAL, PLUMBING, AND ELECTRICAL PLANS FOR WALL BACKING REQUIREMENTS AND IN WALL UTILITIES.
- 4. ALL DOOR JAMBS AND OPENINGS SHALL BE DOUBLE STUDDED WITH 16 GA. STUDS EXTENDED TO STRUCTURE ABOVE REFER TO 4/A5-00 WHERE STUDS CANNOT EXTEND TO STRUCTURE ABOVE DUE TO OBSTRUCTIONS, BRACE PER DETAIL 5/A5-00 FRAME ALL OPENINGS PER HEADER DETAILS 5 AND 6 ON A6-00.
- 5. PROVIDE 6" STEEL STUDS AT ALL WALLS AND/OR WALLS WHERE RECESSED ELECTRICAL PANELS OR FIRE EXTINGUISHER CABINETS ARE LOCATED UNLESS NOTED OTHERWISE. COORDINATE WITH RELATED SUB-CONTRACTORS.
- 6. PROVIDE STEEL TRACK BACKING AT ALL WALL MOUNTED DOOR STOPS. REFER 10/S-1.
- 7. ALL STUDS SUPPORTING WALL HUNG CABINETS SHALL BE MIN. 16 GA. STUDS SPACED AT 16" O.C. MAXIMUM. REFER TO DETAILS 02 AND 03/A5-80 FOR REQUIRED BACKING MATERIAL AND CONNECTION.
- 8. ALL RATED WALLS (FIRE AND SMOKE) SHALL BE CONSTRUCTED SO THAT SECONDARY ALLS DO NOT PENETRATE SYSTEM. ALL PENETRATIONS SHALL BE SEALED W/ UL LISTED FIRE STOP SEALANT, UL LISTED ASSEMBLIES OR APPROVED EQUAL.
- 9. SUBMITTAL FOR WALL MATERIALS SHALL BE PROVIDED TO SUBSTANTIATE THE PROPOSED MATERIALS HAVE BEEN TESTED BY A RECOGNIZED TESTING AGENCY THE REQUIRED RATINGS AND PERFORMANCE LEVELS OF THE SPECIFIED MATERIALS.
- 10. ALL PENETRATIONS IN RATED WALLS OVER 16 SQ. INCHES SHALL BE BACK WRAPPED WITH 5/8" TYPE 'X' GYP. BD. UNPROTECTED PENETRATIONS UNDER 16 SQ. INCHES SHALL NOT EXCEED 100 SQ. INCHES TOTAL FOR EACH 100 SQ. FEET OF WALL AREA. WHERE SUCH UNPROTECTED OPENINGS OCCUR ON OPPOSITE SIDES OF THE WALL SEPARATE THESE OPENINGS BY MIN. 24 INCHES.
- 11. DOOR OPENINGS SHALL BE PROTECTED BY A U.L. LISTED (OR EQUAL) DOOR AND DOOR FRAME. ALL RATED DOORS SHALL BE POSITIVE LATCHING, AUTOMATIC CLOSING AND GASKETED TO PREVENT THE PASSAGE OF SMOKE. DOORS EQUIPPED WITH A HOLD OPEN DEVICE SHALL BE INTERCONNECTED TO THE FIRE ALARM WHICH SHALL CLOSE THE DOOR UPON ACTIVATION.
- 12. COMPLY WITH THE FOLLOWING I.C.C. REPORTS:
"CEMCO"- I.C.C. #ER-3403P (STUDS AND TRACKS)
"TIV RAMSET/REDHEAD"- I.C.C. #1639
REFER TO THE FOLLOWING TABLE FOR ALLOWABLE WALL HEIGHTS. HEIGHTS ARE FOR NON-LOAD BEARING STEEL STUDS USED FOR INTERIOR PARTITIONS WITH BOTH FLANGES OF STUDS CONTINUOUSLY BRACED WITH GYP. BOARD OR FLAT STRAPS. ALLOWABLE HEIGHTS ARE THOSE LISTED WITHIN THE I.C.C. REPORT. BRACE ALL STUDS AS REQUIRED SO AS NOT TO EXCEED THOSE ALLOWED HEIGHTS SET BY THE MFR. AND THE I.C.C. REPORT. SUBMIT FOR APPROVAL, CURRENT I.C.C. REPORT.


STUD	DESIGNATION	MAXIMUM HEIGHT		REMARKS
		16" O.C.	24" O.C.	
3 5/8"-18 GA.	362S200	16'-1"	14'-1"	INTERIOR ONLY
6"-16 GA.	600S200	24'-1"	21'-1"	INTERIOR ONLY

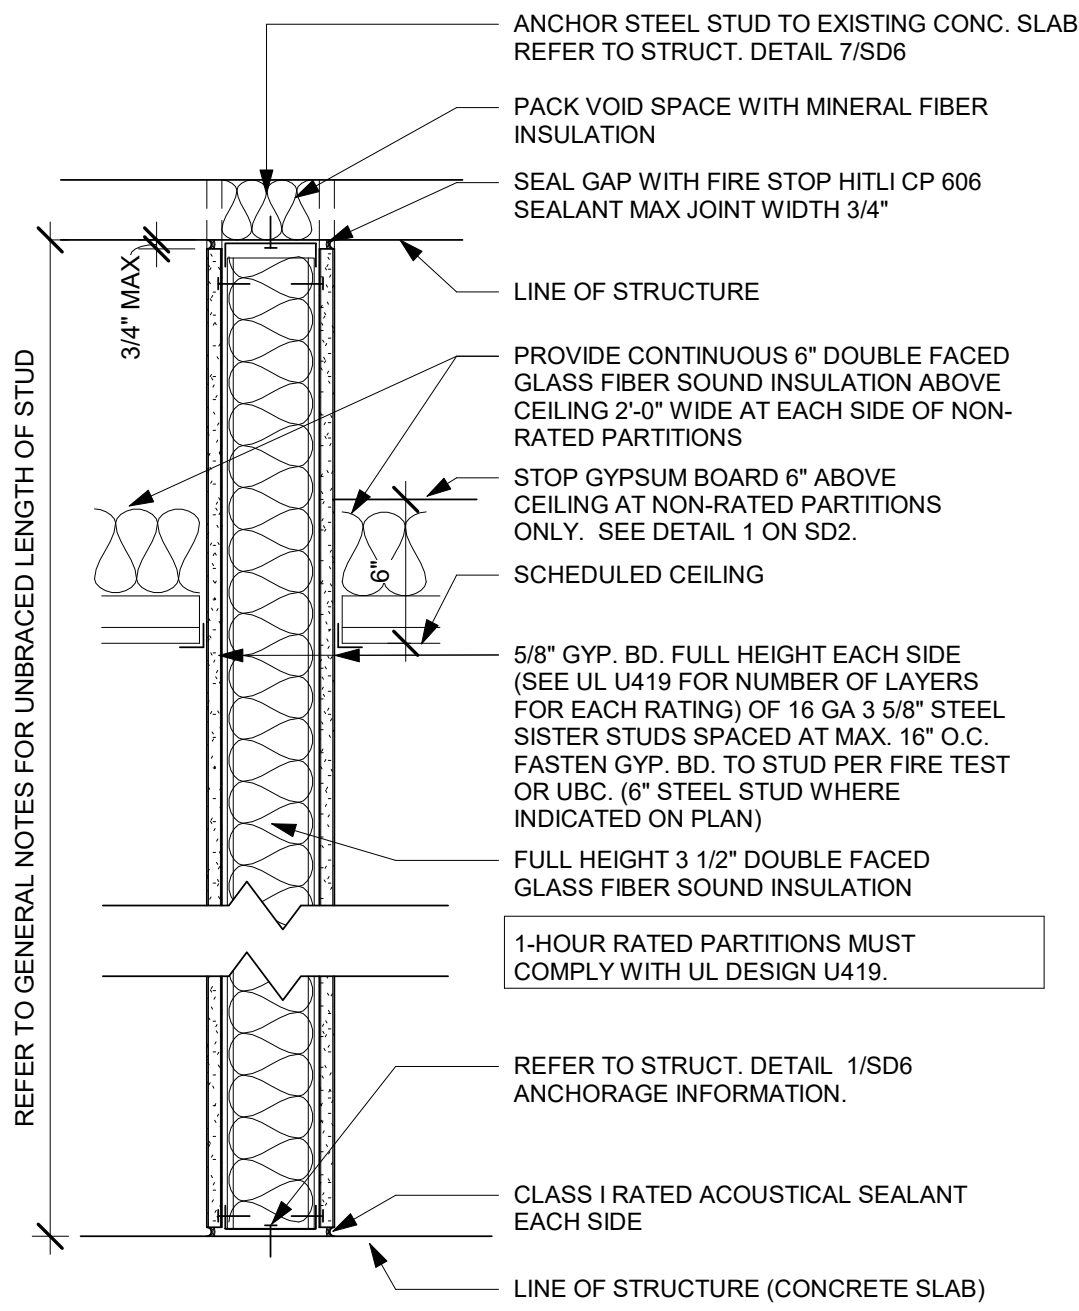


4 WALL TYPE "A1" - RATED
1 1/2" = 1'-0"

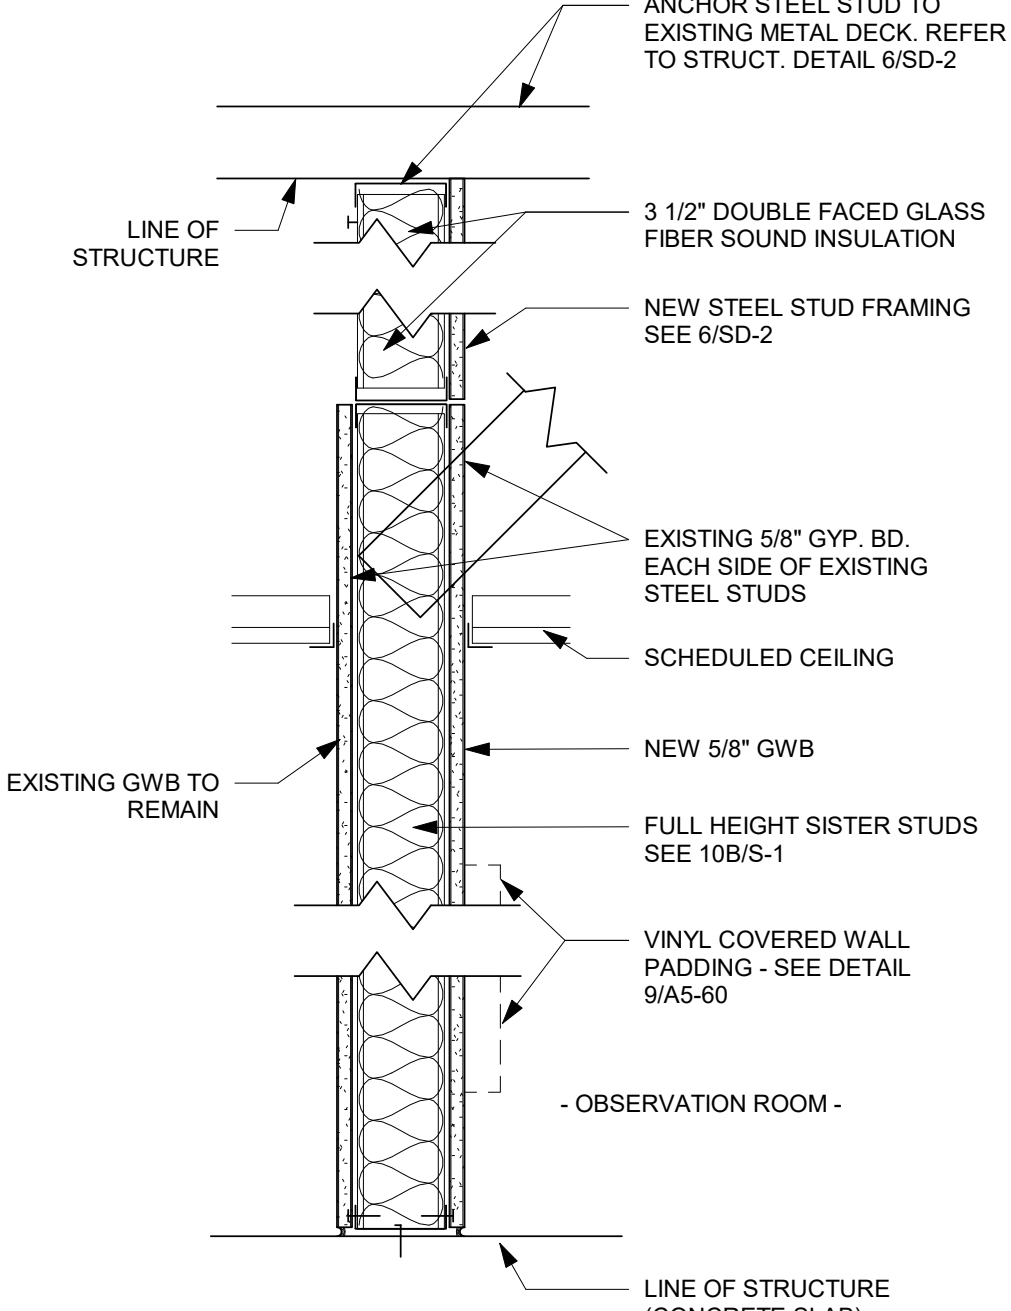

3 WALL TYPE "C" - NOT RATED
1 1/2" = 1'-0"

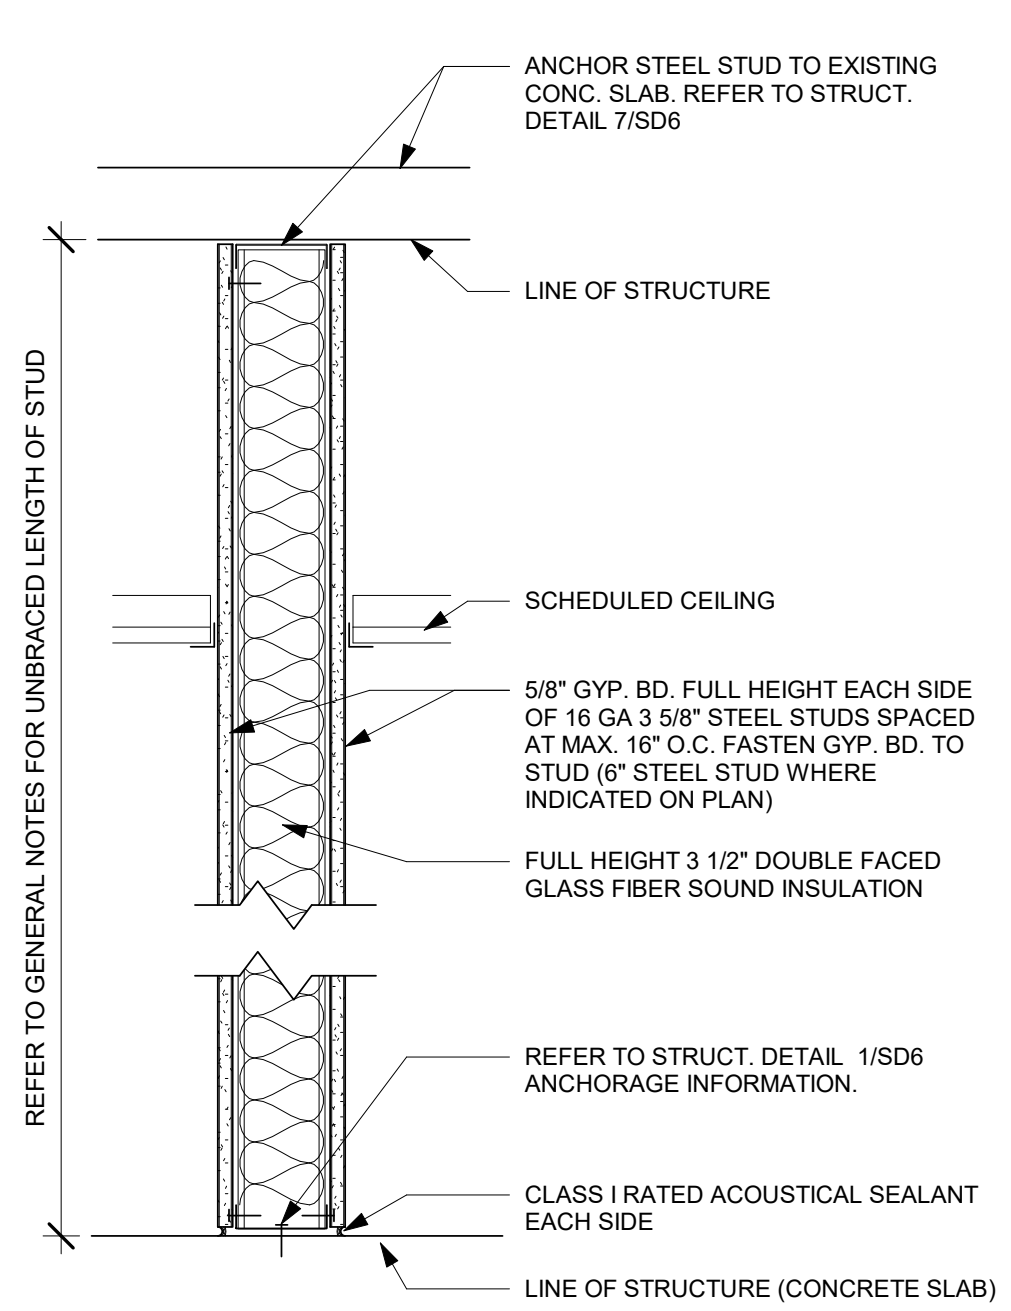

2 WALL TYPE "B" - NOT RATED
1 1/2" = 1'-0"

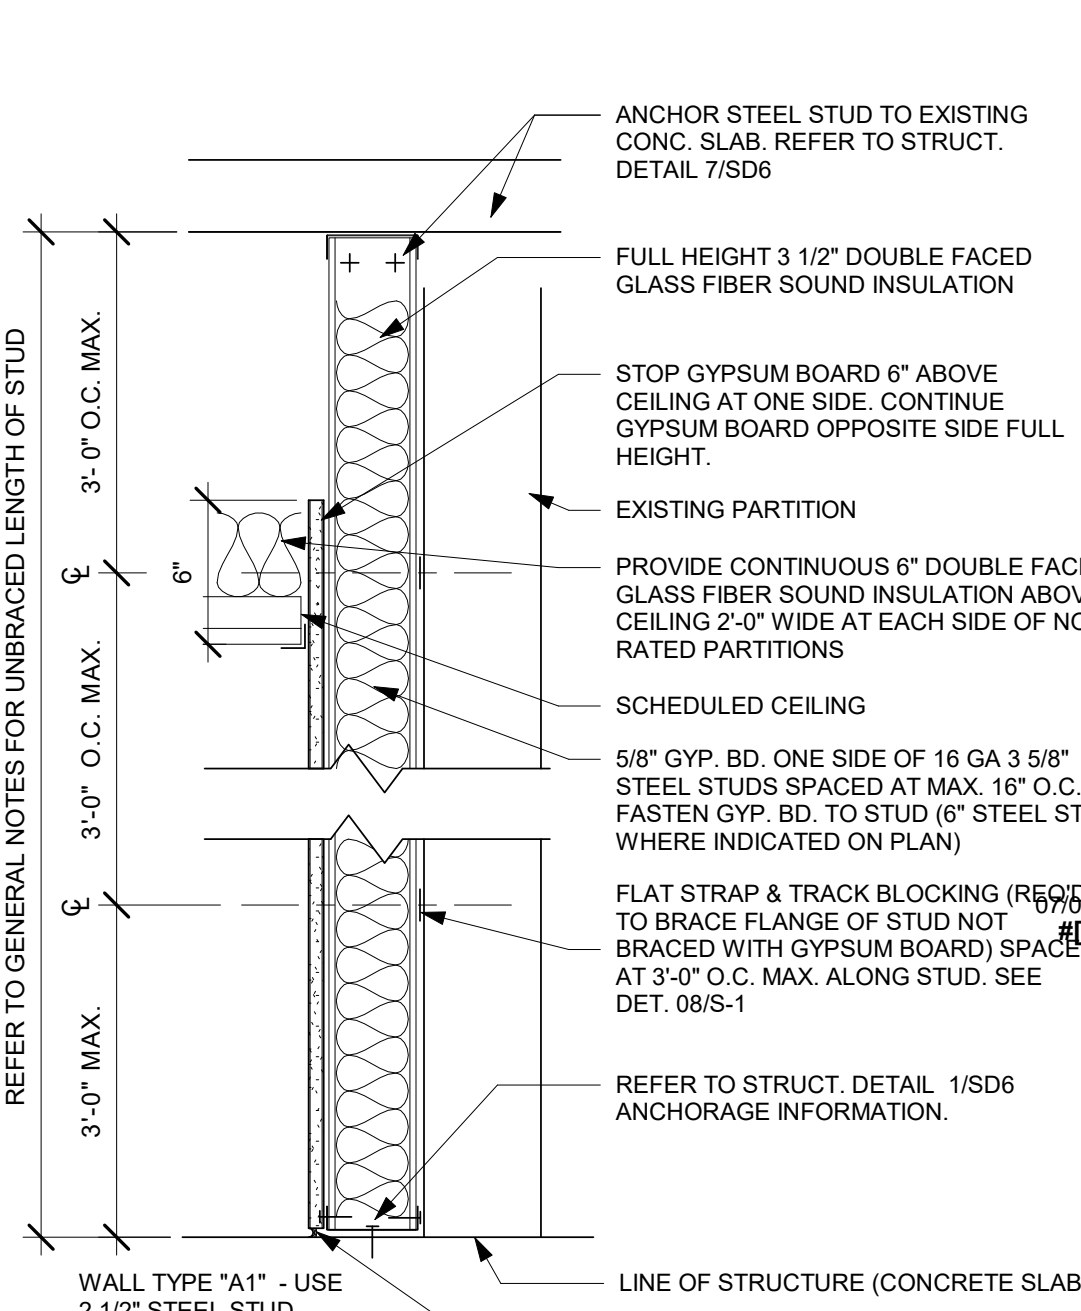

1 WALL TYPE "A" - NOT RATED
1 1/2" = 1'-0"

S F E I R
A R C H I T E C T S

1350 Columbia Street, Suite 603
San Diego, CA 92101

P: 619-299-3917
F: 619-299-5084
www.sfeirarch.com

TCMC
OBSERVATION
ROOM

TRI-CITY MEDICAL
CENTER
4002 VISTA WAY
OCEANSIDE, CALIFORNIA
92056

OWNER: TRI-CITY MEDICAL CENTER
4002 VISTA WAY
OCEANSIDE, CALIFORNIA 92056
TEL(760)724-8411

ARCHITECT: SFEIR ARCHITECTS
1350 COLUMBIA STREET, SUITE 603
SAN DIEGO, CALIFORNIA 92101
TEL(619)299-3917 FAX(619)299-5084

STRUCTURAL: SUN STRUCTURAL ENGINEERING, INC.
2091 LAS PALMAS DRIVE, SUITE D
CARLSBAD, CALIFORNIA 92011
TEL(760)438-1188

ME&P: P2S
9665 CHESAPEAKE, SUITE 230
SAN DIEGO, CALIFORNIA 92123
TEL(619)618-2347



1	1	OSHDP COMMENTS	01/18/2017
2	2	DESIGN CHANGES	01/18/2017
3	3	OSHDP COMMENTS	04/20/2017
4	4	OSHDP COMMENTS	06/14/2017

REV: DESCRIPTION: DATE:

CONSULTANT

OSHDP APPROVAL STAMP:
OSHDP #: S162581-37-00



SHEET TITLE:
TYPICAL RATED
PARTITION ASSEMBLIES

PROJECT TITLE:
TCMC OBSERVATION ROOM

PROJECT #
01643.00

DRAWN BY:
Author

CHECKED BY:
Checker

SCALE:
As indicated

DATE:
10/11/16

SHEET NUMBER:
A5-01

TCMC OBSERVATION ROOM


TRI-CITY MEDICAL CENTER 4002 VISTA WAY OCEANSIDE, CALIFORNIA 92056

OWNER: TRI-CITY MEDICAL CENTER
4002 VISTA WAY
OCEANSIDE, CALIFORNIA 92056
TEL(760)724-8411

ARCHITECT: SFEIR ARCHITECTS
1350 COLUMBIA STREET, SUITE 603
SAN DIEGO, CALIFORNIA 92101
TEL(619)299-3917 FAX(619)299-5084

STRUCTURAL: SUN STRUCTURAL ENGINEERING, INC.
2091 LAS PALMAS DRIVE, SUITE D
CARLSBAD, CALIFORNIA 92011
TEL(760)438-1188

ME&P: P2S
9665 CHESAPEAKE, SUITE 230
SAN DIEGO, CALIFORNIA 92123
TEL(619)618-2347

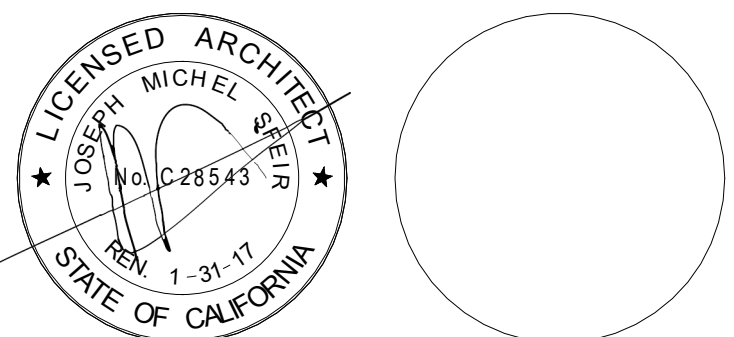

1	OSHPD COMMENTS	01/18/2017
2	DESIGN CHANGES	01/18/2017
3	OSHPD COMMENTS	04/20/2017
4	OSHPD COMMENTS	06/14/2017

REV: DESCRIPTION: DATE:

CONSULTANT

OSHPD APPROVAL STAMP:
OSHPD #: S162581-37-00



Laura Baldrati, Sr. Architect

Office of Statewide Health
Planning & Development
FACILITIES DEVELOPMENT DIVISION

SHEET TITLE:
DETAILS

PROJECT TITLE:
TCMC OBSERVATION ROOM

PROJECT #
01643.00
DRAWN BY:
Author
CHECKED BY:
Checker
SCALE:
As indicated
DATE:
10/11/16

SHEET NUMBER:
A5-60

GENERAL NOTES:

1. THE GENERAL CONTRACTOR SHALL VERIFY ALL EXISTING CONDITIONS AND MEASUREMENTS IN THE FIELD PRIOR TO STARTING CONSTRUCTION.

2. REFER TO GENERAL NOTES ON SHEET A0-00 FOR INFORMATION NOT SHOWN AT THIS SCALE.

GENERAL NOTES GWB CEILING:

DRYWALL CEILING SUSPENSION; CONVENTIONAL CONSTRUCTION
REF: CBC 2007 AND ASCE 7-05.


- (A) GENERAL: GYP BD SUSPENDED CEILING SYSTEMS SHALL BE DESIGNED & CONSTRUCTED IN ACCORDANCE WITH CBC 2007 AND THE FOLLOWING INTERPRETATIONS:
- (B) MATERIALS. MATERIALS ARE TO COMPLY WITH APPLICABLE CBC STANDARDS
- (C) DESIGN. FOR LATERAL LOAD - REFER TO ASCE 7-05 SECTION 13.5.6 FOR LATERAL FORCE BRACING.
- (D) DETAILS OF CONSTRUCTION.

- (1) GENERAL: GYP BD CEILINGS SHALL NOT SUPPORT MATERIALS OR BUILDING COMPONENTS OTHER THAN GRILLES, LIGHT FIXTURES, SMALL ELECT. CONDUITS, SMALL DUCTS AND THE LIKE. ALL SUCH COMPONENTS SHOULD BE SUPPORTED EITHER DIRECTLY FROM MAIN RUNNERS, OR BY SUPPLEMENTAL FRAMING WHICH IS SUPPORTED BY MAIN RUNNERS. NO VERTICAL LOADS OTHER THAN GYPBOARD DEAD LOAD SHOULD BE APPLIED TO CROSS- FURRING.
- (2) VERTICAL SUPPORT SYSTEM.


- (A) HANGER WIRES AND MAIN RUNNERS SHALL BE SPACED AT 4'-0" EA. WAY O.C. MAXIMUM. COMPLY WITH THE FOLLOWING REQUIREMENTS:
- VERTICAL HANGER WIRES SHALL BE NO. 8 GA. & GALVANIZED, SPACED 4'- 0" EA. WAY O.C. MAXIMUM.
 - MAIN RUNNERS SHALL BE 1-1/2"-1.12 LB/FT, HOT-ROLLED CHANNEL.
 - CROSS-FURRING SHALL BE 1"-0.410 LB/FT, HOT ROLLED CHANNEL 24" MAX. O.C.
- (B) THE FOLLOWING REQUIREMENTS APPLY TO ALL WIRE HANGER/RUNNER COMBINATIONS:
- HANGERS SHALL BE SADDLE-TIED AROUND MAIN RUNNERS TO DEVELOP THE FULL STRENGTH OF THE HANGERS.
 - CROSS-FURRING SHALL BE SADDLE-TIED TO THE MAIN RUNNERS WITH ONE STRAND OF NO. 16 OR TWO STRANDS OF NO. 18 GAGE WIRE.
 - MAIN RUNNERS SHALL BE SPLICED BY LAPPING AND INTERLOCKING FLANGES 12" MINIMUM AND TYING NEAR EACH END WITH DOUBLE LOOPS OF NO. 16 GAGE WIRE.
 - CROSS-FURRING SHALL BE SPLICED BY LAPPING AND INTERLOCKING THE PIECES 8" MINIMUM AND TYING NEAR EACH END WITH DOUBLE LOOPS OF NO. 16 GAGE WIRE AND 2#10 SMS.
 - A MAIN RUNNER SHALL BE PLACED WITHIN 8" OF PARALLELING WALLS.
 - THE ENDS OF MAIN RUNNERS AT WALLS SHALL BE SUPPORTED 8" MAXIMUM FROM THEIR ENDS BY VERTICAL HANGERS. END WITH DOUBLE LOOPS OF NO. 16 GAGE WIRE.
 - SHEET METAL SCREWS SHALL BE 1-1/4" HI-LO S BUGLE HEAD SCREWS SPACED 12" O.C. MAXIMUM. SCREW EDGE DISTANCE GYPSUM BOARD SHALL BE 3/8" MIN. SUBSTITUTION OF 1" LONG SCREWS FOR 1-1/4" LONG SCREWS IS PERMITTED.
- (C) THE FOLLOWING REQUIREMENTS APPLY TO ALL HANGER WIRES AND BRACING WIRES:
- HANGER WIRES SHALL BE FASTENED WITH NOT LESS THAN 3 TIGHT TURNS. BRACING WIRES SHALL BE FASTENED WITH NO LESS THAN 4 TIGHT TURNS. MAKE ALL TIGHT TURNS WITHIN A DISTANCE OF 1-1/2" HANGER OR BRACING WIRE ANCHORS TO THE STRUCTURE SHALL BE INSTALLED IN SUCH A MANNER THAT THE DIRECTION OF THE FORCES ACTING ON THE WIRE. NOTE: WIRE TURNS MADE BY MACHINE WHERE BOTH STRANDS HAVE BEEN DEFORMED OR BENT IN WRAPPING CAN WAIVE THE 1-1/2" REQUIREMENT, BUT THE NUMBER OF TURNS SHALL BE MAINTAINED, AND BE AS TIGHT AS POSSIBLE.
 - SEPARATE ALL CEILING HANGING AND BRACING WIRES BY AT LEAST 6" FROM ALL UNBRACED DUCTS, PIPES, CONDUIT, ETC. IT IS ACCEPTABLE TO ATTACH LIGHTWEIGHT ITEMS, SUCH AS SINGLE ELECTRICAL CONDUIT, NOT EXCEEDING 3/4" NOMINAL DIAMETER, TO HANGER WIRES ONLY, USING ACCEPTABLE CONNECTORS.
 - WHEN DRILLED-IN CONCRETE ANCHORS OR SHOT-IN ANCHORS ARE USED IN REINFORCED CONCRETE FOR HANGER WIRES, 1 OUT OF 10 MUST BE FIELD TESTED FOR 200 POUNDS OF TENSION. WHEN DRILLED-IN CONCRETE ANCHORS ARE USED FOR BRACING OUT OF 2 MUST BE FIELD TESTED FOR 440 POUNDS OF TENSION. SHOT-IN ANCHORS IN CONCRETE ARE NOT PERMITTED FOR BRACING WIRES.

- (D) LIGHT FIXTURE SUPPORT.
- ALL RECESSED OR DROP-IN LIGHT FIXTURES SHALL BE SUPPORTED DIRECTLY BY MAIN RUNNERS OR BY SUPPLEMENTAL FRAMING WHICH IS SUPPORTED BY MAIN RUNNERS.
 - SURFACE MOUNTED FIXTURES SHALL BE ATTACHED TO A MAIN RUNNER WITH A POSITIVE CLAMPING DEVICE MADE OF WITH A MINIMUM OF 14 GAGE, ROTATIONAL SPRING CATCHES NOT COMPLY.
- (E) LATERAL SYSTEM
- SEISMIC BRACE TO CEILING ABOVE AS FOR ACOUSTICAL TILE SUSPENSION SYSTEM. USE #12 DIAGONAL WIRES SPACED ON A 8'x12' GRID AND WITHIN 4'-0" OF WALLS. SEISMIC BRACE LOCATED AT INTERSECTION OF MAIN RUNNER AND MEMBER. PROVIDE CONNECTION BETWEEN DIAGONAL MAIN RUNNER SO AS TO PREVENT SLIPPING FOR A 200# APPROXIMATE SEISMIC LOAD.
 - PROVIDE "LATERAL FORCE BRACING" NOTES PER CBC, FOR HOSPITALS MAX. SPACING OF COMPRESSION STRUTS AT 8'-0" X 12'-0". REFER TO DSA I.R'S 25-2 AND 25-3.


- (F) MATERIAL DO
- (G) TO BE CROSS-FURRING WIRES AND

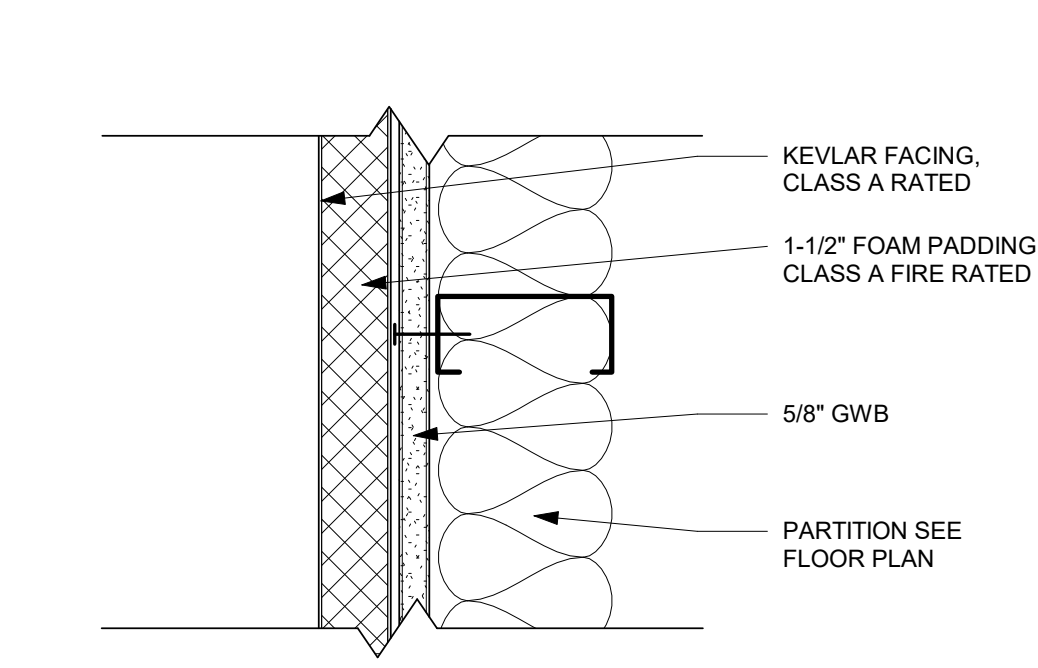


9 VINYL PADDING AT PARTITION
3" = 1'-0"

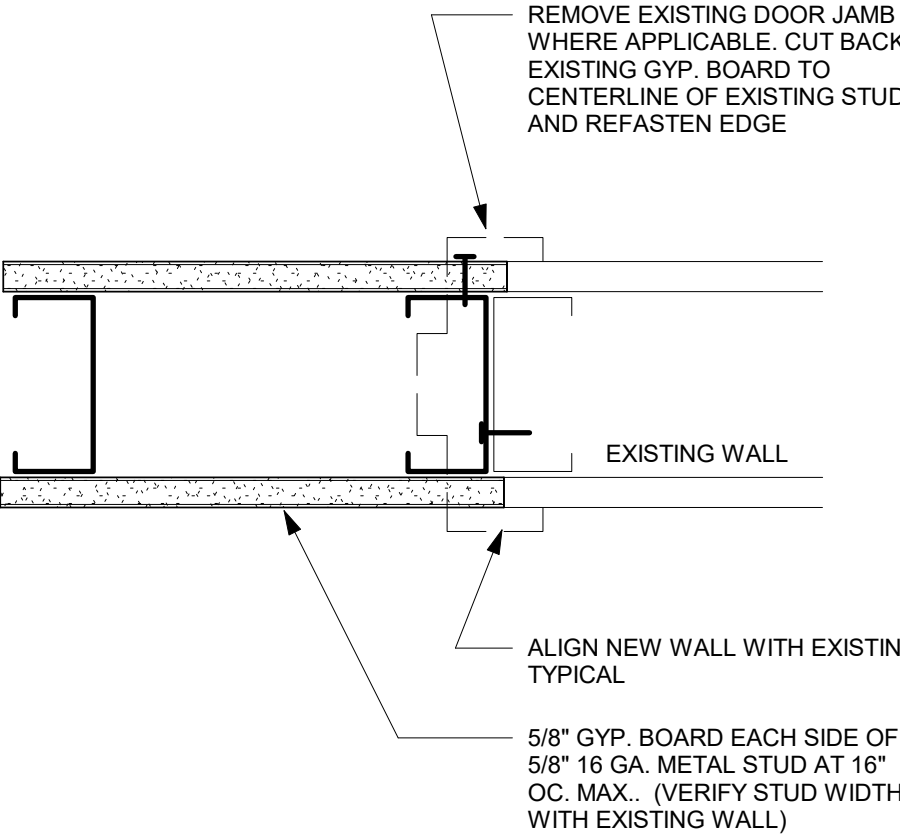


10 INFILL WALL OPENING
3" = 1'-0"

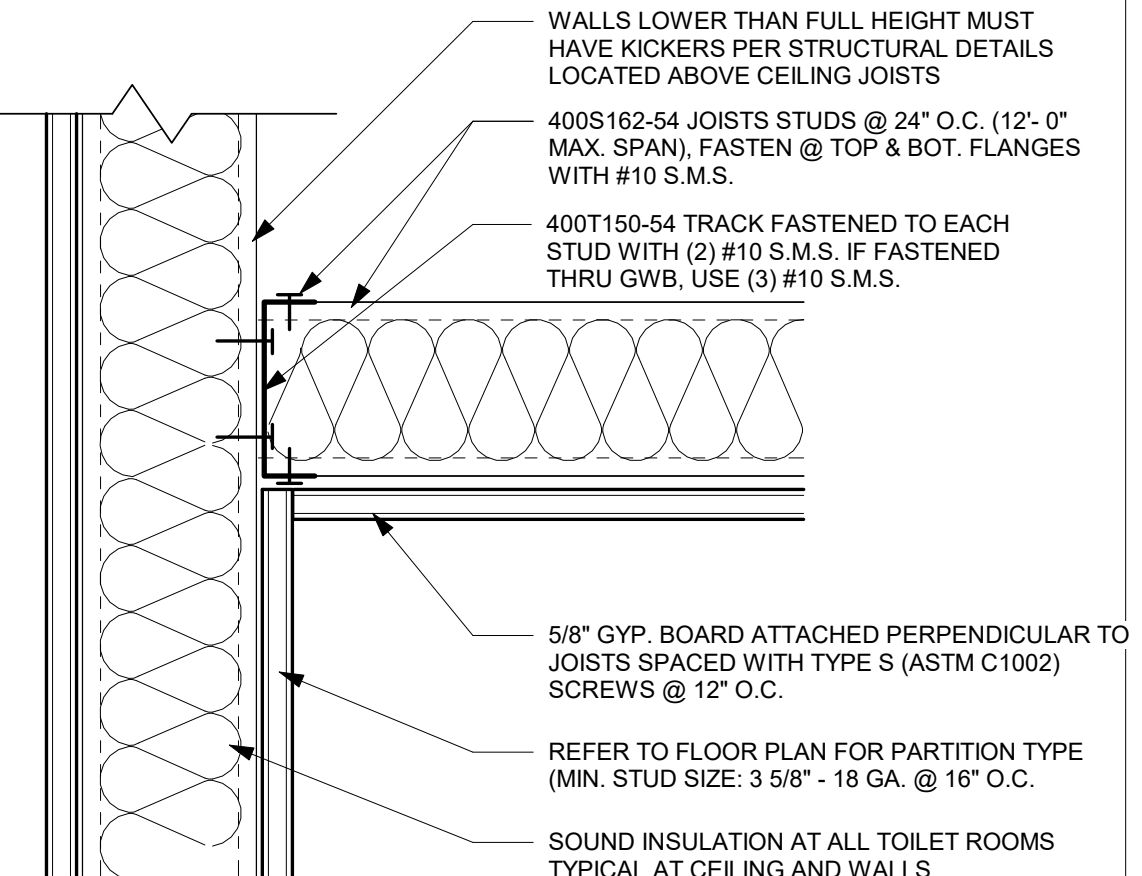


6 JOISTED GYPSUM CEILING
3" = 1'-0"

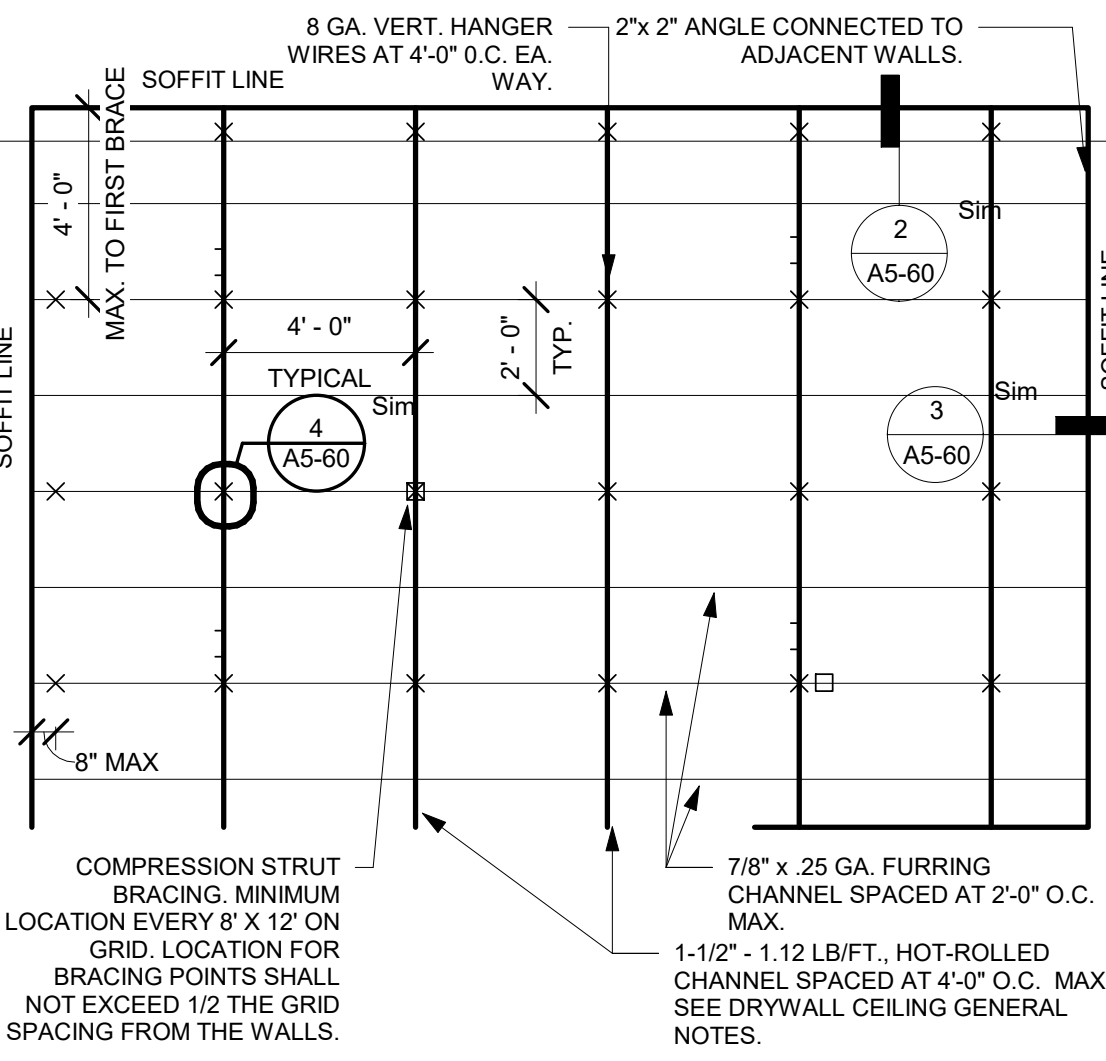


1 DIAGRAMMATIC CEILING
1/4" = 1'-0"

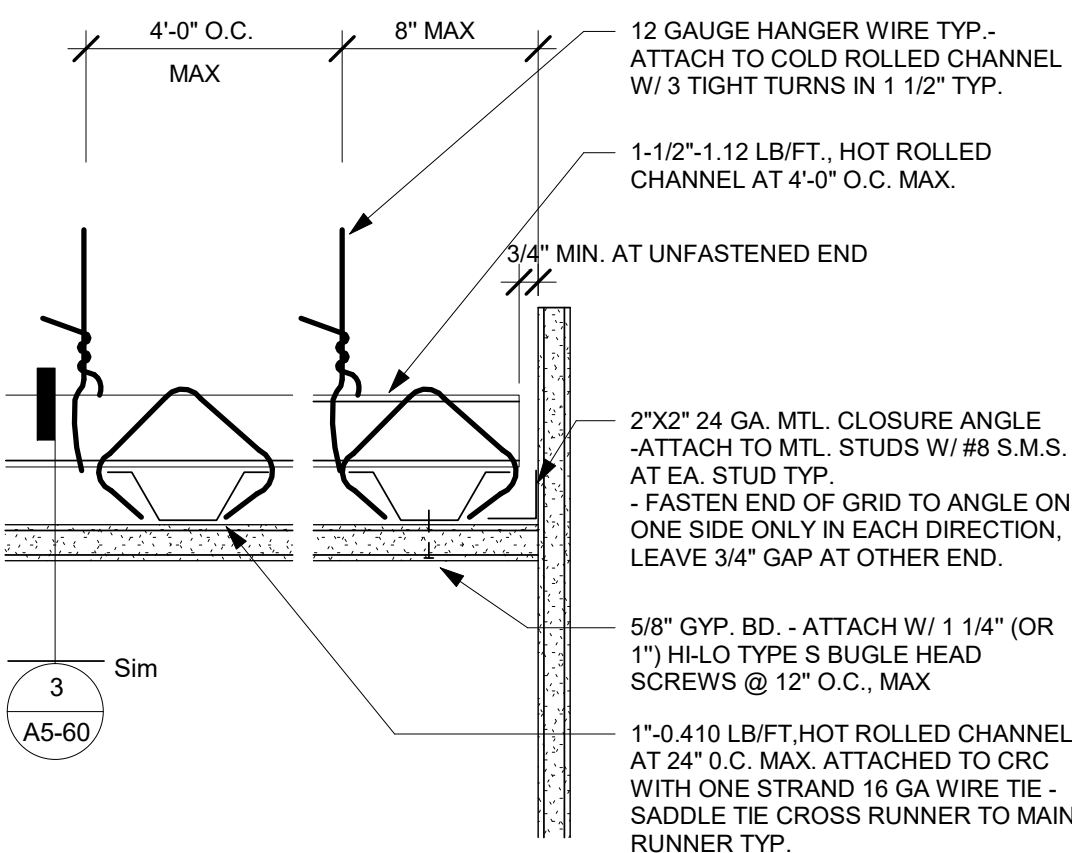

2 CEILING SUPPORT (PERPENDICULAR)1
12" = 1'-0"

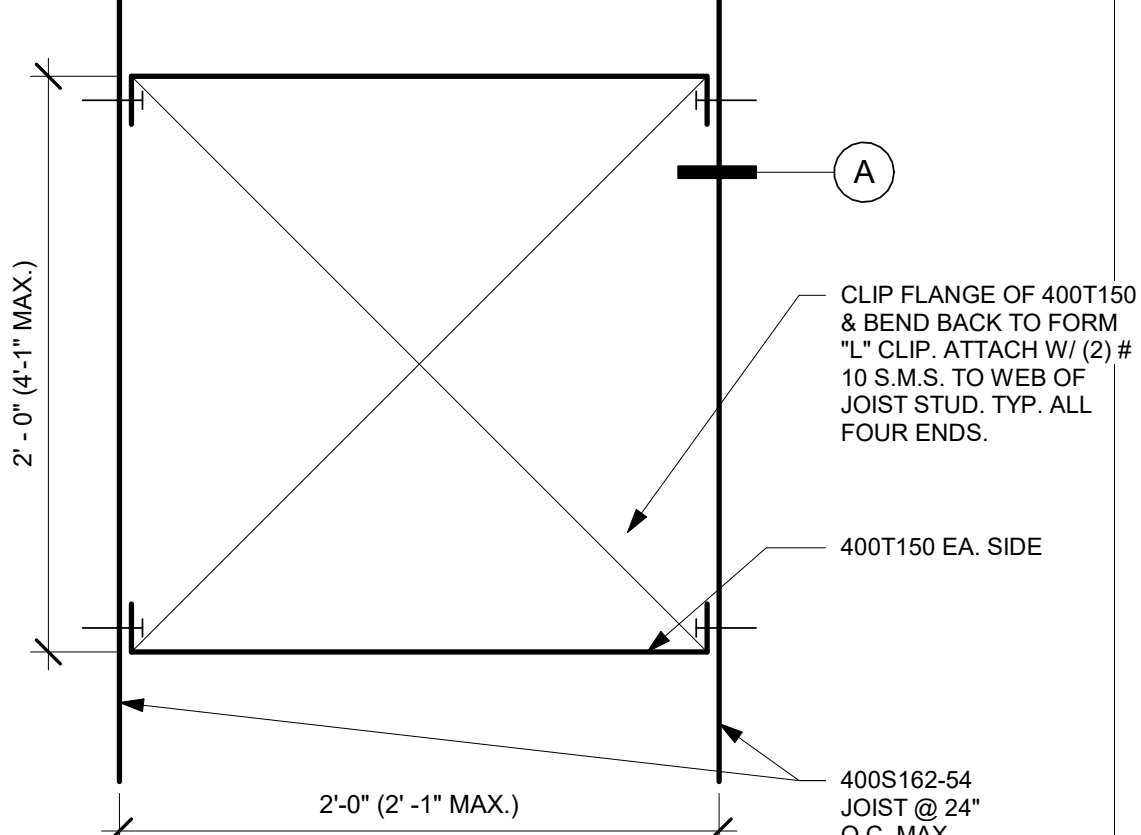


B OPENING FRAMING

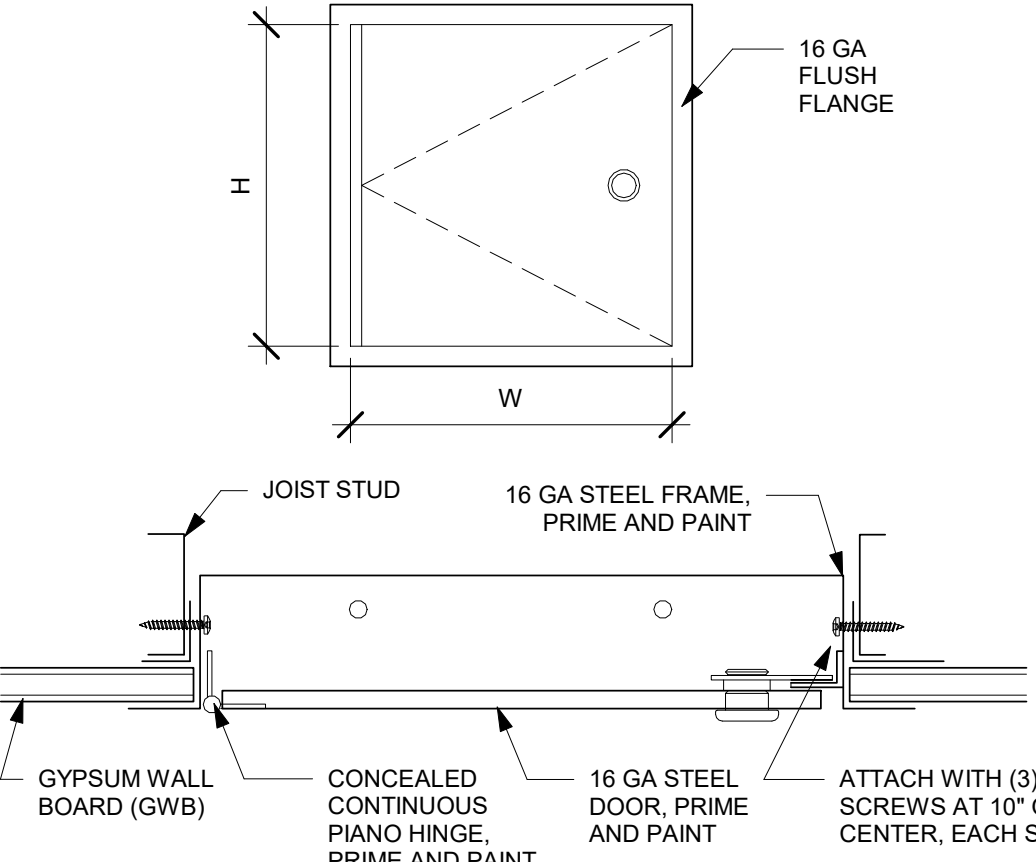


A OPENING FRAMING


7 CEILING ACCESS PANEL.
1 1/2" = 1'-0"

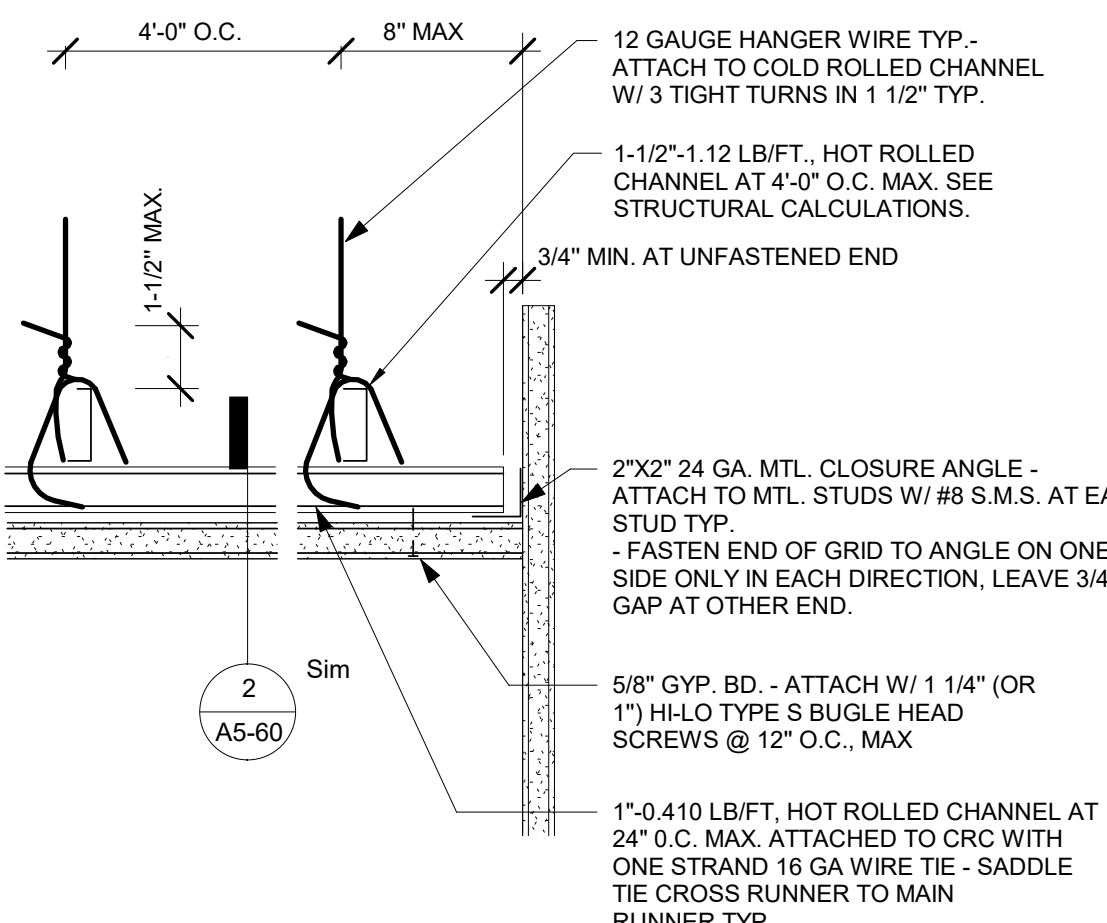


3 CEILING SUPPORT (PARALLEL)1
12" = 1'-0"

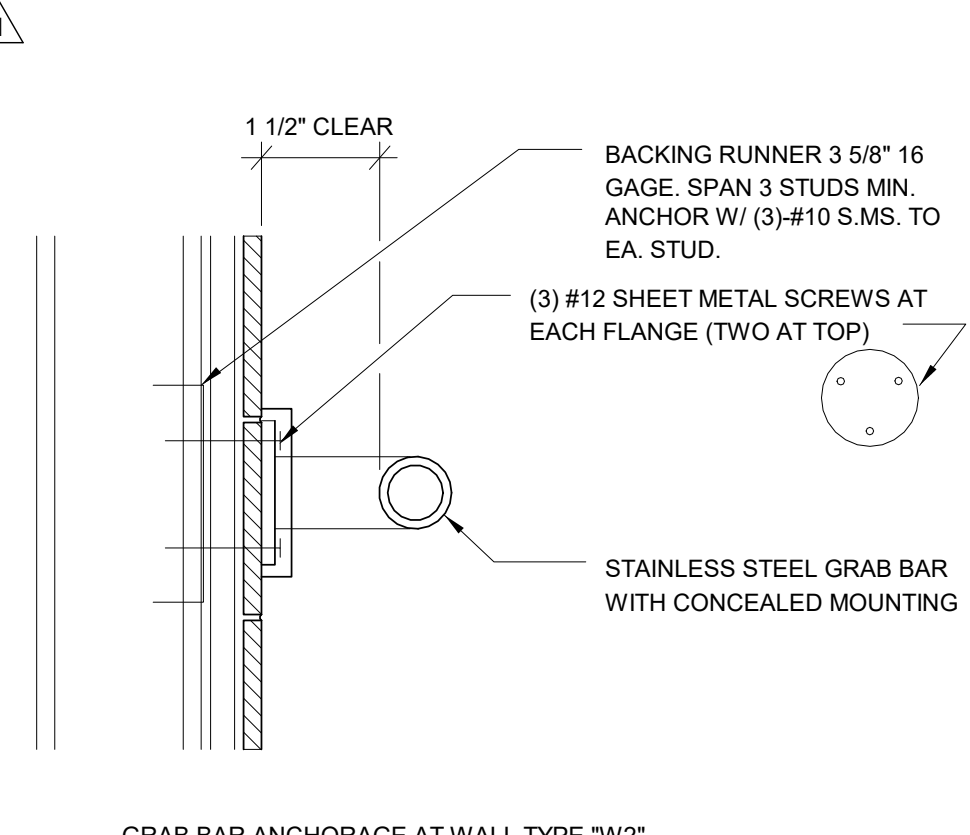

11 GRAB BAR
3" = 1'-0"

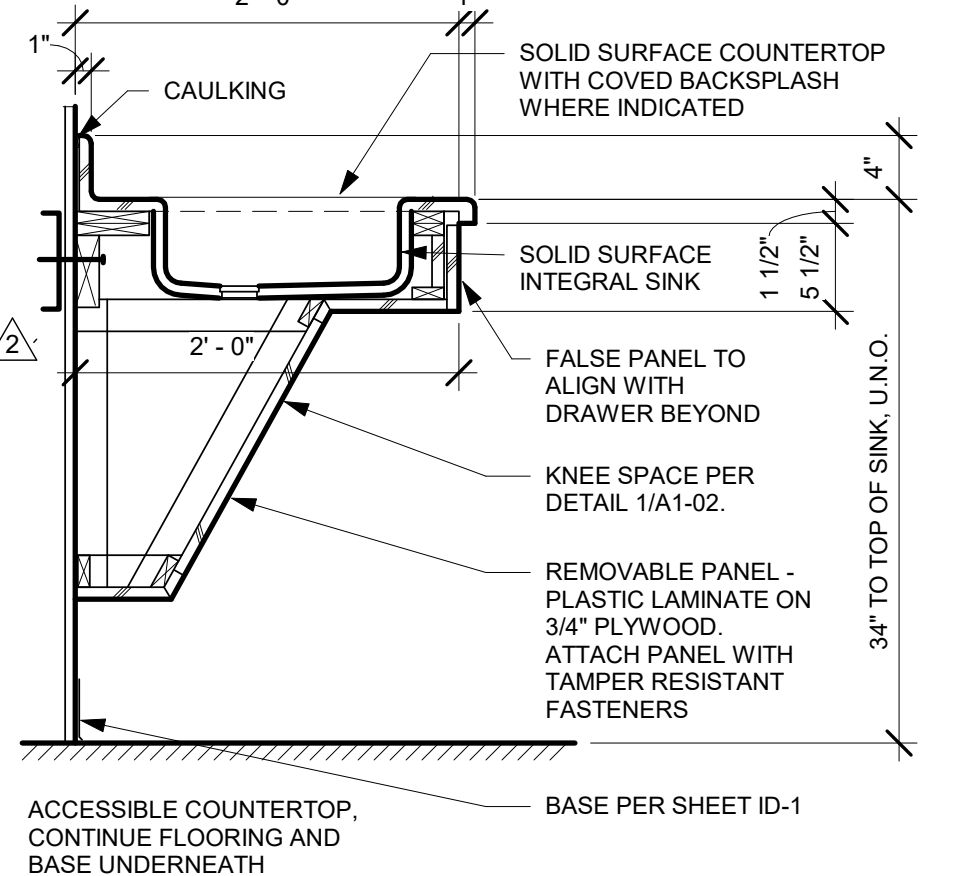

8 COUNTER W/ INTEGRAL SINK
1" = 1'-0"

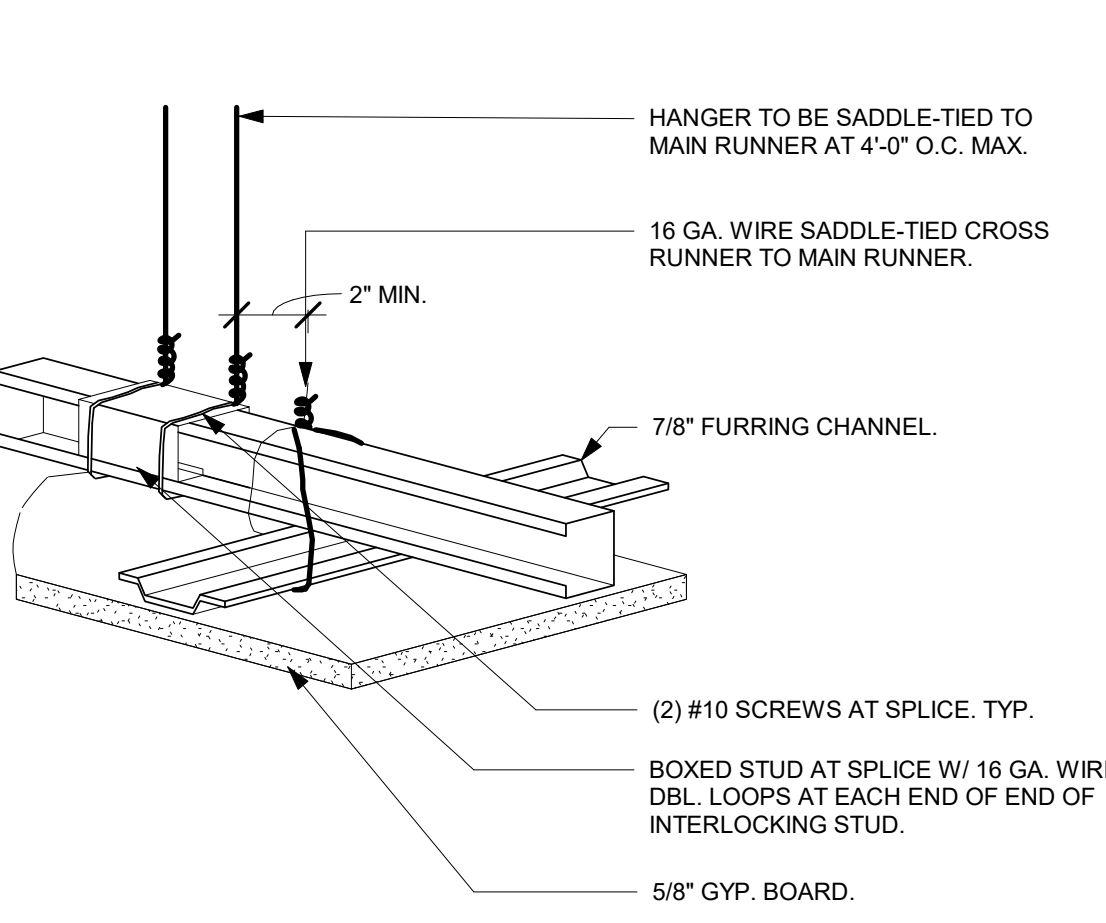

4 SPLICE AT COLD ROLLED CHANNEL1
12" = 1'-0"

TCMC OBSERVATION ROOM


TRI-CITY MEDICAL
CENTER
4002 VISTA WAY
OCEANSIDE, CALIFORNIA
92056

OWNER: TRI-CITY MEDICAL CENTER
4002 VISTA WAY
OCEANSIDE, CALIFORNIA 92056
TEL(760)724-8411

ARCHITECT: SFEIR ARCHITECTS
1350 COLUMBIA STREET, SUITE 603
SAN DIEGO, CALIFORNIA 92101
TEL(619)299-3917 FAX(619)299-5084

STRUCTURAL: SUN STRUCTURAL ENGINEERING, INC.
2091 LAS PALMAS DRIVE, SUITE D
CARLSBAD, CALIFORNIA 92011
TEL(760)438-1188

ME&P: P2S
9665 CHESAPEAKE, SUITE 230
SAN DIEGO, CALIFORNIA 92123
TEL(619)618-2347

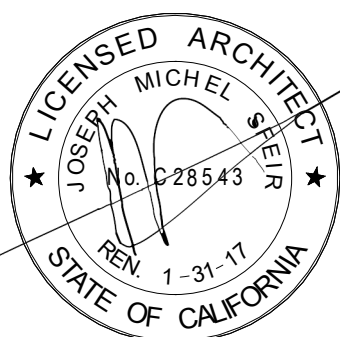

1	OSHDP COMMENTS	01/18/2017
2	DESIGN CHANGES	01/18/2017
3	OSHDP COMMENTS	04/20/2017
4	OSHDP COMMENTS	06/14/2017

REV: DESCRIPTION: DATE:
CONSULTANT

OSHDP APPROVAL STAMP:
OSHDP #: S162581-37-00




SHEET TITLE:
**DOOR AND INTERIOR
OPENINGS SCHEDULE**

PROJECT TITLE:
TCMC OBSERVATION ROOM

PROJECT #:
01643.00
DRAWN BY:
Author
CHECKED BY:
Checker
SCALE:
As indicated
DATE:
10/11/16


A6-00

DOOR AND FRAME SCHEDULE													
OPNG NO.	TYPE	DOOR		MATERIAL	FINISH	FRAME		HEAD	JAMB	THRESHOLD	LABEL	HDWR. SET	NOTES:
		OPENING SIZE (W)	(H)			MATERIAL	FINISH						
168	1C	3' - 8"	7' - 0"	STEEL	PTD	4A	STEEL	PTD	5	6	N/A	NR	1 2 3 4 5 7
168A	1A	3' - 8"	7' - 0"	STEEL	PTD	4A	STEEL	PTD	5	6	N/A	20 MIN.	3 7
168B	1A	3' - 0"	7' - 0"	STEEL	PTD	4B	STEEL	PTD	5 SIM.	6 SIM.	N/A	NR	3 5 6 7

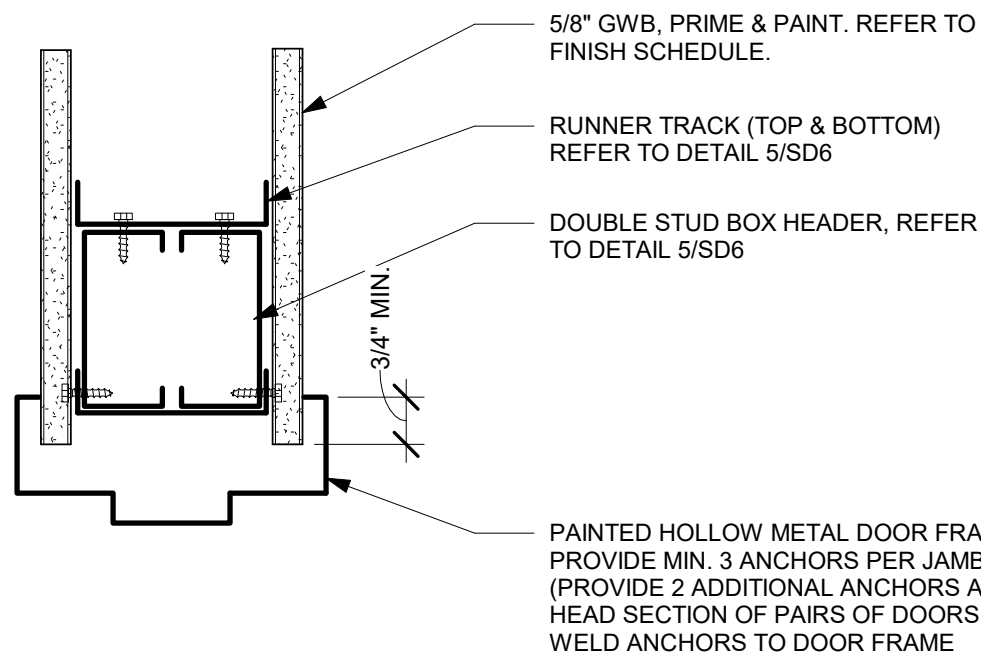


NOTE:
REFER TO FLOOR PLAN FOR REQUIRED PARTITION
TYPE AND NUMBER OF GYP. BOARD LAYERS.

6 TYPICAL DOOR HEADER 3" = 1'-0"

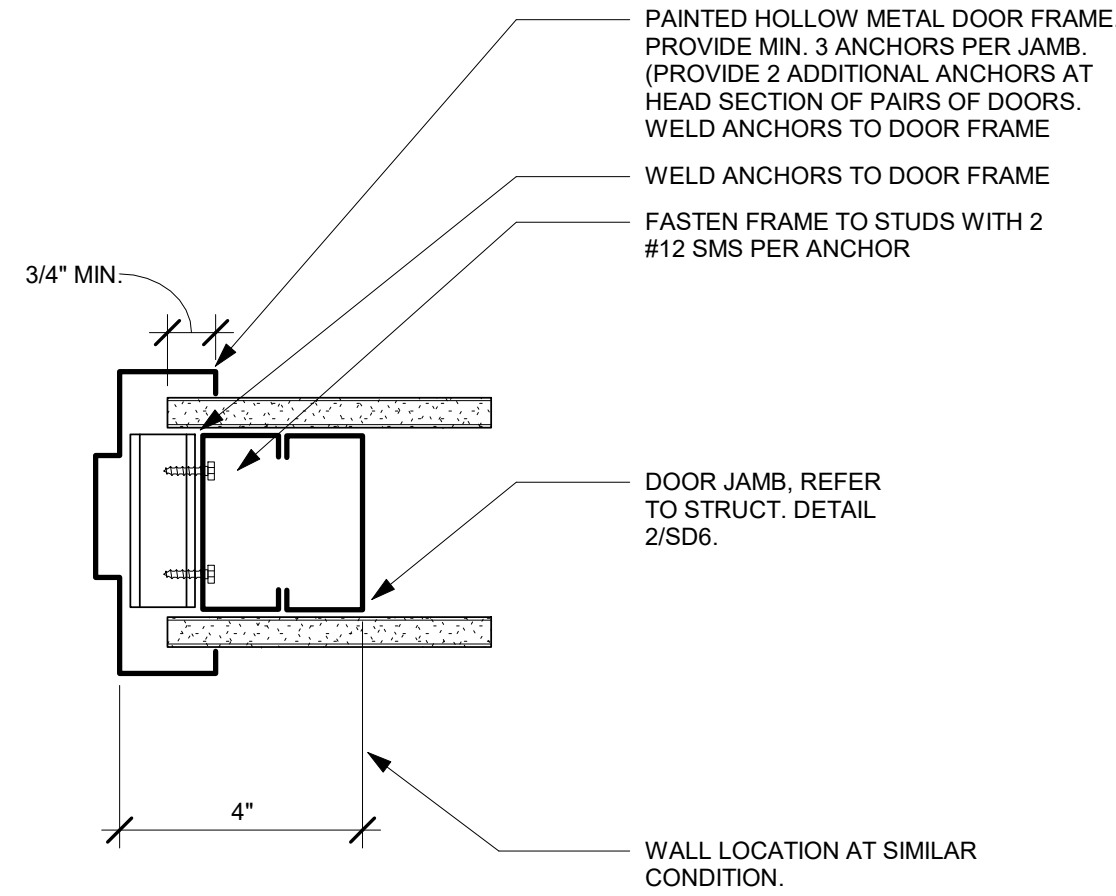


NOTE:
REFER TO FLOOR PLAN FOR REQUIRED PARTITION
TYPE AND NUMBER OF GYP. BOARD LAYERS.

5 TYPICAL DOOR JAMB 3" = 1'-0"

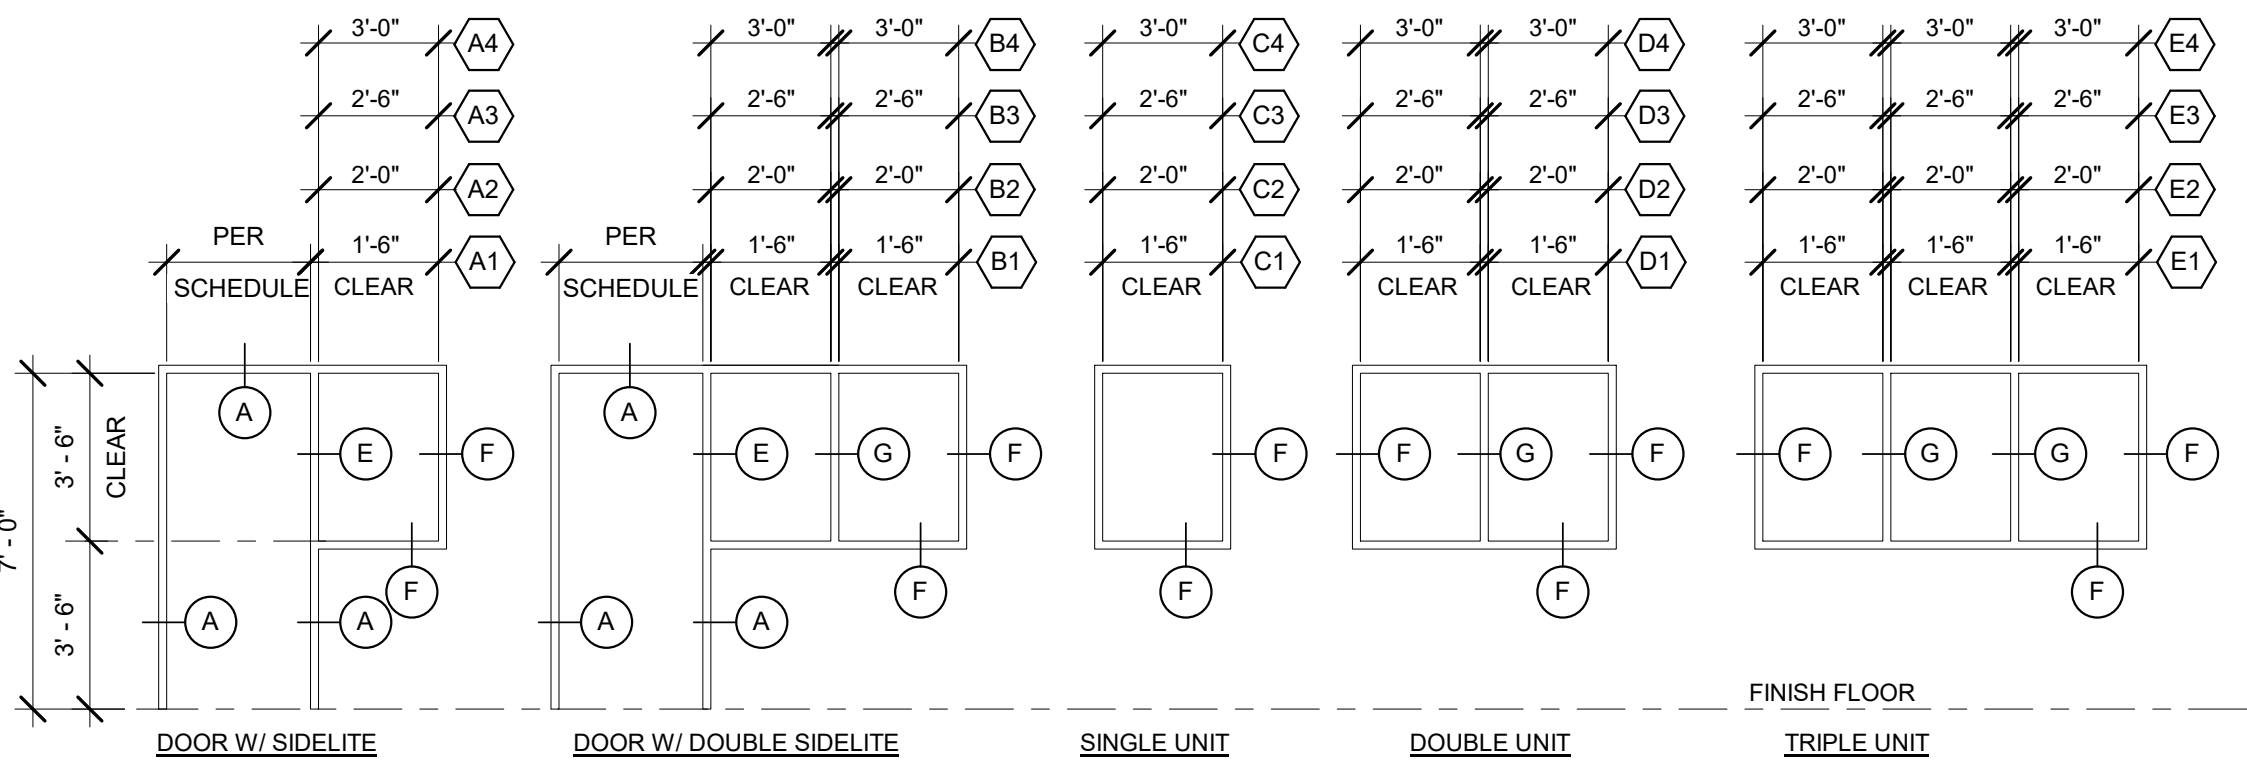


3 FRAME ELEVATIONS 1/4" = 1'-0"


NOTES:
1. GLAZE WINDOWS WITH 1/4" POLISHED
WIRE GLASS IN PAINTED STEEL FRAME.
SET ALL GLAZING STOPS ON CORRIDOR
SIDE OF FRAME.
REFER TO DETAIL 8 THIS SHEET FOR
FRAMES.

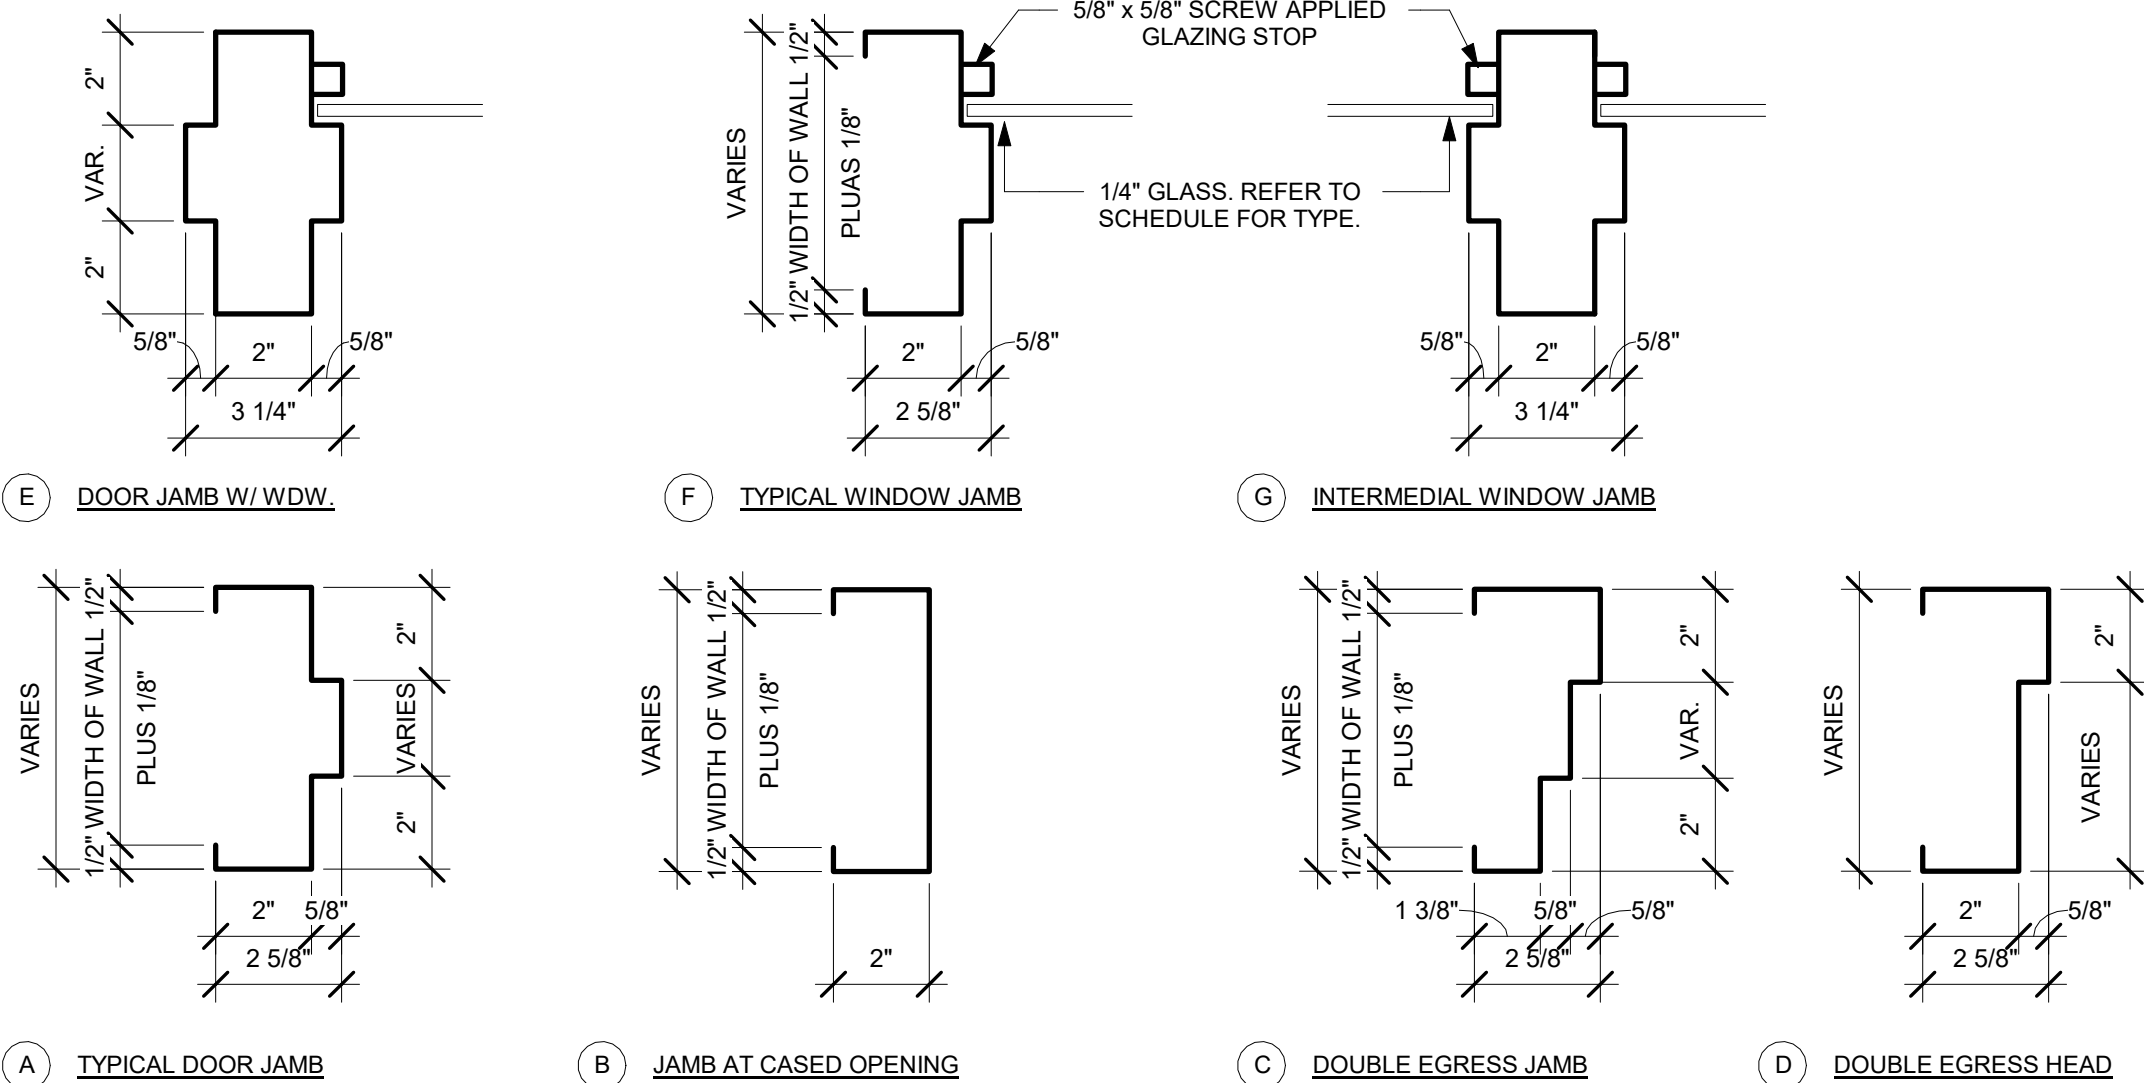


4 FRAME TYPES 3" = 1'-0"

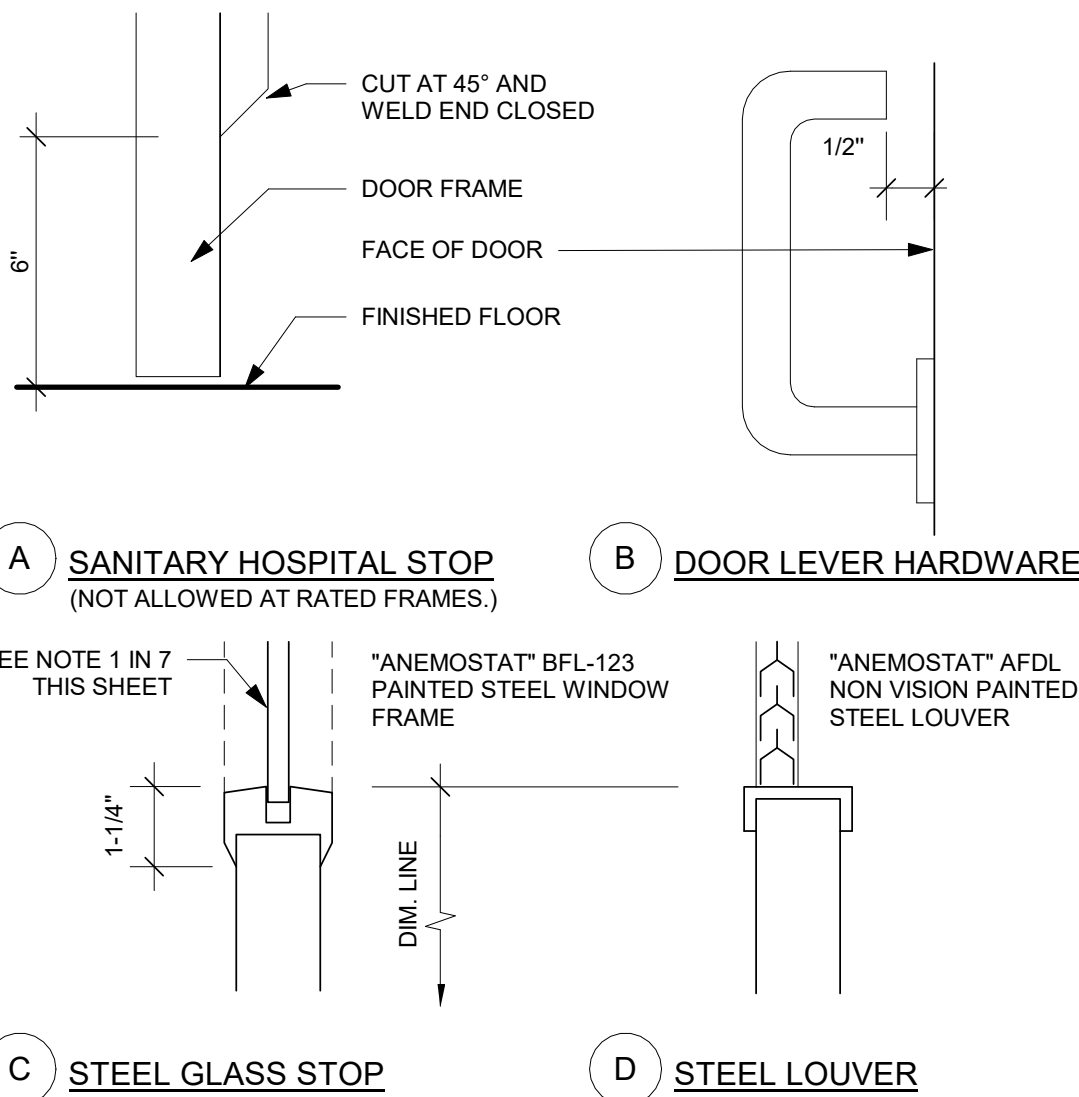

2 DOOR DETAILS 12" = 1'-0"

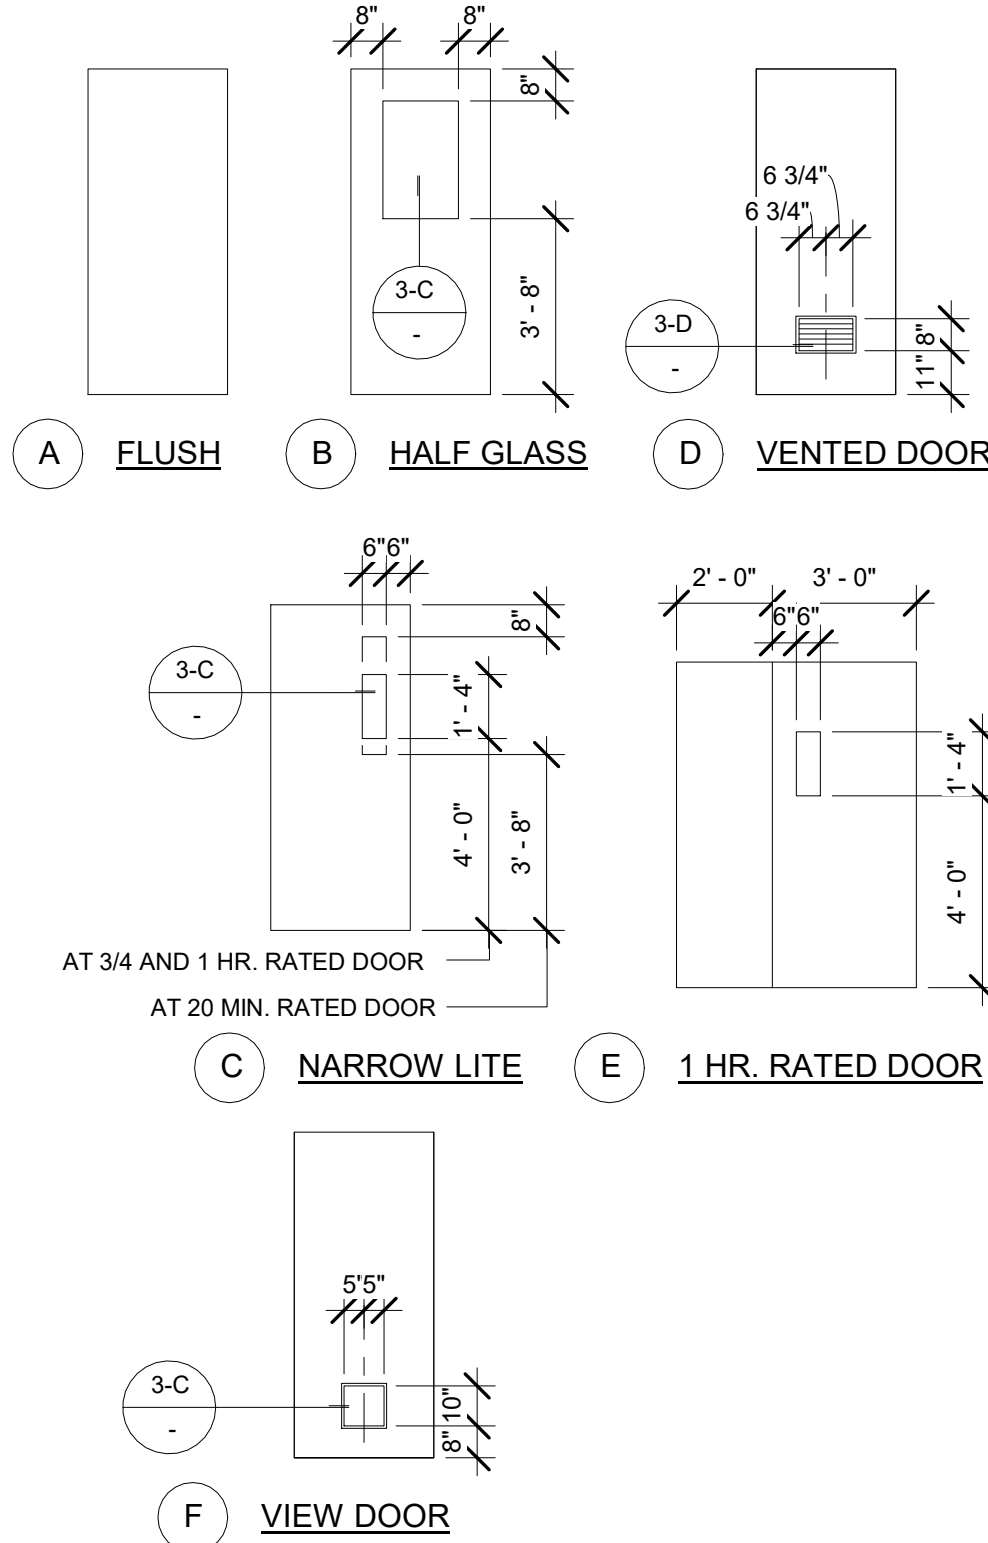

1 DOOR TYPES 1/4" = 1'-0"

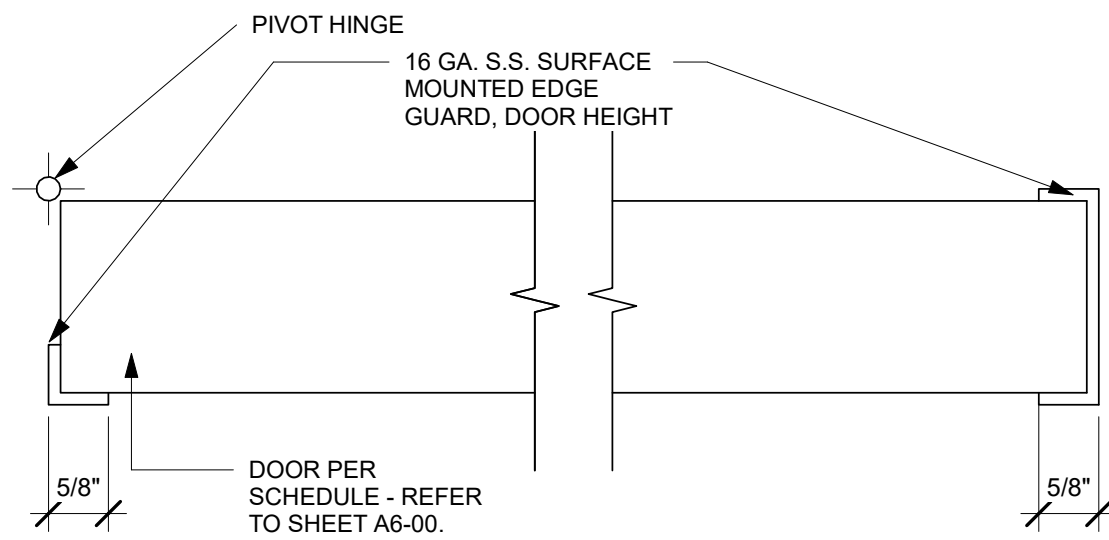

NOTE:
1- OMIT HINGE GUARD AT CONTINUOUS HINGE
2- CUT EDGE OF GUARD FOR LOCKSET FACE PLATE

7 DOOR EDGE GUARD 6" = 1'-0"

DOOR SCHEDULE GENERAL NOTES:

- PROVIDE SANITARY "HOSPITAL STOPS" AT ALL NON-RATED INTERIOR DOOR FRAMES.
- ALL DOORS SHALL RECEIVE LEVER TYPE HARDWARE WITH A PROFILE EQUAL TO DETAIL 2-B THIS SHEET.
- GLAZED OPENINGS IN 20 AND 45 MINUTE ASSEMBLIES SHALL NOT EXCEED 1296 SQ. INCHES AND SHALL BE GLAZED WITH 1/4" WIRE GLASS SET IN PAINTED STEEL FRAME.
- GLAZED OPENINGS IN 60 AND 90 MINUTE ASSEMBLIES SHALL NOT EXCEED 100 SQ. INCHES AND SHALL BE GLAZED WITH 1/4" WIRE GLASS SET IN PAINTED STEEL FRAME.
- FRAMES OF GLAZED OPENINGS IN DOORS SHALL BE PRIMED AND PAINTED TO MATCH DOOR FRAMES.
- CENTER OF DOOR HINGE PIVOT SHALL BE LOCATED AT 4" FROM ADJACENT PARTITION UON.

DOOR SCHEDULE KEYNOTES:

- PUSH PLATE ON OBSERVATION ROOM SIDE OF DOOR ONLY.
- THREE POINT LATCHING ON ANTEROOM SIDE OF DOOR.
- DOOR SHALL BEAR 'S' LABEL.
- PROVIDE DOOR EDGE GUARD PER DETAIL 7/A6-00.
- VIEW WINDOW IN DOOR TO BE CLASS A POLYCARBONATE.
- DUAL-ACTING DOOR, FRAME & HINGES.
- DOOR HINGE TO BE CONTINUOUS.

DOOR SCHEDULE FINISH LEGEND:

SCWD	SOLID CORE WOOD DOOR	ST	STAINED, MATCH EXISTING
PL	PLASTIC LAMINATE	NR	NOT RATED
PTD	PAINTED	BAST	BALISTIC STEEL
		MAR	MARBLE

TCMC OBSERVATION ROOM


TRI-CITY MEDICAL
CENTER
4002 VISTA WAY
OCEANSIDE, CALIFORNIA
92056

OWNER: TRI-CITY MEDICAL CENTER
4002 VISTA WAY
OCEANSIDE, CALIFORNIA 92056
TEL(760)724-8411

ARCHITECT: SFEIR ARCHITECTS
1350 COLUMBIA STREET, SUITE 603
SAN DIEGO, CALIFORNIA 92101
TEL(619)299-3917 FAX(619)299-5084

STRUCTURAL: SUN STRUCTURAL ENGINEERING, INC.
2091 LAS PALMAS DRIVE, SUITE D
CARLSBAD, CALIFORNIA 92011
TEL(760)438-1188

ME&P: P2S ENGINEERING, INC.
9265 CHESAPEAKE DRIVE, SUITE 230
SAN DIEGO, CALIFORNIA 92123
TEL(619)618-2347 FAX(619)330-0668

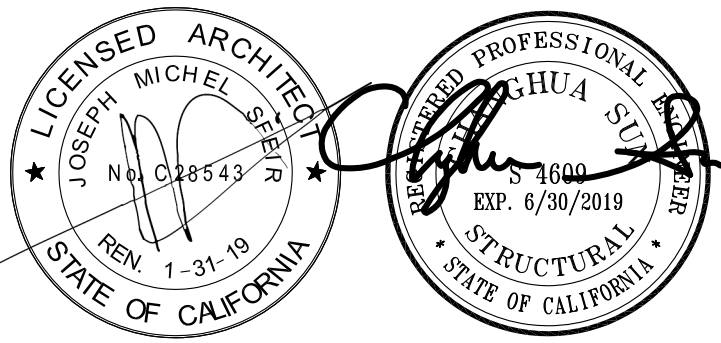

1	1	OSHPD COMMENTS	01/18/2017
2	2	DESIGN CHANGES	01/18/2017
3	3	OSHPD COMMENTS	04/20/2017
4	4	OSHPD COMMENTS	06/14/2017

REV: DESCRIPTION: DATE:

CONSULTANT
SUN Structural Engineering, Inc.
Consulting Structural Engineers
2091 Las Palmas Dr., Suite D
Carlsbad, California 92011
Tel: 760-438-1188
www.sunse-inc.com

OSHPD APPROVAL STAMP:

OSHPD #: S162581-37-00

REVIEWED IN ACCORDANCE WITH
THE REQUIREMENTS OF T24, CCR
APPROVED

Laura Baldrati, Sr. Architect

Office of Statewide Health
Planning & Development
FACILITIES DEVELOPMENT DIVISION

07/06/2017 10:48:54 AM
#S162581-37-00
SHEET 11/12

GENERAL NOTES
TYPICAL DETAILS

PROJECT TITLE:

PROJECT #: 01643.00
DRAWN BY: Author
CHECKED BY: Checker
SCALE: As indicated
DATE: 09/22/16

SHEET NUMBER:

S-I

GENERAL NOTES

- THE CONTRACTOR SHALL VERIFY ALL DIMENSIONS, ELEVATIONS, SITE CONDITIONS PRIOR TO STARTING CONSTRUCTION. THE ARCHITECT AND STRUCTURAL ENGINEER SHALL BE NOTIFIED OF ANY DISCREPANCIES OR INCONSISTENCIES.
- THE ARCHITECT AND STRUCTURAL ENGINEER SHALL BE NOTIFIED OF ANY CONFLICTS OR OMISSIONS BETWEEN THE WORKING DRAWINGS OR SPECIFICATIONS BEFORE PROCEEDING ANY WORK SO AFFECTED. A CLARIFICATION SHALL BE ISSUED FOR SUCH CONFLICTS. ANY WORK PERFORMED IN CONFLICT WITH THE CONTRACT DOCUMENTS OR ANY CODE REQUIREMENTS SHALL BE CORRECTED BY THE ARCHITECT AND STRUCTURAL ENGINEER.
- THE STRUCTURAL DRAWINGS AND SPECIFICATIONS FOR CONSTRUCTION REPRESENT THE FINISHED STRUCTURE. THEY DO NOT INDICATE THE METHOD OF CONSTRUCTION. THE CONTRACTOR SHALL PROVIDE ALL MEASURES NECESSARY TO PROTECT THE STRUCTURE DURING CONSTRUCTION. SUCH MEASURES INCLUDE, BUT NOT LIMITED TO, BRACING, SHORING, TO INSURE THE VERTICAL AND LATERAL STABILITY OF THE STRUCTURE. OBSERVATION VISITS TO THE SITE BY THE ARCHITECT AND STRUCTURAL ENGINEER SHALL NOT INCLUDE INSPECTION OF THE ABOVE ITEMS AND DOES NOT RELIEVE THE CONTRACTOR'S RESPONSIBILITIES.
- THE CONTRACTOR SHALL BE SOLELY RESPONSIBLE FOR CONFORMING TO ALL LOCAL, STATE AND FEDERAL SAFETY AND HEALTH STANDARDS, LAWS AND REGULATIONS. THE ARCHITECT AND STRUCTURAL ENGINEER WILL NOT ENFORCE SAFETY MEASURES OR REGULATIONS.
- NOTES AND DETAILS ON THE DRAWINGS SHALL TAKE PRECEDENCE OVER THE GENERAL NOTES AND TYPICAL DETAILS. DIMENSIONS SHALL TAKE PRECEDENCE OVER SCALES SHOWN IN CASE OF CONFLICT.
- ALL WORKS SHALL CONFORM TO THE STANDARDS OF THE 2013 CALIFORNIA BUILDING CODE.
- A.S.T.M. SPECIFICATIONS NOTED ON THE DRAWINGS SHALL BE OF THE LATEST REVISION.
- NO STRUCTURAL SUBSTITUTIONS OR CHANGES SHALL BE MADE IN THE FIELD. WRITTEN APPROVAL MUST BE OBTAINED FROM THE STRUCTURAL ENGINEER AND OSHPD FOR ANY SUBSTITUTIONS OR CHANGES FROM THE APPROVED CONSTRUCTION DOCUMENTS.
- CONTRACTOR SHALL PROVIDE AND BE RESPONSIBLE FOR THE PROTECTION AND REPAIR OF ADJACENT EXISTING SURFACES AND AREAS WHICH MAY BE DAMAGED AS A RESULT OF NEW WORK.

EXPANSION ANCHOR BOLTS

- ALL FIELD INSTALLED CONCRETE EXPANSION ANCHORS SHALL BE HILTI KB-TZ ANCHORS.
ANCHOR TYPE ICC-ES ESR#
3/8" HILTI KB TZ 1917
- ALL ANCHORS SHALL BE TESTED BASED ON THE FOLLOWING CRITERIA:
ANCHOR TYPE TORQUE ICC-ES ESR#
3/8" HILTI KB TZ ANCHOR 25 FT-LBS 1917

MINIMUM ANCHOR EMBEDMENT SHALL BE 2" FOR 3/8" (INSTALLED IN NORMAL WT. CONCRETE WITH $f_c' = 3000$ PSI)

WHEN INSTALLING DRILLED-IN ANCHORS AND/OR POWDER DRIVEN PINS IN EXISTING NON-PRESTRESSED REINFORCED CONCRETE, USE CARE AND CAUTION TO AVOID CUTTING OR DAMAGING THE EXISTING REINFORCING BARS OR EMBEDDED PIPES AND CONDUITS IN THE SLAB BY USING A NON DESTRUCTIVE METHOD PRIOR TO INSTALLATION. WHEN INSTALLING THEM INTO PRESTRESSED CONCRETE (PRE OR POST TENSIONED) LOCATED THE PRESTRESSED TENDONS BY USING A NON DESTRUCTIVE METHOD PRIOR TO INSTALLATION. EXERCISE EXTREME CARE AND CAUTION TO AVOID CUTTING OR DAMAGING THE TENDONS DURING INSTALLATION.

MAINTAIN 1" MINIMUM CLEARANCE BETWEEN EXISTING REINFORCEMENT AND THE EPOXY ANCHOR.

APPLY PROOF TEST LOADS TO EPOXY ANCHORS WITHOUT REMOVING THE NUT IF POSSIBLE. OTHERWISE, REMOVE THE NUT AND INSTALL A THREADED COUPLER UP TO THE SAME TIGHTNESS OF THE ORIGINAL NUT USING A TORQUE WRENCH AND APPLY THE LOAD.

TESTING SHOULD OCCUR A MINIMUM 24 HOURS AFTER INSTALLATION OF THE SUBJECTED ANCHORS. IF THE MANUFACTURER'S RECOMMENDED INSTALLATION TORQUE IS LESS THAN THE TEST TORQUE, THE MANUFACTURER'S RECOMMENDED INSTALLATION TORQUE SHOULD BE USED IN LIEU OF THE TEST TORQUE. ANCHOR DIAMETER REFERS TO THE THREADED SIZE.

REACTION LOADS FROM TEST FIXTURES MAY BE APPLIED CLOSE TO THE ANCHOR BEING TESTED. PROVIDE THE ANCHOR IS NOT RESTRAINED FROM WITHDRAWING BY THE FIXTURE.

TEST EQUIPMENT INCLUDING TORQUE WRENCHES SHALL BE CALIBRATED BY AN APPROVED TESTING LABORATORY IN ACCORDANCE WITH STANDARD RECOGNIZED PROCEDURES.

TEST METHODS: THE FOLLOWING CRITERIA APPLY FOR THE ACCEPTANCE OF INSTALLED ANCHORS:

A). HYDRAULIC RAM METHOD:
ANCHORS TESTED WITH A HYDRAULIC JACK OR SPRING LOADED DEVICES SHALL MAINTAIN THE TEST LOAD FOR MINIMUM OF 10 SECONDS AND SHALL EXHIBIT NO DISCERNABLE MOVEMENT DURING THE TENSION TEST, w_d , AS EVIDENCED BY LOOSENING OF THE WASHER UNDER NUT.

B). TORQUE WRENCH METHOD:
ANCHORS TESTED WITH A CALIBRATED TORQUE WRENCH MUST ATTAIN THE SPECIFIED TORQUE WITHIN $\frac{1}{2}$ TURN OF THE NUT.

EXCEPTIONS:
1. WEDGE OR SLEEVE TYPE:
ONE-QUARTER ($\frac{1}{4}$) TURN OF THE NUT FOR A $\frac{3}{8}$ IN. SLEEVE ANCHOR ONLY.
2. THREADED TYPE:
ONE-QUARTER ($\frac{1}{4}$) TURN OF THE SCREW AFTER INITIAL SEATING OF THE SCREW HEAD.

TESTING SHOULD OCCUR 24 HOURS MINIMUM AFTER INSTALLATION OF THE EPOXY ANCHOR.

MINIMUM OF 50% OF THE INSTALLED ANCHOR SHALL BE TESTED. (ALTERNATE ANCHORS IN ANY GROUP ARRANGEMENT) IF ANY ANCHOR FAILS TESTING. TEST ALL ANCHORS OF THE SAME TYPE, INSTALLED BY THE SAME TRADE, NOT PREVIOUSLY TESTED UNTIL TWENTY (20) CONSECUTIVE ANCHORS PASS, THEN RESUME THE INITIAL TEST FREQUENCY. TESTS SHALL BE PERFORMED PER CBC 2013, 1913A.7.

ALL TESTS SHALL BE PERFORMED IN THE PRESENCE OF THE INSPECTOR OF RECORD.

COLD-FORMED STEEL FRAMING

- DESIGN, MANUFACTURE AND INSTALLATION OF LIGHT GAGE, COLD-FORMED STEEL JOISTS, PURLINS AND STUDS SHALL CONFORM WITH THE LATEST EDITION OF THE LIGHT GAGE, COLD-FORMED STEEL DESIGN MANUAL ISSUED BY THE AISI.
- STRUCTURAL LIGHT GAUGE STUDS, TRACK, BRIDGING, AND ACCESSORIES SHALL COMPLY WITH STEEL STUD MANUFACTURERS ASSOCIATION ICBO ER-4943P.
- ALL WELDING SHALL BE IN CONFORMANCE WITH AWS D1.3 "STRUCTURAL WELDING CODE - SHEET STEEL". QUALIFICATION OF WELDERS SHALL BE IN ACCORDANCE WITH AWS D1.1, CHAPTER 5, PART C "WELDER QUALIFICATION". SEE LATEST EDITION OF THE AISI SPECIFICATIONS FOR THE "DESIGN OF COLD-FORMED STEEL STRUCTURAL MEMBERS" FOR ALLOWABLE WELD VALUES.
- FRAMING SHALL BE ERECTED PLUMB, LEVEL AND SQUARE. BRIDGING AND DIAGONAL TENSION STRAPS SHALL BE USED.
- TEMPORARY BRACING SHALL BE PROVIDED AS REQUIRED UNTIL ERECTION IS COMPLETE AND SAFELY SECURED TO STRUCTURE.
- COLD-FORMED STEEL YIELD STRENGTH (f_y) IS 33 KSI. IDENTIFICATION OF SSMA PRODUCTS

MEMBER DEPTH: 3.62" = 362x1/100 INCHES ALL MEMBER DEPTHS ARE TAKEN IN 1/100 INCHES FOR ALL "T" SECTIONS MEMBER DEPTH IS THE INSIDE TO INSIDE DIMENTION	FLANGE WIDTH: 2" = 200x1/100 INCHES ALL FLANGE WIDTH ARE TAKEN IN 1/100 INCHES
STYLE: S = STUD OR JOIST SECTIONS T = TRACK SECTIONS	MATERIAL THICKNESS: 0.054" = 54 MILS (16 GA.) MATERIAL THICKNESS IS THE MIN. BASE METAL THICKNESS REPRESENTS 95% OF THE DESIGN THICKNESS


COLD-FORMED STEEL STUDS PROPERTIES			
IDENTIFICATION	MEMBER DEPTH	FLANGE WIDTH	MATERIAL THICKNESS
362S162-43	3.62"	1.625"	18 GA.
362T123-43	3.62"	1.25"	18 GA.
600S200-54	6"	2"	16 GA.

SEISMIC LOAD

SITE LOCATION:
LONGITUDE: 117.29178° WEST, LATITUDE: 33.18425° NORTH
DESIGN SPECTRAL RESPONSE ACCELERATION:
 $S_{D0.5} = 0.760$, $S_{D1} = 0.435$


SEISMIC IMPORTANCE FACTOR: $I_p = 1.5$
SEISMIC FORCE COEFFICIENTS:
 $a_p = 1.0$, $R_p = 2.5$

SEISMIC DESIGN CATEGORY "D"

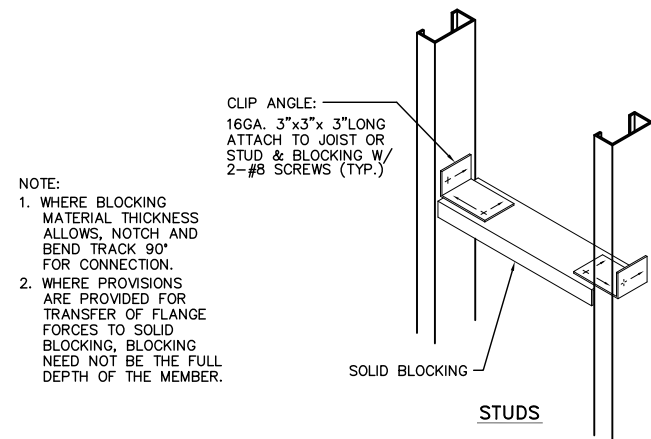


1 BLOCKING AT PARTITION

SCALE: NTS

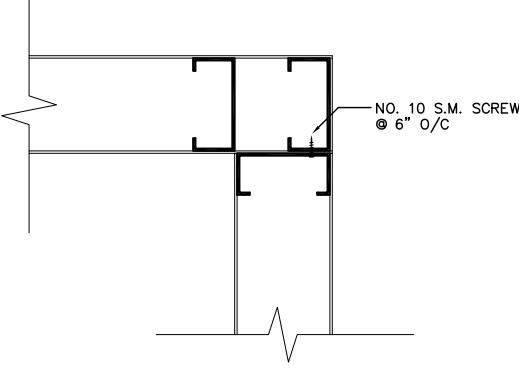


2 CORNER FRAMING

SCALE: NTS

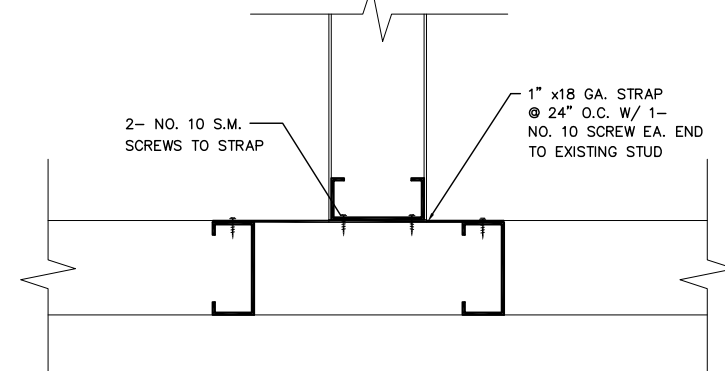


3 NEW WALL TO EXISTING WALL INTERSECTION FRAMING

SCALE: NTS

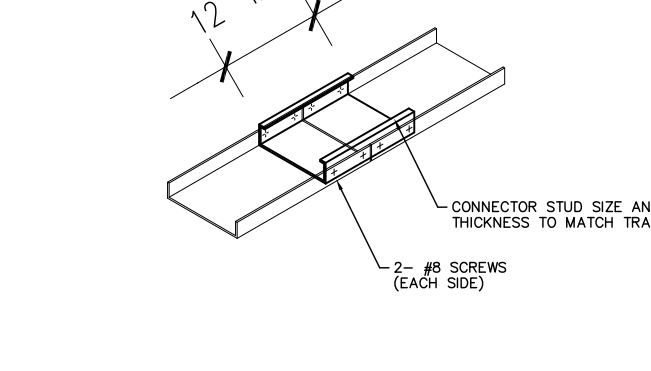


4 TOP & BOTTOM TRACK SPLICE

SCALE: NTS

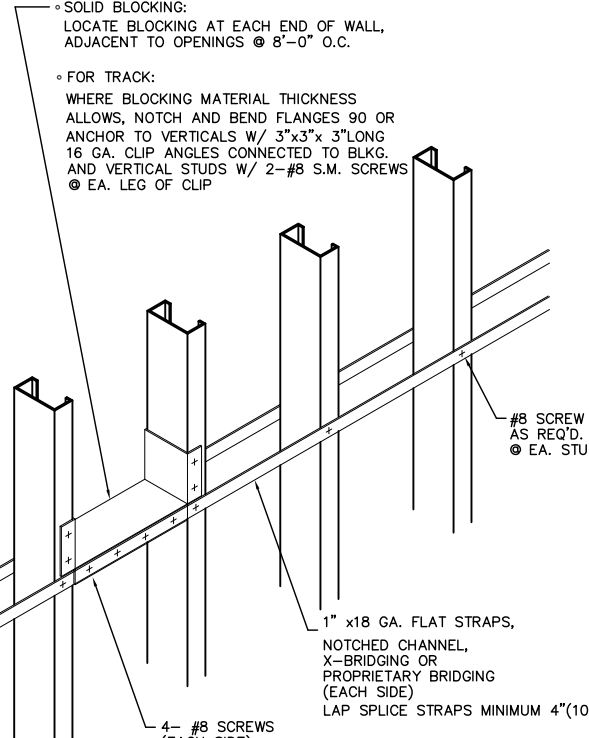

6 WALL BRIDGING ALTERNATE

SCALE: NTS

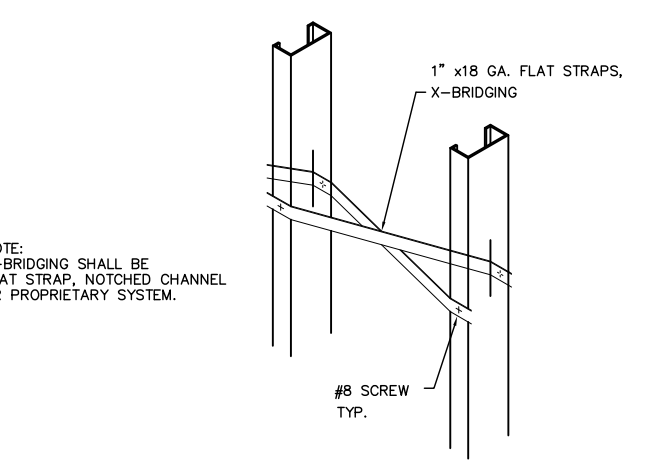


7 X-BRIDGING

SCALE: NTS


8 WALL BRIDGING

SCALE: NTS

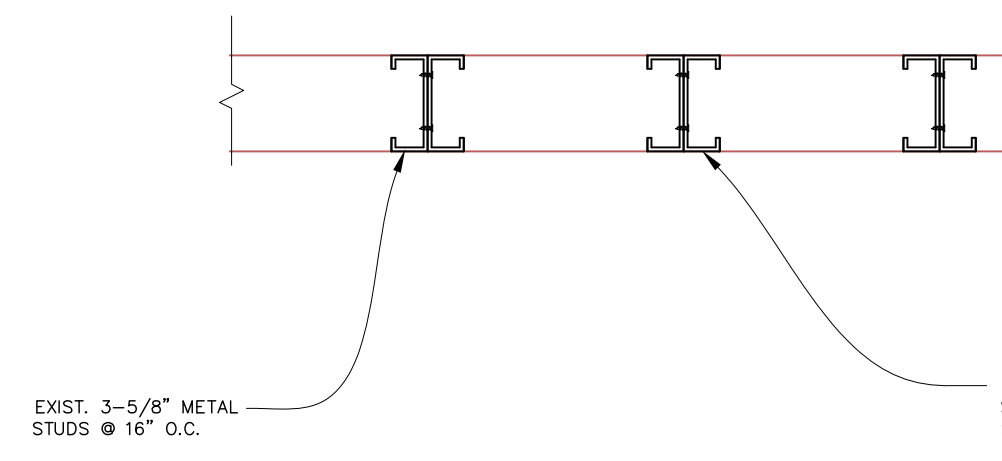


9 TYPICAL SISTER STUDS CONNECTION PLAN VIEW

SCALE: NTS

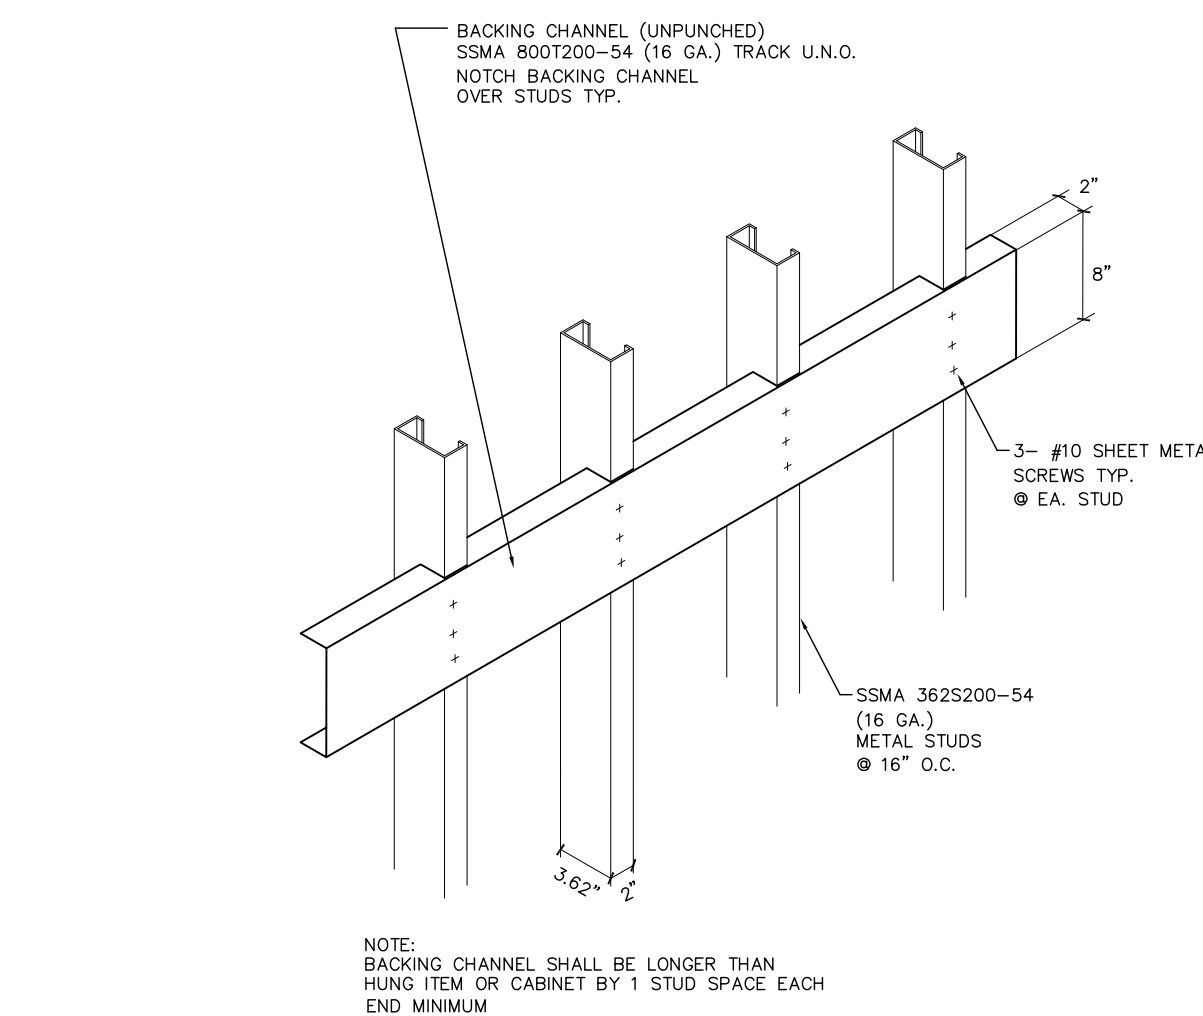

A @ NEW STEEL STUDS WALL

10 TYPICAL BACKING FOR CABINETS AND EQUIPMENT

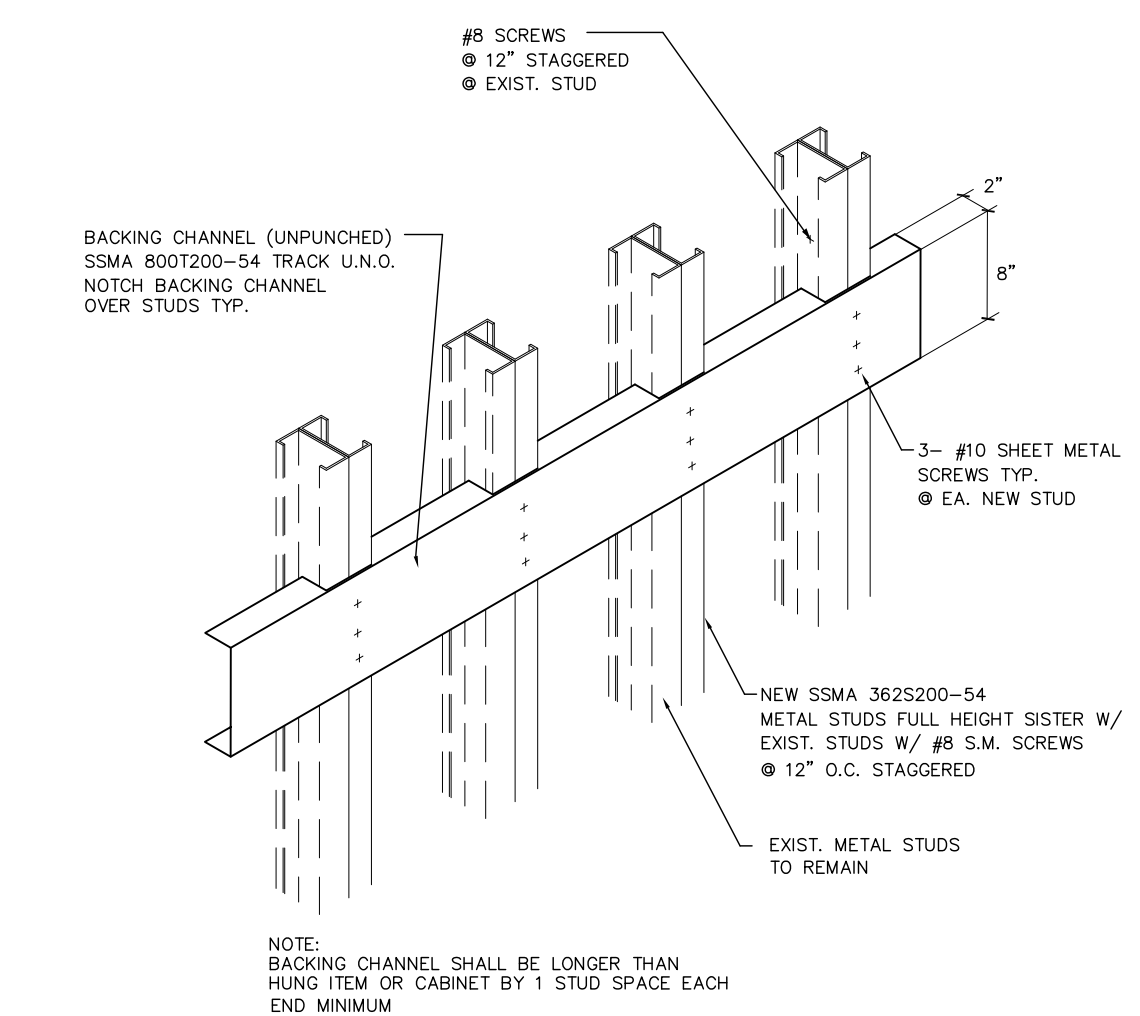

B @ EXISTING STEEL STUDS WALL

TCMC OBSERVATION ROOM


TRI-CITY MEDICAL
CENTER
4002 VISTA WAY
OCEANSIDE, CALIFORNIA
92056

OWNER: TRI-CITY MEDICAL CENTER
4002 VISTA WAY
OCEANSIDE, CALIFORNIA 92056
TEL(760)724-8411

ARCHITECT: SFEIR ARCHITECTS
1350 COLUMBIA STREET, SUITE 603
SAN DIEGO, CALIFORNIA 92101
TEL(619)299-3917 FAX(619)299-5084

STRUCTURAL: SUN STRUCTURAL ENGINEERING, INC.
2091 LAS PALMAS DRIVE, SUITE D
CARLSBAD, CALIFORNIA 92011
TEL(760)438-1188

ME&P: P2S ENGINEERING, INC.
9265 CHESAPEAKE DRIVE, SUITE 230
SAN DIEGO, CALIFORNIA 92123
TEL(619)618-2347 FAX(619)330-0668

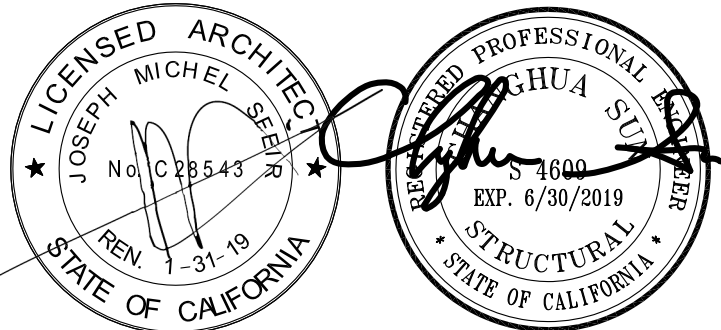

1	OSHPD COMMENTS	01/18/2017
2	DESIGN CHANGES	01/18/2017
3	OSHPD COMMENTS	04/20/2017
4	OSHPD COMMENTS	06/14/2017

REV: DESCRIPTION: DATE:

CONSULTANT
SUN Structural Engineering, Inc.
Consulting Structural Engineers
2091 Las Palmas Dr., Suite D
Carlsbad, California 92011
Tel: 760-438-1188
www.sunse-inc.com

OSHPD APPROVAL STAMP:
OSHPD #: S162581-37-00



07/06/2017 10:49:54 AM
#S162581-37-00
SHEET 111A


PARTIAL FIRST FLOOR PLAN

PROJECT: 111A

PROJECT #: 01643.00
DRAWN BY: Author
CHECKED BY: Checker
SCALE: As indicated
DATE: 09/22/16

SHEET NUMBER: _____

S-2

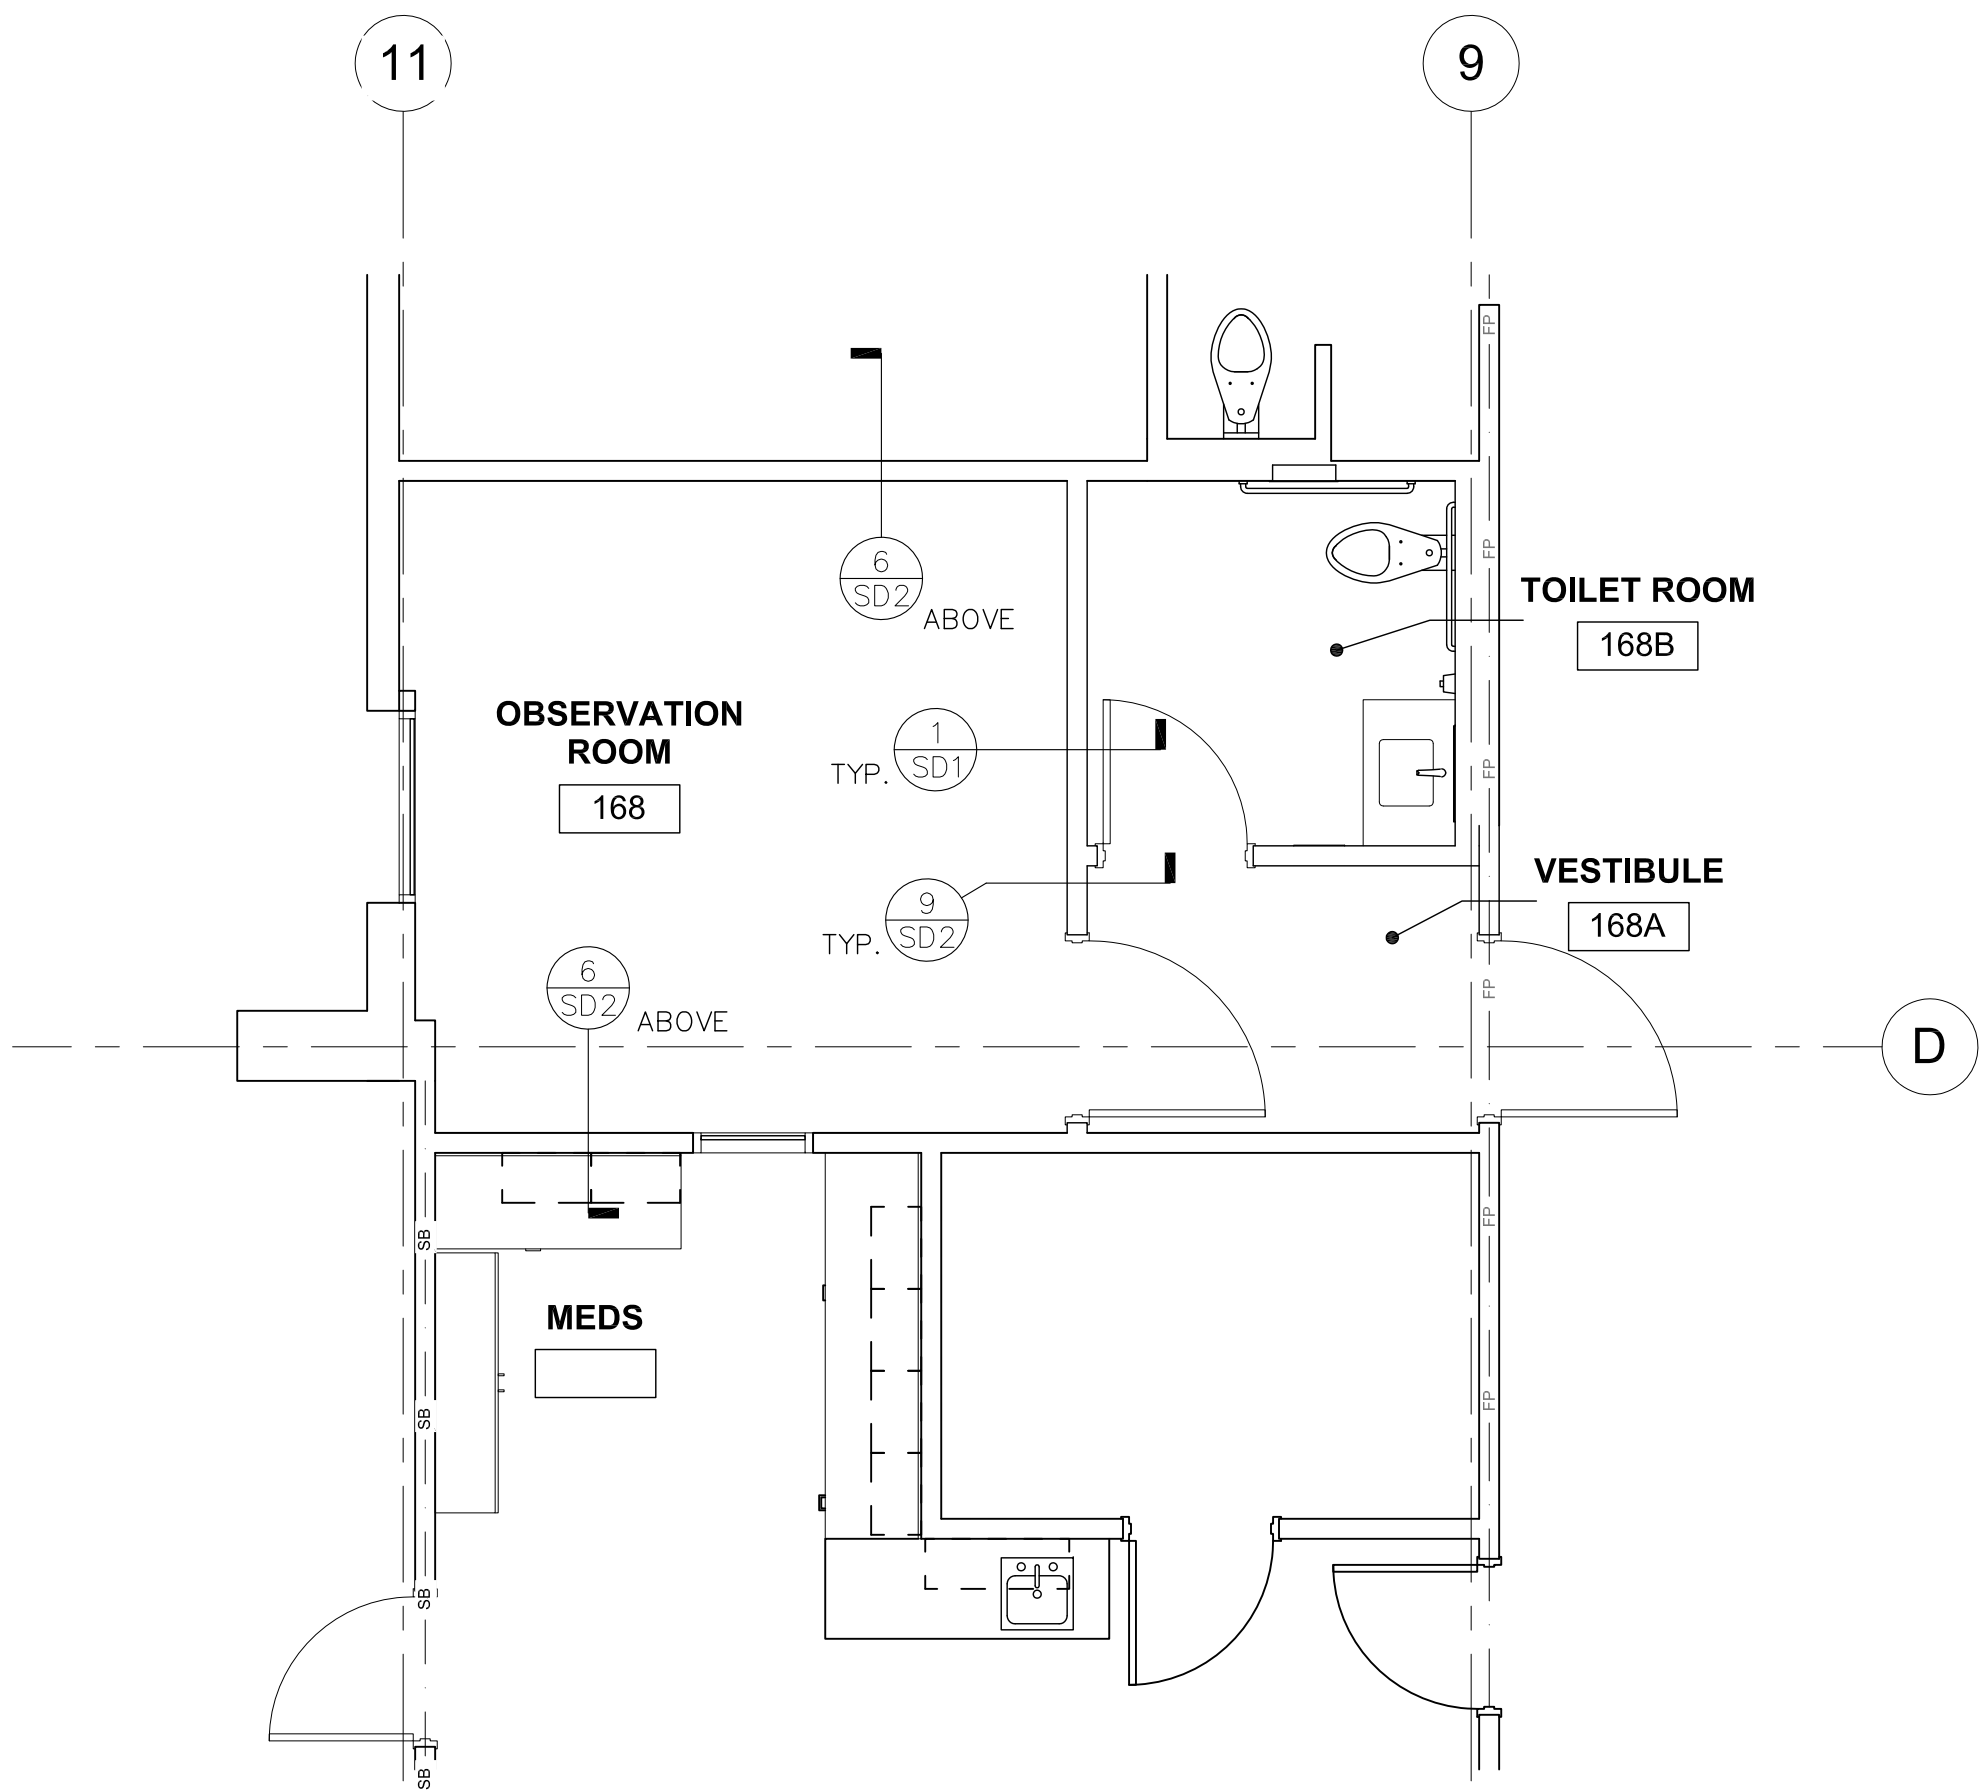

PARTIAL FIRST FLOOR PLAN

SCALE: 1/4"=1'-0"

GENERAL NOTES

- DO NOT SCALE THESE DRAWINGS. PRIOR TO START OF CONSTRUCTION, ALL DIMENSIONS AND ELEVATIONS MUST BE VERIFIED WITH THE APPRD. SET OF ARCHITECTURAL DRAWINGS. IN CASE OF DISCREPENCIES, STRUCTURAL ENGINEER OF RECORD MUST BE NOTIFIED IN WRITING.
- ALL EXISTING MEMBER SIZES, SPACING, & DIMENSIONS MUST BE FIELD VERIFIED. IN CASE OF DISCREPANCIES STRUCTURAL ENGINEER MUST BE NOTIFIED IN WRITING.

TCMC OBSERVATION ROOM


TRI-CITY MEDICAL
CENTER
4002 VISTA WAY
OCEANSIDE, CALIFORNIA
92056

OWNER: TRI-CITY MEDICAL CENTER
4002 VISTA WAY
OCEANSIDE, CALIFORNIA 92056
TEL(760)724-8411

ARCHITECT: SFEIR ARCHITECTS
1350 COLUMBIA STREET, SUITE 603
SAN DIEGO, CALIFORNIA 92101
TEL(619)299-3917 FAX(619)299-5084

STRUCTURAL: SUN STRUCTURAL ENGINEERING, INC.
2091 LAS PALMAS DRIVE, SUITE D
CARLSBAD, CALIFORNIA 92011
TEL(760)438-1188

ME&P: P2S ENGINEERING, INC.
9265 CHESAPEAKE DRIVE, SUITE 230
SAN DIEGO, CALIFORNIA 92123
TEL(619)618-2347 FAX(619)330-0668

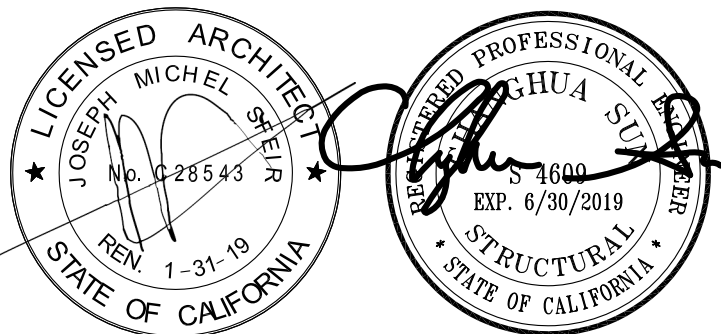

1	1	OSHPD COMMENTS	01/18/2017
2	2	DESIGN CHANGES	01/18/2017
3	3	OSHPD COMMENTS	04/20/2017
4	4	OSHPD COMMENTS	06/14/2017

REV: DESCRIPTION: DATE:

CONSULTANT
SUN Structural Engineering, Inc.
Consulting Structural Engineers
2091 Las Palmas Dr., Suite D
Carlsbad, California 92011
Tel: 760-438-1188
www.sunse-inc.com

OSHPD APPROVAL STAMP:



07/06/2017 10:48:54 AM
#S162581-37-00
SHEET 11/12

DETAILS

PROJECT TITLE:

PROJECT #: 01643.00 SHEET NUMBER:


DRAWN BY: Author

CHECKED BY: Checker


SCALE: As indicated

DATE: 09/22/16


SDI

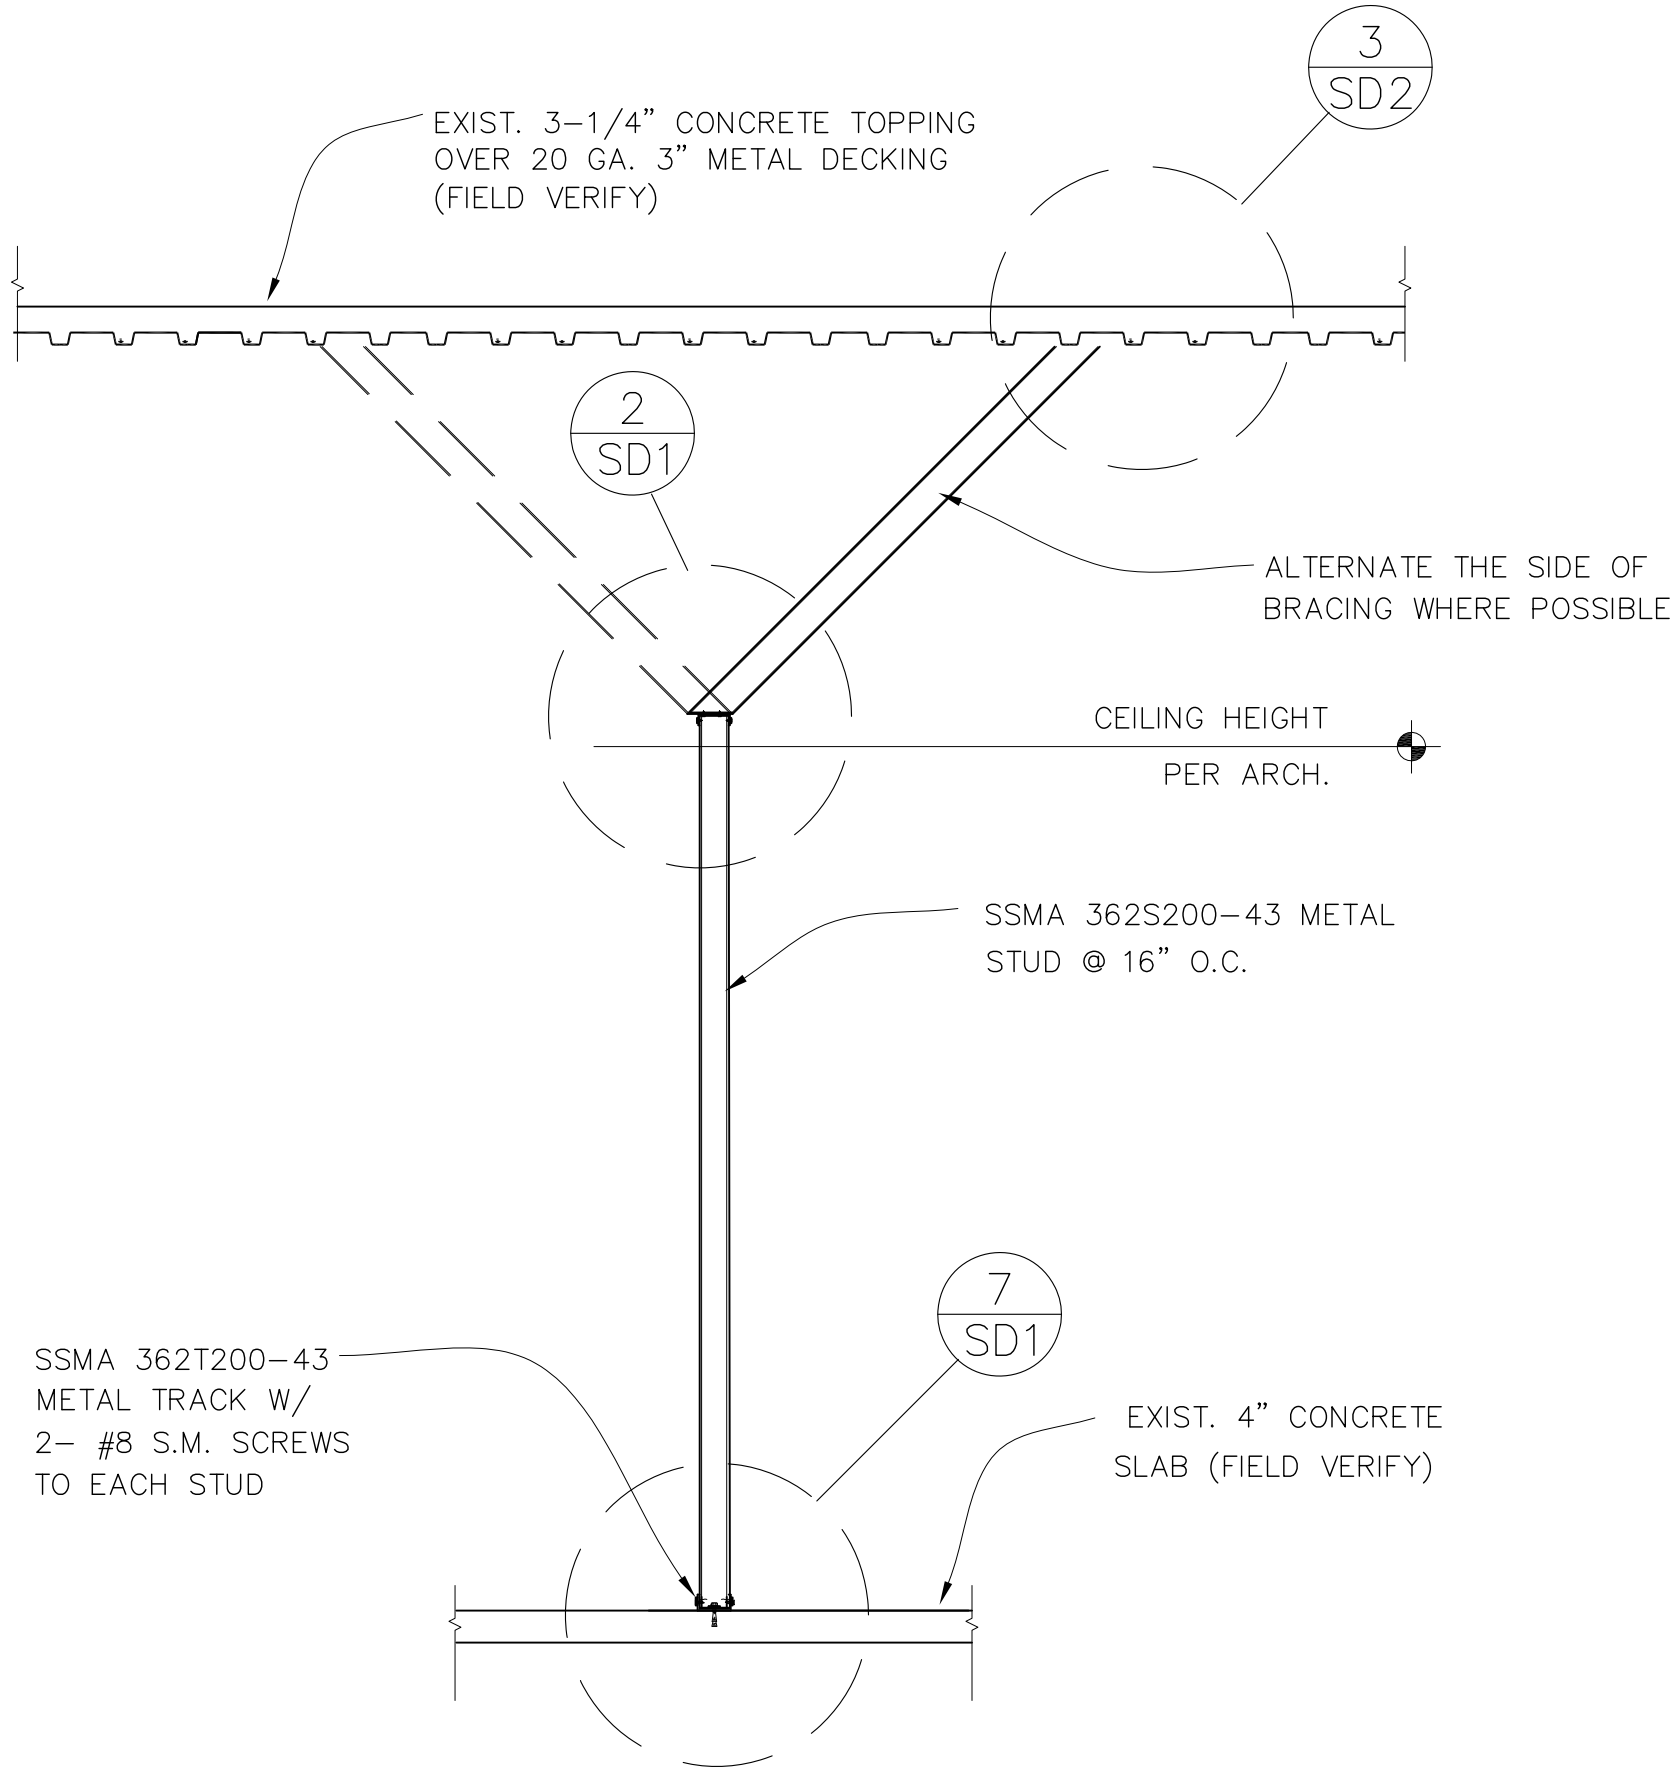


1 DETAIL AT NEW PARTIAL HEIGHT PARTITION WALL
SCALE: 1/2"=1'-0"

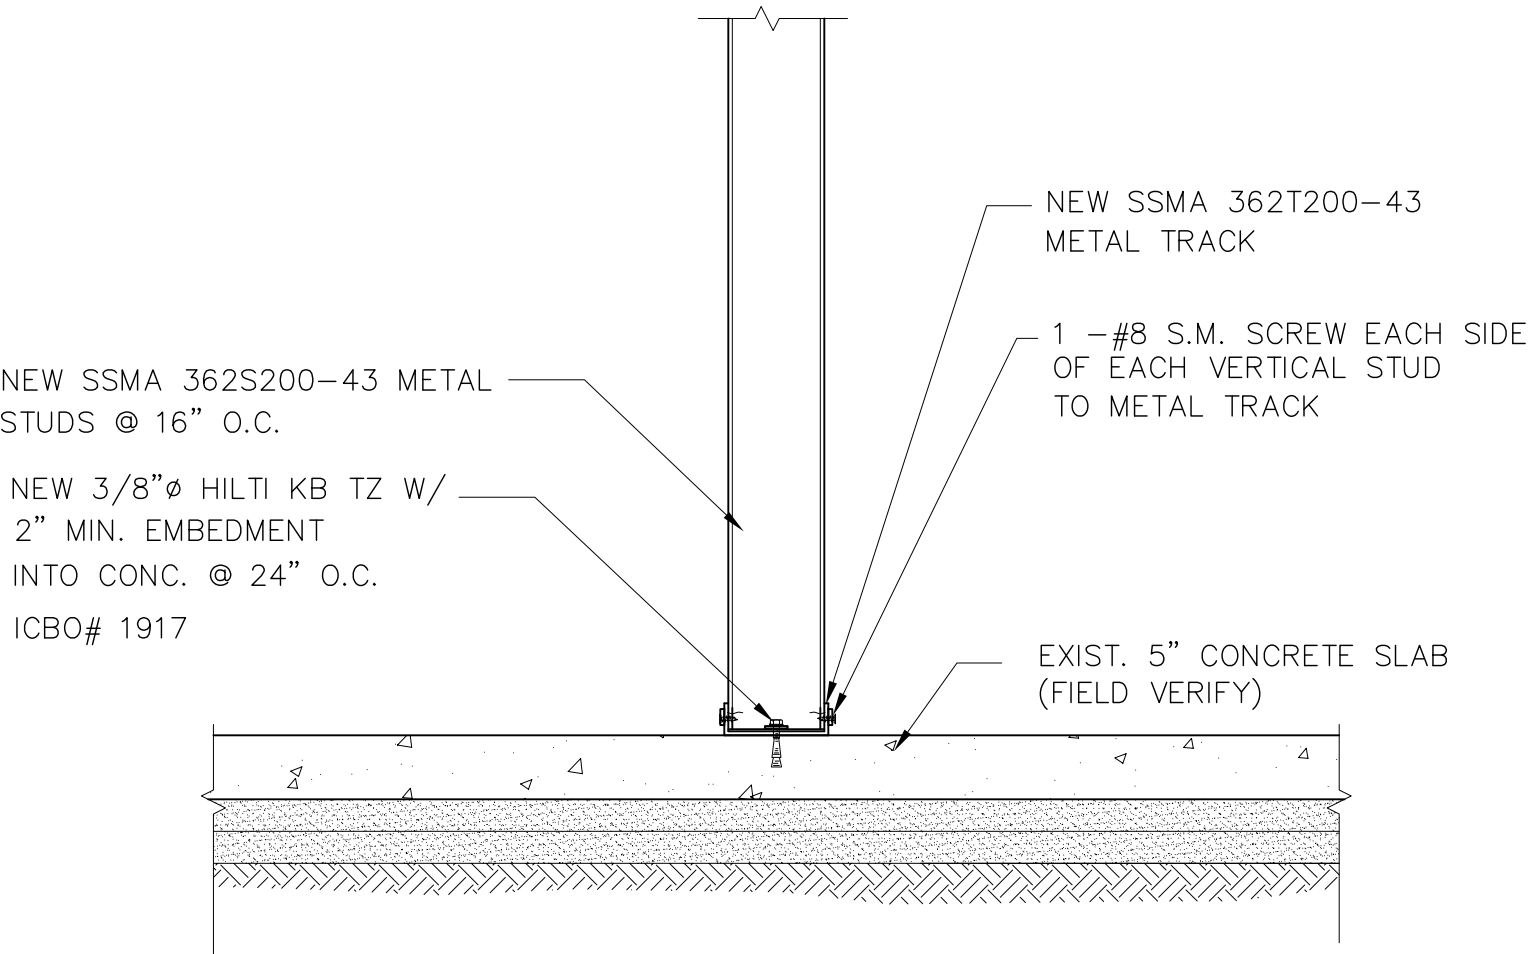


7 TYPICAL PARTITION TO FLOOR CONNECTION
SCALE: 1-1/2"=1'-0"

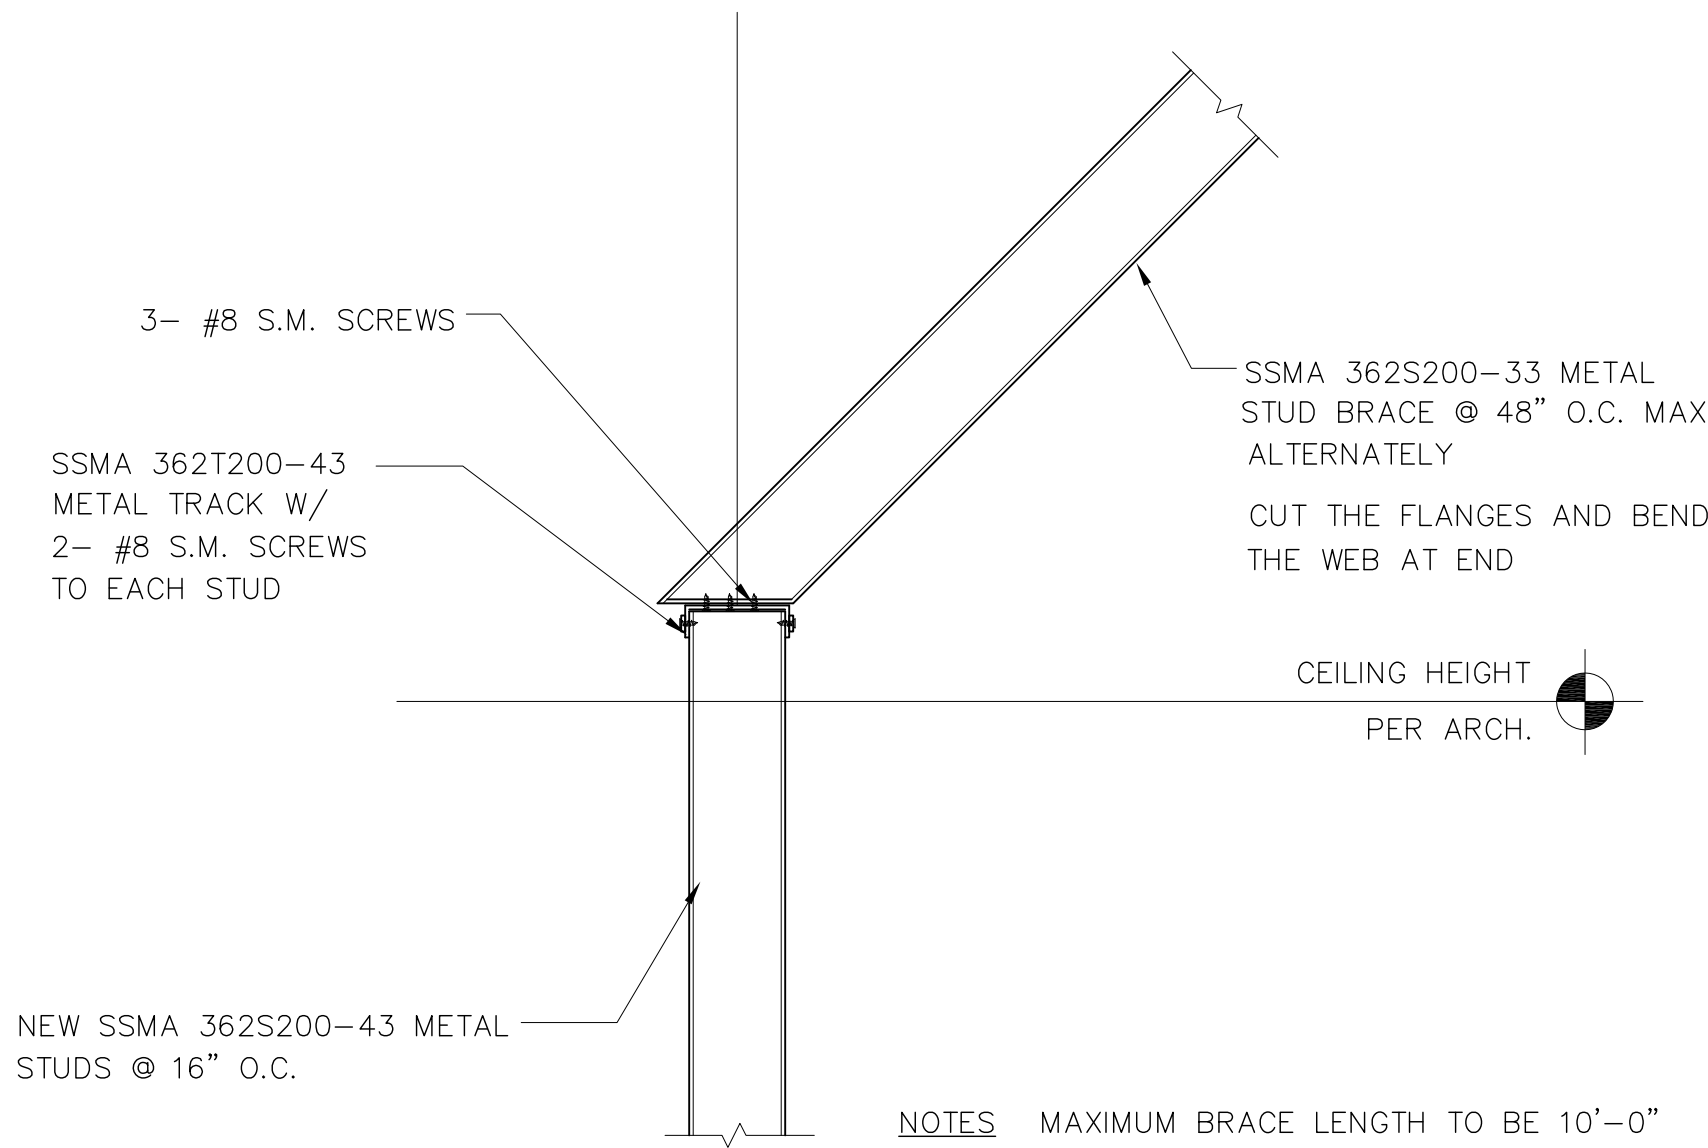


2 TYPICAL BRACING AT TOP OF PARTITION
SCALE: 1-1/2"=1'-0"

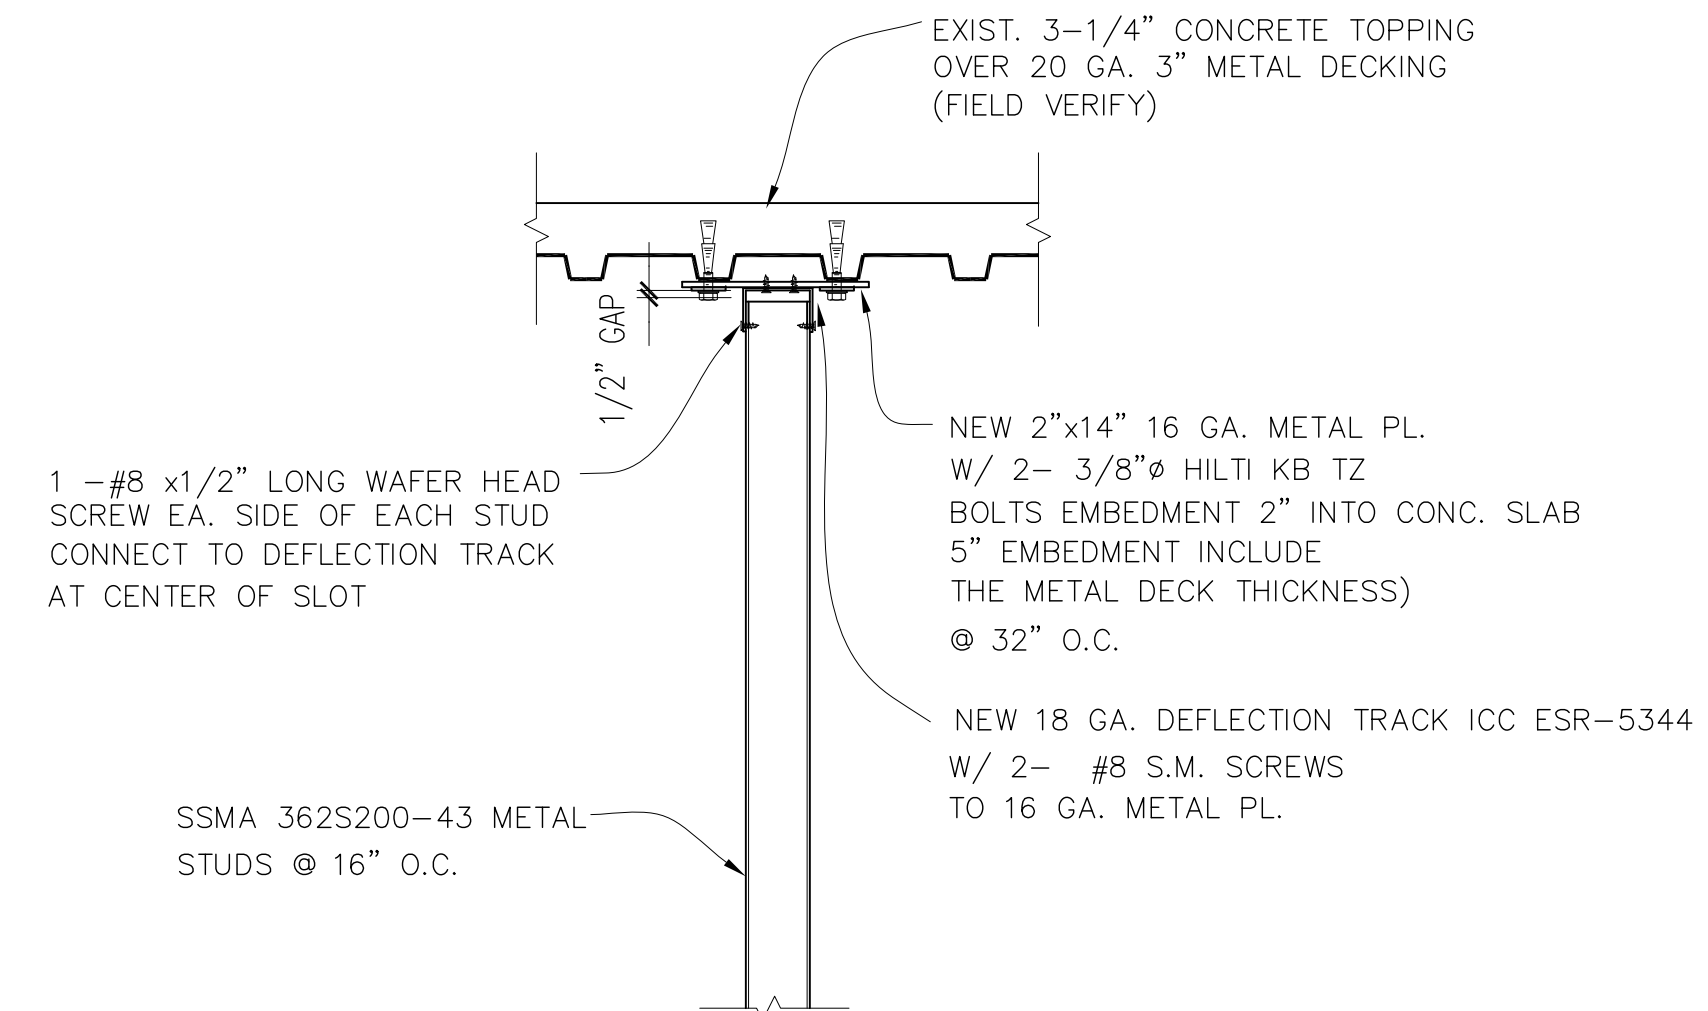


4 CONNECTION AT TOP OF PARTITION @ NEW FULL HEIGHT WALL
SCALE: 1"=1'-0"

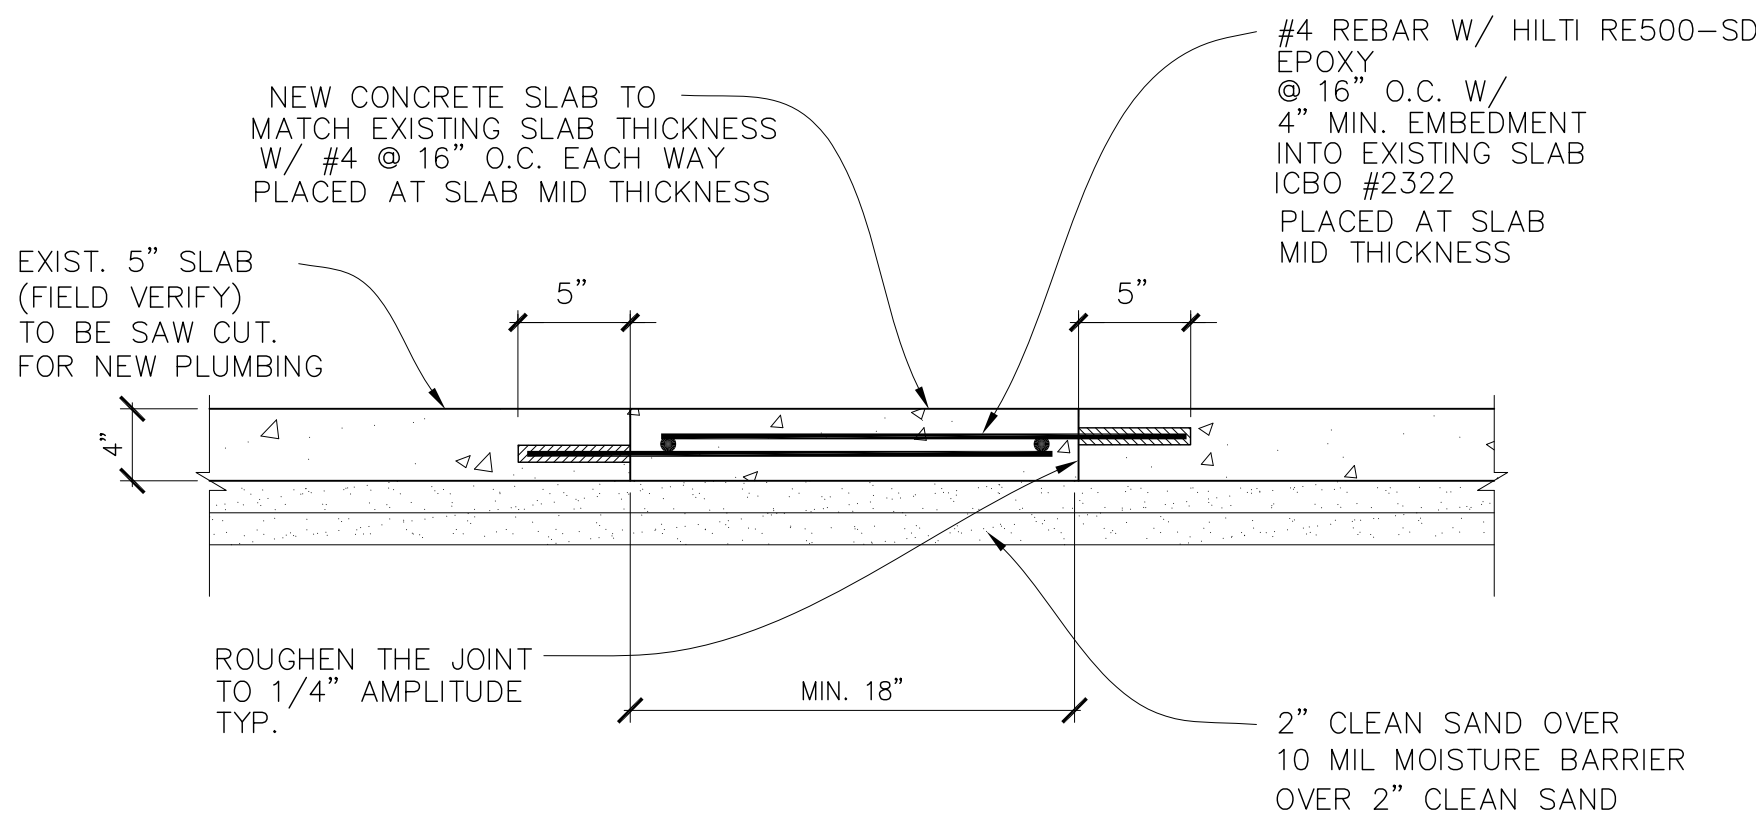

8 SAW CUT SLAB CONNECTION
SCALE: 1-1/2"=1'-0"

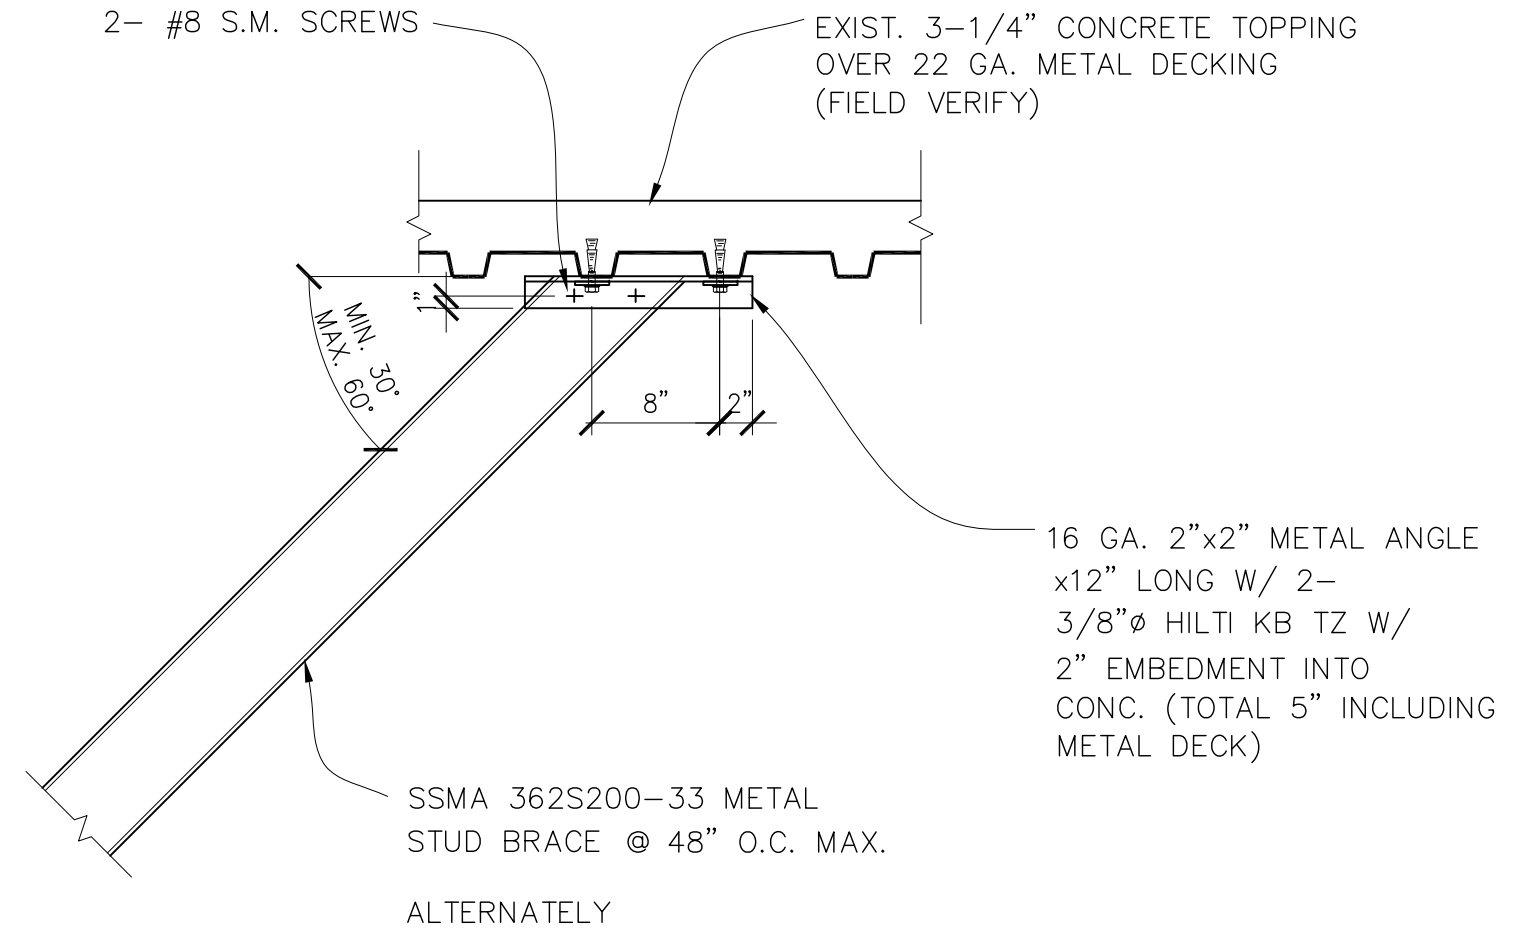

3 TYPICAL BRACING TO FLOOR ABOVE CONNECTION
SCALE: 1-1/2"=1'-0"

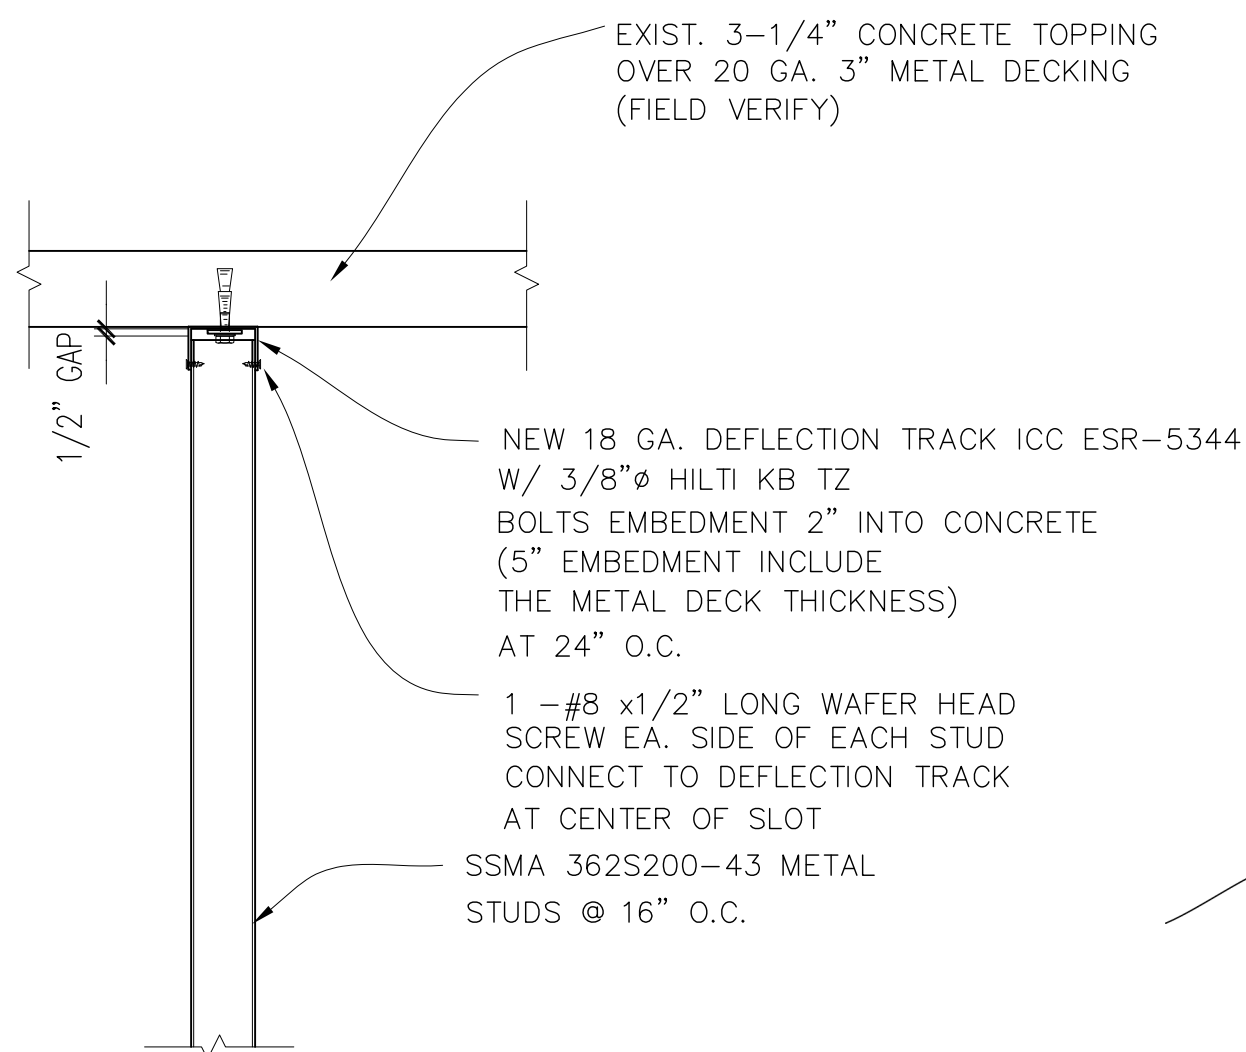

5 CONNECTION AT TOP OF PARTITION @ NEW FULL HEIGHT WALL
SCALE: 1"=1'-0"

TCMC
OBSERVATION
ROOM


TRI-CITY MEDICAL
CENTER
4002 VISTA WAY
OCEANSIDE, CALIFORNIA
92056

OWNER: TRI-CITY MEDICAL CENTER
4002 VISTA WAY
OCEANSIDE, CALIFORNIA 92056
TEL(760)724-8411

ARCHITECT: SFEIR ARCHITECTS
1350 COLUMBIA STREET, SUITE 603
SAN DIEGO, CALIFORNIA 92101
TEL(619)299-3917 FAX(619)299-5084

STRUCTURAL: SUN STRUCTURAL ENGINEERING, INC.
2091 LAS PALMAS DRIVE, SUITE D
CARLSBAD, CALIFORNIA 92011
TEL(760)438-1188

ME&P: P2S ENGINEERING, INC.
9265 CHESAPEAKE DRIVE, SUITE 230
SAN DIEGO, CALIFORNIA 92123
TEL(619)618-2347 FAX(619)330-0668

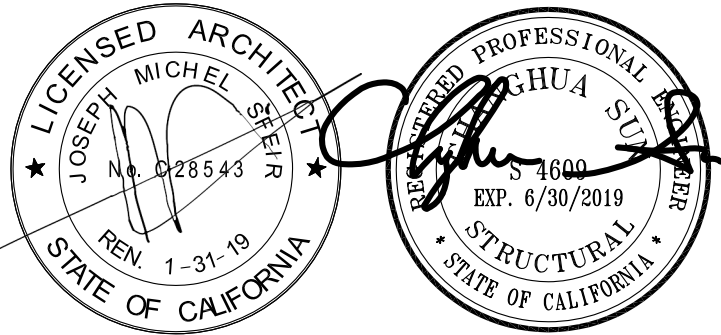

1	1	OSHPD COMMENTS	01/18/2017
2	2	DESIGN CHANGES	01/18/2017
3	3	OSHPD COMMENTS	04/20/2017
4	4	OSHPD COMMENTS	06/14/2017

REV: DESCRIPTION: DATE:

CONSULTANT
SUN Structural Engineering, Inc.
Consulting Structural Engineers
2091 Las Palmas Dr., Suite D
Carlsbad, California 92011
Tel: 760-438-1188
www.sunse-inc.com



07/06/2017 10:49:54 AM
#S162581-37-00
SHEET 1114


DETAILS

PROJECT TITLE: _____


PROJECT #: 01643.00
DRAWN BY: Author
CHECKED BY: Checker
SCALE: As indicated
DATE: 09/22/16

SHEET NUMBER: _____

SD2

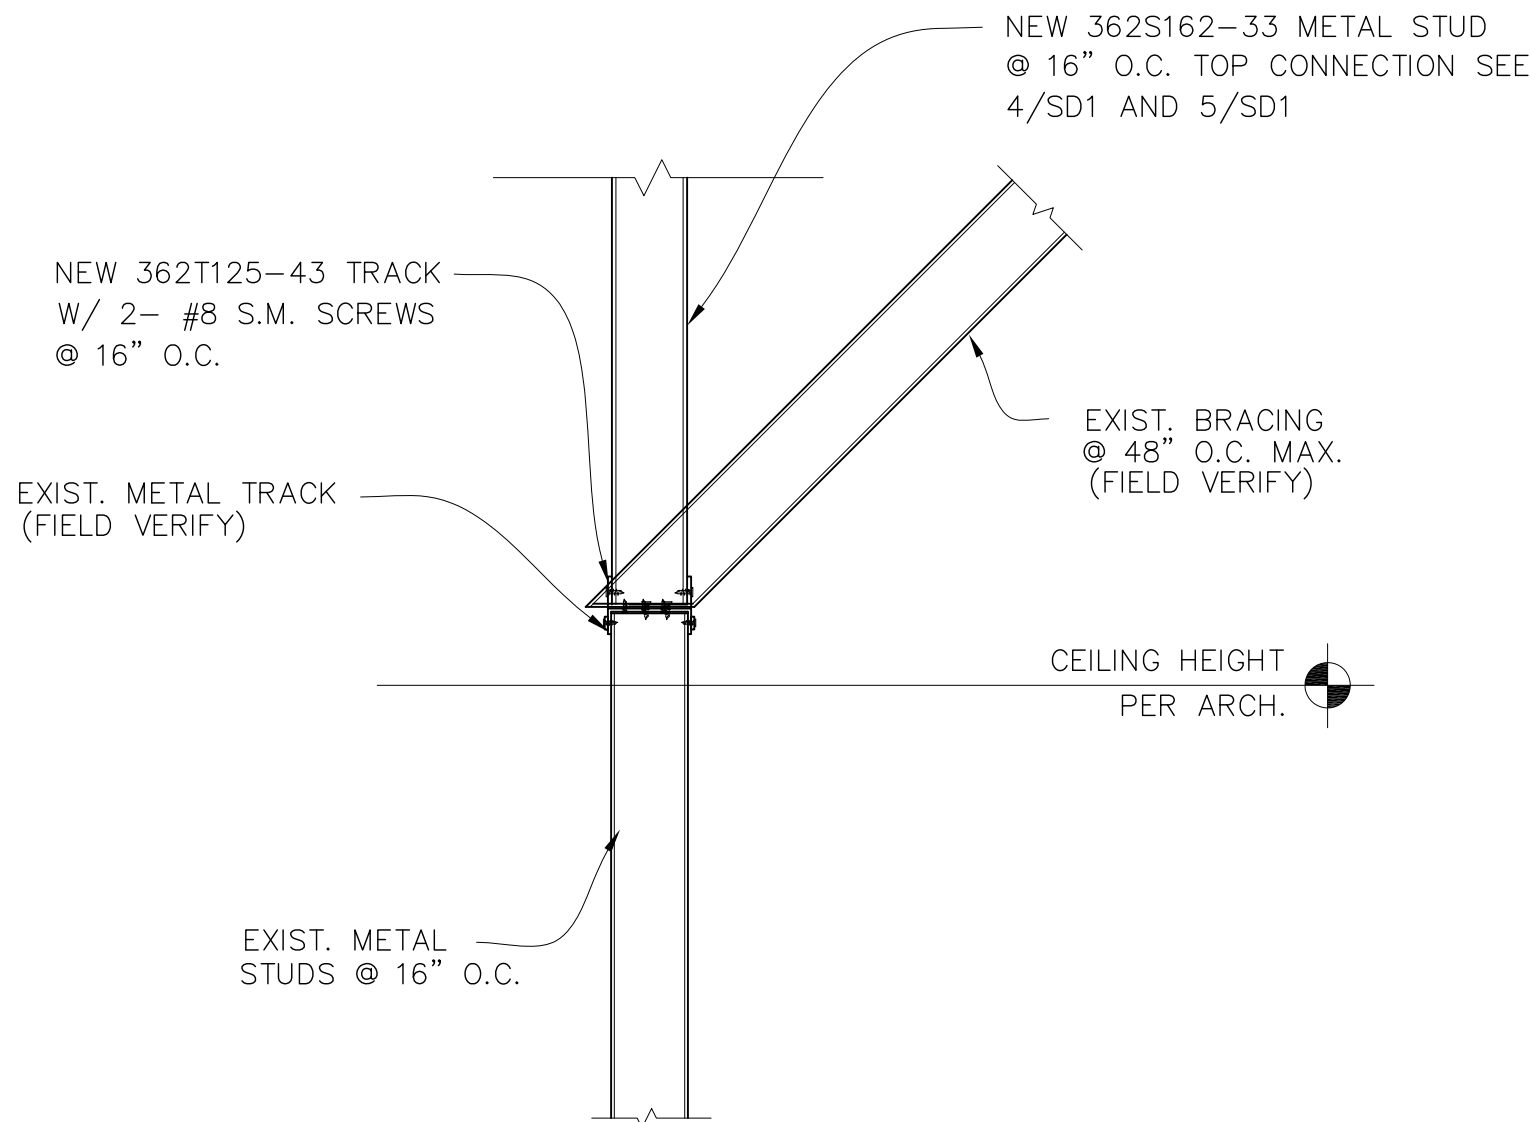

6 EXTENSION FULL HEIGHT WALL
SCALE: 1"=1'-0"

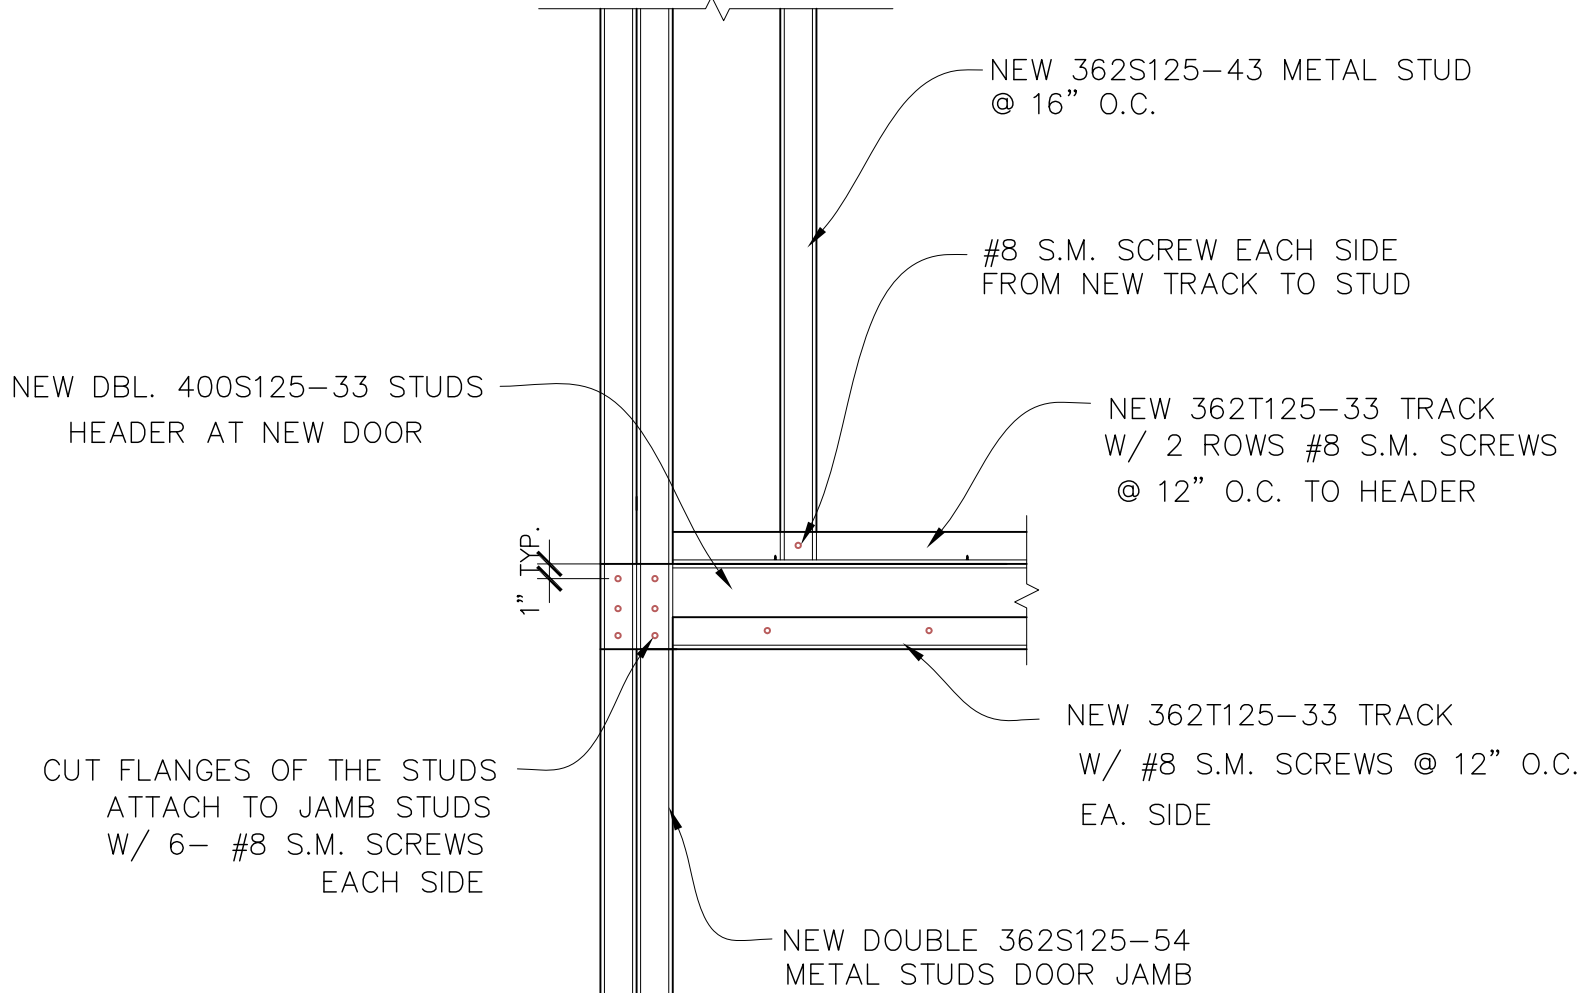

9 DOOR HEADER CONNECTION
SCALE: 1"=1'-0"

LEGEND

SYMBOL	DESCRIPTION
	NOTE CALLOUT
	DETAIL CALLOUT - NUMBER ON TOP DENOTES DETAIL NUMBER - NUMBER ON BOTTOM DENOTES SHEET DETAIL IS SHOWN
	MECHANICAL EQUIPMENT CALLOUT. SEE MECHANICAL PLANS FOR EXACT LOCATION AND REQUIREMENTS
	SECTION CALLOUT
	POINT OF CONNECTION
	POINT OF DISCONNECTION
	NEW LINework
	EXISTING LINework
	DEMOLITION LINework
	NEW PIPING (SIZE-SERVICE)
	SHEET METAL DUCT
	HIDDEN SHEET METAL DUCT
	INTERNALLY INSULATED SHEET METAL DUCT
	DIRECTION OF FLOW
	STANDARD BRANCH FOR SUPPLY AND RETURN
	ROUND ELBOW DOWN
	ROUND ELBOW UP
	RECTANGULAR TO ROUND TRANSITION
	FLEXIBLE DUCT
	FLEX CONNECTION
	BACK DRAFT DAMPER
	FIRE DAMPER
	COMBINATION FIRE AND SMOKE DAMPER
	MOTORIZED DAMPER
	SUPPLY DIFFUSER: 2-WAY/3-WAY/4-WAY
	GRILLE: RETURN/EXHAUST
	1x2' RETURN AIR GRILLE
	2x2' RETURN AIR GRILLE
	SUPPLY AIR DUCT SECTION
	RETURN AIR DUCT SECTION
	EXHAUST AIR DUCT SECTION
	POWER OR GRAVITY ROOF VENTILATOR - EXHAUST
	POWER OR GRAVITY ROOF VENTILATOR - SUPPLY
	UNDERCUT DOOR
	TRANSFER GRILLE OR LOUVER
	DOOR GRILLE OR LOUVER
	SPACE TEMPERATURE SENSOR
	PRESSURE SWITCH
	SMOKE DETECTOR
	STATIC PRESSURE SENSOR

	REFRIGERANT SENSOR
	DEW POINT SENSOR
	HEATING COIL
	DAMPER, OPPOSED BLADE
	DAMPER, PARALLEL BLADE
	LOUVER
	ACCESS DOOR OR ACCESS PANEL (AP) IN DUCTWORK
	TURNING VANES (RECTANGULAR)
	DRAIN, FUNNEL
	CENTRIFUGAL FAN
	2-WAY CONTROL VALVE
	DDC INPUT
	DDC OUTPUT
	LOCALLY MOUNTED INSTRUMENT
	CARBON DIOXIDE SENSOR
	DIFFERENTIAL PRESSURE SENSOR
	FLOW METER
	AIRFLOW SENSOR
	RELATIVE HUMIDITY SENSOR
	TEMPERATURE SENSOR
	AVERAGING TEMPERATURE SENSOR

SYMBOL	DESCRIPTION
	BALL VALVE
	STRAINER, Y-TYPE
	SELF-SEALING PRESSURE AND TEMPERATURE TAP
SYMBOL	DESCRIPTION
	ELBOW FACING AWAY FROM VIEWER
	ELBOW FACING TOWARD VIEWER
	TEE FACING AWAY FROM VIEWER
	TEE FACING TOWARD VIEWER
	PIPE CAP
	FLEXIBLE CONNECTION
	UNION, SCREWED

SHEET INDEX

SHEET	DESCRIPTION
M0-10	GENERAL NOTES, LEGEND AND SHEET INDEX
M0-20	SCHEDULES
M2-10	DEMOLITION AND RENOVATION PLANS
M6-10	DETAILS

ABBREVIATIONS

ABBREVIATION	DESCRIPTION	ABBREVIATION	DESCRIPTION
ABV	ABOVE	KW	KILOWATTS
AC	AIR CONDITIONING UNIT	LAT	LEAVING AIR TEMPERATURE
AFF	ABOVE FINISHED FLOOR	LBS	POUNDS
AHU	AIR HANDLING UNIT	LD	LINEAR DIFFUSER
AP	ACCESS PANEL	LOD	LIMIT OF DEMOLITION
BDD	BACK DRAFT DAMPER	LWT	LEAVING WATER TEMPERATURE
BHP	BRAKE HORSEPOWER	MAX	MAXIMUM
BLDG	BUILDING	MBH	THOUSAND BTU PER HOUR
BTU	BRITISH THERMAL UNIT	MCA	MINIMUM CIRCUIT AMPS
CD	CEILING DIFFUSER	MIN	MINIMUM
CFM	CUBIC FEET PER MINUTE	MOCP	MAXIMUM OVERLOAD CIRCUIT PROTECTION
CV	CONSTANT VOLUME BOX	NIC	NOT IN CONTRACT
D	DRAIN	OAT	OUTSIDE AIR TEMPERATURE
DB	DRY BULB	OBD	OPPOSED BLADE DAMPER
DEG	DEGREES	OSA	OUTSIDE AIR
DIA	DIAMETER	PSD	PRESSURE DROP
DN	DOWN	PERF	PERFORATED
DX	DIRECT EXPANSION	PH	PHASE
EA	EXISTING	POD	POINT OF DISCONNECT
E	EACH	PR	PRESSURE RELIEF
EAT	ENTERING AIR TEMPERATURE	PRV	PRESSURE REDUCING VALVE
EF	EXHAUST FAN	PSID	POUNDS PER SQUARE INCH DIFFERENTIAL
EFF	EFFICIENCY	PSIG	POUNDS PER SQUARE INCH GAUGE
EL	ELEVATION	RA	RETURN AIR
EQ	EQUAL	RAR	RETURN AIR REGISTER
ER	EXHAUST REGISTER	RF	RETURN FAN
ESP	EXTERNAL STATIC PRESSURE	RHC	RE-HEAT COIL
EW	ENTERING WATER TEMPERATURE	RLA	RATED LOAD AMPS
F	DEGREES FAHRENHEIT	RPM	REVOLUTIONS PER MINUTE
FC	FAN COOL UNIT	SA	SUPPLY AIR
FD	FIRE DAMPER	SAR	SUPPLY AIR REGISTER
FLA	FULL LOAD AMPS	SD	SMOKE DAMPER
FLR	FLOOR	SF	SUPPLY FAN
FOB	FLAT ON BOTTOM	SMBH	SENSIBLE MBH
FOT	FLAT ON TOP	STD	STANDARD
FP	FIRE PUMP	TAD	TRANSFER AIR DUCT
FPI	FINS PER INCH	TEMP	TEMPERATURE
FPM	FEET PER MINUTE	TG	TRANSFER GRILLE
FT	FEET OR FOOT	TMBH	TOTAL MBH
FX	FLEXIBLE CONNECTION	TSP	TOTAL STATIC PRESSURE
GA	GAUGE	TYP	TYPICAL
GALV	GALVANIZED	UC	UNDERCUT
GC	GENERAL CONTRACTOR	UON	UNLESS OTHERWISE NOTED
GPH	GALLONS PER HOUR	V	VOLTS
GPM	GALLONS PER MINUTE	VAV	VARIABLE AIR VOLUME UNIT
HB	HOSE BIBB	VD	VOLUME DAMPER
HD	HEAD	VFD	VARIABLE FREQUENCY DRIVE
HP	HEAT PUMP	W	WITH
HP	HORSEPOWER	W/O	WITHOUT
HT	HEIGHT	WB	WET BULB
HZ	HERTZ	WC	WATER COLUMN
IN	INCHES	WG	WATER GAUGE
		WT	WEIGHT

REFERENCE WILL BE MADE TO ANSI Y1.1, MILITARY STANDARD IN THE EVENT ABBREVIATIONS NOT MENTIONED HEREIN ARE USED, ABBREVIATIONS, AND OTHER STANDARD INDUSTRY CONVENTIONS.

PROJECT NOTES

- CONTRACTOR SHALL COORDINATE ARCHITECTURAL REFLECTED CEILINGS PLANS WITH ALL DISCIPLINES TO VERIFY CLEARANCES BETWEEN HVAC DUCTS, HVAC PIPING, LIGHT FIXTURES, ELECTRICAL DATA CONDUITS, PLUMBING LINES, FIRE PROTECTION LINES, STRUCTURAL MEMBERS, ETC. SPECIAL ATTENTION IS REQUIRED ALONG THE LENGTH OF MAIN MECHANICAL SUPPLY AND RETURN AIR DUCTS WHERE THERE IS LIMITED CLEARANCE FOR PASSAGE OR ROUTING OF UTILITIES.
- THE SPACE FOR DUCT WORK & MECHANICAL EQUIPMENT FOR THIS PROJECT IS LIMITED. COORDINATION WITH OTHER TRADES IS CRITICAL. PROCEED WITH PREPARATION OF SHOP DRAWINGS IMMEDIATELY UPON RECEIVING AN AUTHORIZATION TO PROCEED FOR THE PROJECT. COMPLETE SHOP DRAWINGS PRIOR TO MATERIAL FABRICATION AND INSTALLATION. SHOP DRAWINGS SHALL BE REVIEWED BY COMMISSIONING AGENT, MEOR AND OWNERS REPRESENTATIVE PRIOR TO SUBMITTAL.
- PROVIDE ORIGINALLY PREPARED CONTRACTORS SHOP DRAWINGS IN ELECTRONIC FORMAT. IN ADDITION TO THE REQUIREMENTS SPECIFIED ELSEWHERE, THE SHOP DRAWINGS SHALL INCLUDE THE FOLLOWING:
 - DUCT, PIPE AND PLUMBING ELEVATIONS.
 - DOUBLE LINE DUCTWORK AND PIPING (6" & LARGER).
 - ACTUAL SIZE OF PURCHASED EQUIPMENT. PER APPROVED CONTRACTORS SHOP DRAWINGS.
 - ACCESS PANELS INCLUDING CEILING PANELS.
 - ACCESS CLEARANCES FOR EQUIPMENT.
 - ACTUAL LOCATIONS OF CEILING DIFFUSERS, REGISTERS, AND RETURN REGISTERS.
 - LOCATIONS OF STRUCTURAL MEMBERS SUCH AS BEAMS.
 - ACTUAL LOCATIONS OF CONTROL PANELS AND POWER CONNECTIONS TO EQUIPMENT.
 - COLOR CODED DUCT AND PIPING BASED ON MATERIAL USED.
 - MINIMUM 1/4"=1'-0" SCALE DRAWINGS.
 - LABEL AND TAG SCHEDULE FOR EQUIPMENT.
 - DUCT TRANSITIONS TO CLEAR BEAMS OR TIGHT AREAS.
 - ROOM TEMPERATURE SENSOR LOCATIONS.
 - POINT OF CONNECTION TO UTILITIES OUTSIDE THE BUILDING.
 - SECTIONS OR 3-D DRAWINGS OF CONGESTED AREAS.
 - GRID LINES.
 - UTILITY PROFILES FOR UNDERGROUND PIPING.
- DO NOT COMMENCE WITH ANY INSTALLATION, ORDERING OF ANY EQUIPMENT OR MATERIAL FABRICATION WITHOUT AN APPROVED SHOP DRAWING SUBMITTAL.
- FOR EACH SUBMITTAL THE CONTRACTOR SHALL PROVIDE A LETTER (ON COMPANY LETTERHEAD) AND SIGNED BY THE PROJECT MANAGER INDICATING THE SUBMITTAL HAS BEEN FULLY IN HOUSE REVIEWED TO ENSURE FULL COMPLIANCE WITH THE CONTRACT DOCUMENTS AND COORDINATION WITH OTHER TRADES. ANY EXCEPTIONS TO THE CONTRACT DOCUMENTS SHALL BE CLEARLY INDICATED ON THIS LETTER. ANY DISCREPANCIES/EXCEPTIONS NOT IDENTIFIED IN WRITING SHALL BE CORRECTED AT THE SOLE EXPENSE OF THE CONTRACTOR AND AT NO EXPENSE TO THE OWNER AND ENGINEER.

GENERAL NOTES

- ALL WORK SHALL COMPLY WITH THE 2013 EDITIONS OF THE CALIFORNIA BUILDING, MECHANICAL, PLUMBING, AND OTHER APPLICABLE FEDERAL, STATE, OR LOCAL CODES AS ADOPTED AND ENFORCED BY THE LOCAL JURISDICTION. IN CASE THE PLANS SHOW MORE STRINGENT REQUIREMENTS, THE PLANS SHALL GOVERN THE DESIGN. YET NOTHING ON THE DESIGN DOCUMENTS SHALL BE INTERPRETED AS AUTHORITY TO VIOLATE CODE(S) OR REGULATION(S).
- SUBMISSION OF BID IN CONNECTION WITH THIS WORK SHALL IMPLY THAT THE BIDDER HAS EXAMINED THE JOB SITE UNDER WHICH THE CONTRACTOR WILL BE OBLIGATED TO OPERATE UNDER THIS CONTRACT. NO EXTRA CHARGE WILL BE ALLOWED FOR FAILURE OF ANY BIDDER TO EXAMINE THE SITE PRIOR TO BID.
- WHERE USED, THE TERM "PROVIDE" SHALL MEAN "FURNISH AND INSTALL".

GENERAL NOTES

- IN THE EVENT OF A CONFLICT OR INCONSISTENCY BETWEEN ITEMS INDICATED ON DESIGN PLANS / SPECIFICATIONS WITH CODE REQUIREMENTS, THE MORE STRINGENT STANDARD SHALL PREVAIL.
- THIS CONTRACTOR SHALL FURNISH LABOR, MATERIALS, EQUIPMENT, AND TRANSPORTATION AS REQUIRED TO PROPERLY INSTALL ALL NEW HVAC SYSTEMS OR RELATED COMPONENTS AS INDICATED ON PLANS AND SPECIFIED HEREIN.
- ALL NEW EQUIPMENT AND MATERIAL TO BE INSTALLED AS PART OF THIS PROJECT SHALL BEAR AN UNDERWRITERS' LABORATORIES LABEL (UL), AND INSTALLED IN SUCH A MANNER FOR WHICH THEY ARE DESIGNED AND APPROVED.
- THIS CONTRACTOR SHALL DOCUMENT AND RELAY ANY MAJOR DEVIATIONS FROM THE DESIGN DOCUMENTS, AND ATTAIN APPROVAL FROM THE MECHANICAL ENGINEER BEFORE PROCEEDING. AS-BUILT COPIES SHALL BE PROVIDED INDICATING ALL CHANGES / DEVIATIONS MADE DURING CONSTRUCTION.
- ALL WORK SHALL BE PERFORMED IN A CLEAN AND WORKMANLIKE MANNER. CARE SHALL BE EXERCISED TO MINIMIZE ANY INCONVENIENCE OR DISTURBANCE TO OTHER AREAS OF THE BUILDING WHICH ARE TO REMAIN IN OPERATION. ISOLATE WORK AREAS BY MEANS TO KEEP DUST AND DIRT WITHIN THE CONSTRUCTION AREA.
- NO PIPING, EQUIPMENT, ETC. SHALL BE REMOVED, DISCONNECTED OR SHUT DOWN WITHOUT PRIOR REVIEW WITH THE OWNER TO CONFIRM THAT AREAS TO REMAIN IN OPERATION WILL NOT BE AFFECTED. IF ANY AREAS NOT WITHIN THE SCOPE OF WORK ARE AFFECTED BY ANY SHUTDOWN, REMOVAL OR DISCONNECTION, SUFFICIENT ADVANCE NOTICE MUST BE GIVEN TO THE OWNER INDICATING WHICH AREAS WILL BE AFFECTED, WHEN THE PROPOSED SHUTDOWN WILL OCCUR, AND FOR HOW LONG A PERIOD OF TIME.
- THE ARRANGEMENT OF EQUIPMENT AND PIPING SHOWN ON THE DRAWINGS IS BASED UPON INFORMATION AVAILABLE TO THE ENGINEER AT THE TIME OF DESIGN AND IS NOT INTENDED TO SHOW EXACT DIMENSIONS PECULIAR TO A SPECIFIC MANUFACTURER. THE DRAWINGS ARE, IN PART, DIAGRAMMATIC AND SOME FEATURES OF THE ILLUSTRATED EQUIPMENT INSTALLATION MAY REQUIRE REVISION TO MEET ACTUAL EQUIPMENT INSTALLATION REQUIREMENTS. STRUCTURAL SUPPORTS, FOUNDATIONS, CONNECTED PIPING, VALVES AND ELECTRICAL CONDUIT SPECIFIED MAY HAVE TO BE ALTERED TO ACCOMMODATE THE EQUIPMENT PROVIDED. NO ADDITIONAL PAYMENT WILL BE MADE FOR SUCH REVISIONS AND ALTERATIONS.
- THIS CONTRACTOR SHALL VERIFY ALL DIMENSIONS AT THE SITE MAKING FIELD MEASUREMENTS AND SHOP DRAWINGS NECESSARY FOR FABRICATION OR ERECTION OF HVAC SYSTEMS. MAKE ALLOWANCE FOR BEAMS, PIPES AND OTHER OBSTRUCTIONS IN BUILDING CONSTRUCTION. CHECK DRAWINGS SHOWING WORK OF OTHER TRADES AND CONSULT WITH THE OWNERS REPRESENTATIVE IN THE EVENT OF POTENTIAL INTERFERENCE. SHOP DRAWINGS SHALL BE MINIMUM 1/4"=1'-0" SCALE, INDICATING FITTINGS, SIZES, WELDS AND CONFIGURATIONS AND SUBMITTED TO ENGINEER FOR REVIEW.
- THIS CONTRACTOR SHALL COORDINATE HIS WORK WITH ALL OTHER TRADES PRIOR TO FABRICATION, PURCHASE AND/OR INSTALLATION OF ALL WORK.
- BEFORE COMMENCEMENT OF WORK, THIS CONTRACTOR SHALL VERIFY THE EXACT LOCATIONS, ELEVATIONS, AND CHARACTERISTICS OF ALL UTILITIES.
- CONTRACTOR SHALL SECURE AND PAY ALL FEES AND PERMITS PERTAINING TO THE CONTRACT.
- EXISTING MATERIALS THAT ARE REMOVED SHALL NOT BE REUSED IN NEW SYSTEMS, EXCEPT WHERE INDICATED AS BEING RELOCATED.
- ALL EQUIPMENT SHALL BE INSTALLED IN STRICT COMPLIANCE WITH THE MANUFACTURERS WRITTEN INSTRUCTIONS.
- GALVANIZED SHEET METAL SHALL BE PROVIDED FOR ALL HVAC DUCT SYSTEMS, AND CONSTRUCTED / SUPPORTED / INSTALLED IN ACCORDANCE WITH THE 2010 CALIFORNIA MECHANICAL CODE AND THE LATEST SMACNA STANDARDS.
- ALL PIPING SHALL BE INSTALLED AS INDICATED ON THE DRAWINGS IN A NEAT WORKMANSHIP-LIKE MANNER AND BE SUPPORTED AS REQUIRED BY CODES. PIPING SHALL BE SET UP AND DOWN AND OFFSET AS REQUIRED TO SUIT FIELD CONDITIONS. DIELECTRIC COUPLINGS SHALL BE USED WHERE DISSIMILAR METALS ARE JOINED. PIPING SHALL BE TYPE L COPPER.
- THIS CONTRACTOR SHALL PROVIDE ALL NECESSARY SUPPORTS FOR FIXTURES, DUCTWORK, PIPING, AND MECHANICAL EQUIPMENT. IN ORDER TO COMPLY WITH CALIFORNIA BUILDING CODE, SMACNA INSTALLATION STANDARDS, AND ALL RELATED LOCAL ORDINANCES.
- THIS CONTRACTOR SHALL NOT BORE, NOTCH, CUT, OR PENETRATE INTO A STRUCTURAL MEMBER WITHOUT WRITTEN APPROVAL FROM A DESIGNATED STRUCTURAL ENGINEER AND THE OWNER.
- ALL PIPE ELBOWS SHALL BE LONG RADIUS UNLESS OTHERWISE SPECIFICALLY NOTED ON THE DRAWINGS.
- ISOLATE AND DRAIN EXISTING PIPING SYSTEM AS REQUIRED TO ACCOMMODATE INSTALLATION OF THE WORK.
- ALL MATERIAL EXPOSED WITHIN RA PLENUMS SHALL BE NON-COMBUSTIBLE OR SHALL HAVE A FLAME SPREAD INDEX NOT GREATER THAN 25 AND SMOKE DEVELOPED INDEX NOT GREATER THAN 50. COMPLY WITH CMC-602.2.
- 2013 CBC MECHANICAL, ELECTRICAL AND PLUMBING EQUIPMENT ANCHORAGE NOTES:

ALL MECHANICAL, PLUMBING, AND ELECTRICAL COMPONENTS SHALL BE ANCHORED AND INSTALLED PER THE DETAILS ON THE OSHPD APPROVED CONSTRUCTION DOCUMENTS. WHERE NO DETAIL IS INDICATED, THE FOLLOWING COMPONENTS SHALL BE ANCHORED OR BRACED TO MEET THE FORCES AND DISPLACEMENT REQUIREMENTS PRESCRIBED IN THE 2013 CBC SECTIONS 1615A.1.17 THROUGH 1616A.1.27 AND ASCE 7-10 CHAPTER 13.

- ALL PERMANENT EQUIPMENT AND COMPONENTS.
- TEMPORARY OR MOVABLE EQUIPMENT THAT IS PERMANENTLY ATTACHED (E.G. HARD WIRED) TO THE BUILDING UTILITY SERVICES SUCH AS ELECTRICITY, GAS OR WATER.
- MOVABLE EQUIPMENT WHICH IS STATIONED IN ONE PLACE FOR MORE THAN 8 HOURS AND HEAVIER THAN 400 POUNDS ARE REQUIRED TO BE ANCHORED WITH TEMPORARY ATTACHMENTS.

THE ATTACHMENT OF THE FOLLOWING MECHANICAL AND ELECTRICAL COMPONENT SHALL BE POSITIVELY ATTACHED TO THE STRUCTURE, BUT NEED NOT BE DETAILED ON THE PLANS. THESE COMPONENTS SHALL HAVE FLEXIBLE CONNECTIONS PROVIDED BETWEEN THE COMPONENT AND ASSOCIATED DUCTWORK, PIPING, AND CONDUIT.

- COMPONENTS WEIGHING LESS THAN 400 POUNDS AND HAVE A CENTER OF MASS LOCATED 4 FEET OR LESS ABOVE THE ADJACENT FLOOR OR ROOF LEVEL THAT DIRECTLY SUPPORTS THE COMPONENT.
- COMPONENTS WEIGHING LESS THAN 20 POUNDS, OR IN THE CASE OF DISTRIBUTED SYSTEMS, LESS THAN 5 POUNDS PER FOOT, WHICH ARE SUSPENDED FROM A ROOF OR FLOOR OR HUNG FROM A WALL.

FOR THOSE ELEMENTS THAT DO NOT REQUIRE DETAILS ON THE APPROVED DRAWINGS, THE INSTALLATION SHALL BE SUBJECT TO THE APPROVAL OF THE STRUCTURAL ENGINEER OF RECORD. THE PROJECT INSPECTOR WILL VERIFY THAT ALL COMPONENTS AND EQUIPMENT HAVE BEEN ANCHORED IN ACCORDANCE WITH ABOVE REQUIREMENTS.

- PIPING, DUCTWORK, AND ELECTRICAL DISTRIBUTION SYSTEM BRACING NOTES:

PIPING, DUCTWORK, AND ELECTRICAL DISTRIBUTION SYSTEMS SHALL BE BRACED TO COMPLY WITH THE FORCES AND DISPLACEMENTS PRESCRIBED IN ASCE 7-05 SECTION 13.3 AS DEFINED IN ASCE 7-10 13.6.1 TO 13.6.8 AND 2013 CBC SECTIONS 1616A.1.23, 1616A.1.24, 1616A.1.25 AND 1616A.1.26.

THE BRACING AND ATTACHMENTS TO THE STRUCTURE SHALL BE DETAILED ON THE APPROVED DRAWINGS OR THEY SHALL COMPLY WITH ONE OF THE OSHPD PRE-APPROVALS (OPA #) AS MODIFIED TO SATISFY ANCHORAGE REQUIREMENTS OF ACI 318, APPENDIX D.

COPIES OF THE MANUAL SHALL BE AVAILABLE ON THE JOBSITE PRIOR TO THE START OF HANGING AND BRACING OF THE PIPE, DUCTWORK, AND ELECTRICAL DISTRIBUTION SYSTEMS.

THE STRUCTURAL ENGINEER OF RECORD SHALL VERIFY THE ADEQUACY OF THE STRUCTURE TO SUPPORT THE HANGER AND BRACE LOADS.

S F E I R
A R C H I T E C T S

1350 Columbia Street, Suite 603
San Diego, CA 92101

P: 619-299-3917
F: 619-299-5084
www.sfeirarch.com

TCMC
OBSERVATION
ROOM

TRI-CITY MEDICAL
CENTER
4002 VISTA WAY
OCEANSIDE, CALIFORNIA
92056

OWNER:	TRI-CITY MEDICAL CENTER 4002 VISTA WAY OCEANSIDE, CALIFORNIA 92056 TEL(760)724-8411
ARCHITECT:	SFEIR ARCHITECTS 1350 COLUMBIA STREET, SUITE 603 SAN DIEGO, CALIFORNIA 92101 TEL(619)299-3917 FAX(619)299-5084
STRUCTURAL:	SUN STRUCTURAL ENGINEERING, INC. 2091 LAS PALMAS DRIVE, SUITE D CARLSBAD, CALIFORNIA 92011 TEL(760)438-1188
ME&P:	P2S ENGINEERING, INC. 9665 CHESAPEAKE DRIVE, SUITE 230 SAN DIEGO, CALIFORNIA 92123 TEL(619)299-3917 FAX(619)299-5084



OSHPD COMMENTS	12/02/2016
DESIGN CHANGES	12/02/2016
OSHPD COMMENTS	04/20/2017
OSHPD COMMENTS	06/14/2017

REV: _____ DESCRIPTION: _____ DATE: _____

CONSULTANT

p2s P2S Engineering, Inc.
9665 Chesapeake Dr., Suite #230
San Diego, CA 92123
T 619.618.2347 F 619.330.0668
www.p2seng.com

OSHPD APPROVAL STAMP:

OSHPD #: S162581-37-00

REVIEWED IN ACCORDANCE WITH THE REQUIREMENTS OF T24, CCR

APPROVED

Laura Baldrati, Sr. Architect

Office of Statewide Health Planning & Development
FACILITIES DEVELOPMENT DIVISION

07/06/2016 10:49:54 AM
#S162581-37-00

GENERAL NOTES,
LEGEND, AND SHEET
INDEX

PROJECT TITLE:	TCMC OBSERVATION ROOM
PROJECT # 01643.00	SHEET NUMBER:
DRAWN BY: ED	
CHECKED BY: PAL	
SCALE: As indicated	
DATE: 10/11/16	P2S No. 8452

M0-10

DWG: V:\CAD Drawings\4652Mechanical\M0-20.dwg USER: Kyle Manning
DATE: Jun 15, 2017 5:41pm XREFS: Schedules-24636 - IMAGES

AIR BALANCE SCHEDULE

ROOM NUMBER	ROOM NAME	ROOM AREA (SF)	CEILING HEIGHT (FT)	CODE REQUIREMENTS PER CMC TABLE 4-A								PROPOSED DESIGN						ACTUAL 2							REMARKS
				ROOM SUPPLY (CFM)	ROOM EXHAUST (CFM)	ROOM RETURN (CFM)	ROOM OUTSIDE (CFM)	ROOM TOTAL AIR CHANGES (AC/HR)	ROOM OUTSIDE AIR (AC/HR)	AIR BALANCE RELATIONSHIP TO ADJACENT AREAS	ROOM EXHAUST (YES/NO)	ROOM SUPPLY (CFM)	ROOM EXHAUST (CFM)	ROOM RETURN (CFM)	ROOM TOTAL AIR CHANGES (AC/HR)	ROOM OUTSIDE AIR (AC/HR)	ROOM EXHAUST (AC/HR)	AIR BALANCE RELATIONSHIP TO ADJACENT AREAS	ROOM SUPPLY (CFM)	ROOM EXHAUST (CFM)	ROOM RETURN (CFM)	ROOM TOTAL AIR CHANGES (AC/HR)	ROOM OUTSIDE AIR (AC/HR)	ROOM EXHAUST (AC/HR)	
168	OBSERVATION ROOM	190	8'-8"	220	-	-	55	6	2	NR	NO	220	-	150	8.0	2.8	-								1 3 4
168A	VESTIBULE	43	8'-0"	35	-	-	1	6	2	NR	NO	75	-	-	13.1	-	-								1 3
168B	TOILET ROOM	55	8'-0"	-	73	-	-	10	-	N	YES	-	75	-	10	-	10								1 3

- 1P = POSITIVE, NR = NO REQUIREMENT FOR CONTINUOUS DIRECTIONAL CONTROL, N = NEGATIVE
- 2TO BE COMPLETED BY CONTRACTOR.
- 3TRANSFER
- 4(E) AHU, 35% OSA

CV BOX

MARK	MANUFACTURER & MODEL	LOCATION	SERVICE (ROOM)	INLET SIZE IN	AIRFLOW		HEATING COIL										REMARKS	
					MAX CFM	MIN CFM	AIRSIDE					WATERSIDE						
							HTG. MBH	EAT °F	LAT °F	MAX PD IN	GPM	EWT °F	LWT °F	MAX PD FT	ROWS			
HC-1	TITUS PESV	CORRIDOR	OBSERVATION ROOM	6	220	220	9.5	55	95	.15	.95	180	160	5	2	1	2	3

- 1CONTROL VALVE 3-WAY 3 PSI DROP @ FULL FLOW
- 212"x8" COIL
- 3PNEUMATIC, PRESSURE INDEPENDENT, CV BOX

GRILLES, REGISTERS, DIFFUSERS

MARK	DESCRIPTION	MATERIAL	STYLE	FRONT BLADES	DAMPER	FINISH	REMARKS									
CD-1	PRICE SMCD	STEEL	HARD LID	PERFORATED	N/A	1	2									
EG-1	PRICE 530	STEEL	HARD LID	PERFORATED	N/A	1	2									
RG-1	PRICE PFRF	STEEL	HARD LID	PERFORATED	N/A	1	2									

- 1COORDINATE WITH ARCHITECT
- 2TAMPER PROOF FACE FOR SECURED AREAS

SFEIR ARCHITECTS

1350 Columbia Street, Suite 603
San Diego, CA 92101

P: 619-299-3917
F: 619-299-5084
www.sfeirarch.com

TCMC OBSERVATION ROOM


TRI-CITY MEDICAL CENTER
4002 VISTA WAY
OCEANSIDE, CALIFORNIA 92056

OWNER: TRI-CITY MEDICAL CENTER
4002 VISTA WAY
OCEANSIDE, CALIFORNIA 92056
TEL(760)724-8411

ARCHITECT: SFEIR ARCHITECTS
1350 COLUMBIA STREET, SUITE 603
SAN DIEGO, CALIFORNIA 92101
TEL(619)299-3917 FAX(619)299-5084

STRUCTURAL: SUN STRUCTURAL ENGINEERING, INC.
2091 LAS PALMAS DRIVE, SUITE D
CARLSBAD, CALIFORNIA 92011
TEL(760)438-1188

ME&P: P2S ENGINEERING, INC.
9665 CHESAPEAKE DRIVE, SUITE 230
SAN DIEGO, CALIFORNIA 92123
TEL(619)299-3917 FAX(619)299-5084

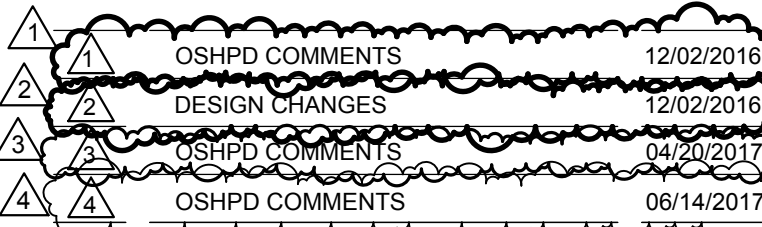

REV: _____ DESCRIPTION: _____ DATE: _____

CONSULTANT

p2s P2S Engineering, Inc.
9665 Chesapeake Dr., Suite #230
San Diego, CA 92123
T 619.618.2347 F 619.330.0668
www.p2seng.com



07/06/2017 10:49:54 AM
#S162581-37-00

SCHEDULES

PROJECT TITLE:

TCMC OBSERVATION ROOM

PROJECT # 01643.00 SHEET NUMBER:

DRAWN BY: ED

CHECKED BY: PAL

SCALE: As indicated


DATE: 10/11/16

P2S No. 8452

M0-20

TRI-CITY MEDICAL
CENTER
4002 VISTA WAY
OCEANSIDE, CALIFORNIA
92056

OWNER:	TRI-CITY MEDICAL CENTER 4002 VISTA WAY OCEANSIDE, CALIFORNIA 92056 TEL(760)724-8411
ARCHITECT:	SFEIR ARCHITECTS 1350 COLUMBIA STREET, SUITE 603 SAN DIEGO, CALIFORNIA 92101 TEL(619)299-3917 FAX(619)299-5084
STRUCTURAL:	SUN STRUCTURAL ENGINEERING, INC 2091 LAS PALMAS DRIVE, SUITE D CARLSBAD, CALIFORNIA 92011 TEL(760)748-1188
ME&P:	P2S ENGINEERING, INC. 9065 CHESAPEAKE DRIVE, SUITE 230 SAN DIEGO, CALIFORNIA 92123 TEL(619)299-3917 FAX(619)299-5084

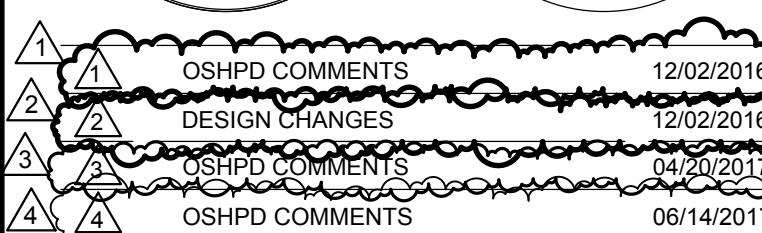

REV:	DESCRIPTION:	DATE:
------	--------------	-------

CONSULTANT

p2S **P2S Engineering, Inc.**
9665 Chesapeake Dr., Suite #230
San Diego, CA 92123
T 619.618.2347 F 619.330.0668
www.p2senq.com

OSHPD APPROVAL STAMP:

OSHPD #: S162581-37-00





07/06/2017 10:48:54 AM
[S16581-3-001]
SHEET TITLE:

DEMOLITION AND RENOVATION PLANS

PROJECT TITLE:	
TCMC OBSERVATION ROOM	
PROJECT #:	SHEET NUMBER:
01843.00	
DRAWN BY:	
ED	
CHECKED BY:	
PAL	
SCALE:	
As indicated	
DATE:	
10/11/16	

M2-10

P2S No. 845:

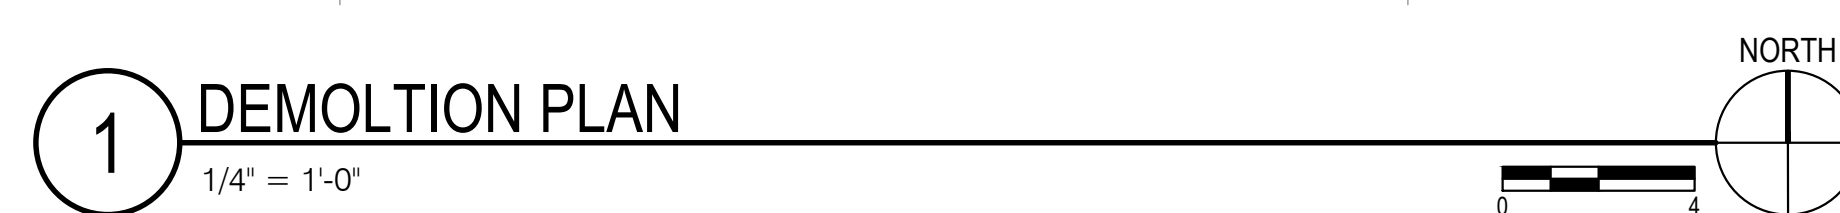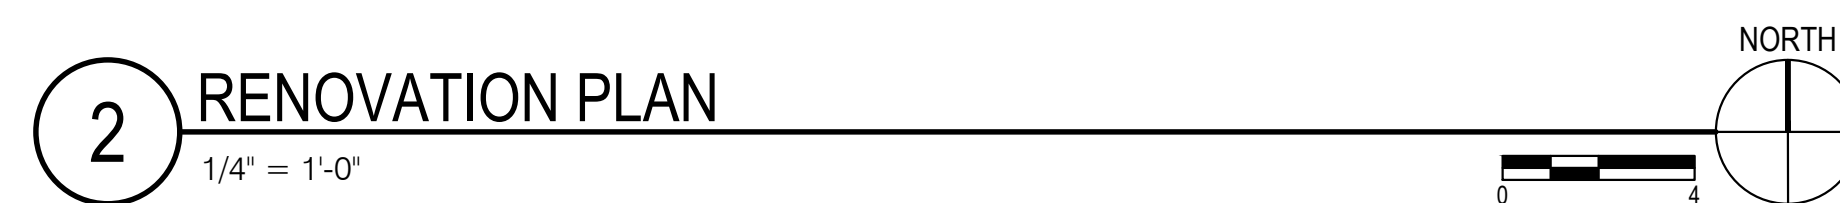

DWG: V:\CAD_Drawings\U6452\Mechanical\U2-10.dwg USER: Kyle Manning
DATE: Jun 15, 2017 5:41pm XREFS: x-ref level demo x-ref level new Start - 24x36 x-ref level rco demo x-ref level rco new MD-FP01 MR-FP01 IMAGES

TCMC OBSERVATION ROOM


TRI-CITY MEDICAL
CENTER
4002 VISTA WAY
OCEANSIDE, CALIFORNIA
92056

OWNER: TRI-CITY MEDICAL CENTER
4002 VISTA WAY
OCEANSIDE, CALIFORNIA 92056
TEL(760)724-8411

ARCHITECT: SFEIR ARCHITECTS
1350 COLUMBIA STREET, SUITE 603
SAN DIEGO, CALIFORNIA 92101
TEL(619)299-3917 FAX(619)299-5084

STRUCTURAL: SUN STRUCTURAL ENGINEERING, INC.
2091 LAS PALMAS DRIVE, SUITE D
CARLSBAD, CALIFORNIA 92011
TEL(760)438-1188

ME&P: P2S ENGINEERING, INC.
9665 CHESAPEAKE DRIVE, SUITE 230
SAN DIEGO, CALIFORNIA 92123
TEL(619)299-3917 FAX(619)299-5084

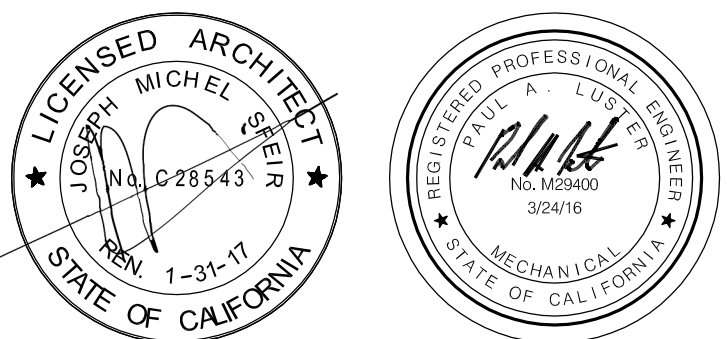

OSHPD COMMENTS	12/02/2016
DESIGN CHANGES	12/02/2016
OSHPD COMMENTS	04/20/2017
OSHPD COMMENTS	08/14/2017

REV:	DESCRIPTION	DATE:

CONSULTANT
p2s P2S Engineering, Inc.
9665 Chesapeake Dr., Suite #230
San Diego, CA 92123
T 619.618.2347 F 619.330.0668
www.p2seng.com

OSHPD APPROVAL STAMP:
OSHPD #: S162581-37-00



07/06/2017 10:49:54 AM
#S162581-37-00
SHEET TITLE:

DETAILS

PROJECT TITLE: TCMC OBSERVATION ROOM

PROJECT #: 01643.00 SHEET NUMBER: M6-10



DRAWN BY: ED

CHECKED BY: PAL

SCALE: As Indicated

DATE: 10/11/16

P2S No. 8452

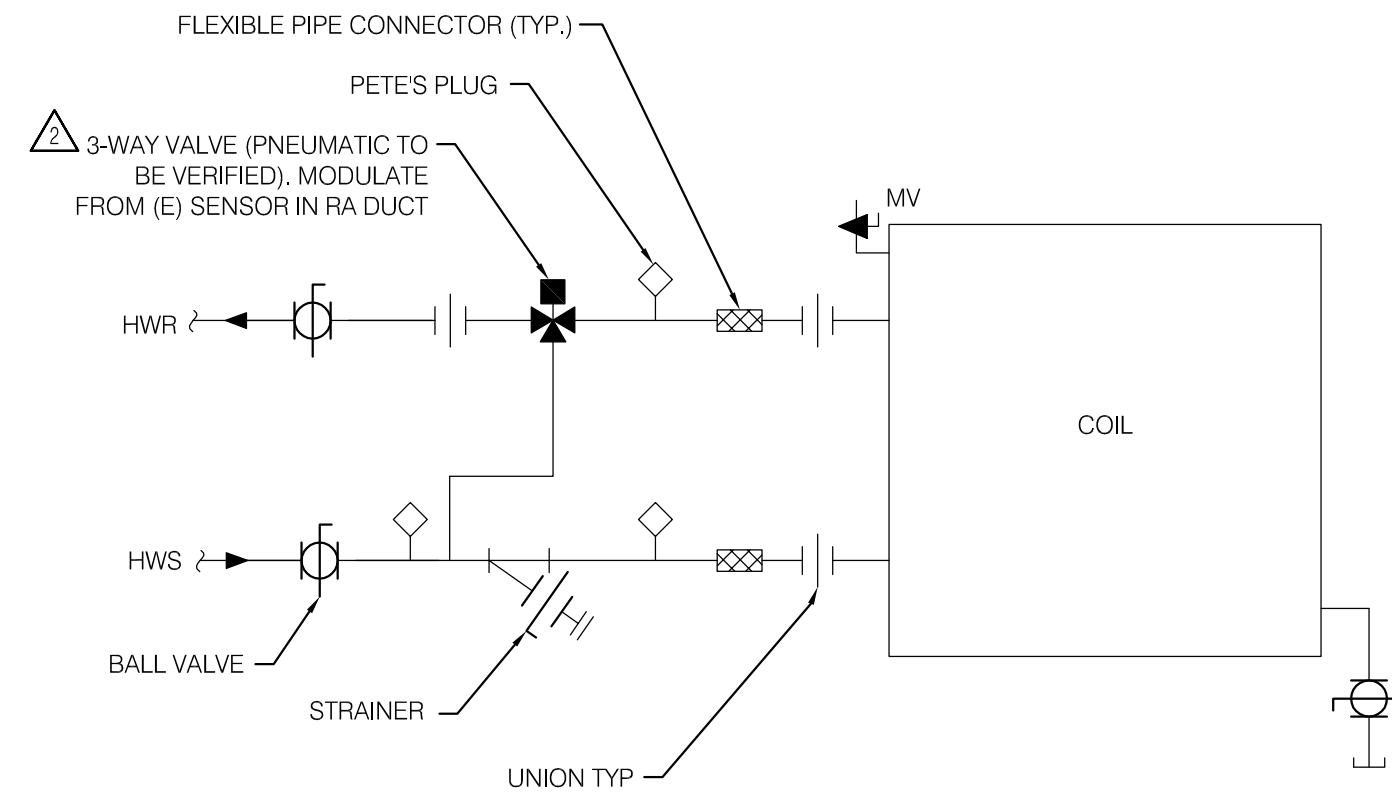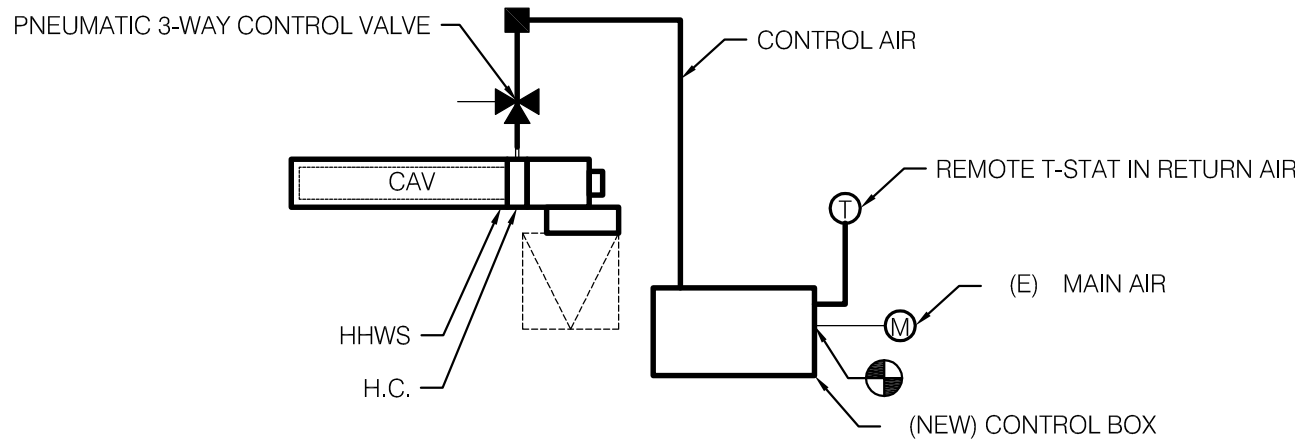


NOTES

- UNIONS NOT REQUIRED FOR FLANGED PIPING.

6 AIR CONDITIONING CONTROL DIAGRAM

NO SCALE

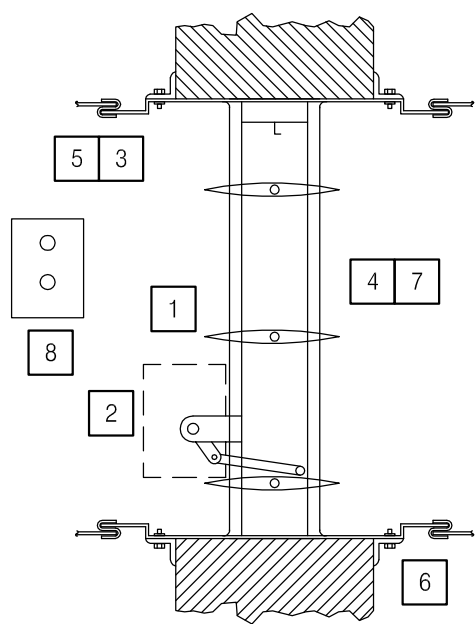

NOTES


- WALL FLOOR FIRE SMOKE DAMPER WITH AIRFOIL BLADES. PER NFPA 90A, ACCESS DOOR IS REQUIRED ON JACKSHAFT SIDE OF THE DAMPER. REFER TO SPECIFICATION SECTION 15910 FOR ADDITIONAL REQUIREMENTS.
- FIRE SMOKE DAMPER JACKSHAFT AND ACTUATOR.
- MOUNTING ANGLE SHALL BE MINIMUM OF 1-1/2"X 1-1/2"X14 GAUGE WITH MINIMUM 1" OVERLAP OF WALL ON EACH SIDE.
- OPENING TO BE 1/4" PER FOOT LARGER THAN DAMPER DIMENSIONS. PROVIDE DUCT ACCESS DOOR AT EACH COMBINATION SMOKE/FIRE DAMPER. DOORS AHHL BE LOCATED SO THAT THE FIRE DAMPER CATCH MAYBE RELEASED WITH THE FIRE DAMPER IN A CLOSED POSITION AND FUSIBLE LINK REPLACED. EACH DOOR SHALL BE STENCILED "SMOKE/FIRE DAMPER ACCESS".
- PLAIN "S" DUCT CONNECTION - DO NOT BOLT OR SCREW DUCT TO SLEEVE.
- 1 - HOUR FIRE CONSTRUCTION BY OTHERS.
- WALL FLOOR FIRE SMOKE DAMPER SHALL BE INSTALLED PER MANUFACTURERS INSTRUCTIONS. DAMPER SHALL BE RUSKIN FSD 60-2 AIRFOIL BLADE DESIGN. DAMPER SHALL BE CLASS 2, UL555S 1-1/2 HOUR FIRE RESISTANCE RATING. NFPA STANDARDS 80, 90A, 92A, 92B, 101& 105 UL555S LISTING R5531 CSFM COMBINATION FIRE/SMOKE DAMPER LISTING #3235-0245/0126
- REFER TO ELECTRICAL AND FIRE ALARM DRAWINGS FOR ADDITIONAL REQUIREMENTS.

5 FIRE/SMOKE DAMPER

NO SCALE

4 3-WAY COIL PIPING DIAGRAM

NO SCALE

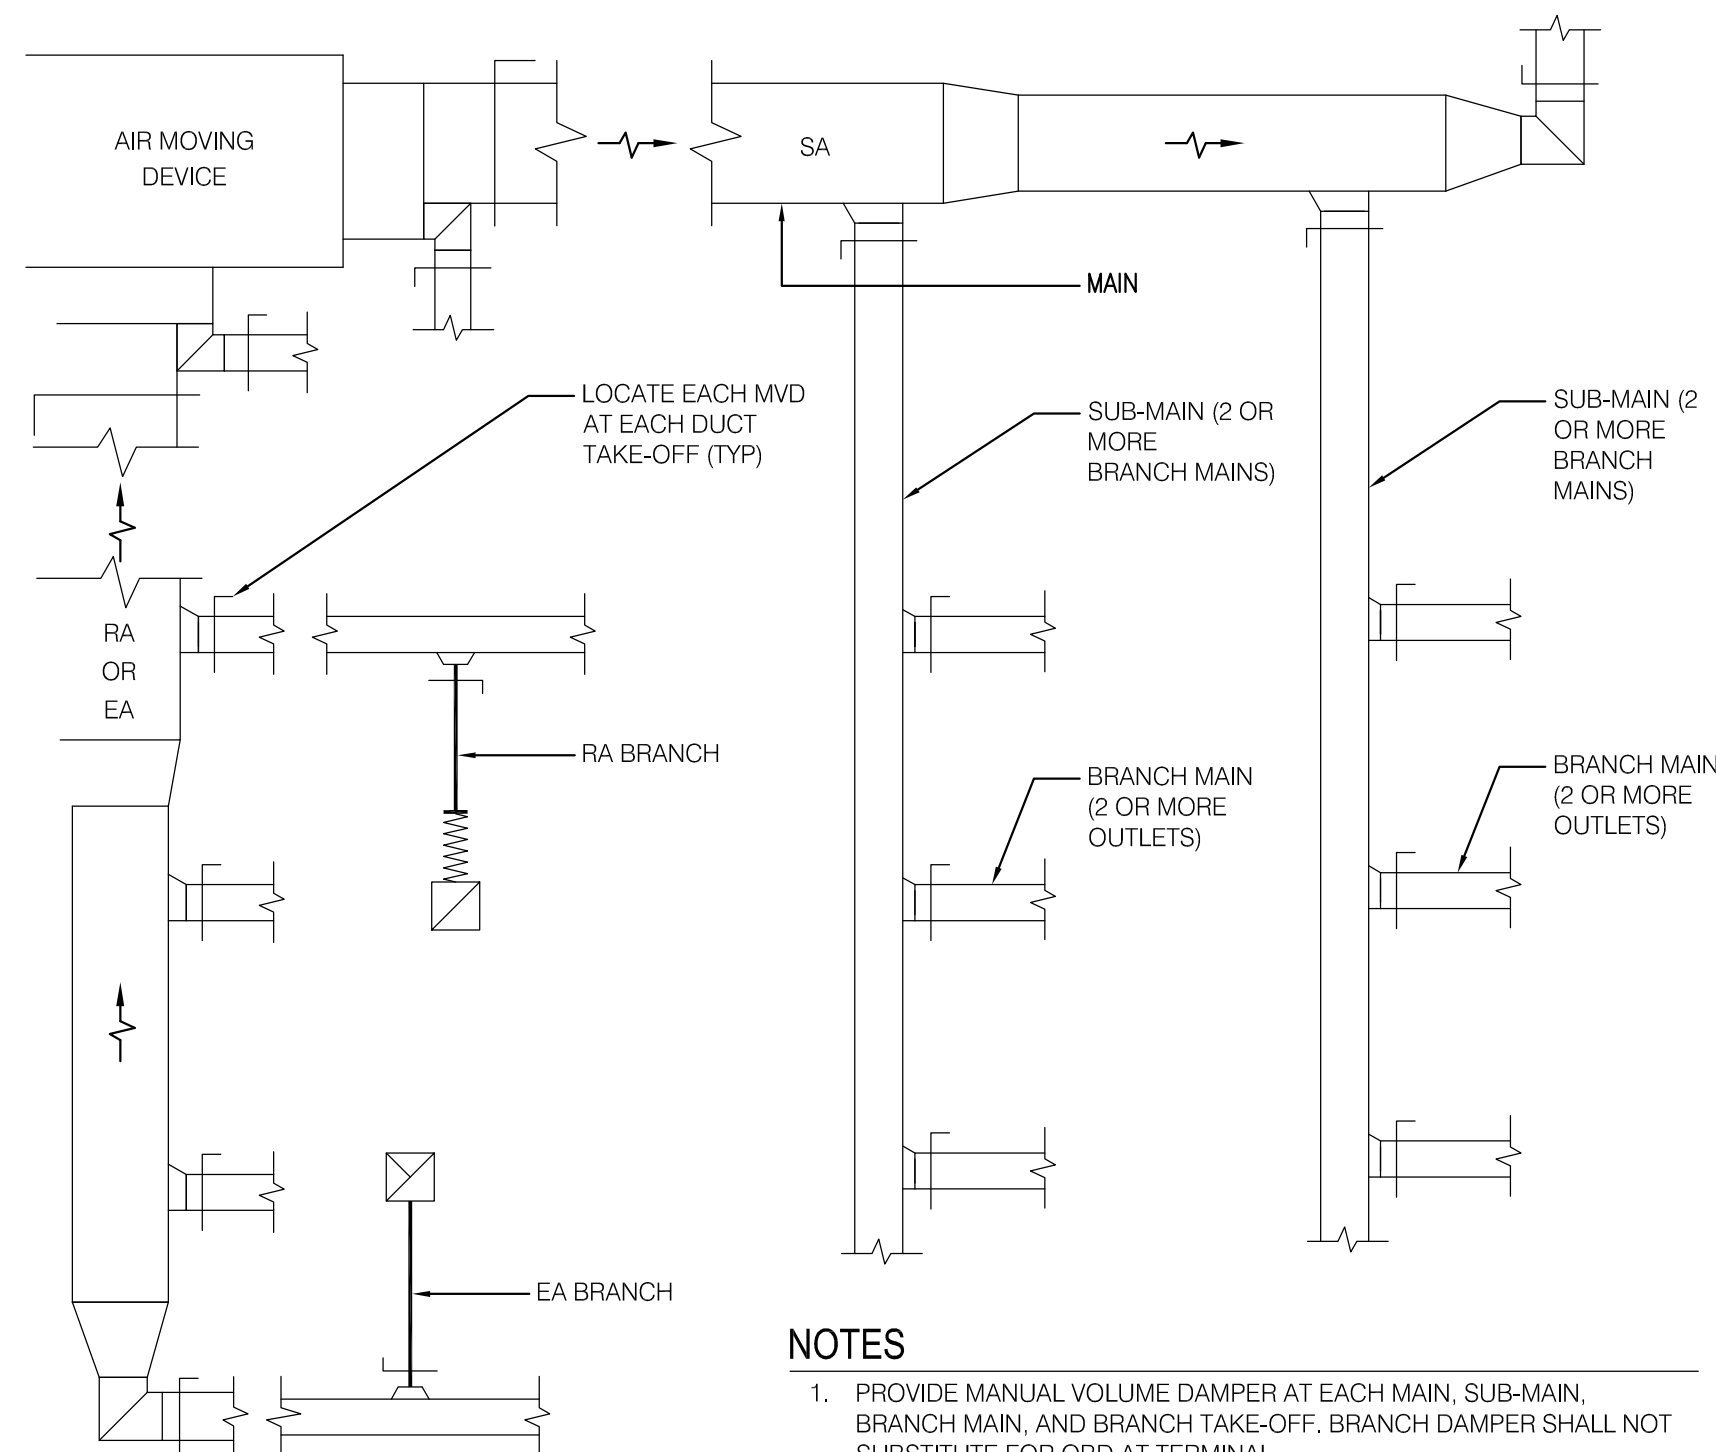

NOTES


- PROVIDE MANUAL VOLUME DAMPER AT EACH MAIN, SUB-MAIN, BRANCH MAIN, AND BRANCH TAKE-OFF. BRANCH DAMPER SHALL NOT SUBSTITUTE FOR OBD AT TERMINAL.
- PROVIDE CEILING ACCESS TO ALL DAMPERS

3 TYPICAL MANUAL VOLUME DAMPER LOCATION DIAGRAM

NO SCALE

2 AIR DISTRIBUTION RESTRAINT

NO SCALE

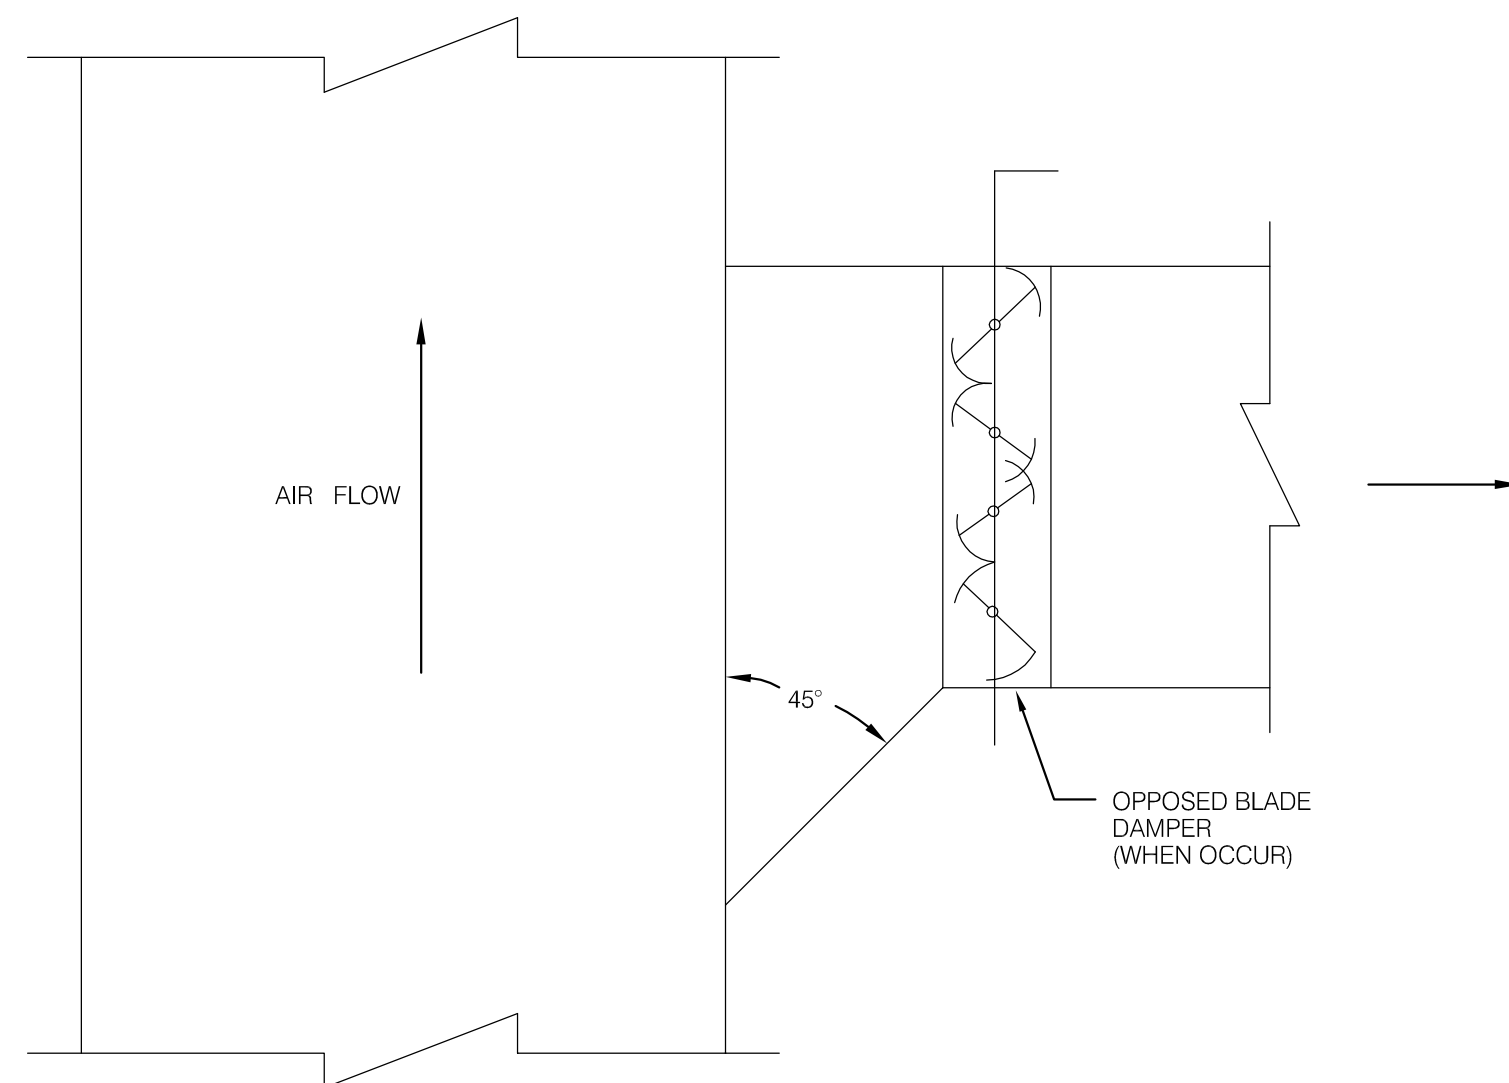

1 BRANCH DUCT (RECTANGULAR)

NO SCALE

DWG: V:\CAD Drawings\46452\Plumbing\P0-10.dwg USER: Kyle Manning
DATE: Jun 15, 2017 5:42pm XREFS: Sheet-2436c IMAGES:

LEGEND

SYMBOL	DESCRIPTION
	NOTE CALLOUT
	DETAIL CALLOUT - NUMBER ON TOP DENOTES DETAIL NUMBER - NUMBER ON BOTTOM DENOTES SHEET DETAIL IS SHOWN
	MECHANICAL EQUIPMENT CALLOUT, SEE MECHANICAL PLANS FOR EXACT LOCATION AND REQUIREMENTS
	SECTION CALLOUT
	POINT OF CONNECTION
	POINT OF DISCONNECTION
	CHANGING PIPE SIZE
	NEW PIPE (SIZE-SERVICE)
	EXISTING PIPE/EQUIPMENT
	DEMOLISHED PIPE/EQUIPMENT
	LOW PRESSURE NATURAL GAS
	MEDIUM PRESSURE NATURAL GAS
	HIGH PRESSURE NATURAL GAS
	INDIRECT WASTE
	SANITARY SEWER/WASTE UNDERGROUND
	SANITARY SEWER/WASTE ABOVEGROUND
	SANITARY VENT
	DOMESTIC HOT WATER RETURN
	DOMESTIC HOT WATER SUPPLY
	DOMESTIC COLD WATER
	STORM DRAIN PIPING
	SUBSOIL DRAIN
	ACID WASTE
	ACID VENT
	PUMP DISCHARGE LINE
	TEMPERED WATER
	TEMPERED WATER RECIRCULATING
	SOFT COLD WATER
	CONDENSATE DRAIN
	DEIONIZED WATER SUPPLY
	DEIONIZED WATER RETURN
	REVERSE OSMOSIS WATER
	CHILLED WATER SUPPLY
	CHILLED WATER RETURN
	LAWN SINKRLEK SUPPLY
	FIRE PROTECTION WATER SUPPLY
	GAS VENT
	FUEL OIL SUPPLY
	FUEL OIL RETURN
	FUEL OIL VENT
	LUBRICATING OIL
	LUBRICATING OIL VENT
	WASTE OIL
	WASTE OIL VENT
	OXYGEN
	LIQUID OXYGEN
	COMPRESSED AIR
	MEDICAL COMPRESSED AIR
	LABORATORY COMPRESSED AIR
	HIGH PRESSURE COMPRESSED AIR
	HEATING HOT WATER SUPPLY
	HEATING HOT WATER RETURN
	VACUUM
	ROOF DRAIN
	OVERFLOW ROOF DRAIN
	NONPOTABLE HOT WATER RETURN
	MEDICAL VACUUM
	SURGICAL VACUUM
	LABORATORY VACUUM
	NITROGEN
	NITROUS OXIDE
	CARBON DIOXIDE
	VALVE AT DROP
	VALVE AT RISE

SYMBOL	DESCRIPTION
	ELBOW DOWN
	PIPE TEE UP & DOWN OR ELBOW UP
	PIPE TEE DOWN
	PIPE TEE UP DESCRIPTION
	SOLENOID VALVE
	GATE VALVE
	BALL VALVE
	PRESSURE REDUCING VALVE
	CHECK VALVE, SWING
	PLUG VALVE
	STRAINER, Y-TYPE
	FLOW METER
	BACKFLOW PREVENTER
	HOSE BIBB
	FLOOR DRAIN
	FLOOR SINK, 1/2 GRATE
	AREA DRAIN / INDUSTRIAL RECEPTOR
	SHUT-OFF VALVE IN YARDBOX
	BALANCING VALVE
	FLOOR CLEANOUT
	CLEANOUT TO GRADE
	WALL CLEANOUT
	WATER HAMMER ARRESTOR
	TRAP PRIMER

ABBREVIATIONS

ABBREVIATION	DESCRIPTION	GPM	GALLONS PER MINUTE
@	AT	ABBREVIATION	DESCRIPTION
ABV	ABOVE	GPR	GAS PRESSURE REGULATOR
A/C	ABOVE CEILING	H&CW	HOT AND COLD WATER
AC	ACETYLENE	H/L	HIGH LEVEL
AD	AREA DRAIN	HDR	HEADER
AFF	ABOVE FINISHED FLOOR	HT	HEIGHT
AFG	ABOVE FINISHED GRADE	IN	INCHES
AFSR	AUTOMATIC FIRE SPRINKLER	IW	INDIRECT WASTE
AR	ARGON GAS	L or LAV	LAVATORY
AV	ACID VENT	MAX	MAXIMUM
AW	ACID WASTE	MIN	MINIMUM
BEL	BELOW	MPG	MEDIUM MEDIUM PRESSURE
BFP	BACKFLOW PREVENTER	MTD	MOUNTED
B/G	BELOW GRADE	NTS	NOT TO SCALE
B/F	BELOW FLOOR	O	OXYGEN
BTM	BOTTOM	OD	OVERFLOW DRAIN
BV	BALL VALVE	OS&Y	OPEN SCREW AND YOKE
CI	CAST IRON	POC	POINT OF CONNECTION
CIP	CAST IRON PIPE	POD	POINT OF DISCONNECTION
CLG	CEILING	PSI	POUNDS PER SQUARE INCH
COTG	CLEAN-OUT TO GRADE	RD	ROOF DRAIN
CU	CUBIC	R&C	ROUGH-IN AND CONNECT
CW	COLD WATER	S	SINK, SEWER, SOIL
DEPT	DEPARTMENT	SD	STORM DRAIN
DF	DRINKING FOUNTAIN	SOV	SHUT-OFF VALVE
DIA	DIAMETER	SO	SQUARE
DN	DOWN	SS	SERVICE SINK
DS	DOWNSPOUT	T/A	TO ABOVE
DWG	DRAWING(S)	T/B	TO BELOW
(E)	EXISTING	TP	TRAP PRIMER
EXIST	EXISTING	TYP	TYPICAL
EQUIP	EQUIPMENT	UG	UNDERGROUND
EW	ELECTRIC WATER COOLER	UON	UNLESS OTHERWISE NOTED
F	FIRE	UR	URINAL
F/A	FROM ABOVE	V	VANITY VENT
F/B	FROM BELOW	VOLT	VOLTAGE
FCO	FLOOR CLEAN-OUT	VTR	VENT THRU ROOF
FD	FLOOR DRAIN	W	WASTE
FF	FINISHED FLOOR	W/	WITH
FM	FORCE MAIN	WC	WATER CLOSET
FS	FLOOR SINK	WCO	WALL CLEAN-OUT
FT	FEET	WH	WATER HEATER
G	NATURAL GAS (LOW PRESSURE)	WHA	WATER HAMMER ARRESTOR
GAL	GALLONS		

REFERENCE WILL BE MADE TO ANSI Y1-1, MILITARY STANDARD IN THE EVENT ABBREVIATIONS NOT MENTIONED HEREIN ARE USED, ABBREVIATIONS, AND OTHER STANDARD INDUSTRY CONVENTIONS.

SHEET INDEX

P0-10	GENERAL NOTES, LEGEND AND SHEET INDEX
P0-20	SCHEDULES
P2-10	DEMOLITION AND RENOVATION PLANS

GENERAL NOTES

- ALL WORK SHALL COMPLY WITH THE 2013 EDITIONS OF THE CALIFORNIA BUILDING, MECHANICAL, PLUMBING, AND OTHER APPLICABLE FEDERAL, STATE, OR LOCAL CODES AS ADOPTED AND ENFORCED BY THE LOCAL JURISDICTION. IN CASE THE PLANS SHOW MORE STRINGENT REQUIREMENTS, THE PLANS SHALL GOVERN THE DESIGN, YET NOTHING ON THE DESIGN DOCUMENTS SHALL BE INTERPRETED AS AUTHORITY TO VIOLATE CODE(S) OR REGULATION(S).
- SUBMISSION OF BID IN CONNECTION WITH THIS WORK SHALL IMPLY THAT THE BIDDER HAS EXAMINED THE JOB SITE UNDER WHICH THE CONTRACTOR WILL BE OBLIGATED TO OPERATE UNDER THIS CONTRACT. NO EXTRA CHARGE WILL BE ALLOWED FOR FAILURE OF ANY BIDDER TO EXAMINE THE SITE PRIOR TO BID.
- WHERE USED, THE TERM "PROVIDE" SHALL MEAN "FURNISH AND INSTALL".
- IN THE EVENT OF A CONFLICT OR INCONSISTENCY BETWEEN ITEMS INDICATED ON DESIGN PLANS / SPECIFICATIONS WITH CODE REQUIREMENTS, THE MORE STRINGENT STANDARD SHALL PREVAIL.
- CONTRACTOR SHALL FURNISH LABOR, MATERIALS, EQUIPMENT, AND TRANSPORTATION AS REQUIRED TO PROPERLY INSTALL ALL PLUMBING SYSTEMS OR RELATED COMPONENTS AS INDICATED ON PLANS AND SPECIFIED HEREIN.
- ALL NEW EQUIPMENT AND MATERIAL TO BE INSTALLED AS PART OF RENOVATION / NEW CONSTRUCTION SHALL BEAR AN UNDERWRITERS LABORATORIES LABEL (UL), AND INSTALLED IN SUCH A MANNER FOR WHICH THEY ARE DESIGNED AND APPROVED.
- CONTRACTOR SHALL DOCUMENT AND RELAY ANY MAJOR DEVIATIONS FROM THE DESIGN DOCUMENTS, AND ATTAIN APPROVAL FROM THE MECHANICAL ENGINEER BEFORE PROCEEDING. AS-BUILT COPIES SHALL BE PROVIDED INDICATING ALL CHANGES / DEVIATIONS MADE DURING CONSTRUCTION. CONTRACTOR SHALL PROVIDE COMPLETED AS-BUILT DRAWINGS IN THE LATEST VERSION OF AUTOCAD.
- ALL WORK SHALL BE PERFORMED IN A CLEAN AND WORKMANLIKE MANNER. CARE SHALL BE EXERCISED TO MINIMIZE ANY INCONVENIENCE OR DISTURBANCE TO OTHER AREAS OF THE BUILDING WHICH ARE TO REMAIN IN OPERATION. ISOLATE WORK AREAS BY MEANS TO KEEP DUST AND DIRT WITHIN THE CONSTRUCTION AREA.
- NO PIPING, EQUIPMENT, ETC. SHALL BE REMOVED, DISCONNECTED OR SHUT DOWN WITHOUT PRIOR REVIEW WITH THE COLLEGE TO CONFIRM THAT AREAS TO REMAIN IN OPERATION WILL NOT BE AFFECTED. IF ANY AREAS NOT WITHIN THE SCOPE OF WORK ARE AFFECTED BY ANY SHUTDOWN, REMOVAL OR DISCONNECTION, SUFFICIENT ADVANCE NOTICE MUST BE GIVEN TO THE COLLEGE INDICATING WHICH AREAS WILL BE AFFECTED, WHEN THE PROPOSED SHUTDOWN WILL OCCUR, AND FOR HOW LONG A PERIOD OF TIME.
- THE ARRANGEMENT OF EQUIPMENT AND PIPING SHOWN ON THE DRAWINGS IS BASED UPON INFORMATION AVAILABLE TO THE ENGINEER AT THE TIME OF DESIGN AND IS NOT INTENDED TO SHOW EXACT DIMENSIONS PECULIAR TO A SPECIFIC MANUFACTURER. THE DRAWINGS ARE, IN PART, DIAGRAMMATIC AND SOME FEATURES OF THE ILLUSTRATED EQUIPMENT INSTALLATION MAY REQUIRE REVISION TO MEET ACTUAL EQUIPMENT INSTALLATION REQUIREMENTS. STRUCTURAL SUPPORTS, FOUNDATIONS, CONNECTED PIPING, VALVES, PIPE SUPPORTS AND ELECTRICAL CONDUIT SPECIFIED MAY HAVE TO BE ALTERED OR ADDITIONAL ITEMS REQUIRED TO ACCOMMODATE THE EQUIPMENT PROVIDED. NO ADDITIONAL PAYMENT WILL BE MADE FOR SUCH REQUIREMENTS, ALTERATIONS AND / OR ADDITIONS.
- CONTRACTOR SHALL VERIFY ALL DIMENSIONS AT THE SITE MAKING FIELD MEASUREMENTS AND PROVIDE SHOP DRAWINGS NECESSARY FOR FABRICATION OR ERECTION OF ALL HVAC AND PIPING SYSTEMS. MAKE ALLOWANCE FOR BEAMS, PIPES AND OTHER OBSTRUCTIONS IN BUILDING CONSTRUCTION. CHECK DRAWINGS SHOWING WORK OF OTHER TRADES AND CONSULT WITH THE UNIVERSITY REPRESENTATIVE IN THE EVENT OF POTENTIAL INTERFERENCE. SHOP DRAWINGS SHALL BE MINIMUM 1/4" = 1'-0" SCALE, INDICATING FITTINGS, SIZES, WELDS AND CONFIGURATIONS AND SUBMITTED TO ENGINEER FOR REVIEW. CONTRACTOR SHALL PROVIDE DIMENSIONED SHOP DRAWINGS COMPLETED IN THE LATEST VERSION OF AUTOCAD.
- CONTRACTOR SHALL COORDINATE HIS WORK WITH ALL OTHER TRADES PRIOR TO FABRICATION, PURCHASE AND/OR INSTALLATION OF ALL WORK.
- BEFORE COMMENCEMENT OF WORK, CONTRACTOR SHALL VERIFY THE EXACT LOCATIONS, ELEVATIONS, AND CHARACTERISTICS OF ALL UTILITIES.
- CONTRACTOR SHALL SECURE AND PAY ALL FEES AND PERMITS PERTAINING TO THE CONTRACT.
- EXISTING MATERIALS THAT ARE REMOVED SHALL NOT BE REUSED IN NEW SYSTEMS, EXCEPT WHERE INDICATED AS BEING RELOCATED.
- ALL EQUIPMENT SHALL BE INSTALLED IN STRICT COMPLIANCE WITH THE MANUFACTURER'S WRITTEN INSTRUCTIONS.
- ALL PLUMBING FIXTURE VENTS TO TERMINATE MINIMUM 12 INCHES FROM ANY VERTICAL SURFACE AND 10 FEET FROM OR 3 FEET ABOVE ANY OUTSIDE AIR INTAKES. NO FLAGPOLING PERMITTED.
- ALL PIPING SHALL BE INSTALLED AS INDICATED ON THE DRAWINGS IN A NEAT WORKMANSHIP-LIKE MANNER AND BE SUPPORTED AS REQUIRED BY CODES. PIPING SHALL BE SET UP AND DOWN AND OFFSET AS REQUIRED TO SUIT FIELD CONDITIONS. DIELECTRIC COUPLINGS SHALL BE USED WHERE DISSIMILAR METALS ARE JOINED.
- ALL PIPING DISCHARGING INTO FLOOR-SINKS AND/OR FLOOR DRAINS SHALL MAINTAIN MINIMUM AIR-GAP AS REQUIRED BY LOCAL CODES.
- ALL VALVES, UNIONS, ETC. TO BE SAME SIZE AS LINE SIZE UNLESS OTHERWISE INDICATED ON DRAWINGS.
- ISOLATE AND DRAIN EXISTING PIPING SYSTEM AS REQUIRED TO ACCOMMODATE INSTALLATION OF THE WORK.
- UNIONS SHALL BE PROVIDED AND INSTALLED AFTER EACH SCREW-TYPE VALVE AND PRIOR TO EQUIPMENT CONNECTIONS.
- EQUIPMENT ANCHORAGE NOTES:

ALL MECHANICAL, PLUMBING, AND ELECTRICAL COMPONENTS SHALL BE ANCHORED AND INSTALLED PER THE DETAILS ON THE DSA APPROVED CONSTRUCTION DOCUMENTS. WHERE NO DETAIL IS INDICATED, THE FOLLOWING COMPONENTS SHALL BE ANCHORED OR BRACED TO MEET THE FORCE AND DISPLACEMENT REQUIREMENTS PRESCRIBED IN THE 2013 CBC, SECTIONS 1616A.1.18 THROUGH 1616A.1.26 AND ASCE 7-10 CHAPTER 6 AND 30.

 - ALL PERMANENT EQUIPMENT AND COMPONENTS.
 - TEMPORARY OR MOVABLE EQUIPMENT THAT IS PERMANENTLY ATTACHED (E.G. HARD WIRED) TO THE BUILDING UTILITY SERVICES SUCH AS ELECTRICITY, GAS OR WATER.
 - MOVABLE EQUIPMENT WHICH IS STATIONED IN ONE PLACE FOR MORE THAN 8 HOURS AND HEAVIER THAN 400 POUNDS ARE REQUIRED TO BE ANCHORED WITH TEMPORARY ATTACHMENTS.

THE ATTACHMENT OF THE FOLLOWING MECHANICAL AND ELECTRICAL COMPONENTS SHALL BE POSITIVELY ATTACHED TO THE STRUCTURE, BUT NEED NOT BE DETAILED ON THE PLANS. THESE COMPONENTS SHALL HAVE FLEXIBLE CONNECTIONS PROVIDED BETWEEN THE COMPONENT AND ASSOCIATED DUCTWORK, PIPING, AND CONDUIT:

 - COMPONENTS WEIGHING LESS THAN 400 POUNDS AND HAVE A CENTER OF MASS LOCATED 4 FEET OR LESS ABOVE THE ADJACENT FLOOR OR ROOF LEVEL THAT DIRECTLY SUPPORT THE COMPONENT.
 - COMPONENTS WEIGHING LESS THAN 20 POUNDS, OR IN THE CASE OF DISTRIBUTED SYSTEMS, LESS THAN 5 POUNDS PER FOOT, WHICH ARE SUSPENDED FROM A ROOF OR FLOOR OR HUNG FROM A WALL.

FOR THOSE ELEMENTS THAT DO NOT REQUIRE DETAILS ON THE APPROVED DRAWINGS, THE INSTALLATION SHALL BE SUBJECT TO THE APPROVAL OF THE STRUCTURAL ENGINEER OF RECORD AND THE DSA DISTRICT STRUCTURAL ENGINEER. THE PROJECT INSPECTOR WILL VERIFY THAT ALL COMPONENTS AND EQUIPMENT HAVE BEEN ANCHORED IN ACCORDANCE WITH ABOVE REQUIREMENTS.
- PIPING, DUCTWORK, AND ELECTRICAL DISTRIBUTION SYSTEM BRACING NOTE

PIPING, DUCTWORK, AND ELECTRICAL DISTRIBUTION SYSTEMS SHALL BE BRACED TO COMPLY WITH THE FORCES AND DISPLACEMENTS PRESCRIBED IN ASCE 7-10 SECTION 13.3 AS DEFINED IN ASCE 7-10 SECTION 13.6.7, 13.6.5.6 ITEM 6, AND 2013 CBC SECTIONS 1616A.1.23, 1616A.1.24, 1616A.1.25 AND 1616A.1.26.

THE BRACING AND ATTACHMENTS TO THE STRUCTURE SHALL BE DETAILED ON THE APPROVED DRAWINGS OR THEY SHALL COMPLY WITH ONE OF THE OSHPD PRE-APPROVALS (OPM #) AS MODIFIED TO SATISFY ANCHORAGE REQUIREMENTS OF ACI 318, APPENDIX D.

COPIES OF THE MANUAL SHALL BE AVAILABLE ON THE JOBSITE PRIOR TO THE START OF HANGING AND BRACING OF THE PIPE, DUCTWORK, AND ELECTRICAL DISTRIBUTION SYSTEM.

THE STRUCTURAL ENGINEER OF RECORD SHALL VERIFY THE ADEQUACY OF THE STRUCTURE TO SUPPORT THE HANGER AND BRACE LOADS.
- PLUMBING FIXTURES AND FAUCETS SHALL BE CERTIFIED BY THE STATE OF CALIFORNIA ENERGY COMMISSION AS REQUIRED BY THE CALIFORNIA ENERGY EFFICIENCY STANDARDS SECTION S-5314 AND TABLE 'G'.
- ALL SOIL, WASTE, STORM DRAIN AND VENT PIPING SHALL SLOPE AT 2% UNLESS OTHERWISE INDICATED.
- PIPING THROUGH FIRE RATED WALLS SHALL BE PER U.L. FIRE RESISTANCE SYSTEM NO. W1001. SEE ARCHITECTURAL PLANS FOR ALL WALL LOCATIONS.
- REFER TO THE SPECIFICATIONS BOOK FOR ADDITIONAL REQUIREMENTS.

GENERAL NOTES

- ALL CLEANOUTS SHALL BE INSTALLED WHERE READILY ACCESSIBLE. THE CONTRACTOR SHALL COORDINATE ALL CLEANOUT LOCATIONS WITH EQUIPMENT, CABINETS, ETC. AND THE ARCHITECT PRIOR TO ANY INSTALLATION.
- KEEP ALL PIPING FROM LOAD BEARING FOOTINGS. IF UNABLE TO CLEAR FOOTINGS OR GRADE BEAMS, INSTALL PIPING THROUGH PIPE SLEEVES.
- BEFORE FABRICATION OR INSTALLATION, THE CONTRACTOR SHALL VERIFY EXACT LOCATIONS OF ALL EQUIPMENT AND FIXTURES. EXACT ROUGH-IN LOCATIONS AND REQUIREMENTS SHALL BE COORDINATED IN FIELD.
- ACCESSIBLE PLUMBING FIXTURES SHALL COMPLY WITH ALL OF THE REQUIREMENTS OF 2013 CBC CHAPTER 11A AND/OR 11B. HEIGHTS AND LOCATION OF ALL FIXTURES SHALL BE ACCORDING TO CBC 2013 SECTION 1138A.4. FIXTURE CONTROLS SHALL COMPLY WITH CBC 2013 SECTION 1138A.4.
- ALL VALVES, TRAP PRIMERS, WATER HAMMER ARRESTERS OR OTHER EQUIPMENT SHOWN IN WALLS OR ABOVE NON-ACCESSIBLE CEILINGS SHALL BE INSTALLED BEHIND AN ACCESS PANEL.
- ALL VENT THROUGH ROOF SHALL BE MINIMUM OF 3 FEET VERTICALLY AND 10 FEET HORIZONTALLY FROM ANY AIR CONDITIONING EQUIPMENT FRESH AIR INTAKES.
- VERIFY WITH ARCHITECTURAL DRAWINGS FOR EXACT LOCATIONS OF ALL FLOOR DRAINS, ROOF, OVERFLOW DRAINS AND FLOOR SINKS.
- FIXTURES SHALL BE PROTECTED DURING CONSTRUCTION FROM ANY DAMAGES. REFINISHED FIXTURES WILL NOT BE ACCEPTABLE UNDER ANY CONDITIONS.
- HOSE BIB WITH VACUUM BREAKER SHALL BE PROVIDED UNDER LAVATORY IN EACH PUBLIC RESTROOM.
- INSULATE INDIRECT DRAIN LINES FROM REFRIGERATORS, FREEZERS, ICE MAKER AND ICE BINS WITH MANVILLE AERO-TUBE OR EQUAL TO PREVENT CONDENSATE DRIPS.
- INSULATE WASTE PIPE AND P-TRAP FROM FLOOR SINK, FLOOR DRAINS OR FUNNEL DRAINS COLLECTING INDIRECT DRAINS FROM REFRIGERATORS, FREEZERS, ICE MAKER AND ICE BINS TO PREVENT CONDENSATE DRIPS. INSULATE WASTE PIPE UP TO THE NEXT 3" OR 4" MAIN CONNECTION.
- PROVIDE AND INSTALL GAS COCKS AND UNION AT EACH GAS FIRED EQUIPMENT.
- PROVIDE AND INSTALL CHROME ANGLE VALVES ON HOT AND COLD WATER SUPPLY AT EACH PLUMBING FIXTURES.
- ALL WATER FAUCETS SHALL BE PROVIDED WITH CODE APPROVED FLOW RESTRICTORS.
- COVER ALL FLOOR DRAINS, FLOOR SINKS, ROOF AND OVERFLOW DRAINS DURING CONSTRUCTIONS TO PREVENT DEBRIS FROM ENTERING PIPE AND PROTECT GRATES FROM DAMAGES.
- COORDINATE WITH ELECTRICAL CONTRACTOR PRIOR TO ORDERING EQUIPMENT FOR AVAILABLE VOLTAGES AT ALL EQUIPMENT LOCATIONS.
- COORDINATE WITH ELECTRICAL CONTRACTOR FOR ALL TAMPER AND FLOW SWITCH LOCATIONS.
- BECAUSE OF THE SMALL SCALE DRAWINGS, IT IS NOT POSSIBLE TO INDICATE ALL OFFSETS, FITTINGS AND ACCESSORIES WHICH MAY BE REQUIRED. THE CONTRACTOR SHALL CAREFULLY INVESTIGATE THE CONDITIONS SURROUNDING INSTALLATION OF HIS WORK, FURNISHING THE NECESSARY PIPING, FITTINGS, VALVES, TRAPS, AND OTHER DEVICES WHICH MAY BE REQUIRED TO COMPLETE THE INSTALLATION.
- UNLESS SPECIFIED ON STRUCTURAL DRAWINGS, ANY ALTERATION OR MODIFICATIONS TO STRUCTURAL ELEMENTS BY CUTTING, DRILLING, BORING, BRACING, WELDING ETC. SHALL HAVE WRITTEN APPROVAL STRUCTURAL ENGINEER PRIOR TO START WORK.
- ITEMS NOT SHOWN IN THE DRAWINGS BUT NECESSARY FOR COMPLETE OPERATION OF THE SYSTEM/FIXTURES/EQUIPMENT OR FOR COMPLETE CODE INSTALLATION SHALL BE PROVIDED AT NO ADDED COST TO THE OWNER.
- DIELECTRIC UNION ISOLATOR WITH THREADED CONNECTIONS SHALL BE PROVIDED FOR CONNECTING INCOMPATIBLE MATERIALS.
- ALL PLUMBING FIXTURES SHALL BE APPROVED BY OWNER PRIOR TO ORDERING.
- CONTRACTOR SHALL FIELD VERIFY EXACT LOCATION OF ALL EXISTING UTILITIES TO WHERE HE IS TO CONNECT PRIOR TO INSTALLATION OF ANY PIPING. EXTEND NEW PIPING IF NECESSARY TO WHERE THE EXISTING IS.
- ALL CONNECTIONS TO EXISTING SERVICES SHALL BE MADE SUCH THAT INTERRUPTION TIME WILL BE AS SHORT AS POSSIBLE. THE CONTRACTOR SHALL GIVE THE OWNERS REPRESENTATIVE SUFFICIENT NOTICE OF SUCH INTERRUPTION AND THE ACTUAL SHUT DOWN TIME SHALL BE AT A TIME DESIGNATED BY THE OWNERS REPRESENTATIVE.
- ALL EXISTING PIPING DAMAGED DURING CONSTRUCTION SHALL BE REPAIRED WITH MATERIALS TO MATCH EXISTING BY THE CONTRACTOR.
- PROVIDE AND INSTALL WATER HAMMER ARRESTORS IN THE FOLLOWING LOCATIONS (ONLY NON-FERROUS ARRESTORS MAY BE INSTALLED IN ANY WATER SYSTEM):
 - WATER LINES TO LAVATORY HEADERS, WATER CLOSET AND URINAL HEADERS, SERVICE SINKS, KITCHEN SINKS, WASH FOUNTAINS, DRINKING FOUNTAINS, LABORATORIES WITH MEDICAL TYPE FAUCETS AND ON WASH SINKS HAVING 3 OR MORE STATIONS AND ALL OTHER QUICK CLOSING FIXTURE SUCH AS CLOTHES WASHERS, AS CLOSE TO FIXTURE AS POSSIBLE.
 - BETWEEN LAST 2 FIXTURES WHEN 3 OR MORE FIXTURES, OTHER THAN THOSE LISTED IN 'A' ABOVE, ARE SERVED BY A COMMON HEADER.
 - WHEN ARRESTOR SHALL BE INSTALLED IN WALL OR FURRING, FURNISH WITH AN ACCESS PLATE LARGE ENOUGH TO PERMIT REMOVAL OF ARRESTOR. ACCESS PLATE SHALL BE A MINIMUM OF 2 INCHES LARGER IN EACH DIRECTION THAN ARRESTOR.
- ALL PIPING INTO STEM WALLS AND FOOTINGS SHALL BE DOUBLE HALF LAP WRAPPED WITH 1/8" THICK "ARMAFLEX" INSULATION. THE CONTRACTOR SHALL ALSO PROVIDE BLOCKED OUT AREAS IN STEM WALL AND FOOTING. ALL PIPING SHALL AVOID THE LOWER 8" OF THE FOOTING.
- ALL HOT WATER PIPING SHALL BE INSULATED. INSULATION SHALL HAVE A FLAME SPREAD OF NOT MORE THAN 25 AND A SMOKE DENSITY NOT EXCEEDING 50 PER 2013 CMC SEC. 1201.3.2.11. SEE SPECIFICATION FOR OTHER REQUIREMENTS.
- ALL CONNECTIONS TO SITE PIPING SHALL BE DONE BY THE PLUMBING CONTRACTOR.
- CLEANOUTS SHALL BE PROVIDED PER 2013 CPC SECTION 707.0 & 719.0 AND TO THE FOLLOWING LOCATIONS:
 - AT EACH BASE OF ROOF DRAIN DOWNSPOUTS.
 - AT EACH BASE OF WASTE STACK.
 - AT EVERY 100 FT OF STRAIGHT RUN OF HORIZONTAL PIPING.
 - AT EACH AGGREGATE HORIZONTAL CHANGE IN DIRECTION EXCEEDING ONE HUNDRED THIRTY-FIVE (135) DEGREES.
 - AT EACH HORIZONTAL DRAINAGE PIPE UPPER TERMINAL
 - ABOVE EACH URINAL.
 - BELOW EACH SINK.
- PROVIDE SEDIMENT TRAP AS CLOSE AS POSSIBLE TO ALL GAS APPLIANCES AND GAS FIRED EQUIPMENTS INLET EXCEPT FOR APPLIANCES LISTED PER 2013 CPC SECTION 1211.8. SEE SEDIMENT TRAP INSTALLATION PER 2013 CPC FIGURE 1211.8.
- DOMESTIC WATER PIPING AND COMPONENTS SHALL BE PROVIDED AND INSTALLED IN COMPLIANCE WITH CALIFORNIA AB 1953 LEGISLATION, WHICH LIMITS THE ALLOWABLE LEAD CONTENT IN CERTAIN DOMESTIC WATER SYSTEM COMPONENTS.
- ALL PLUMBING FIXTURES AND FITTINGS SHALL MEET CALGREEN MANDATORY REQUIREMENT OF 20% REDUCED FLOW RATE SPECIFIED IN TABLE 5.303.2.3.

S F E I R A R C H I T E C T S



1350 Columbia Street, Suite 603
San Diego, CA 92101

P: 619-299-3917
F: 619-299-5084
www.sfeirarch.com

TCMC OBSERVATION ROOM

TRI-CITY MEDICAL
CENTER
4002 VISTA WAY
OCEANSIDE, CALIFORNIA
92056

OWNER:	TRI-CITY MEDICAL CENTER 4002 VISTA WAY OCEANSIDE, CALIFORNIA 92056 TEL(760)724-8411
ARCHITECT:	SFEIR ARCHITECTS 1350 COLUMBIA STREET, SUITE 603 SAN DIEGO, CALIFORNIA 92101 TEL(619)299-3917 FAX(619)299-5084
STRUCTURAL:	SUN STRUCTURAL ENGINEERING, INC. 2091 LAS PALMAS DRIVE, SUITE D CARLSBAD, CALIFORNIA 92011 TEL(760)438-1188
ME&P:	P2S ENGINEERING, INC. 9665 CHESAPEAKE DRIVE, SUITE 230 SAN DIEGO, CALIFORNIA 92123 TEL(619)299-3917 FAX(619)299-5084

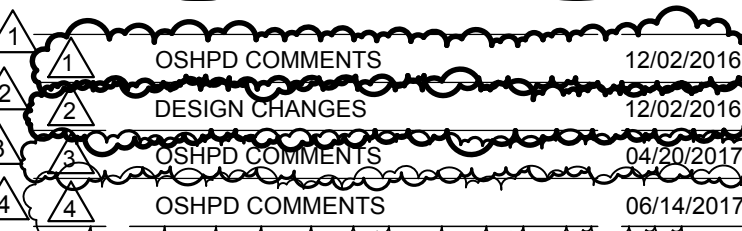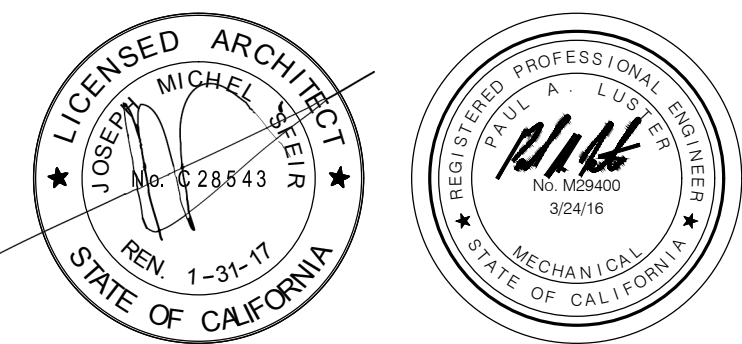

OSHPD COMMENTS	12/02/2016
DESIGN CHANGES	12/02/2016
OSHPD COMMENTS	04/20/2017
OSHPD COMMENTS	06/14/2017

REV:	DESCRIPTION:	DATE:
------	--------------	-------

CONSULTANT

p2s P2S Engineering, Inc.
9665 Chesapeake Dr., Suite #230
San Diego, CA 92123
T 619.618.2347 F 619.330.0668
www.p2seng.com

OSHPD APPROVAL STAMP:

OSHPD #: S162581-37-00



Office of Statewide Health Planning & Development
FACILITIES DEVELOPMENT DIVISION

GENERAL NOTES, LEGEND, AND SHEET INDEX

PROJECT TITLE:	TCMC OBSERVATION ROOM
PROJECT #	01643.00
DRAWN BY:	ED
CHECKED BY:	PAL
SCALE:	As indicated
DATE:	10/11/16

P0-10

P2S No. 8452

DWG: V:\CAD Drawings\4452\Plumbing\PO-20.dwg USER: Kyle Manning
DATE: Jun 15, 2017 5:42pm XREFS: Schedules-24X68 IMAGES:

FIXTURES

SYMBOL	FIXTURE	ROUGH-IN SIZE				DESCRIPTION / REMARKS
		W	V	CW	HW	
L-1	LAV	2"	1-1/2"	1/2"	1/2"	WHITEHALL MODEL WH3374. CUSTOM CABINET AND INTEGRAL SINK (SEE ARCHITECT.) THE LIGATURE RESISTANT FAUCET IS ARRANGED TO BE MOUNTED TO THE DECK OF THE LAVATORY. FAUCET ASSEMBLY REQUIRES (3) 1-5/16" TO 1-1/2" DIAMETER HOLES ON 4" CENTERSET. LIGATURE RESISTANT FAUCET WITH PUSHBUTTONS AND VALVE. VALVE IS AN AIR-CONTROL PNEUMATICALLY OPERATED, PUSHBUTTON VALVE USING ATMOSPHERIC AIR
WC-1	WATER CLOSET	4"	2"	1-1/2" ⚠	N/A	WHITEHALL MODEL WH2142W-2-EGE10. WALL MOUNTED TOILET IS SIPHON JET TYPE WITH AN ELONGATED BOWL MANUFACTURED TO COMPLY WITH ASME A112.19.3 AND CSA B45.4 STANDARDS. TOILET HAS A 1-1/2" NPT FLUSHING INLET CONNECTION. WALL MOUNTING HARDWARE BY OTHERS. 1-1/2" FEMALE NPT FLUSHING INLET. ACCESS PANEL (BOTH SIDES). TOILET WASTE OUTLET. WH2898 ACCESS PANEL AND FLUSH VALV. MECHANICAL FLUSH VALVE PUSHBUTTON ACTUATOR. EXTERIOR SURFACES POWDER COATED WHITE. INTERIOR OF TOILET W/ SATIN FINISH (NOT POWDER COATED)

MATERIALS

- ⚠
1. SANITARY SEWER, VENT AND STORM DRAIN ABOVE GRADE:

PIPE: SERVICE WEIGHT CAST IRON PER ASTM A-74, ASTM A-88, CISPI 301

FITTINGS: NO HUB CAST IRON PER ASTM A-888.

JOINTS: BAND TYPE STAINLESS STEEL COUPLINGS CONFORMING TO ASTM C-1540 HAVING MINIMUM SHIELD THICKNESS OF 31 GAUGE WITH NEOPRENE SEALING SLEEVE CONFORMING TO ASTM C-564. TYLER PIPE ONLY.
2. WATER ABOVE GRADE:

PIPE: TYPE L HARD DRAWN COPPER, ASTM B88.

FITTINGS: WROUGHT COPPER, ANSI B16.22

JOINTS: 95%-5% TIN-ANTIMONY LEAD FREE SOLDER.
3. CATHODIC PROTECTION:

ALL UNDER SLAB METAL PIPING OF ANY KIND IS TO BE SLEEVED IN PLASTIC. NO DIRECT BURY IS ALLOWED FOR METAL PIPING.

1350 Columbia Street, Suite 603
San Diego, CA 92101

P: 619-299-3917
F: 619-299-5084
www.sfeirarch.com

TCMC
OBSERVATION
ROOM

TRI-CITY MEDICAL
CENTER
4002 VISTA WAY
OCEANSIDE, CALIFORNIA
92056

OWNER:

TRI-CITY MEDICAL CENTER
4002 VISTA WAY
OCEANSIDE, CALIFORNIA 92056
TEL(760)724-8411

ARCHITECT:


SFEIR ARCHITECTS
1350 COLUMBIA STREET, SUITE 603
SAN DIEGO, CALIFORNIA 92101
TEL(619)299-3917 FAX(619)299-5084

STRUCTURAL:

SUN STRUCTURAL ENGINEERING, INC.
2091 LAS PALMAS DRIVE, SUITE D
CARLSBAD, CALIFORNIA 92011
TEL(760)438-1188

ME&P:

P2S ENGINEERING, INC.
9665 CHESAPEAKE DRIVE, SUITE 230
SAN DIEGO, CALIFORNIA 92123
TEL(619)299-3917 FAX(619)299-5084

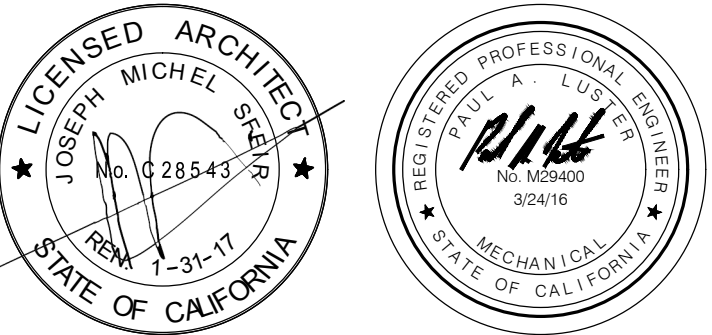

⚠	OSHPD COMMENTS	12/02/2016
⚠	DESIGN CHANGES	12/02/2016
⚠	OSHPD COMMENTS	04/20/2017
⚠	OSHPD COMMENTS	06/14/2017

REV: DESCRIPTION: DATE:

CONSULTANT

p2s

P2S Engineering, Inc.
9665 Chesapeake Dr., Suite #230
San Diego, CA 92123
T 619.618.2347 F 619.330.0668
www.p2seng.com

OSHPD APPROVAL STAMP:

OSHPD #: S162581-37-00

REVIEWED IN ACCORDANCE WITH
THE REQUIREMENTS OF T24, CCR

APPROVED

Laura Baldrati, Sr. Architect

Office of Statewide Health
Planning & Development

FACILITIES DEVELOPMENT DIVISION

07/06/2017 10:49:54 AM

#S162581-37-00

SHEET TITLE:

SCHEDULES

PROJECT TITLE:

TCMC OBSERVATION ROOM

PROJECT #
01643.00

SHEET NUMBER:
P0-20

DRAWN BY:
ED

CHECKED BY:
PAL


SCALE:
As indicated

DATE:
10/11/16

P2S No. 8452


TRI-CITY MEDICAL
CENTER
4002 VISTA WAY
OCEANSIDE, CALIFORNIA
92056

ME&P: P2S ENGINEERING, INC.
9665 CHESAPEAKE DRIVE, SUITE 230
SAN DIEGO, CALIFORNIA 92123
TEL(619)299-3917 FAX(619)299-5084

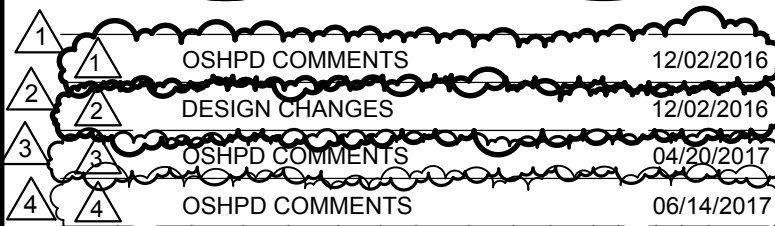

p2s **P2S Engineering, Inc.**
9665 Chesapeake Dr., Suite #230
San Diego, CA 92123
T 619.618.2347 F 619.330.0668
www.p2seng.com

OSHPD #: S162581-37-00

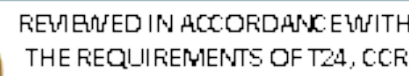

Laura Baldrati, Sr. Architect
Office of Statewide Health
Planning & Development
FACILITIES DEVELOPMENT DIVISION





07/06/2017 10:48:54 AM
[S162581-3] SHEET TITLE

DEMOLITION AND RENOVATION PLANS

TCMC OBSERVATION ROOM

PROJECT #: 01643.00
DRAWN BY: ED
CHECKED BY: PAL
SCALE: As indicated
DATE: 10/11/16

P2S No. 8452

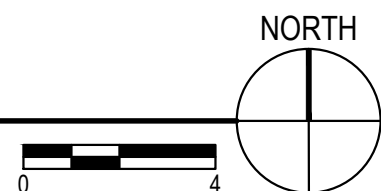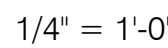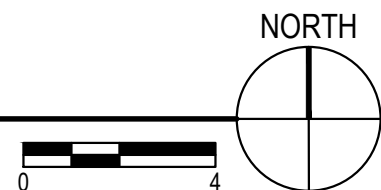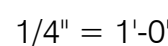

LEGEND

SYMBOL	DESCRIPTION
	NOTE CALLOUT
	MECHANICAL EQUIPMENT CALLOUT, SEE MECHANICAL PLANS FOR EXACT LOCATION AND REQUIREMENTS
	LIGHTING FIXTURE CALLOUT, SEE FIXTURE SCHEDULE: - LETTER DENOTES FIXTURE TYPE - NUMBER DENOTES FIXTURE VOLT/AMPS
	NEW LINework
	EXISTING LINework
	CONDUIT CONCEALED IN WALL OR ABOVE CEILING
	CONDUIT EXPOSED
	CONDUIT CONCEALED UNDERGROUND OR BELOW FLOOR
	CONDUIT CAPPED
	BRANCH CIRCUIT HOMERUN TO PANELBOARD AND CIRCUITS AS INDICATED
	3/4" CONDUIT, TICK MARKS INDICATE QUANTITY OF #12 AWG WIRES (UNLESS NOTED OTHERWISE, NO MARKS INDICATES 2#12 & 1#12 GND WIRES) - SMALL MARK DENOTES HOT WIRE - LARGE MARK DENOTES NEUTRAL WIRE - DIAGONAL DENOTES GROUND WIRE

ABBREVIATIONS

ABBREVIATION	DESCRIPTION	ABBREVIATION	DESCRIPTION
1/C	SINGLE CONDUCTOR	KVA	KILOVOLT-AMPERES
&	AND	KW	KILOWATT
@	AT	LF	LINEAR FEET
A OR AMP	AMPERES	LIS	LOAD INTERRUPTER SWITCH
ABV	ABOVE	LOC.	LOCATION
A.C.	ASPHALT CONCRETE	LTG	LIGHTING
AFF	ABOVE FINISHED FLOOR	LV	LOW VOLTAGE
AFG	ABOVE FINISH GRADE	MAX	MAXIMUM
AIC	AMPERE INTERRUPTING CAPACITY	MCC	MOTOR CONTROL CENTER
AL	ALUMINUM	MCP	MOTOR CIRCUIT PROTECTOR
APPROX.	APPROXIMATE	MFGR	MANUFACTURER
ARCH.	ARCHITECT; ARCHITECTURAL	MH	MANHOLE
ATC	AIR TERMINAL CHAMBER	MI.	MECHANICAL INTERLOCK
ATS	AUTOMATIC TRANSFER SWITCH	MRCT	MULTI-RATIO CURRENT TRANSFORMER
AUTO	AUTOMATIC	MTD	MOUNTED
AUX	AUXILIARY	MTG	MOUNTING
AWG	AMERICAN WIRE GAUGE	MV	MEDIUM VOLTAGE
BAT	BATTERY	N	NORTH
BEL	BELOW	NAC	NOTIFICATION APPLIANCE CIRCUIT
BKBD	BACKBOARD	NC	NORMALLY CLOSED
BKR	BREAKER	NEC	NATIONAL ELECTRICAL CODE
BLDG	BUILDING	NF	NON-FUSED
B.S.	BARE STRANDED	NIC	NOT IN CONTRACT
C	CONDUIT	NL	NIGHT LIGHT- 24HRS ON
CB	CIRCUIT BREAKER	NO.	NUMBER
CC	CONSTANT CURRENT	OC	ON CENTER
CKT	CIRCUIT	OD	OVER DIAMETER
CL	CENTER LINE	OE	OVERHEAD ELECTRICAL
CLG	CEILING	OFC	OIL FUSED CUTOUT
CMU	CONCRETE MASONRY UNIT	OH	OVERHEAD
C.O.	CONDUIT ONLY WITH PULL WIRE	OL	OIL LEVER SWITCH
COL	COLUMN	P	PULL BOX
CP	COMMUNICATION PROCESSOR	PB	PHOTOCELL
CPT	CONTROL POWER TRANSFORMER	PC	POLYCHLORINATED BIPHENYL
CR	CONTROL RELAY	PCB	PRESSURE DIFFERENTIAL SWITCH
CSU	CALIFORNIA STATE UNIVERSITY	PF	POWER FACTOR
CSFD	COMBINATION SMOKE FIRE DAMPER	PH OR Ø	PHASE
CT	CURRENT TRANSFORMER	PILC	PAPER INSULATED, LEAD COVER
CW	COLD WATER	PIV	POST INDICATING VALVE
CU	COPPER	PL	PLATE
DIAG	DIAGRAM	PNL	PANEL
DL	DAMP LOCATION LISTING	POC	POINT OF CONNECTION
DM	DIGITAL METER	PRI	PRIMARY
DP	DISTRIBUTION PANEL	PVC	POLY-VINYL CHLORIDE
DIST.	DISTANCE	PWR	POWER
DWG	DRAWING	REC/RECEPT	RECEPTACLE
DWP	DEPARTMENT OF WATER & POWER	REQ'D	REQUIRED
EA	EACH	RGS	RIGID GALVANIZED STEEL
ELEC.	ELECTRICAL	RPBP	REDUCED PRESSURE BACK FLOW PREVENTER
EMH	ELECTRICAL MANHOLE	RM	ROOM
EMT	ELECTRICAL METALLIC TUBING	SCE	SOUTHERN CALIFORNIA EDISON
EPO	EMERGENCY POWER OFF	SF	SQUARE FEET
EPR	ETHYLENE PROPYLENE RUBBER	SHT	SHEET
EQUIP	EQUIPMENT	SIG.	SIGNAL
EXIST/(E)	EXISTING	SP	SPARE
EXP	EXPLOSION PROOF	SPECS	SPECIFICATIONS
FA	FIRE ALARM	ST	STREET
FFE	FINISHED FLOOR ELEVATION	STD	STANDARD
FIN.	FINISH	SW	SWITCH
FIP.	FIELD INTERFACE PANEL	SWBD	SWITCHBOARD
FIXT	FIXTURE	SWGR	SWITCHGEAR
FLA	FULL LOAD AMPS	SWST	SWITCHING STATION
FLR	FLOOR	TB	TERMINAL BLOCK
FLUOR	FLUORESCENT	TEL./TELE	TELEPHONE
FT	FEET	TMH	TELEPHONE MANHOLE
FACP	FIRE ALARM CONTROL PANEL	T.O.D.	TOP OF DUCTBANK
FATC	FIRE ALARM TERMINAL CABINET	T.O.M.	TOP OF MANHOLE
FO	FIBER OPTIC	TPS	TWISTED SHIELDED PAIR
FTG	FOOTING	TRANSF/XFMR	TRANSFORMER
GFI	GROUND FAULT INTERRUPTER	TS	TAMPER SWITCH
GFR	GROUND FAULT RELAY	TYP	TYPICAL
GG	GREEN GROUND	UG	UNDERGROUND
GND	GROUND	UON	UNLESS OTHERWISE NOTED
HOA	HAND-OFF-AUTOMATIC	V	VOLTS
HP	HORSEPOWER	VA	VOLT-AMPERES
HT	HEIGHT	VB	VIBRATION SWITCH
HTR	HEATER	VFD	VARIABLE FREQUENCY DRIVE
HZ	HERTZ	W	WATTS
IE	INVERT ELEVATION	W/	WITH
ISC	SHORT CIRCUIT CURRENT	W/O	WITHOUT
INCAND	INCADESCENT	WP	WEATHERPROOF
JB	JUNCTION BOX	Z	IMPEDANCE
KCMIL	THOUSAND CIRCULAR MILS	(ER)	EXISTING TO BE REMOVED, RELOCATED AND RECONNECTED
KV	KILOVOLT	(ERR)	RECONNECTED

IN THE EVENT ABBREVIATIONS NOT MENTIONED HEREIN ARE USED, REFERENCE WILL BE MADE TO ANSI Y1.1, MILITARY STANDARD ABBREVIATIONS, AND OTHER STANDARD INDUSTRY CONVENTIONS.

SHEET INDEX

SHEET	DESCRIPTION
E0-10	NOTES, ABBREVIATIONS, AND LEGEND
E0-11	SINGLE LINE DIAGRAMS AND SCHEDULES
E1-10	OVERALL PLAN
E2-10	DEMOLITION AND RENOVATION PLANS

GENERAL NOTES

- APPLICABLE CODES:
2012 IBC AND 2013 CALIFORNIA AMENDMENTS
(2013 CALIFORNIA BUILDING CODE - PART 2, TITLE 24, CCR)
2011 NEC AND 2013 CALIFORNIA AMENDMENTS
(2013 CALIFORNIA ELECTRICAL CODE - PART 3, TITLE 24, CCR)
2013 UMC AND 2012 CALIFORNIA AMENDMENTS
(2012 CALIFORNIA MECHANICAL CODE - PART 4, TITLE 24, CCR)
2013 UPC AND 2012 CALIFORNIA AMENDMENTS
(2012 CALIFORNIA PLUMBING CODE - PART 5, TITLE 24, CCR)-
(PUBLISHER:JAPMO)
2012 IFC AND 2013 CALIFORNIA AMENDMENTS
(2013 CALIFORNIA FIRE CODE - PART 9, TITLE 24, CCR)
- THE INTENT OF THE DRAWINGS AND SPECIFICATIONS IS TO RECONSTRUCT THE HOSPITAL BUILDING IN ACCORDANCE WITH THE CALIFORNIA BUILDINGS STANDARD CODE, TITLE 24, CALIFORNIA CODE OF REGULATIONS. SHOULD ANY CONDITION DEVELOP NOT COVERED BY THE CONTRACT DOCUMENTS WHERE IN THE FINISHED WORK WILL NOT COMPLY WITH THE SAID TITLE 24, CALIFORNIA CODE OF REGULATIONS, A CHANGE ORDER DETAILING AND SPECIFYING THE REQUIRED WORK SHALL BE SUBMITTED TO AND APPROVED BY OFFICE OF STATE WIDE HEALTH PLANNING AND DEVELOPMENT BEFORE PROCEEDING WITH THE WORK.
- WHEN INSTALLING DRILLED-IN ANCHORS/OR POWDER DRIVEN PINS IN EXISTING NON-PRESTRESSED REINFORCED CONCRETE, USE CARE AND CAUTION TO AVOID CUTTING OR DAMAGING THE EXISTING REINFORCING BARS. WHEN INSTALLING THEM INTO EXISTING PRESTRESSED CONCRETE (PRE- OR POST-TENSIONED), LOCATE THE PRESTRESSED TENDONS BY USING A NON-DESTRUCTIVE METHOD PRIOR TO INSTALLATION. EXERCISE EXTREME CARE AND CAUTION TO AVOID CUTTING OR DAMAGING THE TENDONS DURING INSTALLATION. MAINTAIN A MINIMUM CLEARANCE OF ONE INCH BETWEEN THE REINFORCEMENT AND THE DRILLED-IN ANCHOR AND/OR PIN.
- ALL ELECTRICAL SERVICES IN THE HOSPITAL ARE TO REMAIN OPERATIONAL DURING THE ENTIRE CONTRACT PERIOD. ANY INTERRUPTION OF ELECTRICAL POWER FOR THE PERFORMANCE OF THIS WORK SHALL BE ONLY AT SUCH TIME AND SUCH DURATION AS APPROVED IN WRITING BY THE OWNER.
- CUT AND PATCH EXISTING CEILING AND WALL CONSTRUCTION AS REQUIRED FOR CONDUIT, OUTLET BOX, SUPPORTS AND EQUIPMENT INSTALLATION. REPAIR OF EXISTING CONSTRUCTION SHALL MATCH EXISTING TO THE ARCHITECTS SATISFACTION.
- REFER TO ARCHITECTURAL REFLECTED CEILING PLANS FOR EXACT LOCATIONS OF CEILING MOUNTED FIXTURES, SMOKE DETECTORS, SPEAKERS & OUTLETS.
- ALL CONDUIT PENETRATIONS OF FIRE RATED WALLS, FLOORS AND ROOF SHALL BE FIRE STOPPED. FIRE STOP MATERIALS SHALL BE TESTED ASSEMBLY APPROVED BY THE OSHPD FIRE MARSHAL.
- CONTRACTOR SHALL COMPLY WITH ALL GROUNDING AND BONDING REQUIREMENTS OF C.E.C. 517-13.15 & 78.
- ADJUST CEILING MOUNT SMOKE DETECTOR LOCATIONS IF REQUIRED TO PROVIDE 3 FOOT MINIMUM DISTANCE FROM SUPPLY AIR DIFFUSERS. CEILING MOUNT SMOKE DETECTORS AT FIRE DOORS, SHALL BE LOCATED 5 FOOT MAXIMUM FROM FIRE DOOR.
- PROVIDE LOWRY SOUND DEADENING CLAY PADS ON BACK & SIDES OF ALL OUTLETS & BACKBOXES IN COMMON WALLS OF PATIENT ROOMS.
- WHERE PROVIDED, THROUGH-PENETRATION FIRESTOP SYSTEM AND MEMBRANE PENETRATION DETAILS ARE FOR REFERENCE ONLY. THROUGH-PENETRATIONS AND MEMBRANE PENETRATIONS SHALL BE PROTECTED BY AN APPROVED PENETRATION FIRESTOP SYSTEM OR MEMBRANE PENETRATION FIRESTOP SYSTEM INSTALLED AS TESTED IN ACCORDANCE WITH ASTM E 814 OR UL 1479. WITH A MINIMUM POSITIVE PRESSURE DIFFERENTIAL OF 0.01 INCH (2.49 PA) OF WATER OR AS OTHERWISE PERMITTED BY CBC, SECTION 714. LISTED THROUGH-PENETRATION FIRESTOP SYSTEMS AND MEMBRANE PENETRATIONS SHALL BE INSTALLED IN ACCORDANCE WITH THE INSTALLATION DETAILS FOR LISTED SYSTEMS. LISTED THROUGH-PENETRATION FIRESTOP SYSTEMS, MEMBRANE PENETRATION PROTECTION AND OTHER PERMITTED MEANS AND METHODS OF PENETRATION PROTECTION SHALL BE SUBMITTED FOR OSHPD FDD REVIEW AND APPROVAL PRIOR TO INSTALLATION.
- ALL ELECTRICAL DEVICE LOCATIONS AND CONDUIT ROUTING INDICATED ON DRAWINGS ARE DIAGRAMMATICALLY SHOWN.

DEMOLITION NOTES

- DRAWINGS OF EXISTING CONDITIONS HAVE BEEN COMPILED FROM EXISTING DATA SUPPLIED BY THE OWNER TO THE ARCHITECT. THE ARCHITECT MAKES NO WARRANTY, EITHER EXPRESSED OR IMPLIED, FOR THE ACCURACY OR COMPLETENESS OF THE EXISTING INFORMATION RECORDED. FIELD VERIFY ALL EXISTING CONDITIONS NOTIFY THE ARCHITECT IMMEDIATELY OF ANY DISCREPANCIES.
- THE OWNER RESERVES THE RIGHT TO SALVAGE ANY DEMO ITEM. VERIFY ITEMS TO BE SALVAGED WITH THE OWNER PRIOR TO THE START OF DEMOLITION. REMOVE, PROTECT, AND TURN OVER SUCH ITEMS BY DIRECTED BY THE OWNER.
- ALL EXISTING ELECTRICAL, LIGHTING, TELEPHONE, DATA, AND PUBLIC ADDRESS CONDUIT AND WIRING SHALL REMAIN EXCEPT WHERE INDICATED OTHERWISE ON THESE PLANS. RECONNECT EXISTING OUTLETS, DEVICES AND CIRCUITS IN ADJACENT SPACES DISRUPTED BY REMOVAL OF EXISTING OUTLETS, DEVICES OR CIRCUITS IN THIS CONTRACT.
- PROTECT ALL EXISTING CONDUIT, WIRE AND SIGNAL SYSTEMS CABLES PASSING THRU REMODEL AREAS THAT SERVE ADJACENT AREAS.
- WHERE NEW WALL OR CEILING OR OTHER CONSTRUCTION WILL COVER EXISTING OUTLETS, EQUIPMENT OR DEVICES MAKING THEM INACCESSIBLE, RELOCATE THE EXISTING OUTLET, EQUIPMENT OR DEVICE AS REQUIRED OR MAKE OTHER PROVISIONS TO PROVIDE ACCESS.
- RECONNECT EXISTING OUTLETS, LIGHTS, ETC. THAT ARE TO REMAIN THAT ARE DISRUPTED BY REMOVAL OF OTHER EXISTING OUTLETS IN THE CONDUIT RUN AS REQUIRED TO PROVIDE CONTINUITY OF THE CIRCUITS.
- REMOVE ALL EXISTING CONDUITS IN CEILING SPACES FOR SYSTEMS, EQUIPMENT AND DEVICES OR OUTLETS BEING REMOVED THAT ARE NOT BEING REUSED AND ALL ABANDONED EXISTING CONDUITS. REMOVE ALL EXISTING CONDUITS IN WALLS OR FLOORS FOR DEVICES BEING REMOVED THAT INTERFERE WITH NEW CONSTRUCTION. REMOVE WIRE FROM ABANDONED CONDUITS.
- REMOVE ALL ABANDONED SIGNAL SYSTEM CABLES IN CEILING SPACE.
- THE WORD 'ELECTRICAL' USED IN THE CONTEXT OF THESE DEMOLITION PLANS INCLUDES LIGHTING, ELECTRICAL DEVICES & EQUIPMENT, AND ALL SIGNAL SYSTEMS.
- REFER TO LIGHTING, POWER & SIGNAL PLANS FOR ADDITIONAL EXISTING ELECTRICAL TO REMAIN.
- WHERE EXISTING DEVICES OR EQUIPMENT ARE INDICATED TO BE REMOVED IN WALLS THAT ARE TO REMAIN, ALSO REMOVE OUTLET BOX OR BACKBOX AND PATCH WALL FINISH TO MATCH SURROUNDING AREA.
- WHERE EXISTING OUTLETS ARE REMOVED AND THE EXISTING CIRCUIT IS NOT SERVING REMAINING OUTLETS. REMOVE EXISTING WIRE AND CONDUIT BACK TO THE SERVING PANELBOARD AND UPDATE THE PANELBOARD CIRCUIT DIRECTORY INDICATING 'SPARE' FOR ALL UNUSED CIRCUIT BREAKERS.

S F E I R
A R C H I T E C T S

1350 Columbia Street, Suite 603
San Diego, CA 92101

P: 619-299-3917
F: 619-299-5084
www.sfeirarch.com

TCMC
OBSERVATION
ROOM


TRI-CITY MEDICAL
CENTER
4002 VISTA WAY
OCEANSIDE, CALIFORNIA
92056

OWNER: TRI-CITY MEDICAL CENTER
4002 VISTA WAY
OCEANSIDE, CALIFORNIA 92056
TEL:(760)724-8411

ARCHITECT: SFEIR ARCHITECTS
1350 COLUMBIA STREET, SUITE 603
SAN DIEGO, CALIFORNIA 92101
TEL:(619)299-3917 FAX:(619)299-5084

STRUCTURAL: SUN STRUCTURAL ENGINEERING, INC.
2091 LAS PALMAS DRIVE, SUITE D
CARLSBAD, CALIFORNIA 92011
TEL:(760)438-1188

ME&P: P2S ENGINEERING, INC.
9665 CHESAPEAKE DRIVE, SUITE 230
SAN DIEGO, CALIFORNIA 92123
TEL:(619)299-3917 FAX:(619)299-5084

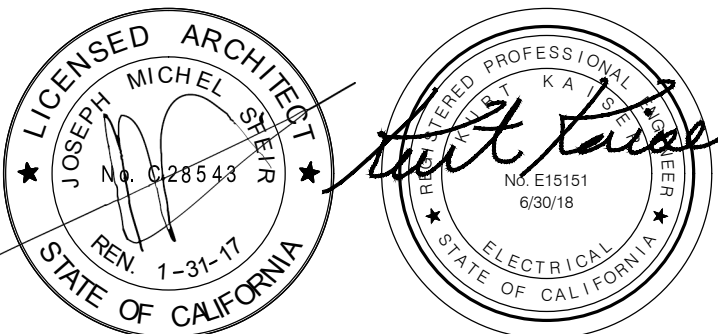

OSHPD COMMENTS	12/02/2016
DESIGN CHANGES	12/02/2016
OSHPD COMMENTS	04/20/2017
OSHPD COMMENTS	06/14/2017

REV: DESCRIPTION: DATE:

CONSULTANT

p2s P2S Engineering, Inc.
9665 Chesapeake Dr., Suite #230
San Diego, CA 92123
T 619.618.2347 F 619.330.0668
www.p2seng.com

OSHPD APPROVAL STAMP:
OSHPD #: S162581-37-00

REVIEWED IN ACCORDANCE WITH
THE REQUIREMENTS OF T24, CCR
APPROVED

Laura Baldrati, Sr. Architect

Office of Statewide Health
Planning & Development
FACILITIES DEVELOPMENT DIVISION

07/06/2016 10:49:54 AM
#S162581-37-00
SHEET TITLE:

NOTES,
ABBREVIATIONS,
AND LEGEND

PROJECT TITLE:

TCMC OBSERVATION ROOM

PROJECT # 01643.00 SHEET NUMBER:

DRAWN BY: ED

CHECKED BY: PAL

SCALE: As indicated

DATE: 10/11/16

P2S No. 8452

E0-10

LUMINAIRE SCHEDULE								
TYPE	DESCRIPTION	TOTAL V-A	LAMPS			VOLTAGE	MTG.	REMARKS
			NO.	V-A	TYPE			
<div>A</div> <div>50</div>	TAMPER RESISTANT RECESSED GYPSUM MOUNTED 1' X 4' 3500K LED WITH STANDARD 0-10V DIMMING DRIVER. KENALL #CSEDO-14-45L35-DCC-120-5F-RM	50	-	50	LED	120	R	NOTES 1, 2
<div>B</div> <div>16</div>	TAMPER RESISTANT RECESSED 6" DIAMETER DOWNLIGHT LED WITH STANDARD 0-10V DIMMING DRIVER. KENALL #CDL6VL2-13L35K-120-2FW-T	16	-	16	LED	120	R	NOTES 1, 2
<div><div><u>GENERAL NOTES:</u></div><div><div>1. ALL LED LUMINAIRES SHALL BE PROVIDED WITH 3500K COLOR TEMPERATURE LAMPS (UNLESS OTHERWISE NOTED) AND ELECTRONIC DRIVER AS SPECIFIED.</div></div></div> <div><div><u>KEY NOTES:</u></div><div><div>1. PROVIDE COMPLETE WITH ALL MOUNTING HARDWARE REQUIRED FOR A COMPLETE INSTALLATION.</div><div>2. REFER TO ARCHITECTURAL PLANS FOR CEILING TYPE.</div></div></div> <div><div><u>ABBREVIATIONS:</u></div><div><div>P = PENDANT</div><div>R = RECESSED</div><div>S = SURFACE</div><div>W = WALL</div><div>PO = POLE</div></div></div>								

1. ALL NEW FEEDER CONDUCTORS SHALL BE CONTINUOUS WITH NO SPICES.
2. ALL FEEDERS SHALL BE COPPER WITH 90° C. (THHN/THWN) INSULATION.
3. NEW CIRCUIT BREAKERS SHALL BE TYPE TO MATCH EXISTING, U.N.O. PROVIDE ALL REQUIRED MOUNTING HARDWARE, LUGS AND COVERPLATES FOR A COMPLETE INSTALLATION.

1	NO LOAD INCREASE AS PART OF THIS PROJECT
---	--

1350 Columbia Street, Suite 603
San Diego, CA 92101

P: 619-299-3917
F: 619-299-5084
www.sfeirarch.com

TRI-CITY MEDICAL
CENTER
4002 VISTA WAY
OCEANSIDE, CALIFORNIA
92056

OWNER: TRI-CITY MEDICAL CENTER
4002 VISTA WAY
OCEANSIDE, CALIFORNIA 92056
TEL(760)724-8411

ARCHITECT: SFEIR ARCHITECTS
1350 COLUMBIA STREET, SUITE 603
SAN DIEGO, CALIFORNIA 92101
TEL(619)299-3917 FAX(619)299-5084

STRUCTURAL: SUN STRUCTURAL ENGINEERING, INC.
2091 LAS PALMAS DRIVE, SUITE D
CARLSBAD, CALIFORNIA 92011
TEL(760)438-1188

ME&P: P2S ENGINEERING, INC.
9665 CHESAPEAKE DRIVE, SUITE 23
SAN DIEGO, CALIFORNIA 92123
TEL(619)299-3917 FAX(619)299-5084



TOTAL OA =	0 VOLT-AMPS	0 AMPS	* "L" DENOTES LONG CONTINUOUS LOAD
TOTAL OB =	0 VOLT-AMPS	0 AMPS	1. CIRCUIT LOAD MODIFIED WITH NO LOAD INCREASES
TOTAL OC =	0 VOLT-AMPS	0 AMPS	

TOTAL OA =	0 VOLT-AMPS	0 AMPS	* "L" DENOTES LONG CONTINUOUS LOAD
TOTAL OB =	200 VOLT-AMPS	1.667 AMPS	1. PROVIDE CIRCUIT BREAKER INDICATED IN AVAILABLE SPACE.
TOTAL OC =	50 VOLT-AMPS	0.417 AMPS	2. INDICATES LOAD ADDED TO EXISTING CIRCUIT. (EXISTING LOAD 204W + 200W ADDED LOAD = 404W NEW TOTAL LOAD)



NO SCALE

1	OSHPD COMMENTS	12/02/2016
2	DESIGN CHANGES	12/02/2016
3	OSHPD COMMENTS	04/20/2017
4	OSHPD COMMENTS	06/14/2017

REV: DESCRIPTION: DATE:

CONSULTANT

p2s **P2S Engineering, Inc.**
9665 Chesapeake Dr., Suite #230
San Diego, CA 92123
T 619.618.2347 F 619.330.0668
www.p2seng.com

OSHPD #: S162581-37-00

REVIEWED IN ACCORDANCE WITH
THE REQUIREMENTS OF T24, CCR

APPROVED

Laura Baldrati, Sr. Architect

Office of Statewide Health
Planning & Development
FACILITIES DEVELOPMENT DIVISION

8:54 AM
SHEET TITLE:

SINGLE LINE DIAGRAM AND SCHEDULES

PROJECT TITLE

TCMC OBSERVATION ROOM

PROJECT #: 01643 00

DRAWN BY:
ED


CHECKED BY:
RAI

As indicated

DATE:
10/11/16

P2S No. 8452

100% CONSTRUCTION DOCUMENTS

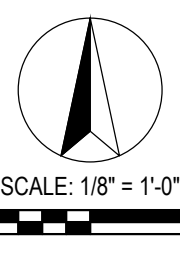


TRI-CITY MEDICAL
CENTER
4002 VISTA WAY
OCEANSIDE, CALIFORNIA
92056

OWNER: TRI-CITY MEDICAL CENTER
4002 VISTA WAY
OCEANSIDE, CALIFORNIA 92056
TEL(760)724-8411

ARCHITECT: SFEIR ARCHITECTS
1350 COLUMBIA STREET, SUITE 603
SAN DIEGO, CALIFORNIA 92101
TEL(619)299-3917 FAX(619)299-5084

STRUCTURAL: SUN STRUCTURAL ENGINEERING, INC.
2091 LAS PALMAS DRIVE, SUITE D
CARLSBAD, CALIFORNIA 92011
TEL(760)438-1188

ME&P: P2S ENGINEERING, INC.
9985 CHESAPEAKE DRIVE, SUITE 230
SAN DIEGO, CALIFORNIA 92123
TEL(619)299-3917 FAX(619)299-5084

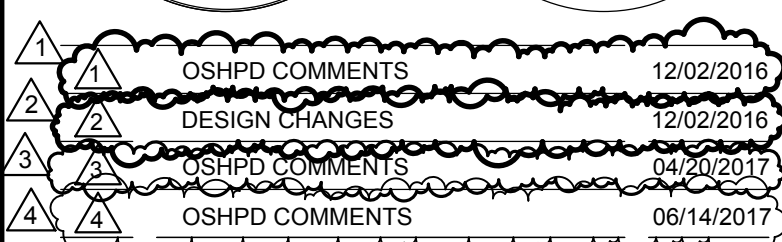

REV:	DESCRIPTION:	DATE:
CONSULTANT		

p2s **P2S Engineering, Inc.**
9665 Chesapeake Dr., Suite #230
San Diego, CA 92123
T 619.618.2347 F 619.330.0668
www.p2seng.com

OSHHPD APPROVAL STAMP:
OSHHPD #: S162581-37-00



07/06/2017 10:48:54 AM
#[S16581-37-00]
SHEET TITLE:


DEMOLITION AND RENOVATION PLANS

PROJECT TITLE:	
TCMC OBSERVATION ROOM	
PROJECT #:	SHEET NUMBER:
01643.00	
DRAWN BY:	
ED	
CHECKED BY:	
PAL	
SCALE:	
As Indicated	
DATE	
10/11/16	
E2-10	
P.S. No. 0453	


E2-10

P2S No. 8452

1	ALL EXISTING ELECTRICAL TO BE REMOVED UNLESS OTHERWISE NOTED.
2	EXISTING RECEPTACLE TO BE RELOCATED.
3	PROVIDE LUTRON SLIDE-TO-OFF DIMMER #NTF-10-WH.
4	INTERCEPT EXISTING UNSWITCHED LIGHTING CIRCUIT "C-5" AND EXTEND AS INDICATED. NO INCREASE IN LOAD.
5	INTERCEPT EXISTING RECEPTACLE CIRCUIT "C-16" AND EXTEND AS INDICATED. NO INCREASE IN LOAD.
6	RECONNECT RELOCATED RECEPTACLE TO EXISTING CIRCUIT. NO INCREASE IN LOAD.
7	INTERCEPT EXISTING RECEPTACLE CIRCUIT "E-3" AND EXTEND AS INDICATED. REFER TO PANEL SCHEDULE FOR LOAD SUMMARY.

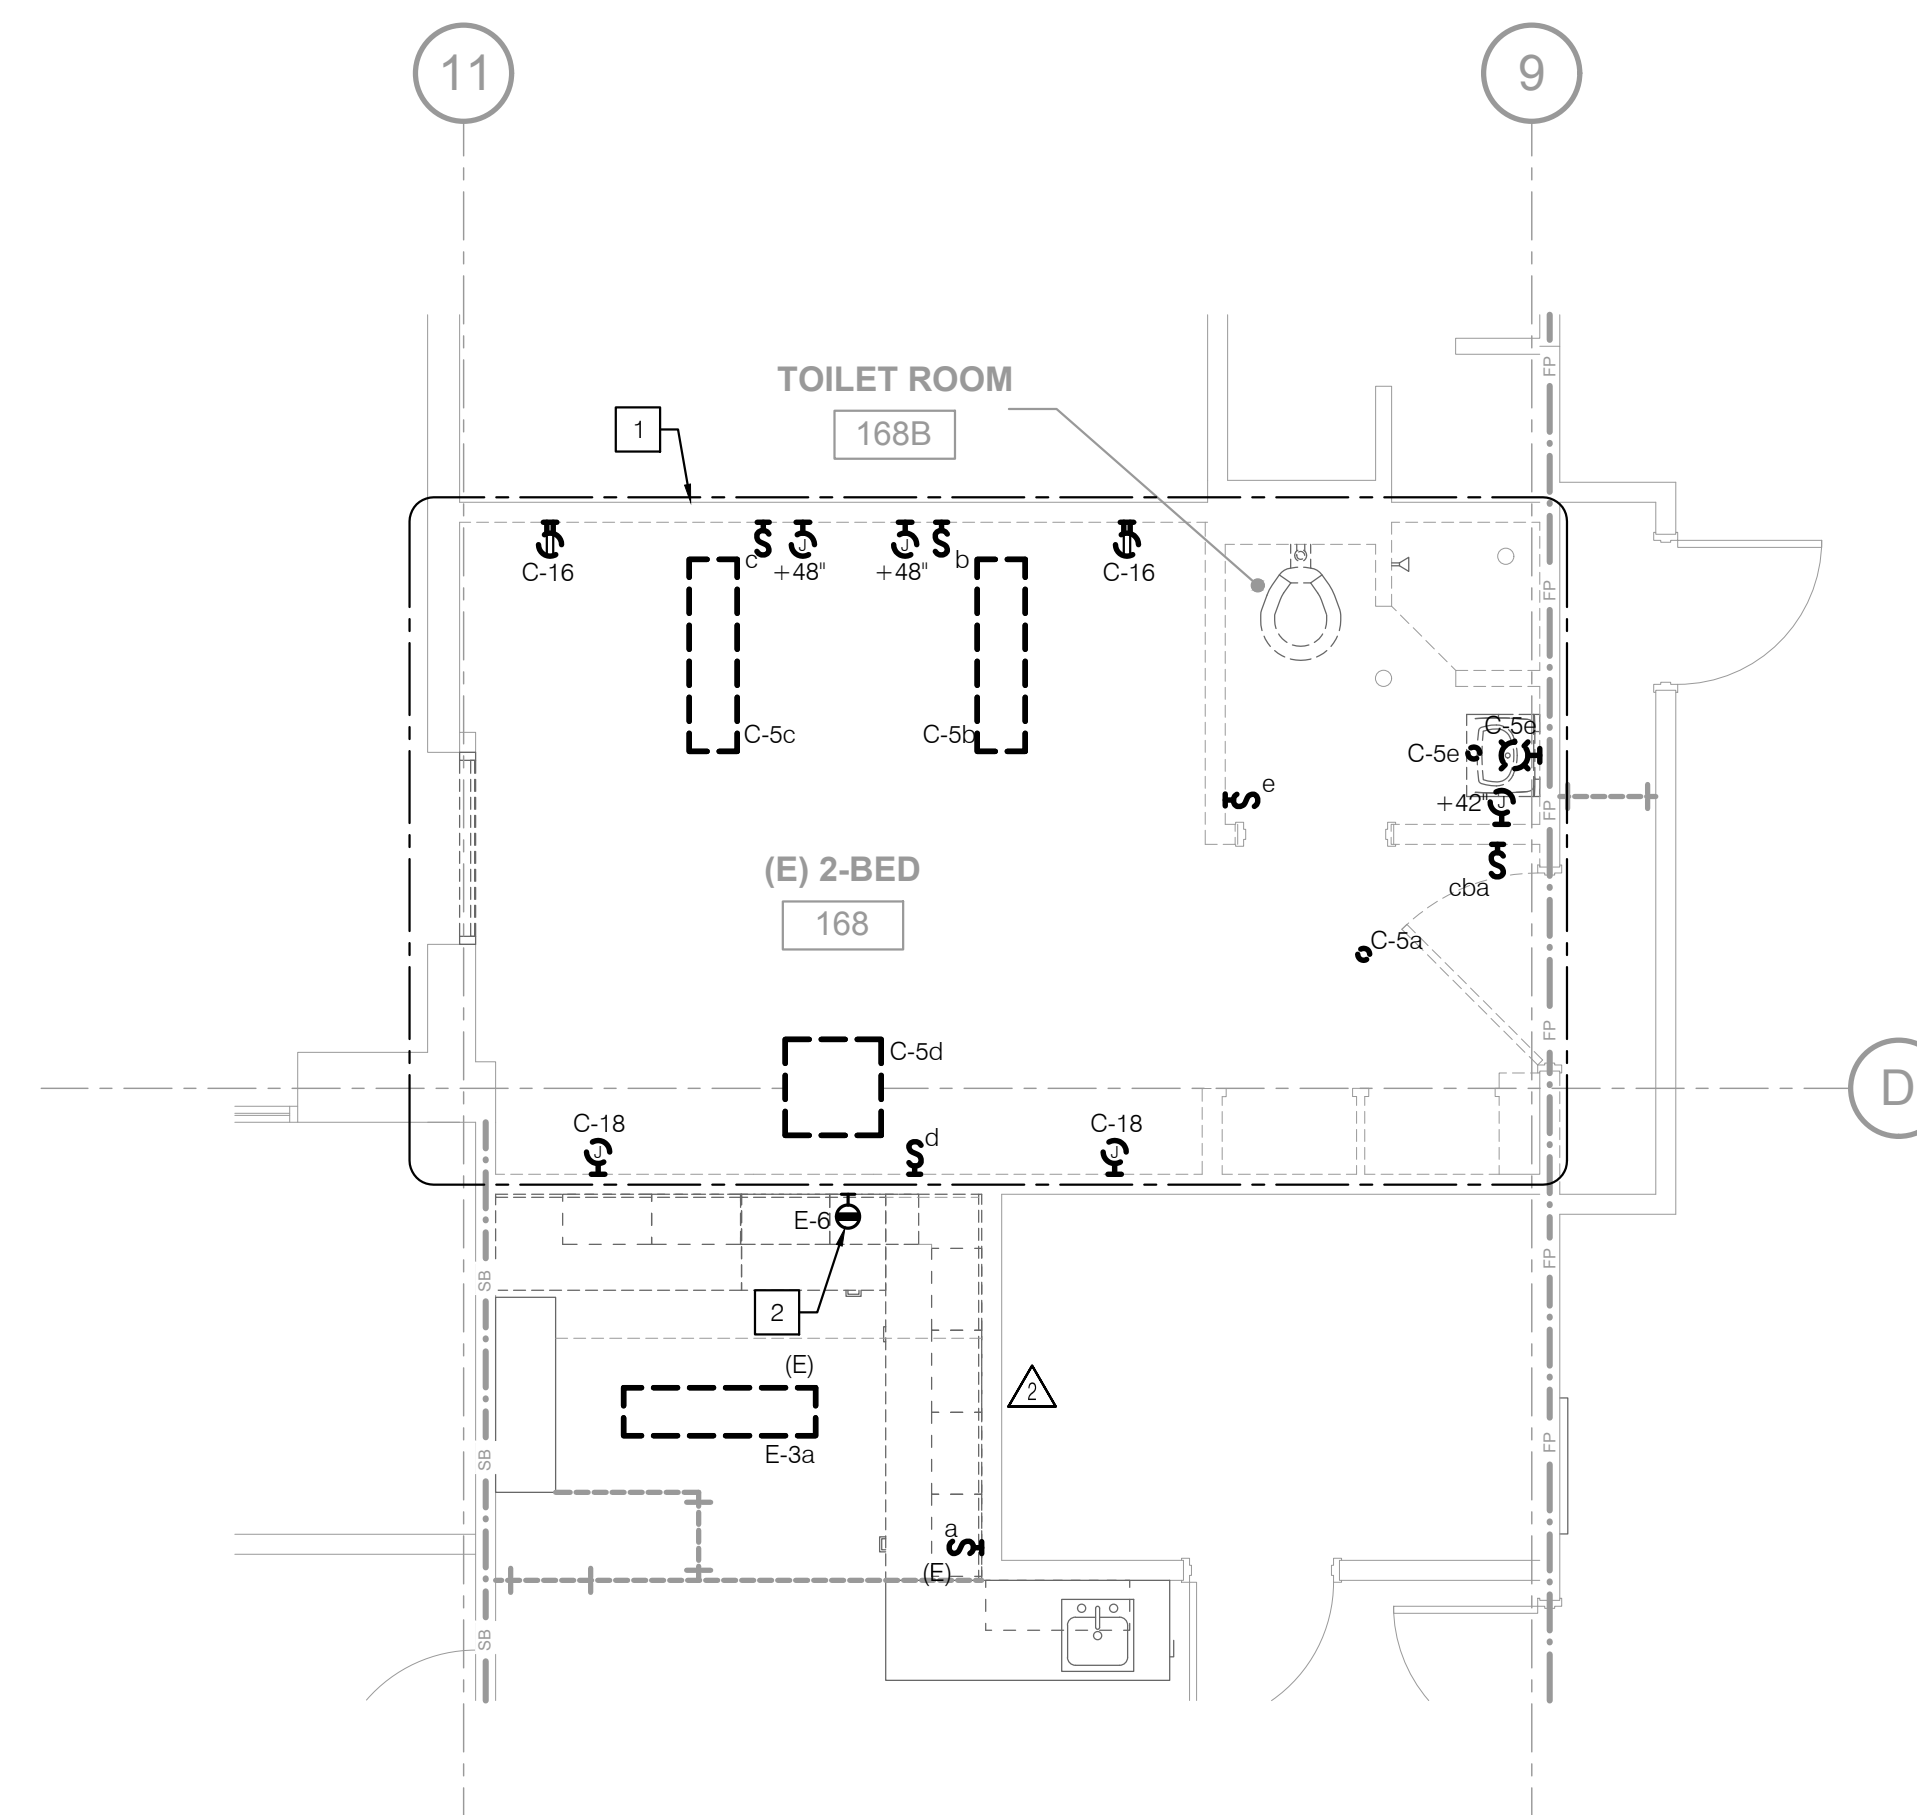

2 DEMOLITION PLAN

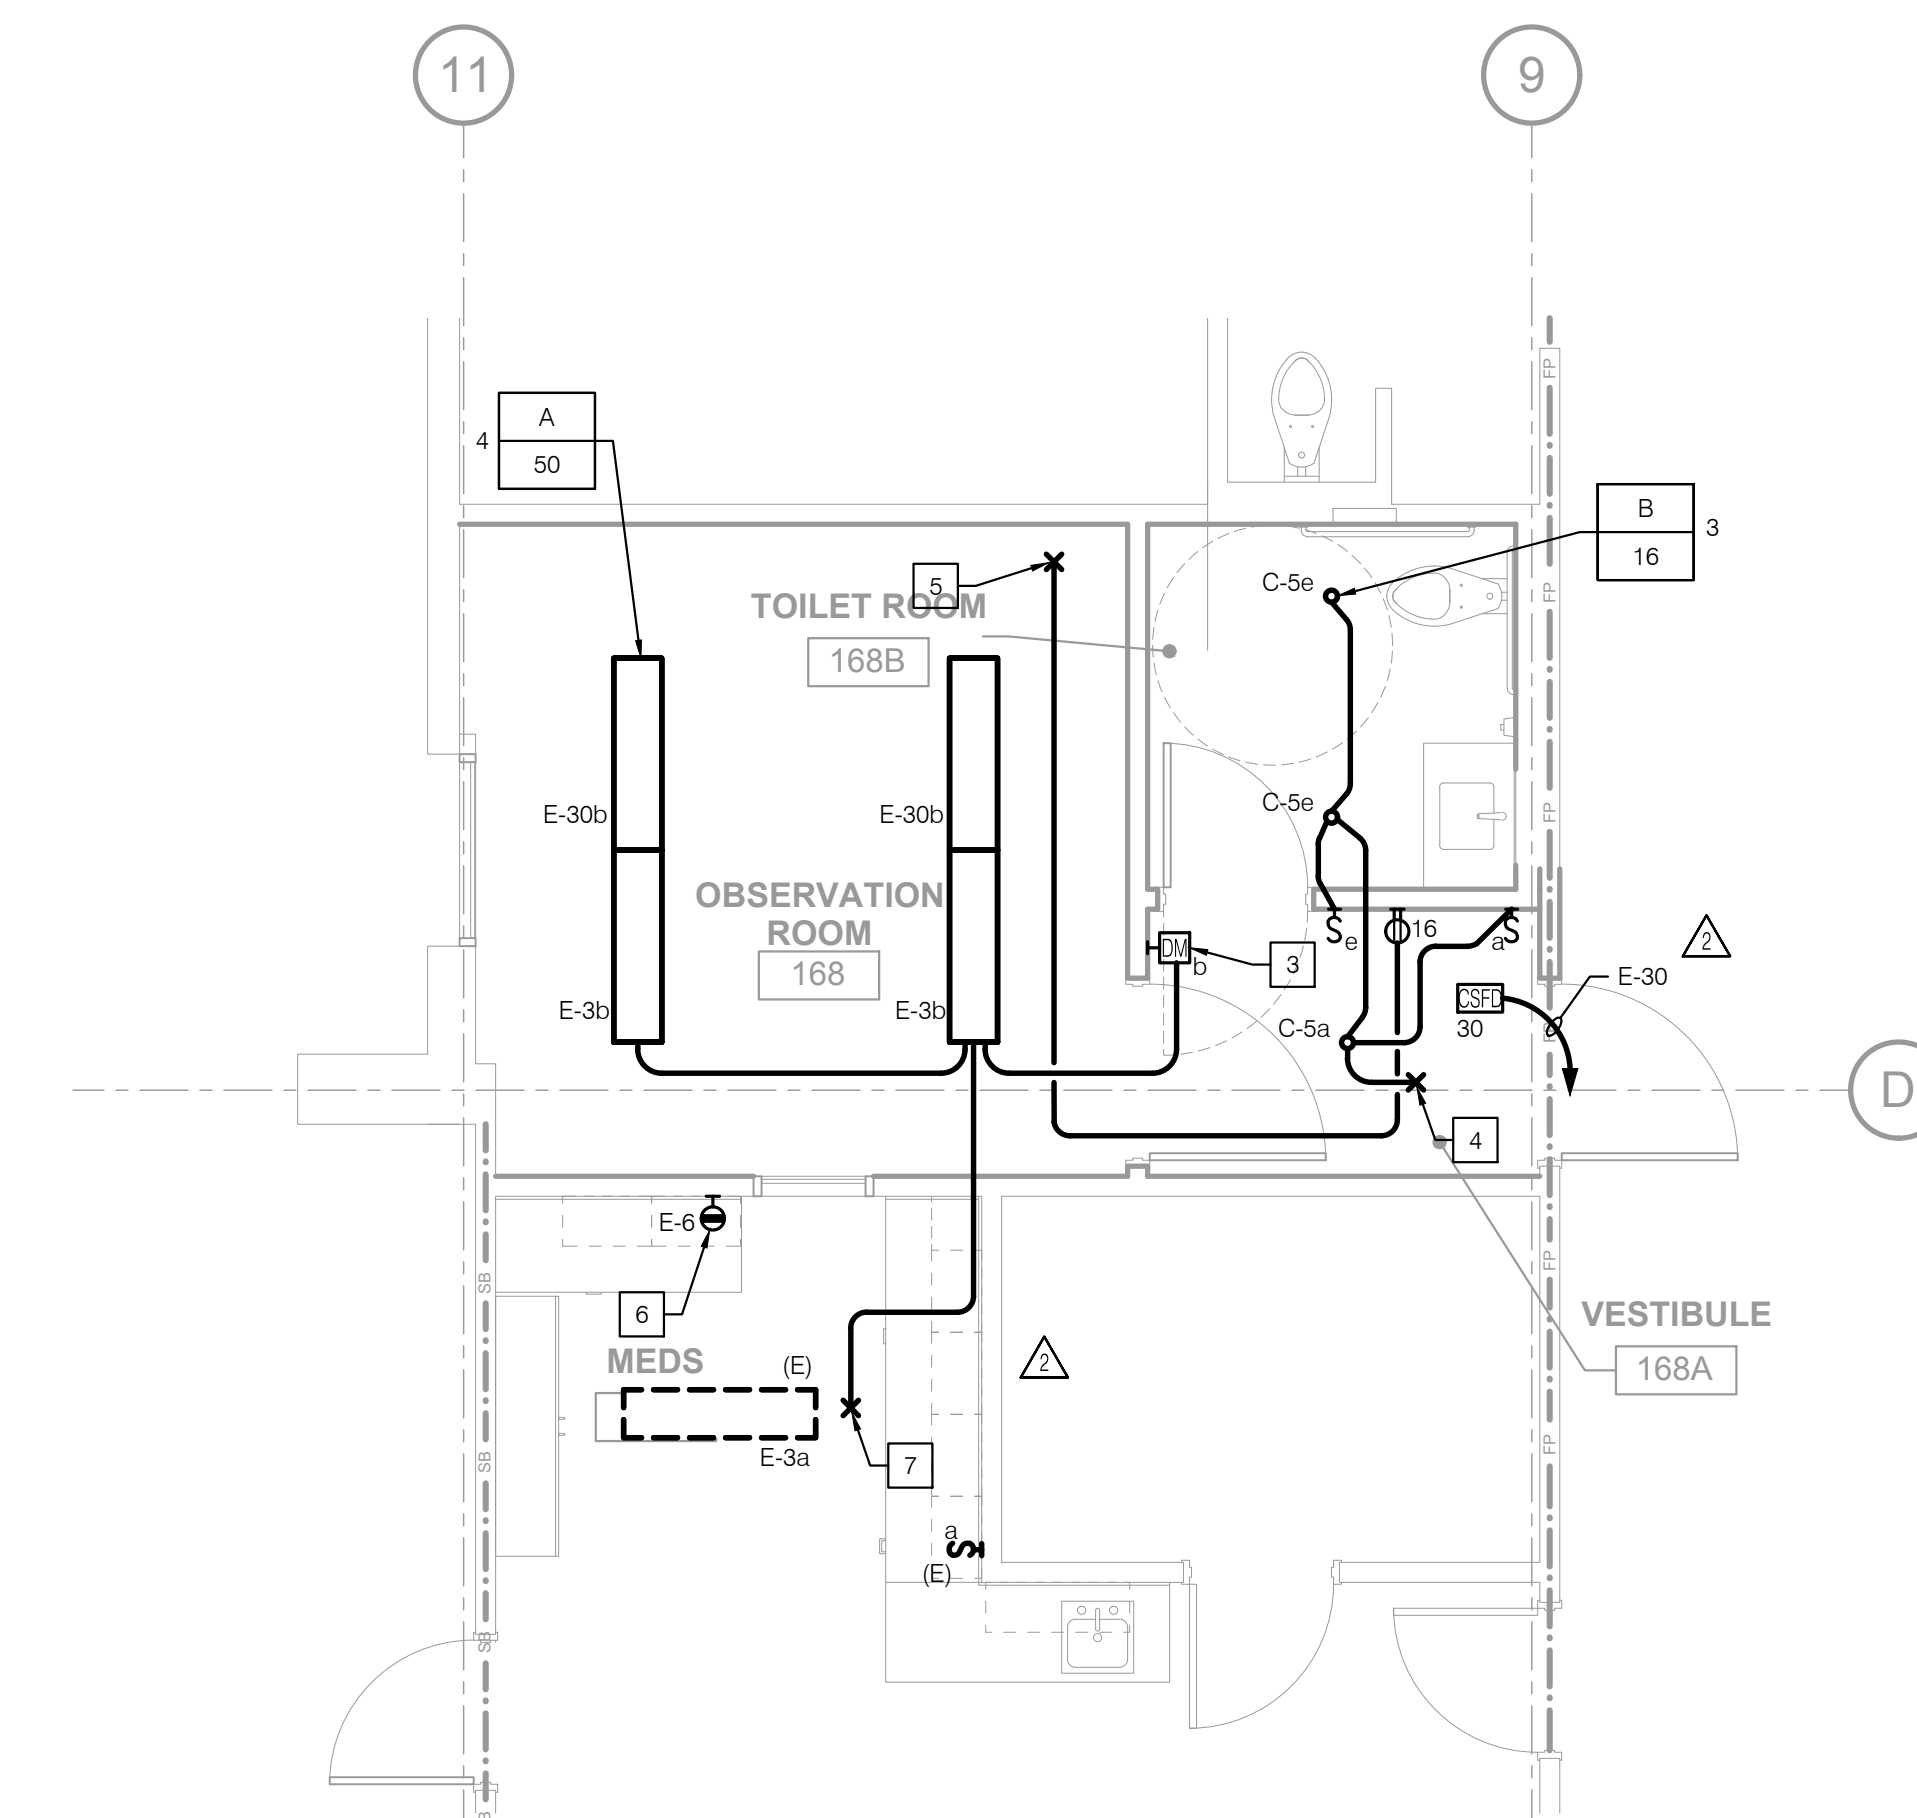








1 RENOVATION PLAN

GENERAL NOTES:

1. THE GENERAL CONTRACTOR SHALL VERIFY ALL EXISTING CONDITIONS AND MEASUREMENTS IN THE FIELD PRIOR TO STARTING CONSTRUCTION.
2. REFER TO GENERAL NOTES ON SHEET A0-00 FOR INFORMATION NOT INDICATED ON THIS SHEET.

CODE COMPLIANCE
PARTITION LEGEND:

-  ACCESSIBLE PATH OF TRAVEL.
-  EGRESS PATH OF TRAVEL.
-  ONE-HOUR RATED CORRIDOR.
-  INDICATES A ONE HOUR SMOKE BARRIER.
-  INDICATES A ONE HOUR FIRE RATED PARTITION.
-  INDICATES A ONE HOUR RATED FIRE BARRIER.
-  INDICATES A TWO HOUR RATED FIRE BARRIER.

S F E I R
A R C H I T E C T S

1350 Columbia Street, Suite 603
San Diego, CA 92101

P: 619-299-3917
F: 619-299-5084
www.sfeirarch.com

TCMC
OBSERVATION
ROOM


TRI-CITY MEDICAL
CENTER
4002 VISTA WAY
OCEANSIDE, CALIFORNIA
92056

OWNER: TRI-CITY MEDICAL CENTER
4002 VISTA WAY
OCEANSIDE, CALIFORNIA 92056
TEL(760)724-8411

ARCHITECT: SFEIR ARCHITECTS
1350 COLUMBIA STREET, SUITE 603
SAN DIEGO, CALIFORNIA 92101
TEL(619)299-3917 FAX(619)299-5084

STRUCTURAL: SUN STRUCTURAL ENGINEERING, INC.
2091 LAS PALMAS DRIVE, SUITE D
CARLSBAD, CALIFORNIA 92011
TEL(760)438-1188

ME&P: P2S
9665 CHESAPEAKE, SUITE 230
SAN DIEGO, CALIFORNIA 92123
TEL(619)618-2347

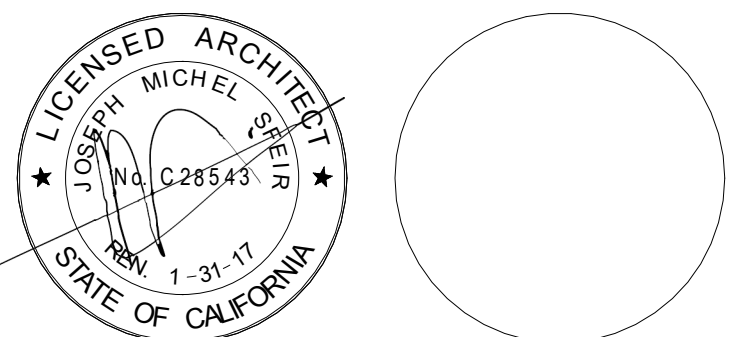

1	OSHDP COMMENTS	01/18/2017
2	DESIGN CHANGES	01/18/2017
3	OSHDP COMMENTS	04/20/2017
4	OSHDP COMMENTS	06/14/2017

REV: DESCRIPTION: DATE:

CONSULTANT

OSHDP APPROVAL STAMP:
OSHDP #: S162581-37-00



SHEET TITLE:
CODE COMPLIANCE FIRST
FLOOR PLAN

PROJECT TITLE:
TCMC OBSERVATION ROOM

PROJECT #
01643.00

DRAWN BY:
Author


CHECKED BY:
Checker

SCALE:
As indicated

DATE:
10/11/16

SHEET NUMBER:
A1-01A

1 CODE COMPLIANCE BHU FIRST FLOOR PLAN
1" = 10'-0"

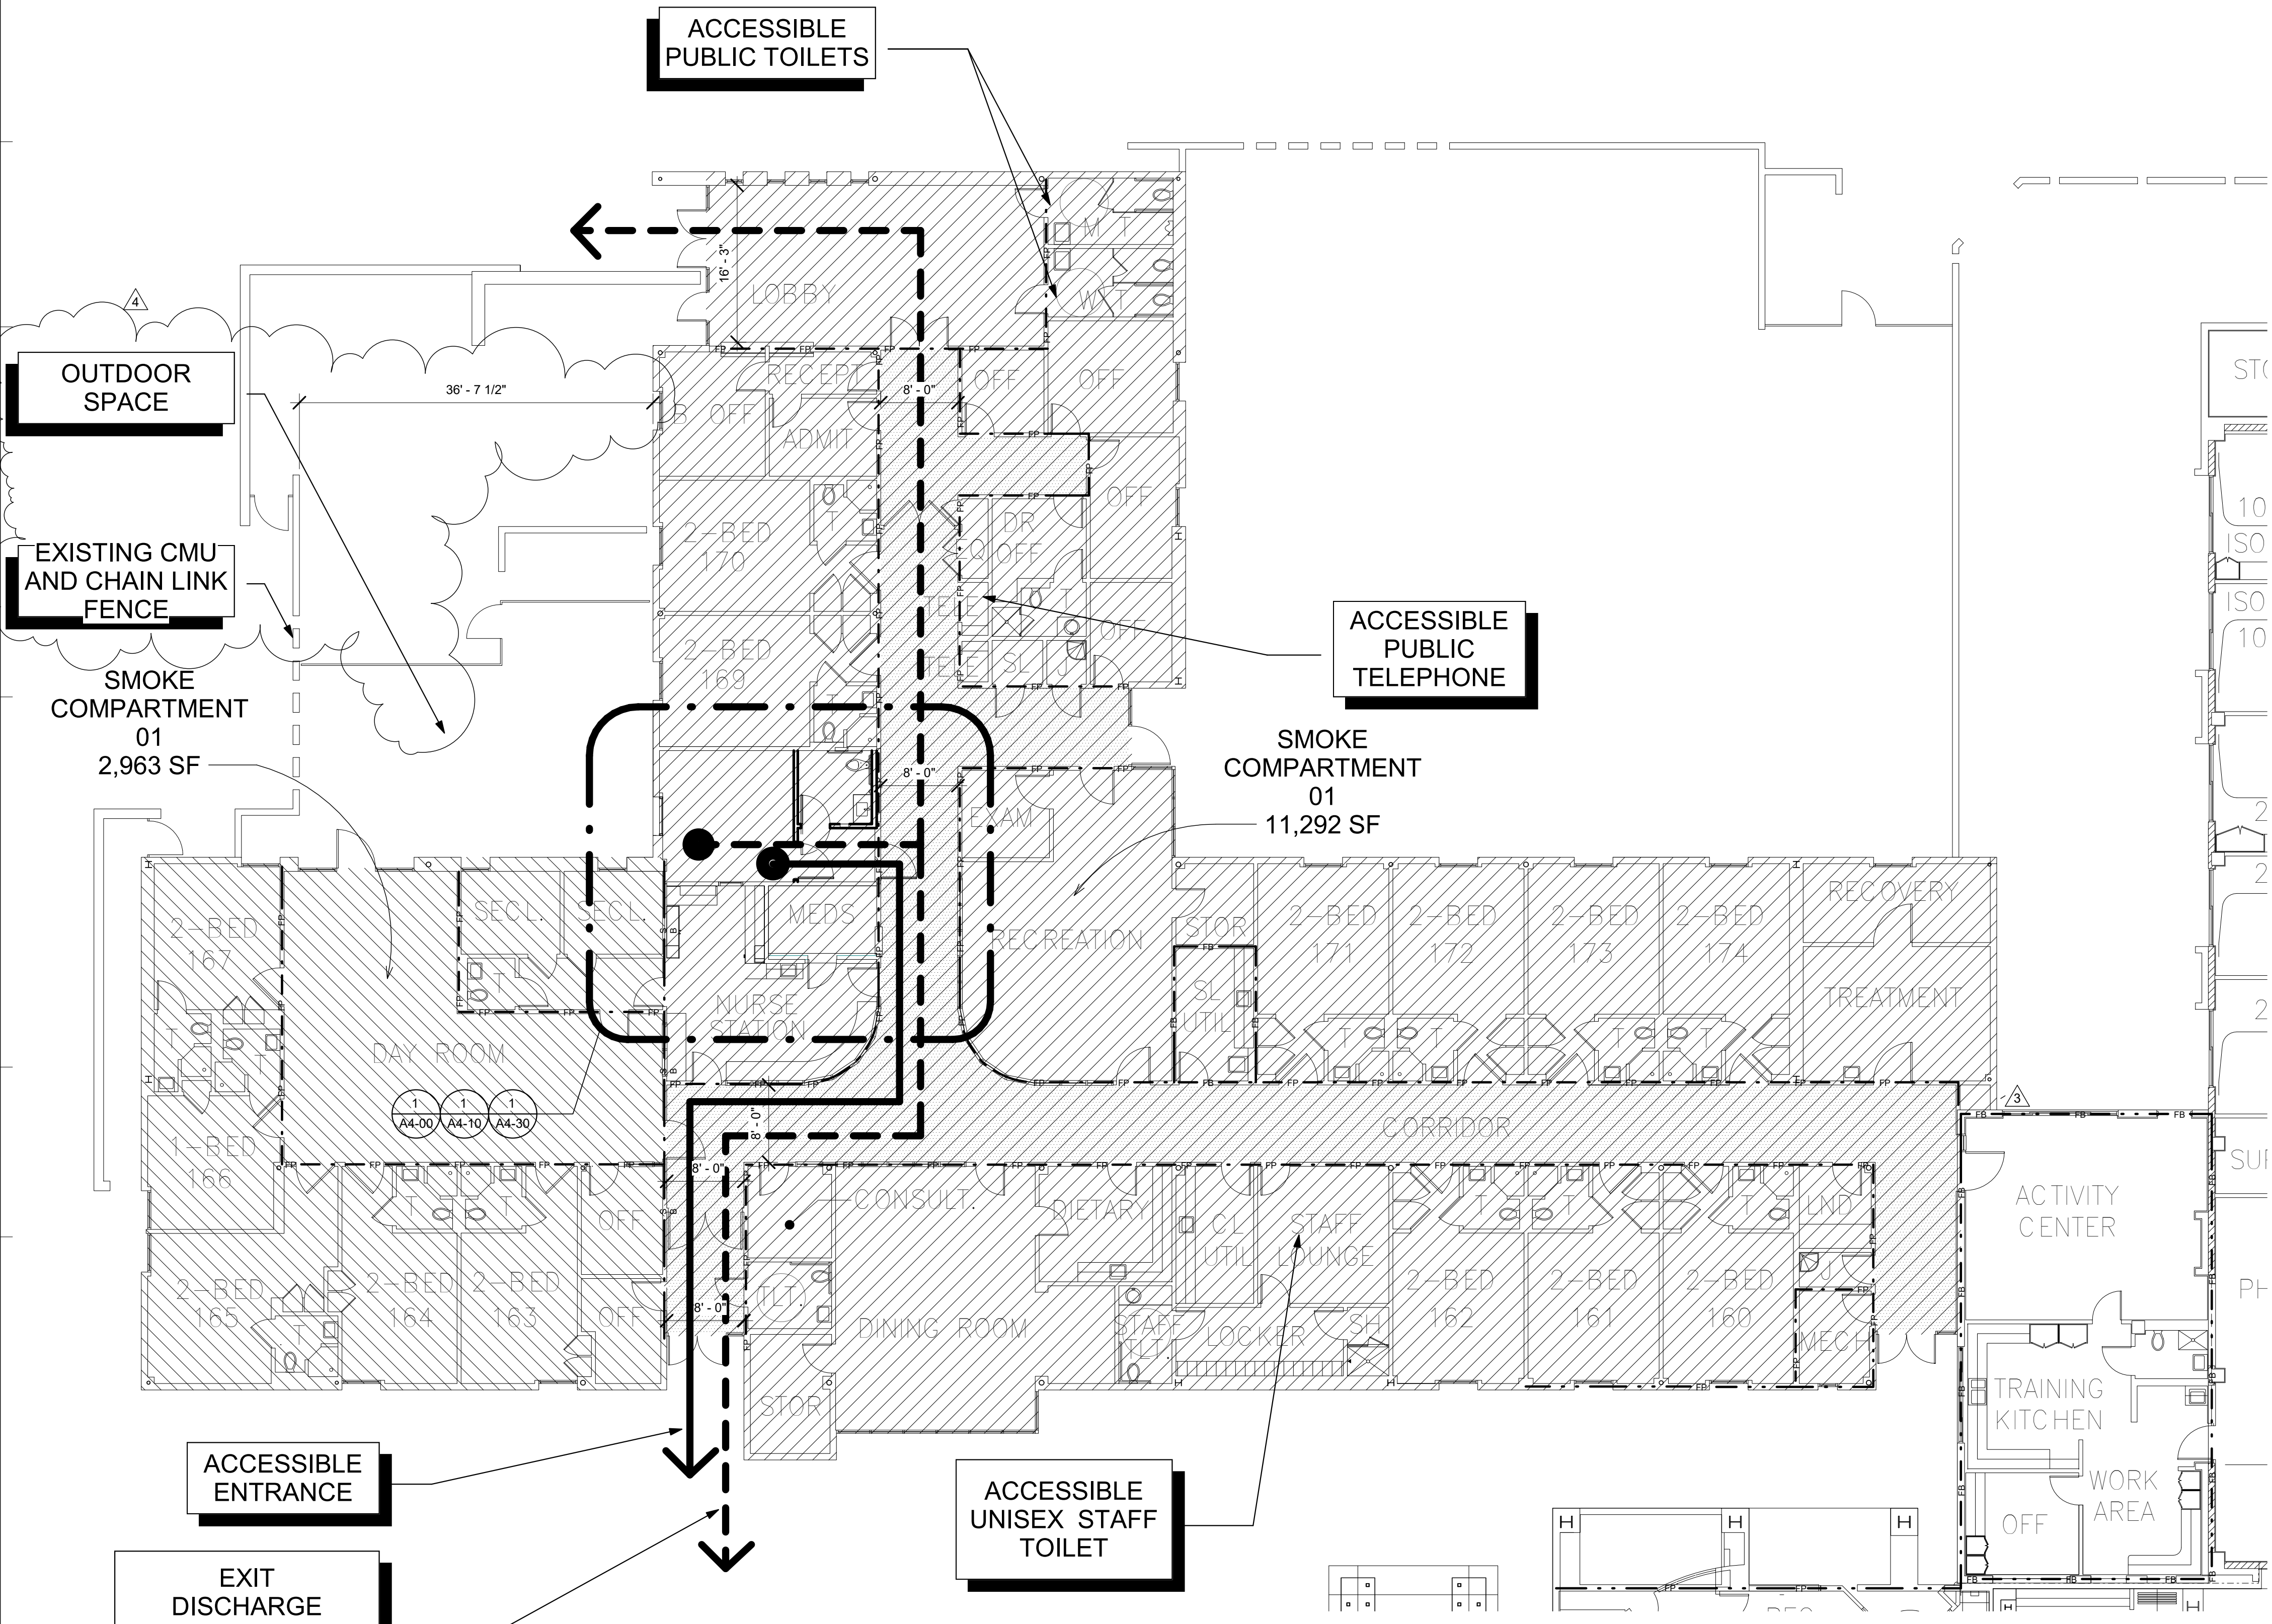

NOTES:

1.

FINISH LEGEND:

FLOORS:

SV-1 MANNINGTON SHEET VINYL "BUTTERMILK" 15360
SV-2 MATCH EXISTING
VCT-1 MATCH EXISTING

DOOR & FRAME:

DR-1 DOOR: SHERWIN WILLIAMS SW 7032 "WARM STRONG BEIGE"
FRAME: SHERWIN WILLIAMS SW 7032 "WARM STRONG BEIGE"

BASE:

B-1 MANNINGTON SHEET VINYL "BUTTERMILK" - 6" INTEGRAL COVE (NO METAL TRIM) SEE
2/ID-1
B-2 MATCH EXISTING

WALLS:

P-1 SHERWIN WILLIAMS SW 7002 "DOWNY" EPOXY
P-2 MATCH EXISTING
WC-1 1-1/2" FOAM COVERED WITH HEAVY DUTY CLASS A FIRE RATED VINYL - COLOR TO MATCH SHERWIN WILLIAMS SW 7032 STRONG BEIGE"
"WARM

WC-2 ACROVYN #103 "BEIGE"

CEILING:


C-1 GYPSUM BOARD SHERWIN WILLIAMS SW 6119 "ANTIQUE WHITE"

LAMINATE & ALL EXPOSED SURFACES:

PL-1 WILSONART #7919K-78 "AMBER CHERRY"
PL-2 MATCH EXISTING

COUNTERTOPS:

SS-1 CORIAN "GRANOLA F"

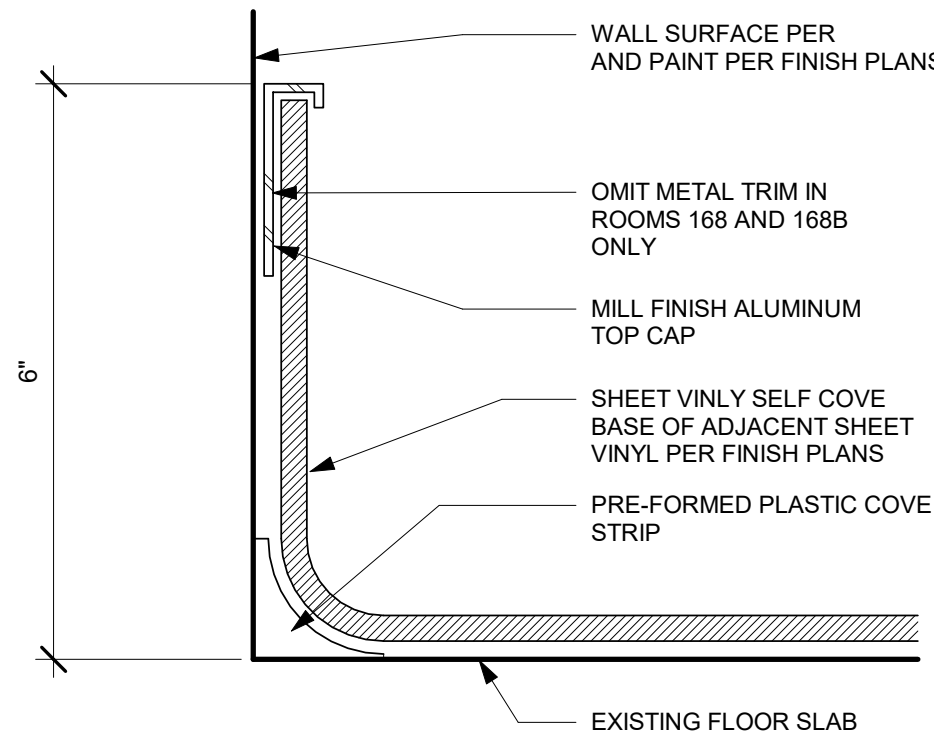


NOTES:

1. STANDARD FINISH BASE DETAIL, APPLY AT ALL LOCATIONS RESILIENT SELF COVE BASE LOCATIONS PER FINISH PLANS.

2 SHEET VINYL COVE BASE1
6" = 1'-0"

1 FIRST LEVEL NEW FINISHES PLAN
1/4" = 1'-0"

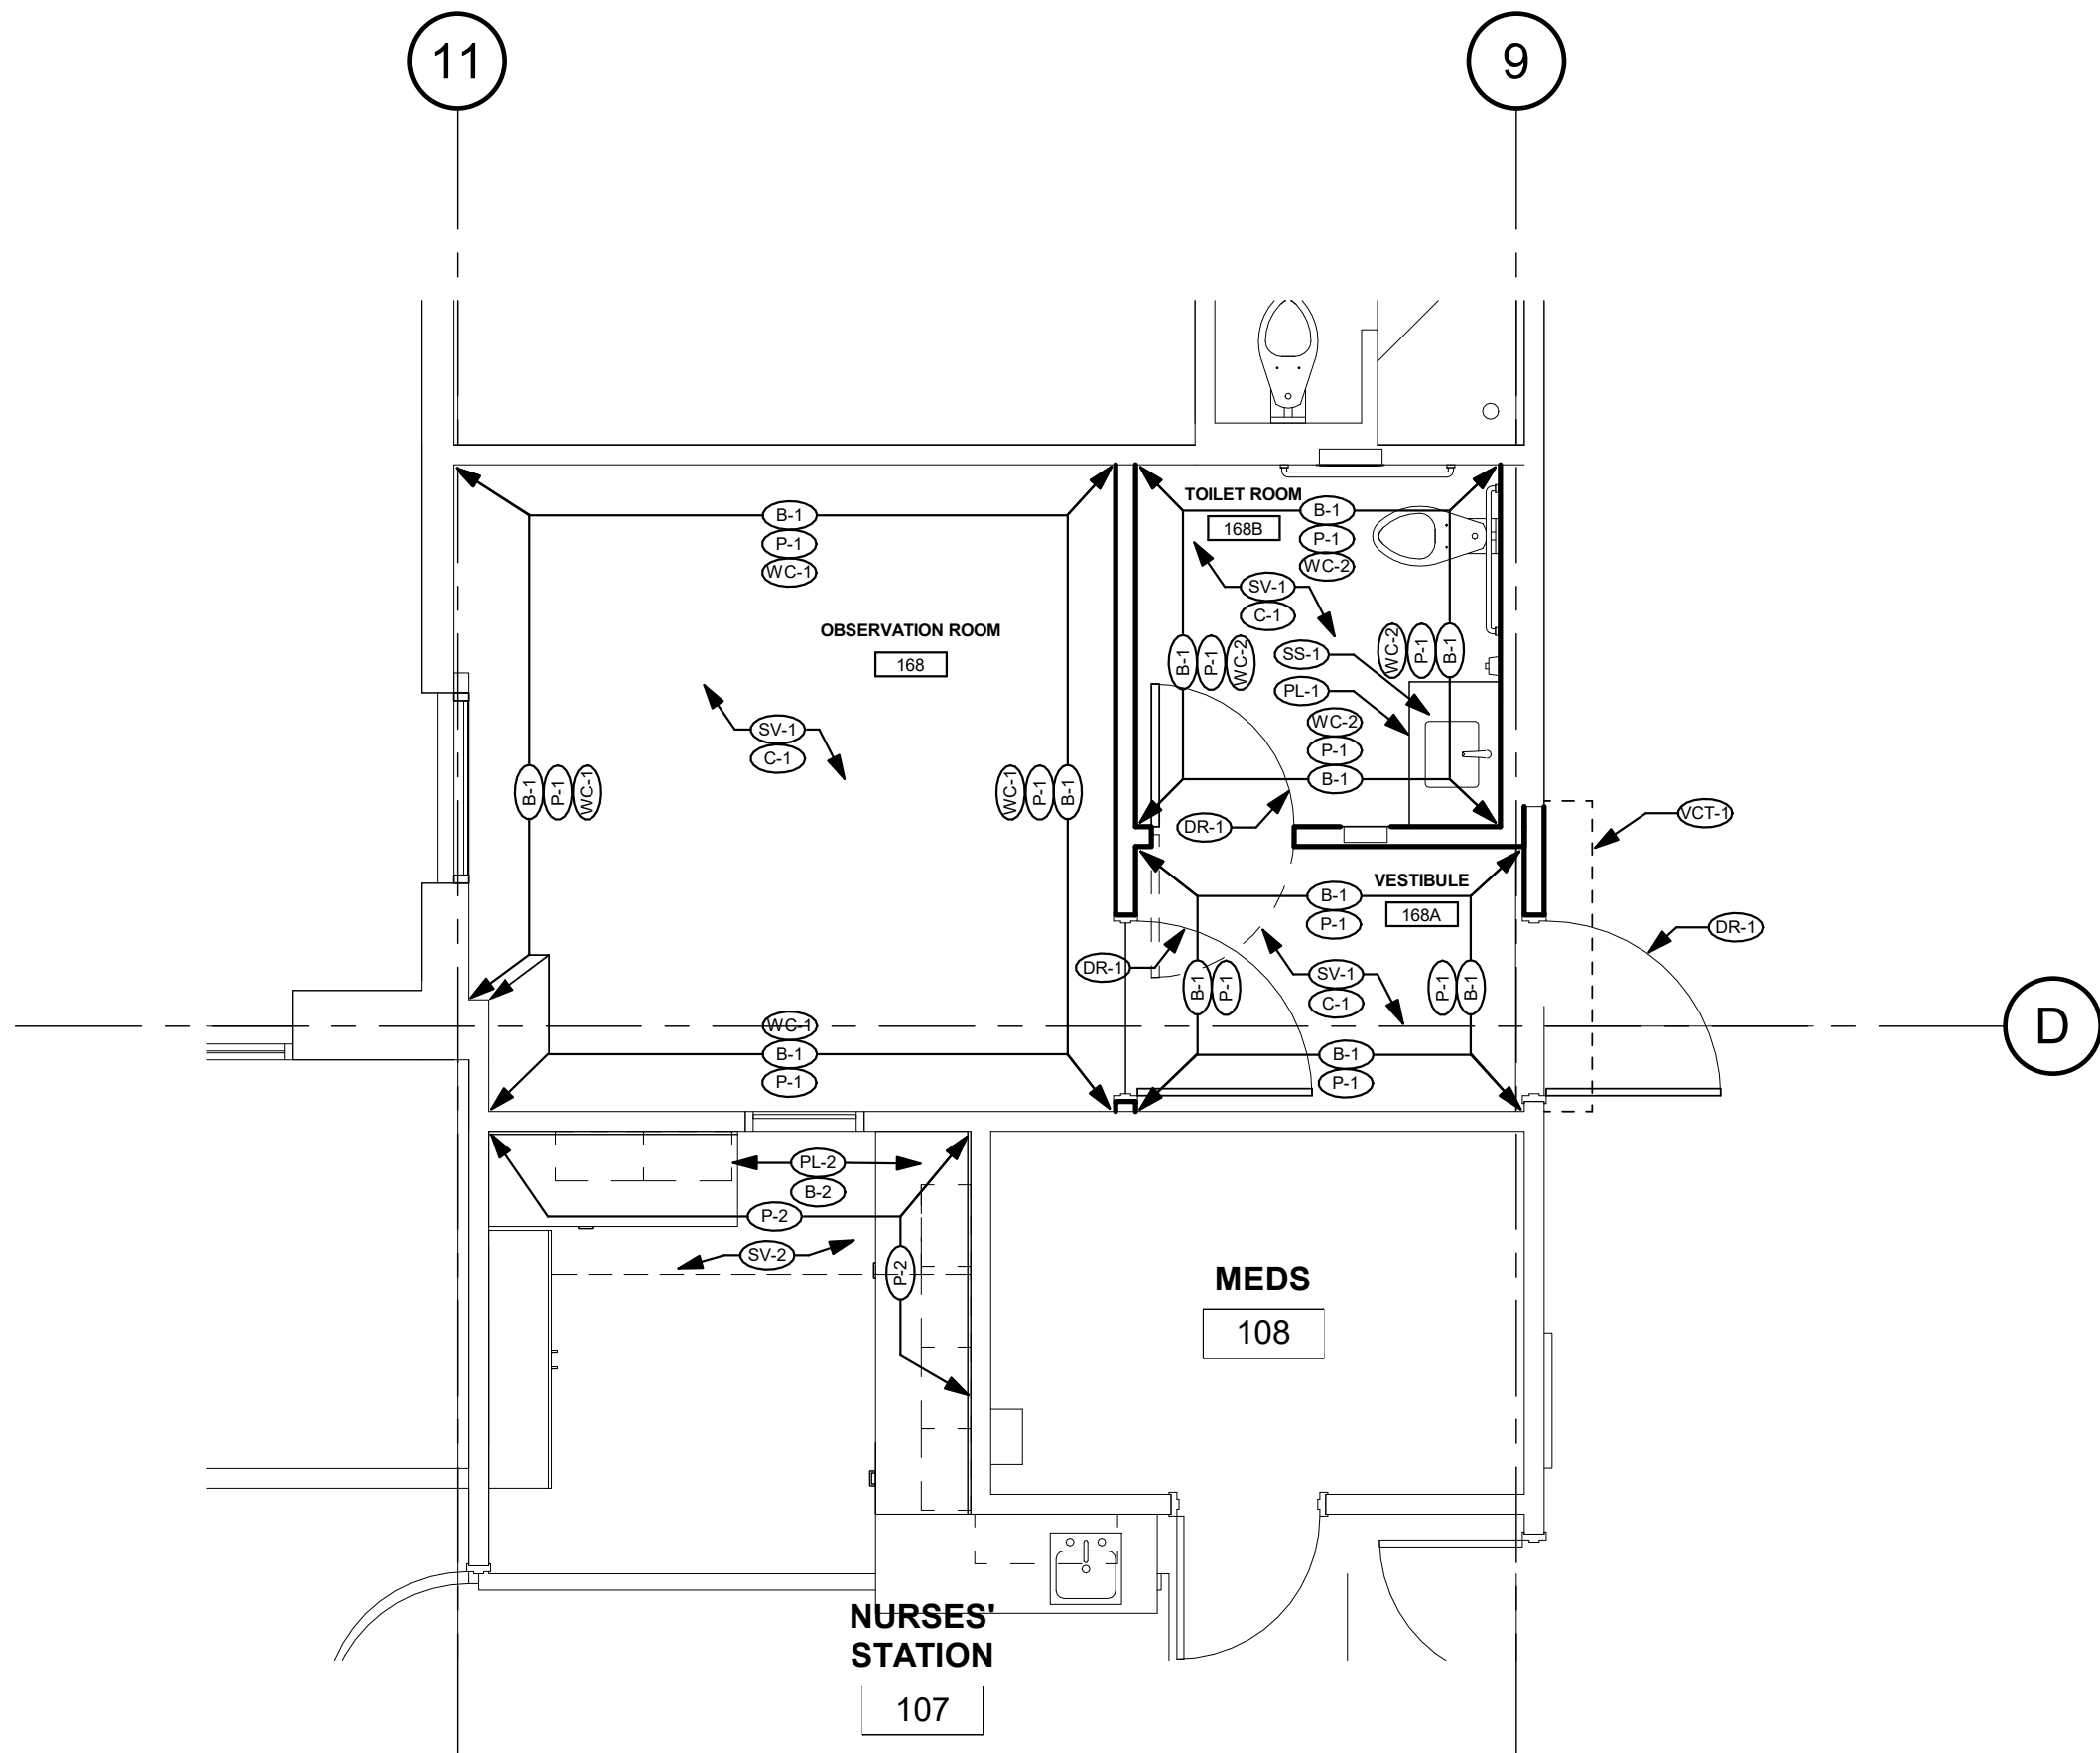

GENERAL NOTES:

- THE GENERAL CONTRACTOR SHALL VERIFY ALL EXISTING CONDITIONS AND MEASUREMENTS IN THE FIELD PRIOR TO STARTING CONSTRUCTION.
- REFER TO GENERAL NOTES ON SHEET A0-00 FOR INFORMATION NOT INDICATED ON THIS SHEET.

FINISH PLAN GENERAL NOTES:

- PATCH AND REPAIR FINISHES IN LIKE KIND WHERE AFFECTED BY NEW CONSTRUCTION ON EXISTING BUILDING FINISHES.
- ALL WINDOW COVERING TO BE CENTERED ON STOREFRONT AND INTALL PER MANUFACTURER'S REQUIREMENTS.
- REFER TO ENLARGE FLOOR PLANS FOR CORNER GUARDS, CRASH RAIL AND CHAIRD RAIL LOCATONS.
- REFER TO INTERIOR ELEVATIONS AND SHEET A5-80 FOR ALL CASEWORK FINISHES.
- CONTRACTOR SHALL SUBMIT SIX (6) COPIES OF MANUFACTURER'S SPECIFICATIONS AND INSTALLATION INSTRUCTIONS FOR ALL FLOORING, CEMENT LEVELING AND PATCHING MATERIALS. PERFORM STRICTLY IN ACCORDANCE WITH MANUFACTURER'S SPECIFICATIONS. PROVIDE MAINTENANCE INFORMATION TO THE FACILITIES MAINTENANCE DEPARTMENT.
- PATCH AND REPAIR EXISTING SUB FLOOR SLAB AS REQUIRED TO PROVIDE A SMOOTH SURFACE FOR NEW FLOORING PER MANUFACTURER'S INSTALLATION REQUIREMENTS. PROVIDE SELF-LEVELING UNDERLAYMENT CONCRETE.
- FLOORING PREPARATION SHALL BE PERFORMED AS REQUIRED BY THE FLOOR FINISH MANUFACTURER IN A MANNER SUCH THAT THE MANUFACTURER'S PRODUCT WARRANTY WILL REMAIN IN EFFECT. IF FIELD CONDITIONS REQUIRE VARIATIONS FROM MANUFACTURER'S REQUIREMENTS, THE CONTRACTOR SHALL NOTIFY THE FACILITIES MANAGER IN WRITING DTO RECEIVE INSTRUCTIONS ON HOW TO PROCEED.
- ALL ADHESIVES FOR FINISH MATERIALS SHALL HAVE LOW VOC EMISSIONS. CONTRACTOR SHALL PROVIDE DIRECT VENTILATION TO PREVENT VOC'S OUT GASSING FROM ADHESIVES FROM ENTERING THE BUILDING HVAC SYSTEM AND AFFECTING THE OCCUPANTS OF THE BUILDING.
- CONTRACTOR TO PROVIDE TRANSITIONS BETWEEN FLOORING MATERIALS PER DETAILS ON SHEET A5-90. ALL TRANSITIONS LOCATED UNDER DOORS, TO BE CENTERED UNDER DOOR.
- DOOR SWING: CONTRACTOR SHALL INSTALL ALL NEW FLOORING SUCH THAT IT DOES NOT INTERFERE WITH EXISTING DOORS AND SUCH A WAY THAT EXISTING DOORS DO NOT TOUCH THE SURFACE OF NEW FLOORING. ANY PROBLEMATIC DOORS SHALL BE BROUGHT TO THE ATTENTION FO THE FACILITIES CONSTRUCTION REPRESENTATIVE PRIOR TO FLOORING PREPARATION.
- PERFORM CALCIUM CHLORIDE TEST FOR ALL SLAB SUBFLOORS WHERE SLAB IS NEW, OR ALL EXISTING SLAB ON GRADE LOCATIONS. WHERE EXISTING SLAB IS ABOVE GRADE, CONTRACTOR MAY LIMIT TESTING TO AREAS NEAR A SOURCE OF WATER SUCH AS AROUND PLUMBING LINES, SHOWER STALLS, ROOF DRAINS, ETC. WHERE MOISTURE IN THE SLAB EXCEEDS FINISH MATERIAL'S MANUFACTURER'S RECOMMENDATIONS, REFER TO NOTES ABOVE FOR MANUFACTURER'S WARRANTY REQUIREMENTS.
- CONTRACTOR TO INCLUDE ALLOWANCE FOR CONCRETE SLAB SEALER TO BE FURNISHED AND APPLIED UNDER ALL FLOOR FINISHES ON SLAB ON GRADE.
- CONTRACTOR SHALL VERIFY LEAD TIMES FOR ALL FINISH MATERIALS AND SHALL BE RESPONSIBLE TO HAVE ALL MATERIALS ON THE JOB SITE ON TIME. NO SUBSTITUTIONS SHALL BE MADE DUE TO LATE ORDERING OF MATERIALS.
- CONTINUE ALL FLOOR FINISHES UNDER ALL APPLIANCES AND REMOVABLE CABINETS AND EQUIPMENT.
- PAINT FINISHES (SHEEN) AS FOLLOWS:
WALLS: EGGSHELL SHEEN
EXCEPTIONS SEMI GLOSS SHEEN AT: TOILETS PUBLIC AND LABS, FOOD SERVICE AREAS, TRASH AND UTILITY ROOMS.
PAINTED DOORS & FRAMES: SEMI GLOSS
CEILING AND SOFFITS: FLAT
NOTE: REFER TO INTERIOR ELEVATIONS WHERE FOR LOCATIONS WHERE EPOXY PAINT IS REQUIRED.
- SUBMIT ALL FINISH SAMPLES TO ARCHITECT FOR APPROVAL, INCLUDING DRAW DOWNS OF ALL PAINT COLORS IN ALL FINISH TYPES AS USED.
- PAINT ALL ACCESS PANELS TO MATCH ADJ. WALL SURFACE.
- PLASTER FINISH SHALL BE LEVEL FOR WHERE A PAINTED FINISH SURFACE IS SHOWN.

RESILIENT FLOORING:

- ALL RESILIENT FLOORING INSTALLATIONS SHALL BE COMPLETED TO THE POINT READY FOR THE FIRST DAY OF USE AND IN AS NEW CONDITION. CLEAN CONSTRUCTION DUST AND DERYB, DAMP MOP AND APPLY A SEALER OR WAXED PER MANUFACTURER'S RECOMMENDATIONS FOR THE PRODUCT. FLOORING CONTRACTOR TO PROVIDE THE PRODUCT SPECIFICATION AND A RECOMMENDED REAPPLICATION TIME FOR THE SEALER OR WAX TO THE FACILITIES MAINTENANCE OFFICE.
- ALL SHEET GOODS OF RESILIENT FLOORING SHALL BE INSTALLED USING HEAT WELD SEAMS, WELDING RODS SHALL MATCH THE COLOR OF THE FLOORING MATERIAL UNLESS OTHERWISE NOTED ON THE FINISH PLAN OR LEGEND.

CASEWORK AND MILL WORK:

- ALL CASEWORK AND MILL WORK TO CONFORM TO THE REQUIREMENTS OF THE LATEST EDITION OF W.I.C. FOR CUSTOM GRADE.
- WOOD SAMPLES PROVIDED TO THE COTNRACTOR ARE FOR COLOR ONLY. CONTRACTOR TO SUBMITT SAMPLES FOR ALL WOOD FINISHES FOR APPROVAL AND VERIFY SHEEN OF FINISH FOR ALL LOCATIONS OF STAINED WOOD FINISH. SUBMITTALS SHALL INCLUDE INFORMATION ON THE SPECIES OF WOOD USED, VENEER MATCHING PROPOSED AND CLEAR FINISH PROPOSED OVER THE STAIN.
- SHOP DRAWINGS SHALL BE SUBMITTED FOR ALL CASEWORK AND MILL WORK.

FLAME SPREAD:

- FLAME SPREAD OF FINISH MATERIALS: WALL, FLOOR AND CEILING SHALL NOT EXCEED THE FLAME SPREAD CLASSIFICATIONS IN CBC TABLE 803.5

S F E I R
A R C H I T E C T S

1350 Columbia Street, Suite 603
San Diego, CA 92101

P: 619-299-3917
F: 619-299-5084
www.sfeirarch.com

TCMC
OBSERVATION
ROOM


TRI-CITY MEDICAL
CENTER
4002 VISTA WAY
OCEANSIDE, CALIFORNIA
92056

OWNER: TRI-CITY MEDICAL CENTER
4002 VISTA WAY
OCEANSIDE, CALIFORNIA 92056
TEL(760)724-8411

ARCHITECT: SFEIR ARCHITECTS
1350 COLUMBIA STREET, SUITE 603
SAN DIEGO, CALIFORNIA 92101
TEL(619)299-3917 FAX(619)299-5084

STRUCTURAL: SUN STRUCTURAL ENGINEERING, INC.
2091 LAS PALMAS DRIVE, SUITE D
CARLSBAD, CALIFORNIA 92011
TEL(760)438-1188

ME&P: P2S
9665 CHESAPEAKE, SUITE 230
SAN DIEGO, CALIFORNIA 92123
TEL(619)618-2347

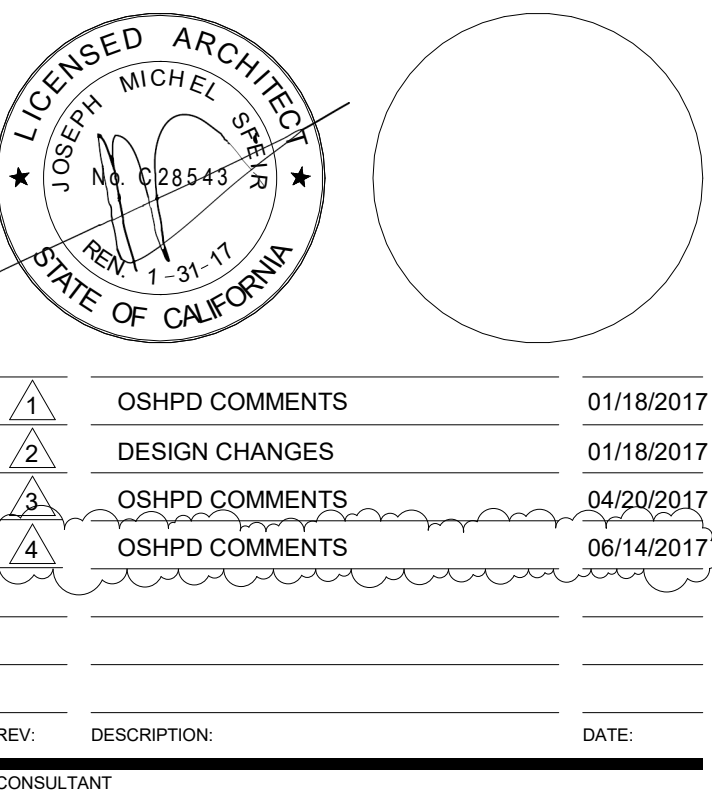

OSHPD APPROVAL STAMP:
OSHPD #: S162581-37-00



07/06/2017 10:49:54 AM
#S162581-37-00

SHEET TITLE:
1/4" PARTIAL FINISHES
FIRST

PROJECT TITLE:
TCMC OBSERVATION ROOM

PROJECT #:
01643.00
DRAWN BY:
Author
CHECKED BY:
Checker
SCALE:
As indicated
DATE:
10/11/16

ID-1