MEP:

P2S

9665 Chesapeake, suite 230 San Diego, CA 92123 P: 619-618-2347

TCMC PHARMACY USP 800 UPGRADE

TRI-CITY MEDICAL CENTER

4002 VISTA WAY OCEANSIDE, CALIFORNIA 92056

CONSTRUCTION DOCUMENTS: 07/27/2017

 \wedge OSHPD COMMENTS: 10/09/2017

<u>/2</u> DESIGN CHANGES: 10/09/2017 $\sqrt{3}$

OSHPD COMMENTS: 12/11/2017

 \land DESIGN CHANGES: 12/11/2017

<u></u> OSHPD COMMENTS: 05/15/2018

DESIGN CHANGES: 06/05/2018


ARCHITECTURE:

R S F ARCHITECTS

5151 Shoreham Pl., Suite 100 San Diego, CA 92122

P: 619-299-3917 F: 619-299-5084 www.sfeirarch.com

6

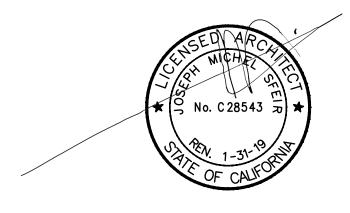


OSHPD PROJECT NUMBER: S171641-37-00

STRUCTURAL:

SUN Structural Engineering, Inc.

2091 Las Palmas Dr., Ste. D Carlsbad, California 92011 760–438–1188 Fax: 760–438–1188

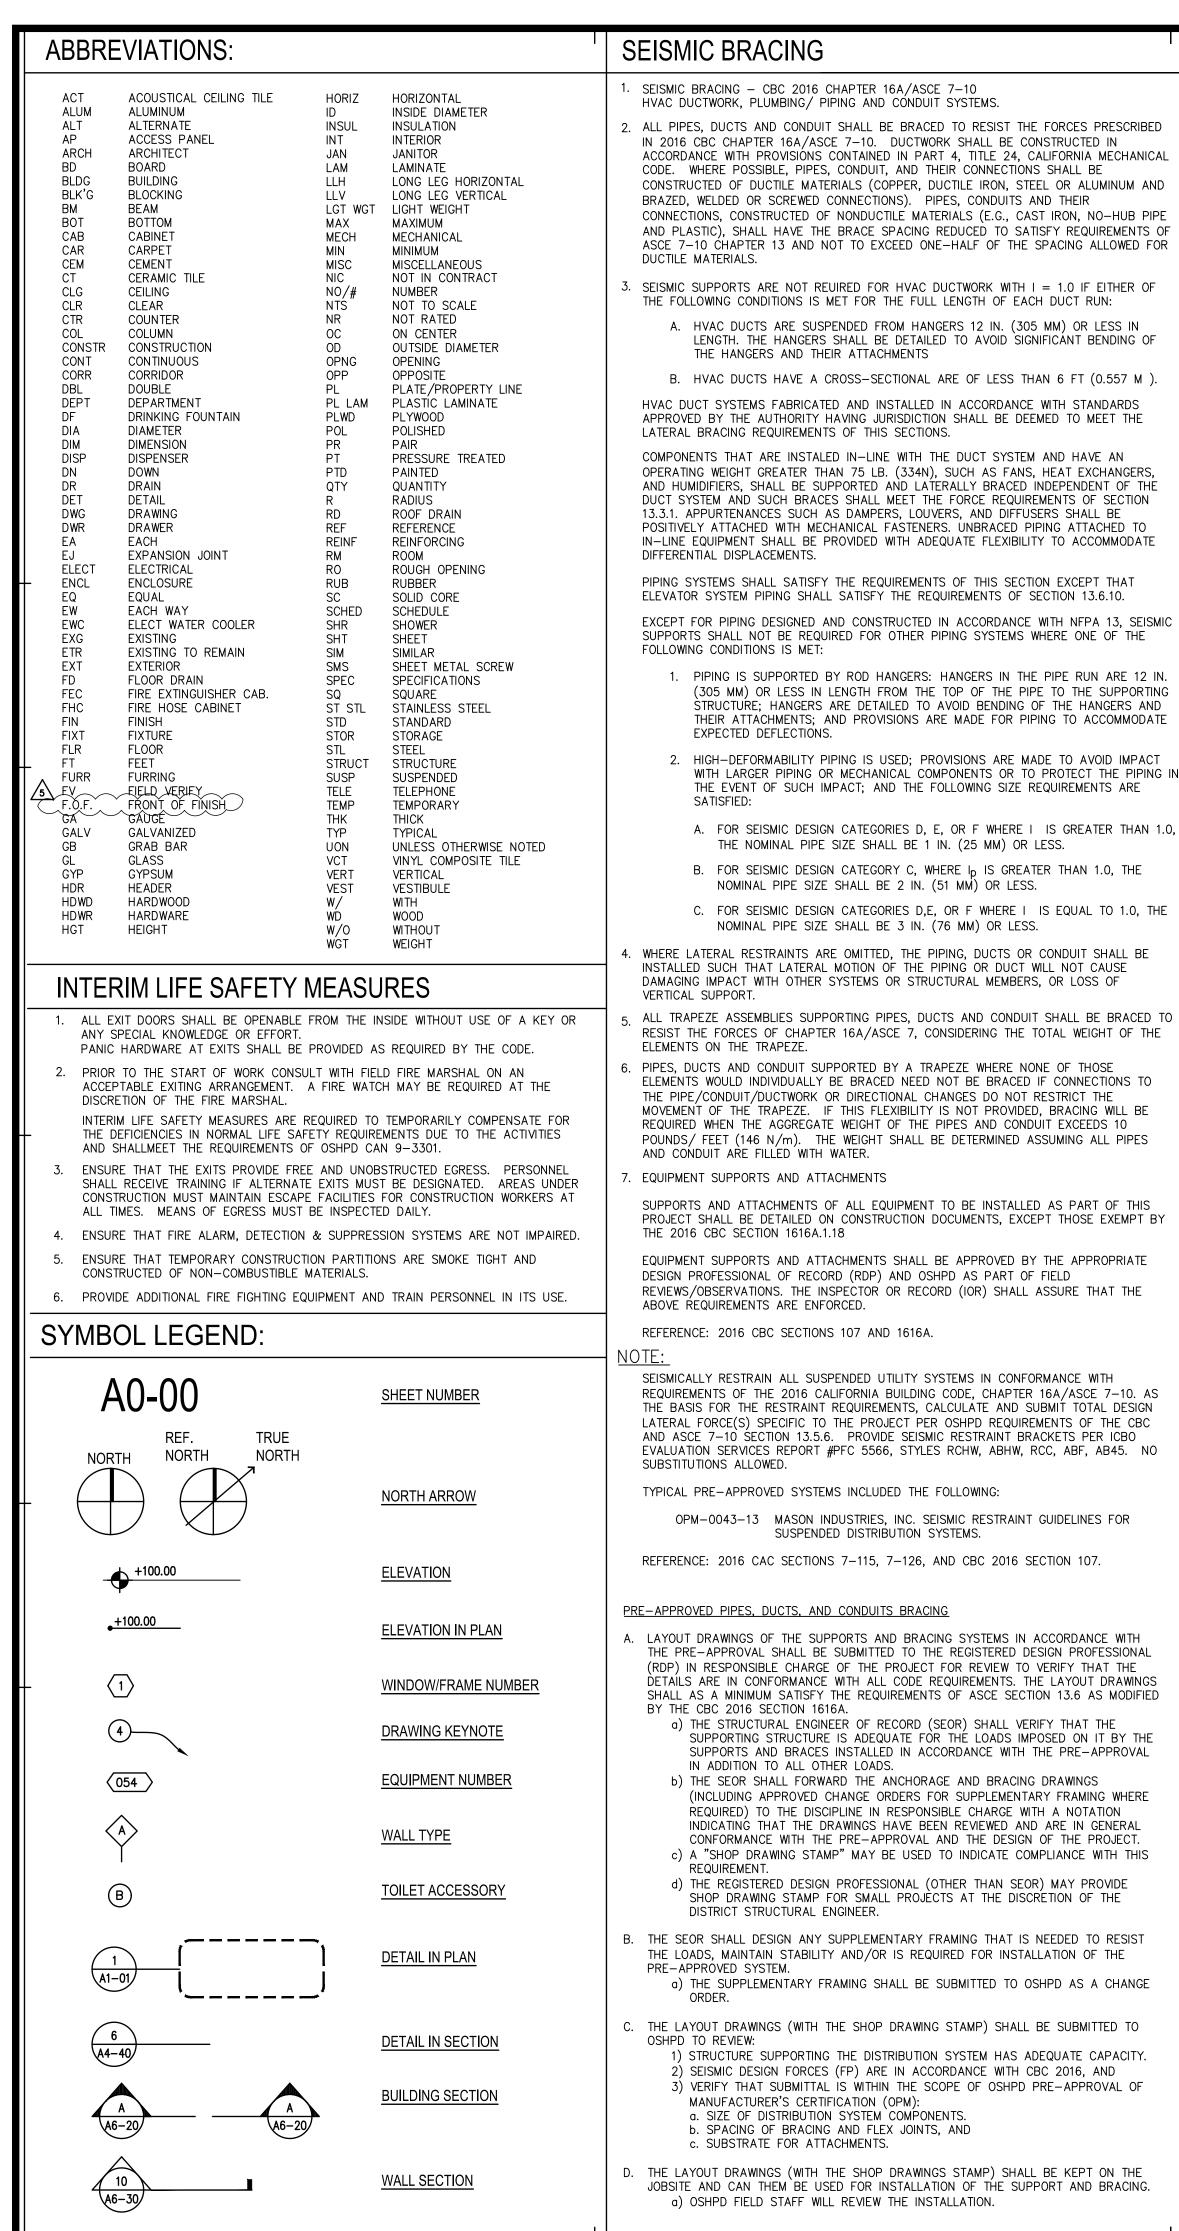


BE ON THE JOBSITE PRIOR TO STARTING THE INSTALLATION OF HANGERS AND/OR BRACES a) IT IS THE CONTRACTOR'S RESPONSIBILITY TO OBTAIN COPIES OF OPM AND FURNISH THE IOR WITH ONE COPY OF EACH. F. COMPONENTS OF TWO OR MORE PRE-APPROVED BRACING SYSTEMS SHALL NOT BE MIXED. a) ONLY ONE PRE-APPROVED BRACING SYSTEM MAY BE USED FOR A RUN OF PIPE, DUCT OR CONDUIT. b) ANY SUBSTITUTION OF COMPONENT OF A PRE-APPROVED BRACING SYSTEM SHALL REQUIRE OSHPD REVIEW AND APPROVAL. REFERENCE: 2016 CAC SECTIONS 7-115, 7-126, 7-153, AND CBC 2016 SECTION 107. REQUIREMENTS FOR ACCESSIBILITY STANDARDS IN ADDITION TO ALL LOCAL REQUIREMENTS AND THE AMERICANS WITH DISABILITIES ACT DRAWINGS (ADA), ACCESSIBLE FEATURES SHALL COMPLY WITH THE STATE OF CALIFORNIA ADMINISTRATIVE CODE OF REGULATIONS, BUILDING CODE, TITLE 24, PART 2 . DURING ALL HOURS THE BUILDING IS OPEN TO THE PUBLIC, ALL PRIMARY ENTRANCES TO THE BUILDING. THE PRIMARY PATH OF TRAVEL FROM THE ENTRANCES TO ALL PORTIONS OF THE BUILDING INCLUDING SANITARY FACILITIES, DRINKING FOUNTAINS AND PUBLIC TELEPHONES SERVING THE BUILDING MUST BE ACCESSIBLE TO THE DISARI FD ALL BUILDING ENTRANCES SHALL BE IDENTIFIED WITH AT LEAST ONE STANDARD SIGN AND WITH ADDITIONAL DIRECTIONAL SIGNS, AS REQUIRED, TO BE VISIBLE TO PERSONS ALONG APPROACHING PEDESTRIAN WAYS. SUBCONTRACTORS HAND-ACTIVATED DOOR OPENING HARDWARE SHALL BE 34" MIN. AND 44 INCHES MAX. ABOVE THE FINISH FLOOR OR GROUND. LATCHING AND LOCKING DOORS THAT ARE HAND-ACTIVATED AND WHICH ARE IN A PATH OF TRAVEL SHALL BE OPERABLE WITH A SINGLE EFFORT BY LEVER-TYPE HARDWARE, PANIC BARS, PUSH-PULL ACTIVATING BARS OR OTHER HARDWARE DESIGNED TO PROVIDE PASSAGE WITHOUT REQUIRING THE ABILITY TO GRASP THE OPENING HARDWARE. LOCKED EXIT DOORS SHALL OPERATE AS ABOVE IN EGRESS DIRECTION. (CBC SECTION 11B-404.2.7) MAXIMUM EFFORT TO OPERATE DOORS SHALL NOT EXCEED 5 POUNDS FOR EXTERIOR DOORS AND 5 POUNDS FOR INTERIOR DOORS, SUCH PULL OR PUSH EFFORT BEING APPLIED AT RIGHT ANGLES TO HINGED DOORS AND AT THE CENTER PLANE OF SLIDING OR FOLDING DOORS. COMPENSATING DEVICES OR AUTOMATIC DOOR ASSEMBLY. OPERATORS MAY BE UTILIZED TO MEET THE ABOVE STANDARDS. WHEN FIRE DOORS ARE REQUIRED. THE MAXIMUM EFFORT TO OPERATE THE DOOR MAY BE INCREASED TO THE MINIMUM ALLOWABLE BY THE APPROPRIATE ADMINISTRATIVE AUTHORITY, NOT TO EXCEED 15 POUNDS. (CBC SECTION 11B-404.2.9) THE BOTTOM 10 INCHES OF ALL DOORS EXCEPT AUTOMATIC AND SLIDING SHALL HAVE A SMOOTH. UNINTERRUPTED SURFACE TO ALLOW THE DOOR TO BE OPENED BY A WHEELCHAIR FOOTREST WITHOUT CREATING A TRAP OR HAZARDOUS CONDITION. WHERE NARROW FRAME DOORS ARE USED, A 10-INCH HIGH SMOOTH PANEL SHALL BE INSTALLED ON THE PUSH SIDE OF THE DOOR, WHICH WILL ALLOW THE DOOR TO BE OPENED BY A WHEELCHAIR FOOTREST WITHOUT CREATING A TRAP OR HAZARDOUS CONDITION. (CBC SECTION 11b-404.2.10) FOR HINGED DOORS, THE OPENING WIDTH SHALL BE MEASURED WITH THE DOOR POSITIONED AT AN ANGLE OF 90 DEGREES FROM ITS CLOSED POSITION. AT LEAST ONE OF A PAIR OF DOORS SHALL MEET THIS OPENING WIDTH REQUIREMENT. (CBC SECTION 11B-404.2.2 & 11B-404.2.3) MANUALLY OPERATED EDGE OR SURFACE MOUNTED FLUSH BOLTS ARE NOT ALLOWED. WHEN EXIT DOORS ARE USED IN PAIRS AND APPROVED FLUSH BOITS ARE USED. THE DOOR LEAF HAVING THE AUTOMATIC FLUSH BOLTS CONSTRUCTION. SHALL HAVE NO DOOR KNOB OR SURFACE-MOUNTED HARDWARE. THE UNLATCHING OF ANY LEAF SHALL NOT REQUIRE MORE THAN ONE OPERATION. THERE SHALL BE A LEVEL AND CLEAR FLOOR OR LANDING ON EACH SIDE OF A DOOR. THE LEVEL AREA SHALL HAVE A LENGTH IN THE DIRECTION OF DOOR SWING OF A LEAST 60 INCHES AND THE LENGTH OPPOSITE THE DIRECTION OF THE DOOR SWING OF 48 INCHES AS MEASURED AT RIGHT ANGLES TO THE PLANE OF THE DOOR IN ITS CLOSED POSITION. THE WIDTH OF THE LEVEL AREA ON THE SIDE TO WHICH THE DOOR SWINGS SHALL EXTEND 24 INCHES PAST THE STRIKE EDGE OF THE DOOR FOR EXTERIOR DOORS AND 18 INCHES PAST THE STRIKE EDGE FOR INTERIOR DOORS. THE WIDTH OF THE AREA ON THE SIDE OPPOSITE THE SWING SHALL EXTEND 12 INCHES PAST THE STRIKE EDGE OF THE DOOR WHEN THE DOOR IS EQUIPPED WITH BOTH A CLOSER AND A LATCHSET. ABRUPT CHANGES IN LEVEL ALONG ANY ACCESSIBLE ROUTE SHALL NOT EXCEED 1/2 INCH. WHEN CHANGES IN LEVEL DO OCCUR, THEY SHALL BE BEVELED WITH A SLOPE NO GREATER THAN 1:2 EXCEPT THAT LEVEL CHANGES NOT EXCEEDING 1/4 INCH MAY BE VERTICAL. WHEN CHANGES IN LEVELS GREATER THAN 1/2 INCH ARE NECESSARY THEY SHALL COMPLY WITH THE REQUIREMENTS. 12. FOR RAMPS. MINIMUM WIDTH SHALL BE 48". 13. SIDE REACH MOUNTING HEIGHTS: IF THE CLEAR FLOOR SPACE ALLOWS PARALLEL APPROACH BY A PERSON IN A WHEELCHAIR, THE MAXIMUM HEIGHT FOR HIGH SIDE REACH SHALL BE 44 INCHES AND THE LOW SIDE REACH SHALL BE 15 INCHES ABOVE THE FINISHED FLOOR. 14. FORWARD REACH MOUNTING HEIGHTS: IF THE CLEAR SPACE ONLY ALLOWS FORWARD APPROACH BY A PERSON IN A WHEELCHAIR, THE MAXIMUM HEIGHT FOR HIGH SIDE REACH SHALL BE 48 INCHES AND THE LOW SIDE REACH SHALL BE 15 INCHES ABOVE THE FINISHED FLOOR. 15. DOORS LEADING TO MEN'S SANITARY FACILITIES SHALL BE IDENTIFIED BY AN EQUILATERAL TRIANGLE 1/4" THICK, WITH EDGES 12" LONG AND A VERTEX POINTING UPWARD. WOMEN'S SANITARY FACILITIES SHALL BE IDENTIFIED BY A CIRCLE 1/4" THICK AND 12" IN DIAMETER. 16. UNISEX SANITARY FACILITIES SHALL BE IDENTIFIED BY A CIRCLE 1/4" THICK, 12" DIAMETER, WITH A 1/4" THICK TRIANGLE SUPERIMPOSED ON THE CIRCLE AND WITHIN THE 12" DIAMETER.

E. A COPY OF THE CHOSEN BRACING SYSTEM(S) INSTALLATION GUIDE/OPM MANUAL SHALL

- 17. GEOMETRIC (CIRCLE AND TRIANGLE) SYMBOLS SHALL BE CENTERED ON THE DOOR AT A HEIGHT OF 60" ABOVE FINISHED FLOOR AND THEIR COLOR AND CONTRAST SHALL BE DISTINCTLY DIFFERENT FROM THE COLOR AND CONTRAST OF THE DOOR.
- 18. ADDITIONAL SIGNAGE REQUIREMENTS: RAISED LETTERS SHALL BE PROVIDED AND SHALL BE ACCOMPANIED BY BRAILLE IN CONFORMANCE WITH SECTION 11B-703. THEY SHALL BE INSTALLED ON THE WALL ADJACENT TO THE LATCH OUTSIDE OF THE DOOR. WHERE THERE IS NO WALL SPACE ON THE LATCH SIDE, INCLUDING DOUBLE LEAF DOORS, SIGNS SHALL BE PLACED ON THE NEAREST ADJACENT WALL AND SIGNS SHALL BE MOUNTED 48" MINIMUM ABOVE FINISH FLOOR, MEASURED FROM THE BASELINE OF THE LOWEST LINE OF BRAILLE AND 60" MAXIMUM ABOVE THE FINISH FLOOR, MEASURED FROM THE BASELINE OF THE HIGHEST LINE OF RAISED CHARACTERS. CBC 11B-703.4.1

VICINITY MAP:

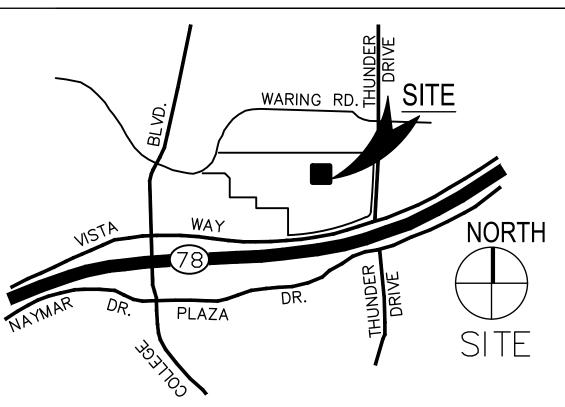

GENERAL NOTES

- THE GENERAL CONTRACTOR IS RESPONSIBLE FOR CHECKING CONTRACT DOCUMENTS FIELD CONDITIONS AND DIMENSIONS FOR ACCURACY, AND CONFIRMING THAT WORK BUILDABLE AS SHOWN BEFORE PROCEEDING WITH CONSTRUCTION. IF THERE ARE AN QUESTIONS REGARDING THESE OR OTHER COORDINATION ISSUES, THE GENERAL CONTRACTOR IS RESPONSIBLE FOR OBTAINING A CLARIFICATION FROM THE OWNERS REPRESENTATIVE BEFORE PROCEEDING WITH WORK IN QUESTION OR RELATED WORK.
- THE GENERAL CONTRACTOR SHALL INFORM THE OWNERS' REPRESENTATIVE, PRIOR TO CONSTRUCTION, OF ANY CONFLICTS THAT EXIST IN ANY AND ALL MECHANICAL, TELEPHONE, ELECTRICAL, LIGHTING, PLUMBING AND SPRINKLER EQUIPMENT LOCATION INCLUDING ALL PIPING, DUCTWORK AND CONDUIT, AND INSURE THAT ALL REQUIRED CLEARANCES FOR INSTALLATION AND MAINTENANCE ARE PROVIDED.
- THE GENERAL CONTRACTOR SHALL BE RESPONSIBLE FOR PROVIDING ALL WORK AND MATERIALS IN ACCORDANCE WITH ALL CODES AND REQUIREMENTS OF STATE AND LOCAL REGULATORY AGENCIES.
- ALL WORK NOT SPECIFICALLY COVERED IN THE CONTRACT DOCUMENTS SHALL BE FURNISHED AND INSTALLED IN ACCORDANCE WITH CONSTRUCTION INDUSTRY
- DRAWINGS, THOUGH NOTED TO SCALE, ARE DIAGRAMMATICAL. DO NOT SCALE
- ALL HEIGHTS ARE DIMENSIONED FROM TOP OF SLAB UNLESS OTHERWISE NOTED.
- THE GENERAL CONTRACTOR SHALL BE RESPONSIBLE FOR DOCUMENTING ALL CHANGES TO THE CONSTRUCTION DOCUMENTS, NO MATTER HOW MINOR, FOR AS-BUILT RECORD DOCUMENTS. THESE DOCUMENTS ARE TO BE GIVEN TO THE OWNERS' REPRESENTATIVE WITHIN 2 WEEKS AFTER FINAL COMPLETION.
- THE GENERAL CONTRACTOR SHALL BE RESPONSIBLE FOR COORDINATING ALL UTILITIES INDICATED ON THE INTERIOR ELEVATIONS WITH THE ELECTRICAL AND PLUMBING
- 9. IN THE CASE OF CONFLICTS OR AMBIGUITIES NOT CLARIFIED PRIOR TO THE BIDDING DEADLINE, USE THE MOST COSTLY ALTERNATIVE (BETTER QUALITY, GREATER QUANTITY AND LARGER SIZE) IN PREPARING THE BID.
- 10. ALL PENETRATIONS THROUGH FIRE RESISTIVE PARTITION AND SLAB, INCLUDING CONDUITS AND PIPING, SHALL BE CONSTRUCTED TO MEET APPROVED U.L. SYSTEM.
- ALL PENETRATIONS INTO SOUND RATED PARTITIONS, INSULATED PARTITIONS OR CEILING ASSEMBLIES SHALL BE SEALED WITH APPROVED PERMANENT RESILIENT SEALANT. OR OTHERWISE TREATED TO MAINTAIN INTEGRITY OF THE ACOUSTICAL
- CONTRACTOR TO PREVENT GALVANIC ACTION AND OTHER FORMS OF CORROSION BY INSULATING METALS AND OTHER MATERIALS FROM DIRECT CONTACT WITH INCOMPATIBLE MATERIALS.
- THE CONTRACTOR SHALL PERFORM ALL CUTTING, PATCHING, AND FINISHING NECESSARY TO RESTORE THE ORIGINAL CONDITION OF THE BUILDING TO ALL EXISTING PORTIONS OF THE BUILDING AFFECTED BY HIS WORK, TO THE SATISFACTION OF THE OWNER'S REPRESENTATIVE.
- WHEN INSTALLING DRILLED-IN ANCHORS AND OR POWDER DRIVEN PINS IN EXISTING NON-PRESTRESSED REINFORCED CONCRETE, USE CARE AND CAUTION TO AVOID CUTTING OR DAMAGING THE EXISTING REINFORCING STEEL MAINTAIN A MINIMUM CLEARANCE OF ONE INCH BETWEEN THE REINFORCEMENT STEEL AND THE DRILLED-IN ANCHOR AND OR PIN.
- 15. THE CONTRACTOR SHALL COORDINATE ALL PHASING, ACCESS, DEBRIS, STAGING AREAS, AND HOURS OF CONSTRUCTION WITH OWNERS PRIOR TO START OF
- CONTRACTOR TO PROVIDE REQUIRED DUST AND INFECTION CONTROL PROTECTION SYSTEM. MEANS AND METHODS TO BE COORDINATED WITH OWNER.
- THE CONTRACTOR SHALL BE RESPONSIBLE FOR THE SECURITY OF THE AREA OF THE PROJECT WORK AND SHALL ALSO BE RESPONSIBLE FOR THE DISCIPLINE OF ALL CONSTRUCTION WORKERS ON THE PROJECT.
- THE GENERAL CONTRACTOR SHALL COORDINATE WITH STRUCTURAL, MEP, FIRE ALARM FIRE PROTECTION, NURSE CALL, INTERIORS AND EQUIPMENT DRAWINGS PRIOR TO STARTING CONSTRUCTION. THE PROJECT MANUAL AND ALL DRAWINGS IN THE CONSTRUCTION DRAWINGS SHALL BE PART OF THE CONSTRUCTION DOCUMENTS
- 19. THE GENERAL CONTRACTOR SHALL SEPARATE DISSIMILAR METALS WITH BUILDING PAPER OR PLASTIC SHIM.
- THE GENERAL CONTRACTOR SHALL X-RAY AND/OR ULTRASOUND THE EXISTING CONCRETE FLOORS AND STRUCTURAL SLAB FOR ANY POSSIBLE EMBEDDED CONDUITS, STRUCTURAL REBAR UNFORESEEN CONDITION THAT IS OUTSIDE THE SCOPE OF WORK AND MIGHT IMPEDE THE ANCHORING OF EQUIPMENT OR CONFLICT WITH TRENCHING PRIOR TO CONSTRUCTION.
- CONTRACTOR STAGING TO BE IN THE ROOMS UNDER REMODEL.
- 22. CONTRACTOR PARKING TO BE IN CONTRACTOR DESIGNATED PARKING AREA.
- THE CONTRACTOR SHALL ENSURE THAT THE AREA UNDER REMODEL IS LOCKED AND OTHERWISE SECURED AFTER HOURS.
- 24. THE GENERAL CONTRACTOR IS RESPONSIBLE TO CUT & PATCH TO MATCH ALL EXISTING PARTITIONS WHERE NEW FIRE ALARM AND ELECTRICAL DEVICES ARE REQUIRED AS SPECIFIED IN THE FIRE ALARM DRAWINGS.
- CONTRACTOR SHALL FURNISH AND APPLY CRETESEAL 2000 CONCRETE SEALER OR APPROVED EQUAL ON SLAB ON GRADE.

PROJECT INFORMATION:

SCOPE OF WORK:

UPGRADE AND REMODEL OF THE EXISTING INPATIENT PHARMACY TO UNITED STATES PHARMACOPEIA CHAPTER 800. THE FULL EXTENT OF WORK IS INDICATED IN THE CONSTRUCTION DOCUMENTS PREPARED BY SFEIR ARCHITECTS.

BUILDING DESCRIPTION:

NUMBER OF STORIES: 1 STORY + 1 BASEMENT OCCUPANCY GROUP: I-2 (NO CHAMGE IN EXISTING OCCUPANCY LOAD) TYPE OF CONSTRUCTION: I-A FIRE SPRINKLERS: ENTIRE BUILDING

CONSTRUCTION CLASSIFICATION:

SEISMIC ZONE 4 3HR STRUCTURAL FRAME. 2HR FLOOR-CEILING/ROOF 1 1/2 HR ROOF

AREA OF REMODEL

ANTE ROOM = 339 SQ. FT. BSC ROOM = 94 SQ. FT. IV PREP. ROOM = 139 SQ. FT. TOTAL COMBINED AREA = 572 SQ. FT.

Ι	INDEX O	F DRAWINGS:
		COVER SHEET
Y	ARCHITECTU	RAL:
	A0-00	
	A1-00	SITE ACCESSIBILITY AND EGRESS PATH OF TRAVEL
		CODE COMPLIANCE FIRST FLOOR PLAN
		PHARMACY FLOOR PLAN
	A1-04	ADA CODE COMPLIANCE DETAILS
		PHASING PLAN
	A4-01 A4-10	DEMOLITION FLOOR PLAN NEW FLOOR PLAN
		DEMOLITION REFLECTED CEILING PLAN
	A4-30	REFLECTED CEILING PLAN
		INTERIOR ELEVATIONS
		INTERIOR ELEVATIONS FIRE RATED ASSEMBLIES
		TYPICAL RATED PARTITION ASSEMBLIES
6		ROOF PLAN
	A5-60	GYPSUM CEILING DETAILS
6		LAY IN CEILING DETAILS
>	A5-80 A6-00	MILLWORK DETAILS DOOR AND INTERIOR OPENINGS SCHEDULE
	A6-20	PROPOSED EQUIPMENT FLOOR PLAN
	ID-1	NEW FINISHES PLAN
	ID-2	FINISHES, NOTES & DETAILS
	STRUCTURAL	<u>.</u>
	S-1	- GENERAL NOTES TYPICAL DETAILS
	S-2	PARTIAL FLOOR PLAN, PARTIAL PENTHOUSE ROOF PLAN
	SDI	DETAILS
	SD2	DETAILS
	SD3	DETAILS
	MECHANICAL	
	M0-01	GENERAL NOTES, LEGEND, SYMBOLS, AND SHEET INDEX
;	M0-02	SCHEDULES
	M1-10	ZONING PLAN
	M2-10 M2-11	PARTIAL RENOVATION FIRST FLOOR AND ROOF PLAN PARTIAL RENOVATION HEATING HOT WATER FLOOR PLAN
	M2-11 M5-10	DIAGRAMS
	M6-10	DETAILS
	MD2-10	PARTIAL DEMOLITION FIRST FLOOR AND ROOF PLAN
	MD2-11	PARTIAL DEMOLITION HEATING HOT WATER FLOOR PLAN
	PLUMBING:	
	P0-01	GENERAL NOTES, LEGEND, SYMBOLS, AND SHEET INDEX
	P0-02 P2-10	SCHEDULES AND DETAILS PARTIAL RENOVATION FLOOR PLAN
		PARTIAL DEMOLITION FLOOR PLAN
	ELECTRICAL:	
	E0.1	GENERAL NOTES, LEGEND, SYMBOLS AND SHEET INDEX
	E0.2 ED2.1	PARTIAL SINGLE LINE DIAGRAM, SCHEDULES, & LOAD SUMMARY PARTIAL DEMOLITION FLOOR PLANS
		PARTIAL RENOVATION FLOOR PLANS
	E0.3	PANEL SCHEDULES & LOAD SUMMARIES
	DEFERF	RED APPROVALS
	-FIRE AL	ARM
	-FIRE PR	OTECTION
	-SIGNAGE	
		ABLE CODES AND REGULATIONS:
		CALIFORNIA ADMINISTRATIVE CODE (CAC)
		PART 1, TITLE 24, CCR)
		CALIFORNIA BUILDING CODE (CBC) PART 2, TITLE 24, CCR)
		CALIFORNIA ELECTRICAL CODE (CEC)
		PART 3, TITLE 24, CCR)
	2016 (CALIFORNIA MECHANICAL CODE (CMC)
		PART 4, TITLE 24, CCR)

PPLIC	ABLE CODES AND REGULATIONS:	os i Ot
2016	CALIFORNIA ADMINISTRATIVE CODE (CAC) (PART 1, TITLE 24, CCR)	
2016	CALIFORNIA BUILDING CODE (CBC) (PART 2, TITLE 24, CCR)	
2016	CALIFORNIA ELECTRICAL CODE (CEC) (PART 3, TITLE 24, CCR)	
2016	CALIFORNIA MECHANICAL CODE (CMC) (PART 4, TITLE 24, CCR)	
2016	CALIFORNIA PLUMBING CODE (CPC) (PART 5, TITLE 24, CCR)	SHE
2016	CALIFORNIA FIRE CODE (CFC) (PART 9, TITLE 24, CCR)	
OSHF	PD INTENT STATEMENT	
THE 2016 SHOULD AI THE FINISH AND SPEC	T OF THE DRAWINGS AND SPECIFICATIONS IS TO BUILD IN ACCORDANCE WITH EDITION OF TITLES 24 & 19 OF THE CALIFORNIA CODE OF REGULATIONS. NY CONDITION OCCUR NOT COVERED BY THE CONTRACT DOCUMENTS WHEREIN IED WORK WILL NOT COMPLY WITH SAID CODES, A CHANGE ORDER DETAILING IFYING THE REQUIRED WORK SHALL BE SUBMITTED TO AND APPROVED BY IOR TO PROCEEDING WITH THE WORK.	

OSHPD APPROVAL:

2016

All rights reserved. No part of this work may be reproduced or copied in any form or by any means, graphic, electronic, or mechanical, including photocopying, recording, taping, or information and retrieval systems without written permission of the ARCH

APPLICATION NUMBER: S171641-37-00


5151 Shorehom Place, Suite 100 Son Diego, Ca 92122 P: 619–299–3917 TCCMC PHARMACY USPP 800 UPGRADE Tri-City Medical Center 4002 Vista Way Oceanside, California 92056 OWNER: RI-CITY MEDICAL CENTER 4002 VISTA WAY Oceanside, California 92056 ARCHITECT: SFER ARCHITECTS 5151 Shoreham Place, Suite 100 San DIEGO, CALIFORNIA 92122 TEL(619)299–3917 FAX(519)299–5084 MEP: P2S ENGMEERING, INC. 9665 CHESAPEAKE DRIVE, SUITE 100 SAN DIEGO, CA 92011 TEL(19)291–3917 FAX(519)299–5084 MEP: P2S ENGMEERING, INC. 9665 CHESAPEAKE DRIVE, SUITE 200 SAN DIEGO, CA 92012 TEL(619)294–3917 FAX(519)299–5084 MEP: P2S ENGMEERING, INC. 9665 CHESAPEAKE DRIVE, SUITE 100 CARLSBAD, CA 92011 TEL(19)60438–1188 TEL(19)60438–1188 MORENTE 10-0000 SAN DIEGO, CA 92012 TEL(19)60438–1188 MORENTE 10-0000 MER: 10-0000 SAN DIEGO, CA 92011 TEL(19)60438–1188 MORENTE 10-0000 MER: 10-0000 MER: 20-00000 MER: 20-00000 MER: 20-0000000 MER: 20-00000000 MER: 20-00000000 MER: 20-000000000 MER: 20-00000000000 MER: 20-0000000000000 MER: 20-0000000000000 MER: 20-00000000000000000000000000000000000	San Diego, Ca 92122 2: 619–299–3917 ::::::::::::::::::::::::::::::::::::	S arc	F : н	E I T	ł	ст	R
F: 619–299–5084 www.sfeirarch.com TCMC PHARMACY USP 800 UPGRADE Tri-City Medical Center 4002 Vista Way Oceanside, California 92056 WNER: TRI-CITY MEDICAL CENTER 4002 VISTA WAY OCEANSIDE, CALIFORNIA 92056 ARCHITECT: SFEIR ARCHITECTS 5151 SHOREHAM PLACE, SUITE 100 SAN DIEGO, CALIFORNIA 92039–5084 MEP: P2S5 ENGINEERING, INC. 9665 CHESAFEAKE DRIVE, SUITE 230 SAN DIEGO, CA 92123 TEL(760)438–1188 TEL(760)438–1188 TEL(760)438–1188 DEGOR CHAMES 0-09-17 COMMENTS 0500 COMMENTS 00500 COMMENT	TCMC PHARMACY USP 800 USP 800 UPGRADE Tri-City Medical Cent 4002 Vista Way Oceanside, California 92056 DWNER: TRI-CITY MEDICAL CENTER 4002 Vista Way Oceanside, California 92056 ARCHITECT: SFEIR ARCHITECTS 5151 SHOREHAM PLACE, SUITE 100 SAN DIEGO, CALIFORNIA 92036 ARCHITECT: SFEIR ARCHITECTS 5151 SHOREHAM PLACE, SUITE 100 SAN DIEGO, CA 2123 TEL(619)299-3147 STRUCTURAL: SUN STRUCTURAL ENGINEERING 2091 LAS PALMAS DRIVE, SUITE 230 SAN DIEGO, CA 92011 TEL(760)438-1188 TEL(760)438-1188 TEL(760)438-1188 TEL(760)438-1188 TEL(760)438-118 TEL(760)438-1			Suite 100			
PHARMACY USP 800 UPGRADE Tri-City Medical Cente 4002 Vista Way Oceanside, California 92056 OWNER: TRI-CITY MEDICAL CENTER 4002 Vista Way Oceanside, California 92056 OWNER: TRI-CITY MEDICAL CENTER 4002 Vista Way Oceanside, California 92056 AN DIECO, CALIFORNIA 92056 AN DIECO, CALIFORNIA 92056 AN DIECO, CALIFORNIA 92056 MEP: P2S ENGINEERING, INC. 9665 CALIFORNIA 92122 TEL(619)918-2347 STRUCTURAL: SUN STRUCTURAL ENGINEERING 2091 LSS PALMAS DRIVE, SUITE 230 SAN DIECO, CA 92123 TEL(619)618-2347 STRUCTURAL: SUN STRUCTURAL ENGINEERING 2091 LSS PALMAS DRIVE, SUITE 2 CARLSBAD, CA 92011 TEL(760)438-1188	PHARMACY USP 800 UPGRADE Tri-City Medical Cent 4002 Vista Way Oceanside, California 92056 DWNER: TRI-CITY MEDICAL CENTER 4002 Vista Way Oceanside, California 92056 DWNER: TRI-CITY MEDICAL CENTER 4002 Vista Way Oceanside, California 92056 ARCHITECT: SFEIR ARCHITECTS 5151 SHOREHAM PLACE, SUITE 100 SAN DIEGO, CALIFORNIA 92052 TEL(619)299-3917 FAX(619)299-5084 WEP: P2S ENCINEERING, INC. 9665 COLIFORNIA 92123 TEL(619)618-2347 STRUCTURAL: SUN STRUCTURAL ENCINEERING 2091 LAS PALMAS DRIVE, SUITE 230 SAN DIEGO, CA 92123 TEL(619)618-2347 STRUCTURAL: SUN STRUCTURAL ENCINEERING 2091 LAS PALMAS DRIVE, SUITE 2 CARLSBAD, CA 92011 TEL(760)438-1188	F: 619–299–	5084				
USSP 800 UPGRADE Tri-City Medical Cent 4002 Vista Way Oceanside, California 92056 OWNER: TRI-CITY MEDICAL CENTER 4002 VISTA WAY 0CEANSIDE, CALIFORNIA 92056 ARCHITECT: SFEIR ARCHITECTS 5151 SHOREHAM PLACE, SUITE 100 SAN DIEGO, CALIFORNIA 92122 TEL(619)299-3917 FAX(619)299-5084 MEF: P2S ENGINEERING, INC. 96655 CHESAPEAKE DRIVE, SUITE 230 SAN DIEGO, CALIFORNIA 92122 TEL(619)618-2347 STRUCTURAL: SUN STRUCTURAL ENGINEERING 2041 LAS PALMAS DRIVE, SUITE 2 CARLSBAD, CA 92011 TEL(760)438-1188 MON C 28543 TO VICH TO VICH MON C 28543 TO VICH DO-00-17 CALE MON C 28543 TO VICH DESIGN GUANGES MON C 28543 TO VICH DESIT	USP 800 UPGRADE Tri-City Medical Cent 4002 Vista Way Oceanside, California 92056 DWNER: TRI-CITY MEDICAL CENTER 4002 VISTA WAY OCEANSIDE, CALIFORNIA 92056 ARCHITECT: STEIR ARCHITECTS 5151 SHOREHAM PLACE, SUITE 100 SAN DIECO, CALIFORNIA 92122 TEL(619)299-3917 FAX(619)299-5084 MEP: P2S ENGINEERING, INC. 9665 CHESAPEAKE DRIVE, SUITE 230 SAN DIECO, CA 2123 TEL(619)618-2347 STRUCTURAL: SUN STRUCTURAL ENGINEERING 2091 LAS PALMAS DRIVE, SUITE 2 OCARLSBAD, CA 92011 TEL(760)438-1188 DOM-17 DESIGN CHANCES OSHPD COMMENTS D-09-17 DESIGN CHANCES OSHPD COMMENTS D-09-17 DESIGN CHANCES OSHPD COMMENTS D-09-17 DESIGN CHANCES DESIGN CHANCES	TCN	ЛС				
UPGRADE 4002 Vista Way Oceanside, California 92056 OWNER: TRI-CITY MEDICAL CENTER 4002 Vista Way OCEANSIDE, CALIFORNIA 92056 ARCHITECT: SFEIR ARCHITECTS SAN DIEGO, CALIFORNIA 92056 ARCHITECT: SFEIR ARCHITECTS 9665 CHESAPEAKE DRIVE, SUITE 230 SAN DIEGO, CALIFORNIA 92122 TEL(619)299-3917 FAX(619)299-5084 MEP: P2S ENGINEERING, INC. 9665 CHESAPEAKE DRIVE, SUITE 230 SAN DIEGO, CALIFORNIA 92122 TEL(619)618-2347 STRUCTURAL: SUN STRUCTURAL ENGINEERING 2091 LAS PALMAS DRIVE, SUITE D CARLSBAD, CA 92011 TEL(760)438-1188 VICTORICAL STATE 10-09-17 DESIGN CHANGES 12-11-17 OBERO COMMENTS 12-11-17 ORIPD COMMENTS	UPGRADE UPGRA	PHA	١R	ΜA	C'	Y	
Tri-City Medical Cent 4002 Vista Way Oceanside, California 92056 OWNER: TRI-CITY MEDICAL CENTER 4002 VISTA WAY OCEANSIDE, CALIFORNIA 92056 ARCHITECT: SFEIR ARCHITECTS 5151 SHOREHAM PLACE, SUITE 100 SAN DIEGO, CALIFORNIA 92122 TEL(619)299-3917 FAX(619)299-5084 MEP: P2S ENGINEERING, INC. 9665 CHESAPEAKE DRIVE, SUITE 230 SAN DIEGO, CA 92123 TEL(619)618-2347 STRUCTURAL: SUN STRUCTURAL ENGINEERING 2091 LAS PALMAS DRIVE, SUITE 2 CARLSBAD, CA 92011 TEL(760)438-1188 INCC28543 INCC28543 INCC28543 INCOMMENTS INCOMMENTS INCC485 INCOMMENTS INCOMMENTS </th <th>Tri-City Medical Cent 4002 Vista Way Oceanside, California 92056 DWNER: TRI-CITY MEDICAL CENTER 4002 Vista Way OCEANSIDE, CALIFORNIA 92056 ARCHITECT: SFEIR ARCHITECTS 5151 SHOREHAM PLACE, SUITE 100 CARLOGO, CALIFORNIA 92056 ARCHITECT: SFEIR ARCHITECTS 9665 CHESAPEAKE DRIVE, SUITE 230 SAN DIEGO, CA 92123 TEL(619)299-3917 FAX(619)299-5084 WEP: P2S ENGINEERING, INC. 9665 CHESAPEAKE DRIVE, SUITE 230 SAN DIEGO, CA 92123 TEL(619)618-2347 STRUCTURAL: SUN STRUCTURAL ENGINEERING 2091 LAS PALMAS DRIVE, SUITE D CARLSBAD, CA 92011 TEL(760)438-1188 IMPORT Import <</th> <th>USF</th> <th>D 8</th> <th>00</th> <th></th> <th></th> <th></th>	Tri-City Medical Cent 4002 Vista Way Oceanside, California 92056 DWNER: TRI-CITY MEDICAL CENTER 4002 Vista Way OCEANSIDE, CALIFORNIA 92056 ARCHITECT: SFEIR ARCHITECTS 5151 SHOREHAM PLACE, SUITE 100 CARLOGO, CALIFORNIA 92056 ARCHITECT: SFEIR ARCHITECTS 9665 CHESAPEAKE DRIVE, SUITE 230 SAN DIEGO, CA 92123 TEL(619)299-3917 FAX(619)299-5084 WEP: P2S ENGINEERING, INC. 9665 CHESAPEAKE DRIVE, SUITE 230 SAN DIEGO, CA 92123 TEL(619)618-2347 STRUCTURAL: SUN STRUCTURAL ENGINEERING 2091 LAS PALMAS DRIVE, SUITE D CARLSBAD, CA 92011 TEL(760)438-1188 IMPORT Import <	USF	D 8	00			
4002 Vista Way Oceanside, California 92056 OWNER: TRI-CITY MEDICAL CENTER 4002 VISTA WAY OCEANSIDE, CALIFORNIA 92056 ARCHITECT: SFEIR ARCHITECTS 5151 SHOREHAM PLACE, SUITE 100 SAN DIEGO, CALIFORNIA 92122 TEL(619)299–3917 FAX(619)299–5084 MEP: P2S ENGINEERING, INC. 9665 CHESAPEAKE DRIVE, SUITE 230 SAN DIEGO, CA 92123 TEL(619)618–2347 STRUCTURAL: STRUCTURAL: SUN STRUCTURAL ENGINEERING 2091 LAS PALMAS DRIVE, SUITE D CARLSBAD, CA 92011 TEL(760)438–1188 TEL(760)438–1188 A OSHPD COMMENTS 10–09–17 A OSHPD COMMENTS 10–09–17 A OSHPD COMMENTS 12–11–17 A OSHPD COMMENTS 12–11–17 A DESIGN CHANCES	4002 Vista Way Oceanside, California 92056 DWNER: TRI-CITY MEDICAL CENTER 4002 VISTA WAY OCEANSIDE, CALIFORNIA 92056 ARCHITECT: SFEIR ARCHITECTS 5151 SHOREHAM PLACE, SUITE 100 SAN DIEGO, CALIFORNIA 92122 TEL(619)299-3917 FAX(619)299-5084 WEP: P2S ENGINEERING, INC. 9665 CHESAPEAKE DRIVE, SUITE 230 SAN DIEGO, CA 92123 TEL(619)618-2347 STRUCTURAL: SUN STRUCTURAL ENGINEERING 2091 LAS PALMAS DRIVE, SUITE D CARLSBAD, CA 92011 TEL(760)438-1188 Image: Structure of the structure	UPC	GR	AD	Ε		
4002 Vista Way Oceanside, California 92056 OWNER: TRI-CITY MEDICAL CENTER 4002 VISTA WAY OCEANSIDE, CALIFORNIA 92056 ARCHITECT: SFEIR ARCHITECTS 5151 SHOREHAM PLACE, SUITE 100 SAN DIEGO, CALIFORNIA 92122 TEL(619)299–3917 FAX(619)299–5084 MEP: P2S ENGINEERING, INC. 9665 CHESAPEAKE DRIVE, SUITE 230 SAN DIEGO, CA 92123 TEL(619)618–2347 STRUCTURAL: STRUCTURAL: SUN STRUCTURAL ENGINEERING 2091 LAS PALMAS DRIVE, SUITE D CARLSBAD, CA 92011 TEL(760)438–1188 TEL(760)438–1188 A OSHPD COMMENTS 10–09–17 A OSHPD COMMENTS 10–09–17 A OSHPD COMMENTS 12–11–17 A OSHPD COMMENTS 12–11–17 A DESIGN CHANCES	4002 Vista Way Oceanside, California 92056 DWNER: TRI-CITY MEDICAL CENTER 4002 VISTA WAY OCEANSIDE, CALIFORNIA 92056 ARCHITECT: SFEIR ARCHITECTS 5151 SHOREHAM PLACE, SUITE 100 SAN DIEGO, CALIFORNIA 92122 TEL(619)299-3917 FAX(619)299-5084 WEP: P2S ENGINEERING, INC. 9665 CHESAPEAKE DRIVE, SUITE 230 SAN DIEGO, CA 92123 TEL(619)618-2347 STRUCTURAL: SUN STRUCTURAL ENGINEERING 2091 LAS PALMAS DRIVE, SUITE D CARLSBAD, CA 92011 TEL(760)438-1188 Image: Structure of the structure		1 N /		1	0	1
Oceanside, California 92056 OWNER: TRI-CITY MEDICAL CENTER 4002 VISTA WAY OCEANSIDE, CALIFORNIA 92056 ARCHITECT: SFEIR ARCHITECTS 5151 SHOREHAM PLACE, SUITE 100 SAN DIEGO, CALIFORNIA 92122 TEL(619)299-3917 FAX(619)299-5084 MEP: P2S ENGINEERING, INC. 9665 CHESAPEAKE DRIVE, SUITE 230 SAN DIEGO, CA 92123 TEL(619)618-2347 STRUCTURAL: SUN STRUCTURAL ENGINEERING 2091 LAS PALMAS DRIVE, SUITE D CARLSBAD, CA 92011 TEL(760)438-1188 VIET OSHPD COMMENTS VIET OSHPD COMMENTS VIET OSHPD COMMENTS VIET DESIGN CHANGES VIET DIE	Oceanside, California 92056 DWNER: TRI-CITY MEDICAL CENTER 4002 VISTA WAY OCEANSIDE, CALIFORNIA 92056 ARCHITECT: SFEIR ARCHITECTS 5151 SHOREHAM PLACE, SUITE 100 SAN DIEGO, CALIFORNIA 92122 TEL(619)299-3917 FAX(619)299-5084 MEP: P2S ENGINEERING, INC. 9665 CHESAPEAKE DRIVE, SUITE 230 SAN DIEGO, CA 92123 TEL(619)618-2347 STRUCTURAL: SUN STRUCTURAL ENGINEERING 2091 LAS PALMAS DRIVE, SUITE D CARLSBAD, CA 92011 TEL(760)438-1188 ITEL(619)618-2347 DESIGN CHANGES ITEL(760)438-1188 10-09-17		•	ledio	cal	Cen	t
4002 VISTA WAY OCEANSIDE, CALIFORNIA 92056 ARCHITECT: SFEIR ARCHITECTS 5151 SHOREHAM PLACE, SUITE 100 SAN DIEGO, CALIFORNIA 92122 TEL(619)299–3917 FAX(619)299–5084 MEP: P2S ENGINEERING, INC. 9665 CHESAPEAKE DRIVE, SUITE 230 SAN DIEGO, CA 92123 TEL(619)618–2347 STRUCTURAL: SUN STRUCTURAL ENGINEERING 2091 LAS PALMAS DRIVE, SUITE D CARLSBAD, CA 92011 TEL(760)438–1188 Image: Subscript of the subscript of t	4002 VISTA WAY OCEANSIDE, CALIFORNIA 92056 ARCHITECT: SFEIR ARCHITECTS 5151 SHOREHAM PLACE, SUITE 100 SAN DIEGO, CALIFORNIA 92122 TEL(619)299-3917 FAX(619)299-5084 MEP: P2S ENGINEERING, INC. 9665 CHESAPEAKE DRIVE, SUITE 230 SAN DIEGO, CA 92123 TEL(619)618-2347 STRUCTURAL: SUN STRUCTURAL ENGINEERING 2091 LAS PALMAS DRIVE, SUITE D CARLSBAD, CA 92011 TEL(760)438-1188 Image: Comments of the state of the		•	rnia 92	056		
5151 SHOREHAM PLACE, SUITE 100 SAN DIEGO, CALIFORNIA 92122 TEL(619)299-3917 FAX(619)299-5084 MEP: P2S ENGINEERING, INC. 9665 CHESAPEAKE DRIVE, SUITE 230 SAN DIEGO, CA 92123 TEL(619)618-2347 STRUCTURAL: SUN STRUCTURAL ENGINEERING 2091 LAS PALMAS DRIVE, SUITE D CARLSBAD, CA 92011 TEL(760)438-1188 Image: Comparison of the structure of th	5151 SHOREHAM PLACE, SUITE 100 SAN DIEGO, CALIFORNIA 92122 TEL(619)299-3917 FAX(619)299-5084 MEP: P2S ENGINEERING, INC. 9665 CHESAPEAKE DRIVE, SUITE 230 SAN DIEGO, CA 92123 TEL(619)618-2347 STRUCTURAL: SUN STRUCTURAL ENGINEERING 2091 LAS PALMAS DRIVE, SUITE D CARLSBAD, CA 92011 TEL(760)438-1188 Image: Comparison of the second	OWNER:	4002 VIS	TA WAY			
9665 CHESAPEAKE DRIVE, SUITE 230 SAN DIEGO, CA 92123 TEL(619)618–2347 STRUCTURAL: SUN STRUCTURAL ENGINEERING 2091 LAS PALMAS DRIVE, SUITE D CARLSBAD, CA 92011 TEL(760)438–1188	9665 CHESAPEAKE DRIVE, SUITE 230 SAN DIEGO, CA 92123 TEL(619)618-2347 STRUCTURAL: SUN STRUCTURAL ENGINEERING 2091 LAS PALMAS DRIVE, SUITE D CARLSBAD, CA 92011 TEL(760)438-1188	ARCHITECT:	5151 SHO SAN DIEC	OREHAM P SO, CALIFO	RNIA 92	2122	34
2091 LAS PALMAS DRIVE, SUITE D CARLSBAD, CA 92011 TEL(760)438–1188 Image: Comparison of the second s	2091 LAS PALMAS DRIVE, SUITE D CARLSBAD, CA 92011 TEL(760)438–1188	MEP:	9665 CH SAN DIEC	ESAPEAKE 50, CA 92	DRIVE,	SUITE 230	
No. C 28543	No. C 28543 No. C 28543 I-31-0 OF CALL OF CALL I-31-0	STRUCTURAL:	2091 LAS CARLSBA	S PALMAS D, CA 920	DRIVE,		
No. C 28543	No. C 28543 No. C 28543 I-31-0 OF CALL OF CALL I-31-0	CED	HR		· · · ·	· · ·	
Image: Consultant state Image: Consultant state	Image: State of the state	I ST					•
OSHPD COMMENTS 10-09-17 DESIGN CHANGES 10-09-17 OSHPD COMMENTS 12-11-17 DESIGN CHANGES 6-05-18 CONSULTANT DATE:	Image: Construction of the second state of the second s	In Br	2 3)			
Image: Construction Image: Construction Image: Construction Image: Construction Image: Construction Image: Construction Image: Construction Image: Construction Image: Construction Image: Construction Image: Construction Image: Construction Image: Construction Image: Construction Image: Construction Image: Construction Image: Construction Image: Construction Image: Construction Image: Construction Image: Construline Image: Construction Image	Image: State of the s			•	• . • .		
Image: State of a sta	Image: Second changes 12-11-17 Image: Second changes 12-11-17 Image: Second changes 5-15-18 Image: Second changes 6-05-18 Image: Second changes 6	$\overline{\Lambda}$ —					
S OSHPD COMMENTS 5-15-18 6 DESIGN CHANGES 6-05-18	S OSHPD COMMENTS 5–15–18 6 DESIGN CHANGES 6–05–18						
6 DESIGN CHANGES 6-05-18	6 DESIGN CHANGES 6-05-18		HANGES	~~~~~	~~~~~	12–11–17	\sim
			$\sim\sim\sim\sim\sim$	~~~~~			3
CONSULTANT OSHPD APPROVAL STAMP:	CONSULTANT DSHPD APPROVAL STAMP:						ر
CONSULTANT OSHPD APPROVAL STAMP:	CONSULTANT DSHPD APPROVAL STAMP:						
CONSULTANT OSHPD APPROVAL STAMP:	CONSULTANT DSHPD APPROVAL STAMP:						
CONSULTANT OSHPD APPROVAL STAMP:	CONSULTANT DSHPD APPROVAL STAMP:						
CONSULTANT OSHPD APPROVAL STAMP:	CONSULTANT DSHPD APPROVAL STAMP:						
OSHPD APPROVAL STAMP:	DSHPD APPROVAL STAMP:		10N:			DATE:	
		CUNSULTANT					
OSHPD #: S171641-37-00	OSHPD #: S171641-37-00						
		OSHPD #	S1716	41-37	-00		

PROJECT INFORMATION

ECT TITLE: MC USP 800


DATE:

PROJECT #:	01667.00	SHE
DRAWN BY:	LN	
CHECKED BY:	JS	
SCALE:	AS SHOWN	

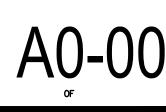

100% CONSTRUCTION DOCUMENT

07/31/17

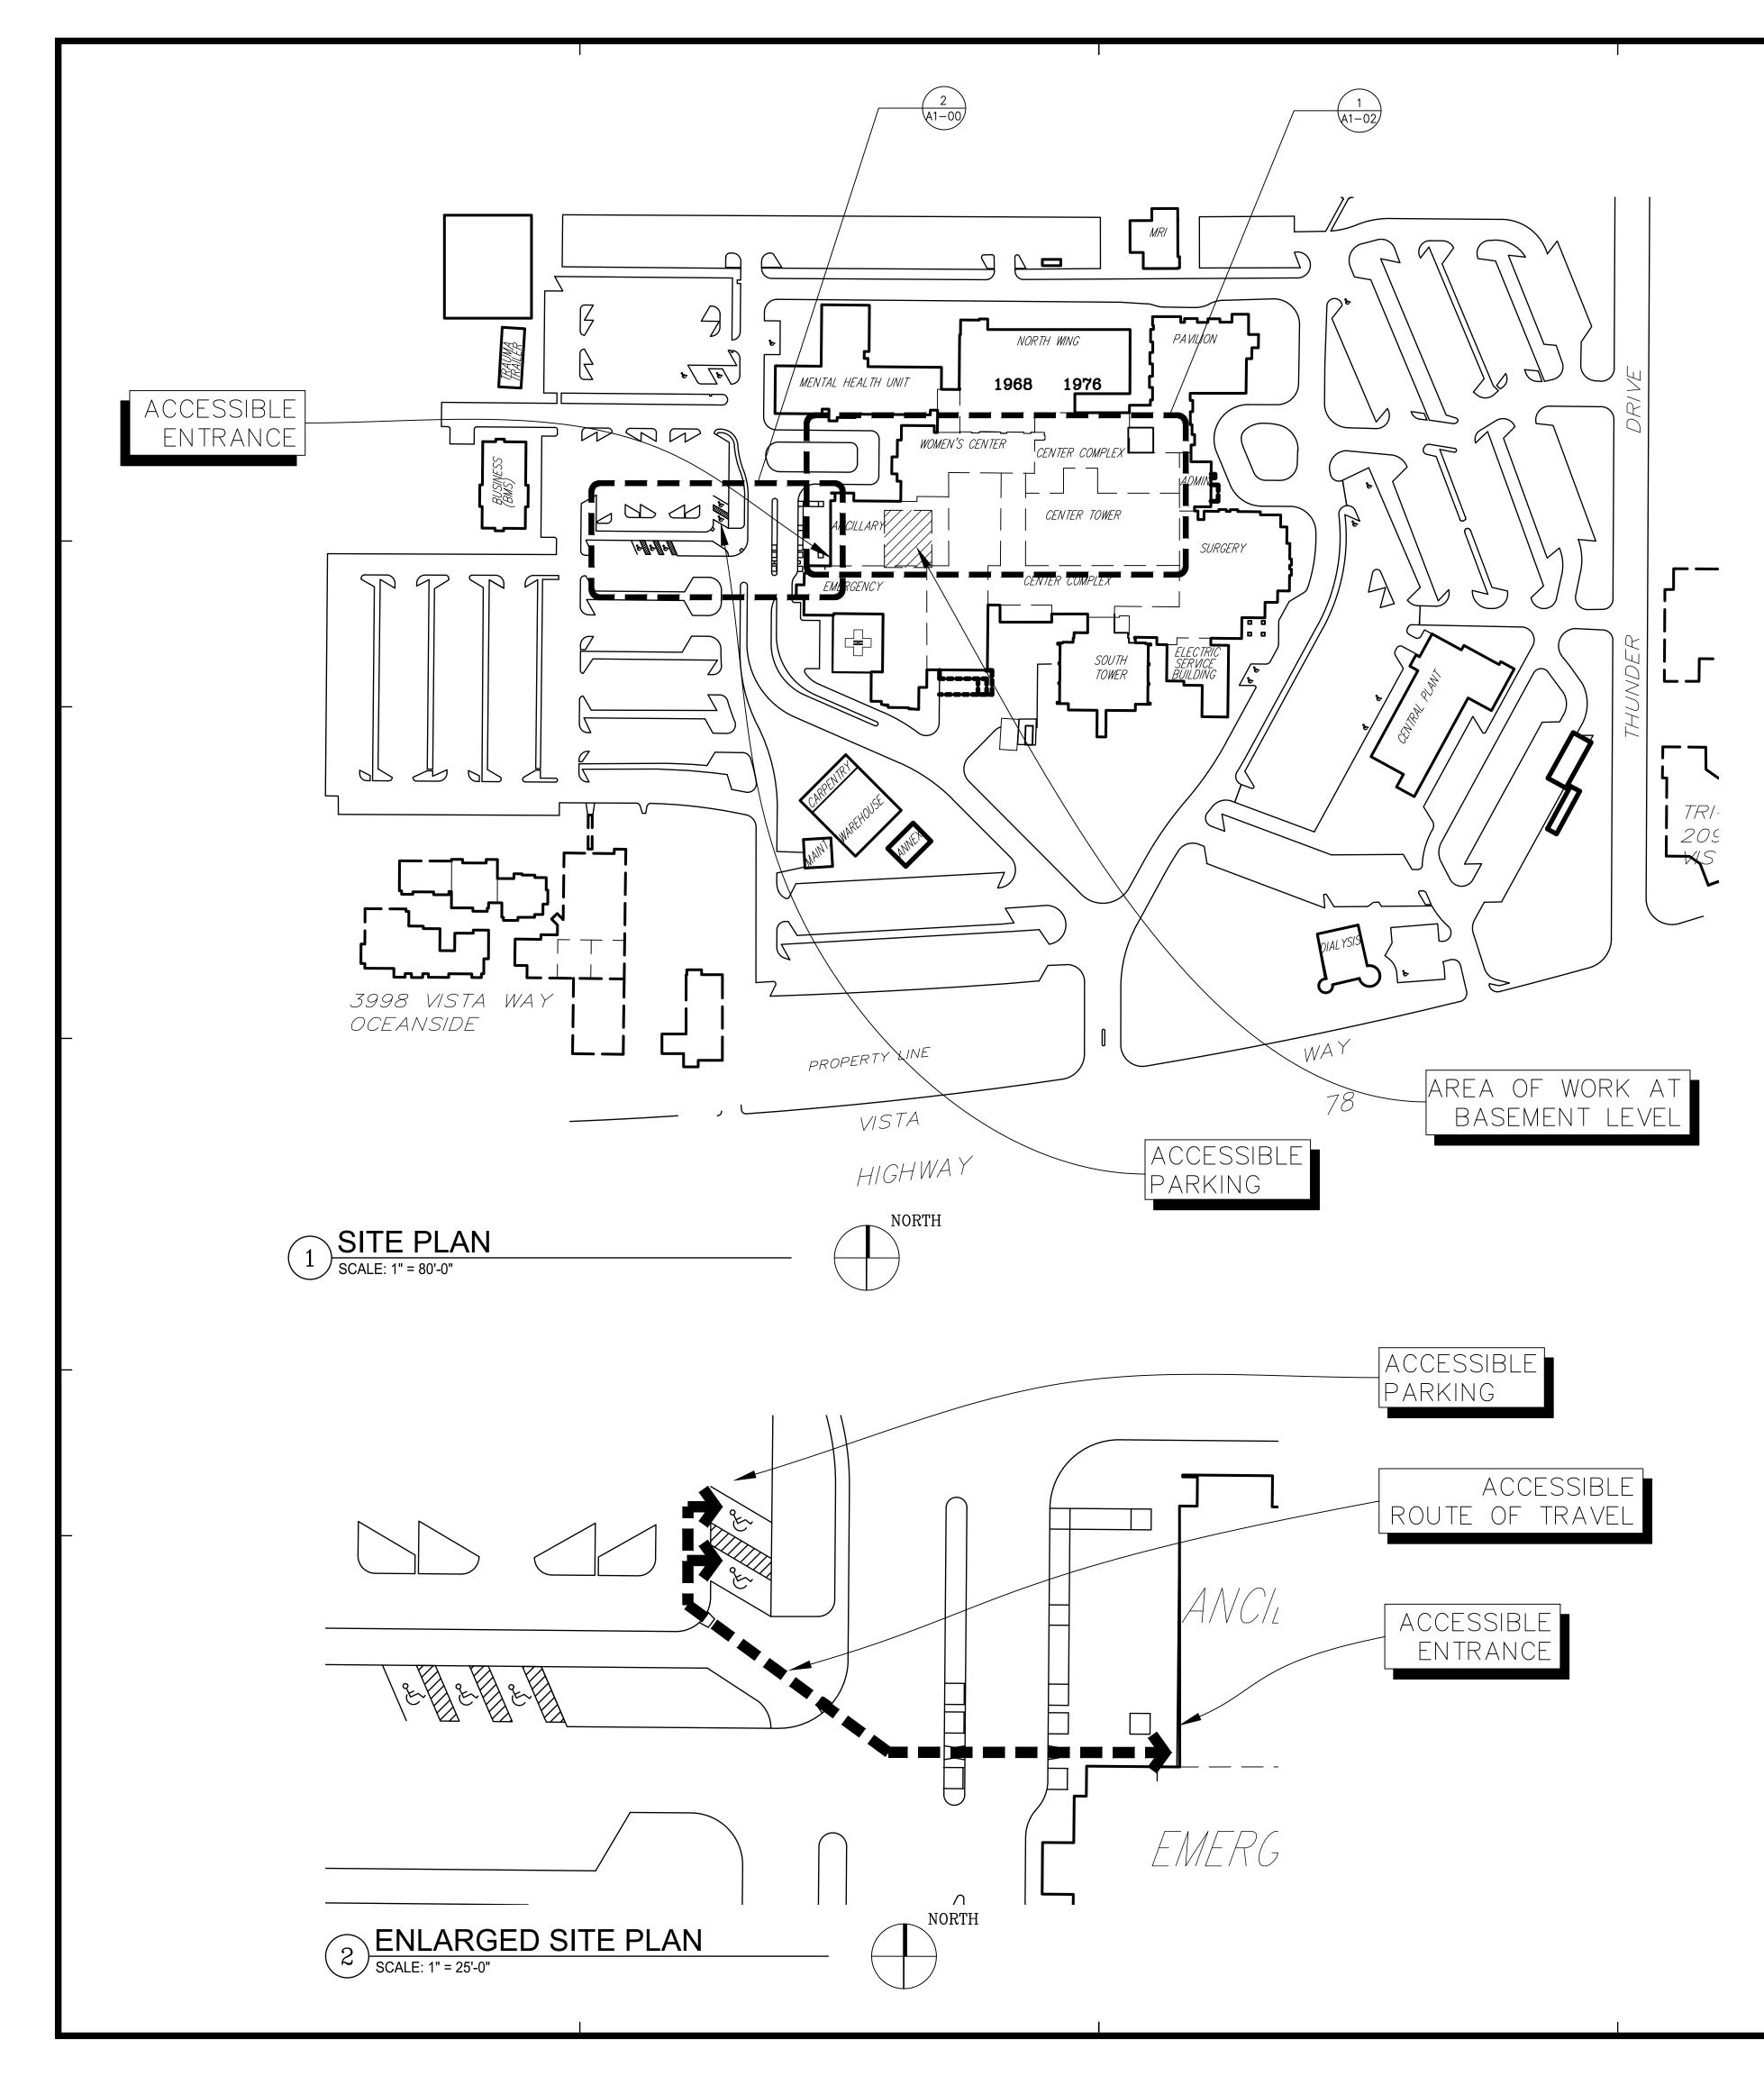

GENERAL NOTES:

- 1. THE GENERAL CONTRACTOR SHALL VERIFY ALL EXISTING CONDITIONS AND MEASUREMENTS IN THE FIELD PRIOR TO STARTING CONSTRUCTION.
- 2. REFER TO GENERAL NOTES ON SHEET A0-00 FOR INFORMATION NOT INDICATED ON THIS SHEET.

PARTITION LEGEND:

ACCESSIBLE PATH OF TRAVEL. EGRESS PATH OF TRAVEL. ONE-HOUR RATED CORRIDOR. ____ INDICATES AN EXISTING MEMBRANE OF PARTITION OR _____ PARTITION TO BE REMOVED. REFER TO DEMOLITION PLAN FOR FURTHER REQUIREMENTS. INDICATES AN EXISTING PARTITION TO REMAIN. REFER TO PLAN FOR UPGRADE REQUIREMENTS. <u>_1</u> SB SB SB SB SB III INDICATES AN EXISTING 1 HOUR SMOKE BARRIER 3 SP SP SP SP SP INDICATES AN EXISTING 1 HOUR SMOKE PARTITION FP FP FP FP FP INDICATES AN EXISTING ONE HOUR FIRE RATED PARTITION TO REMAIN. ALL PENETRATIONS SHALL BE PROTECTED WITH A UL-LISTED FIRE STOP SYSTEM. FB FB FB FB FB FB INDICATES AN EXISTING ONE HOUR RATED FIRE BARRIER TO REMAIN, ALL PENETRATIONS SHALL BE PROTECTED WITH A UL-LISTED FIRE STOP SYSTEM. FB FB FB FB FB FB INDICATES AN EXISTING TWO HOUR RATED FIRE BARRIER TO REMAIN, ALL PENETRATIONS SHALL BE PROTECTED WITH A UL-LISTED FIRE STOP SYSTEM. SB SB SB SB SB INDICATES A NEW 1 HOUR SMOKE BARRIER INDICATES A NEW 1 HOUR SMOKE PARTITION EXTENDING TO THE UNDERSIDE OF THE STRUCTURE ABOVE. ALL PENETRATIONS SHALL BE PROTECTED WITH A UL-LISTED FIRE STOP SYSTEM. EXTENDING TO THE UNDERSIDE OF THE STRUCTURE ABOVE. ALL PENETRATIONS SHALL BE PROTECTED WITH A UL-LISTED FIRE STOP SYSTEM. THICK LINE INDICATES NEW SURFACE FINISH. INDICATES AN EXISTING STRUCTURAL CONSILED WALL TO REMAIN. LOCATE REINFORCING STEEL AND OBTAIN APPROVAL FROM STRUCTURAL ENGINEER PRIOR TO CORING AND/ OR CUTTING.

-X WALL TYPE REFERENCE REFER TO SHEET A5-10.

PARTITION NOTES:

1. ALL DIMENSIONS SHOWN ARE TO FINISHED FACE OF GYP. BOARD, TYPICAL U.O.N. REFER TO SHEET A5-10 FOR GENERAL NOTES AND REQUIREMENTS FOR PARTITIONS.

2. EXISTING WALLS WERE CONSTRUCTED WITH MANY PERMITS AND/OR CONTRACTS. FIELD VERIFY CONSTRUCTION AND WIDTH PRIOR TO FABRICATION OF DOOR FRAMES OR COMPONENTS WHICH REQUIRE THE WIDTH OF WALL TO BE SET.

S F R F A R C H I T E C T S 5151 Shoreham Place, Suite 100 San Diego, Ca 92122 P: 619-299-3917 F: 619-299-5084 www.sfeirarch.com TCMC PHARMACY USP 800 UPGRADE **Tri-City Medical Center** 4002 Vista Way Oceanside, California 92056 TRI-CITY MEDICAL CENTER OWNER: 4002 VISTA WAY OCEANSIDE, CALIFORNIA 92056 ARCHITECT: SFEIR ARCHITECTS 5151 SHOREHAM PLACE, SUITE 100 SAN DIEGO, CALIFORNIA 92122 TEL(619)299-3917 FAX(619)299-5084 MEP: P2S ENGINEERING, INC. 9665 CHESAPEAKE DRIVE, SUITE 230 SAN DIEGO, CA 92123 TEL(619)618-2347 STRUCTURAL: SUN STRUCTURAL ENGINEERING 2091 LAS PALMAS DRIVE, SUITE D CARLSBAD, CA 92011 TEL(760)438-1188 No. C 28543 1-31-OF CALLES ••••• . 10-09-17 OSHPD COMMENTS 10-09-17 DESIGN CHANGES 12-11-17 OSHPD COMMENTS 12-11-17 DESIGN CHANGES 5–15–18 < OSHPD COMMENTS $\approx \infty \infty$ 6-05-18 DESIGN CHANGES REV: DESCRIPTION: DATE: CONSULTANT OSHPD APPROVAL STAMP: OSHPD #: S171641-37-00 SHEET TITLE: SITE ACCESSIBILITY AND EGRESS PATH OF TRAVEL PROJECT TITLE: TCMC USP 800 PROJECT #: 01667.00 DRAWN BY:

AS SHOWN


07/31/17

A1-00

CHECKED BY

SCALE:

DATE:

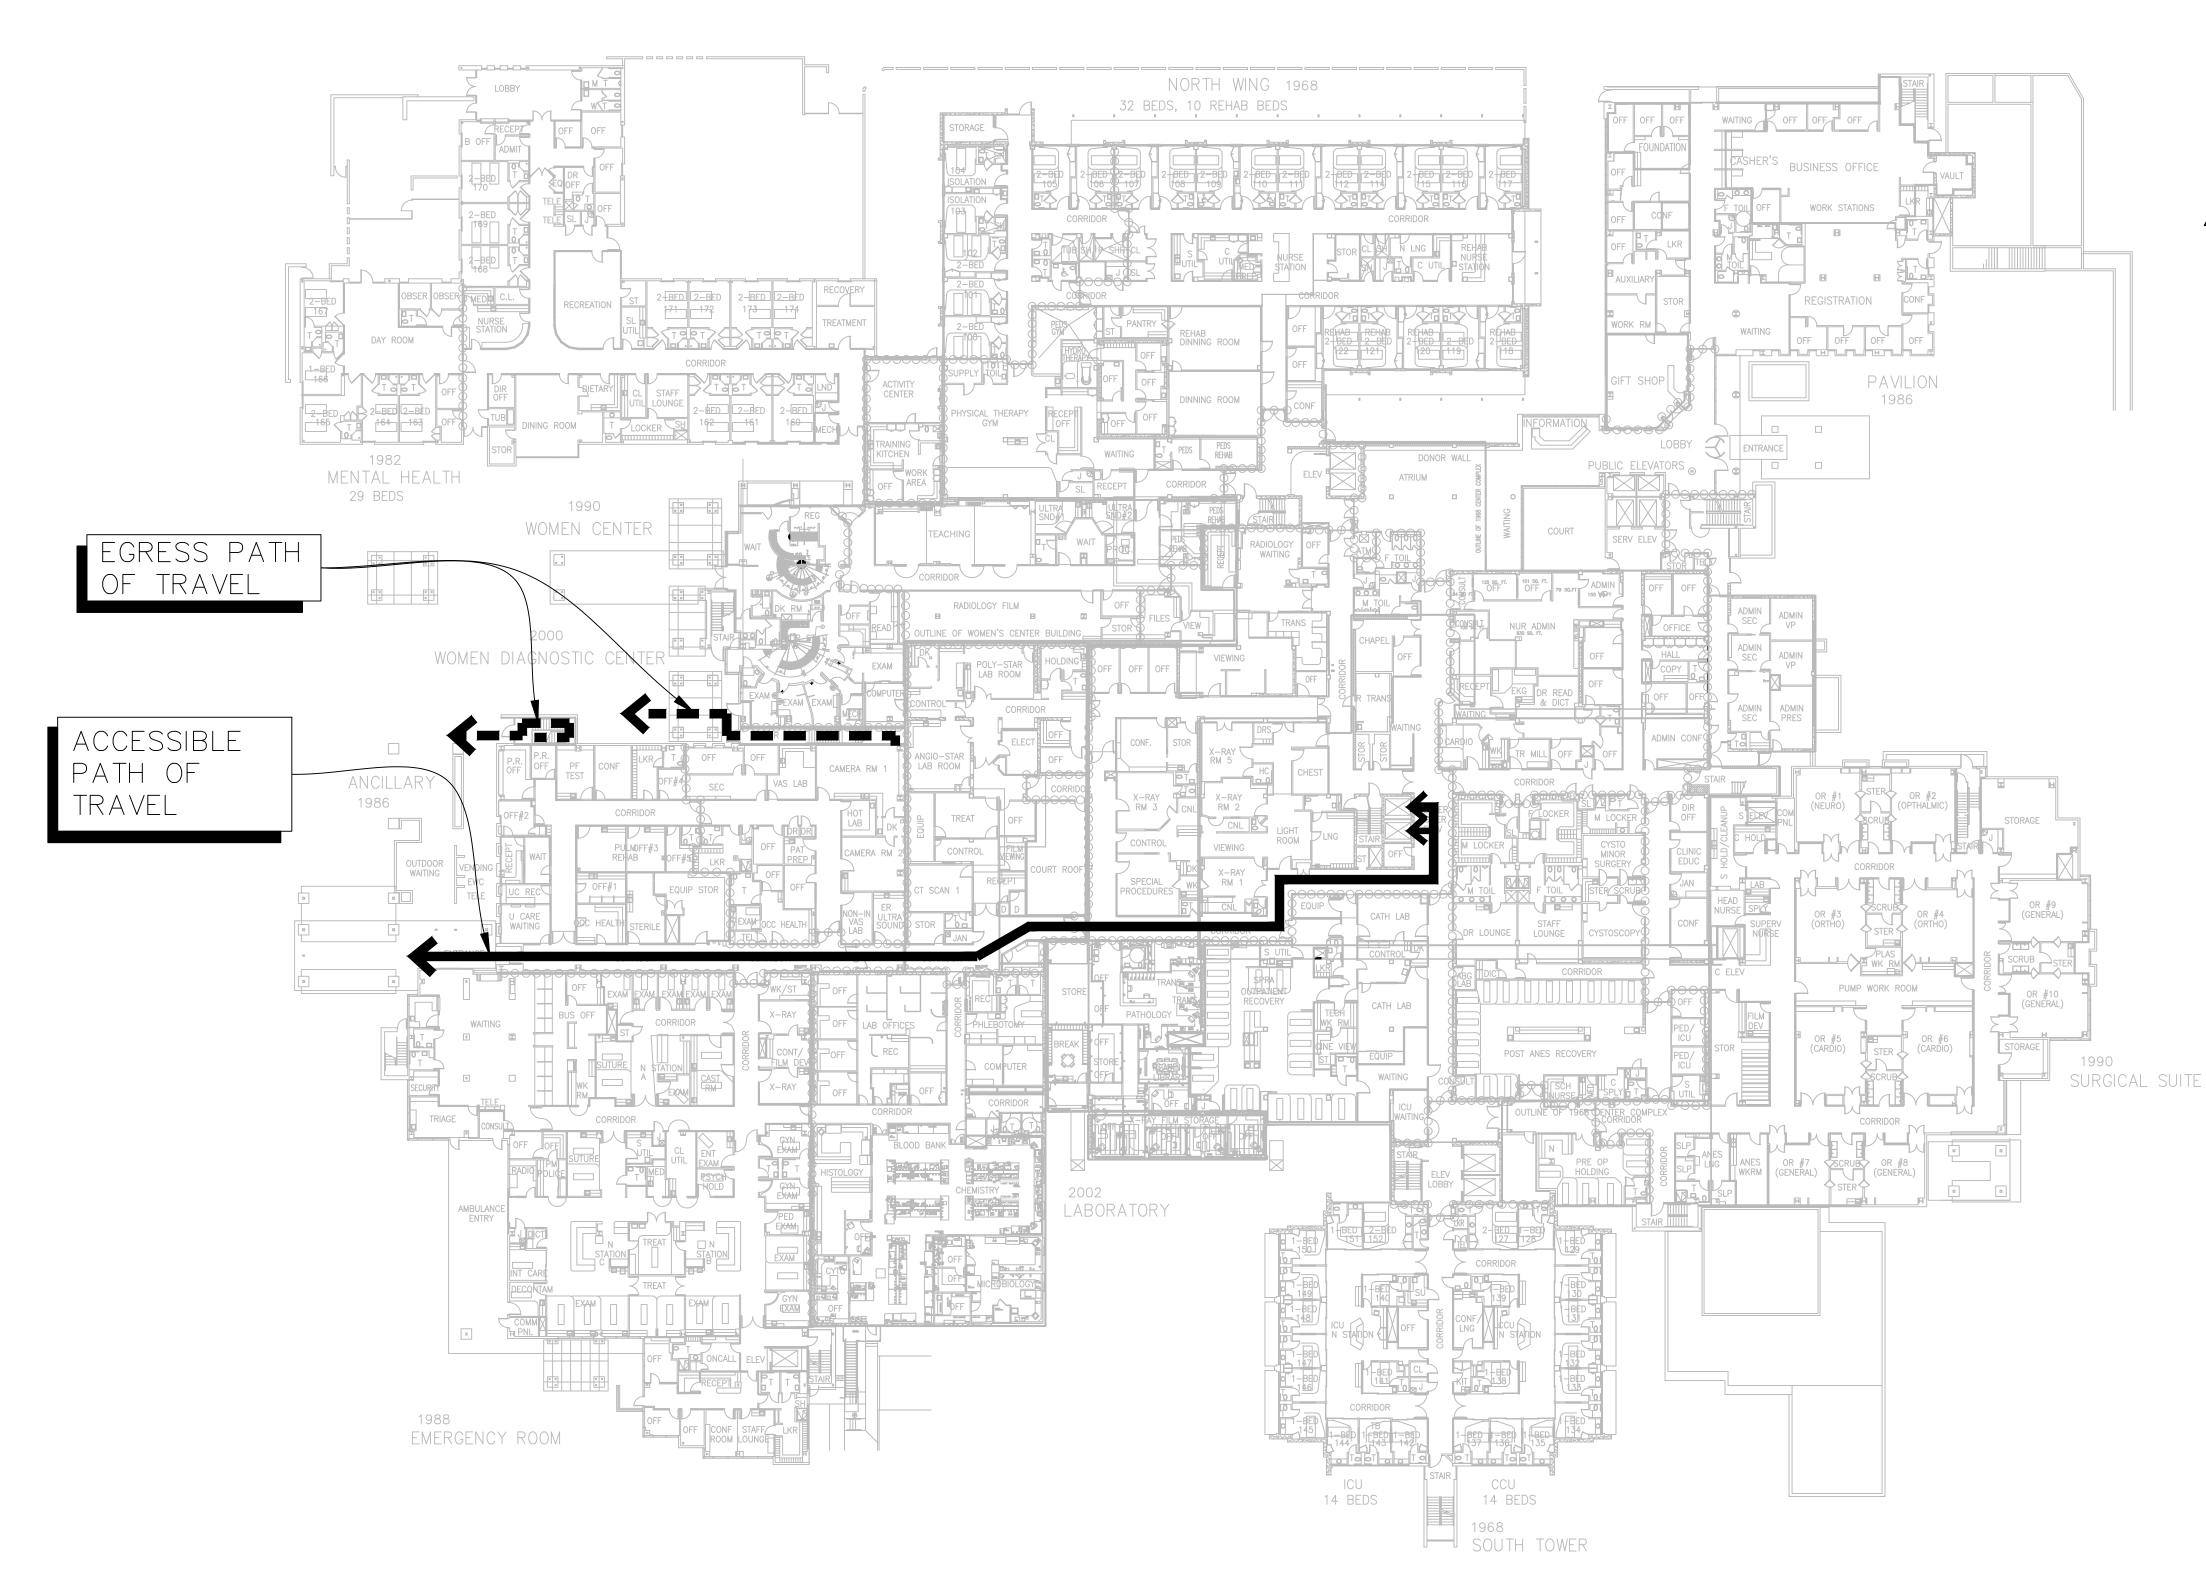

CODE COMPLIANCE FIRST FLOOR PLAN SCALE: 1/32" : 1'-0"




NORTH

GENERAL NOTES:

- 1. THE GENERAL CONTRACTOR SHALL VERIFY ALL EXISTING CONDITIONS AND MEASUREMENTS IN THE FIELD PRIOR TO STARTING CONSTRUCTION.
- 2. REFER TO GENERAL NOTES ON SHEET A0-00 FOR INFORMATION NOT INDICATED ON THIS SHEET.

PARTITION LEGEND:

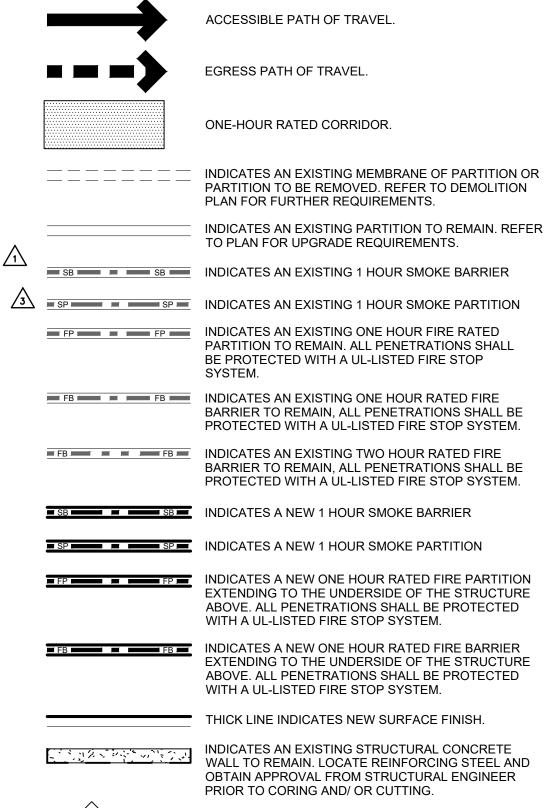

WALL TYPE REFERENCE REFER TO SHEET A5-10. $\prec x >$

PARTITION NOTES:

- 1. ALL DIMENSIONS SHOWN ARE TO FINISHED FACE OF GYP. BOARD, TYPICAL U.O.N. REFER TO SHEET A5-10 FOR GENERAL NOTES AND, REQUIREMENTS FOR PARTITIONS.
- 2. EXISTING WALLS WERE CONSTRUCTED WITH MANY PERMITS AND/OR CONTRACTS. FIELD VERIFY CONSTRUCTION AND WIDTH PRIOR TO FABRICATION OF DOOR FRAMES OR COMPONENTS WHICH REQUIRE THE WIDTH OF WALL TO BE SET.

All rights reserved. No part of this work may be reproduced or copied in any form or by any means, graphic, electronic, or mechanical, including photocopying, recording, taping, or info

S F R F A R C H I T E C T S

5151 Shoreham Place, Suite 100 San Diego, Ca 92122

P: 619–299–3917 F: 619–299–5084 www.sfeirarch.com

TCMC PHARMACY USP 800 UPGRADE

Tri-City Medical Center

	sta Way de, California 92056	
OWNER:	TRI-CITY MEDICAL CENTER 4002 VISTA WAY OCEANSIDE, CALIFORNIA 920	056
ARCHITECT:	SFEIR ARCHITECTS 5151 SHOREHAM PLACE, SU SAN DIEGO, CALIFORNIA 92' TEL(619)299–3917 FAX(61	122
MEP:	P2S ENGINEERING, INC. 9665 CHESAPEAKE DRIVE, S SAN DIEGO, CA 92123 TEL(619)618–2347	SUITE 230
STRUCTURA	L: SUN STRUCTURAL ENGINEER 2091 LAS PALMAS DRIVE, S CARLSBAD, CA 92011 TEL(760)438–1188	
1 67 No.	1-31-19 CALIFORNIT	
	d comments	10-09-17
	N CHANGES	10-09-17
	D COMMENTS	12–11–17
$\sqrt{\frac{2}{5}}$	N CHANGES	12-11-17
	d comments 	5-15-18 5-05-18 6-05-18

_____ REV: DESCRIPTION: CONSULTANT

OSHPD APPROVAL STAMP: OSHPD #: S171641-37-00


SHEET TITLE:

CODE COMPLIANCE FIRST FLOOR PLAN

PROJECT TITLE: TCMC USP 800

PROJECT #: 01667.00 DRAWN BY: - I N CHECKED BY: SCALE: AS SHOWN DATE: 07/31/17

DATE:

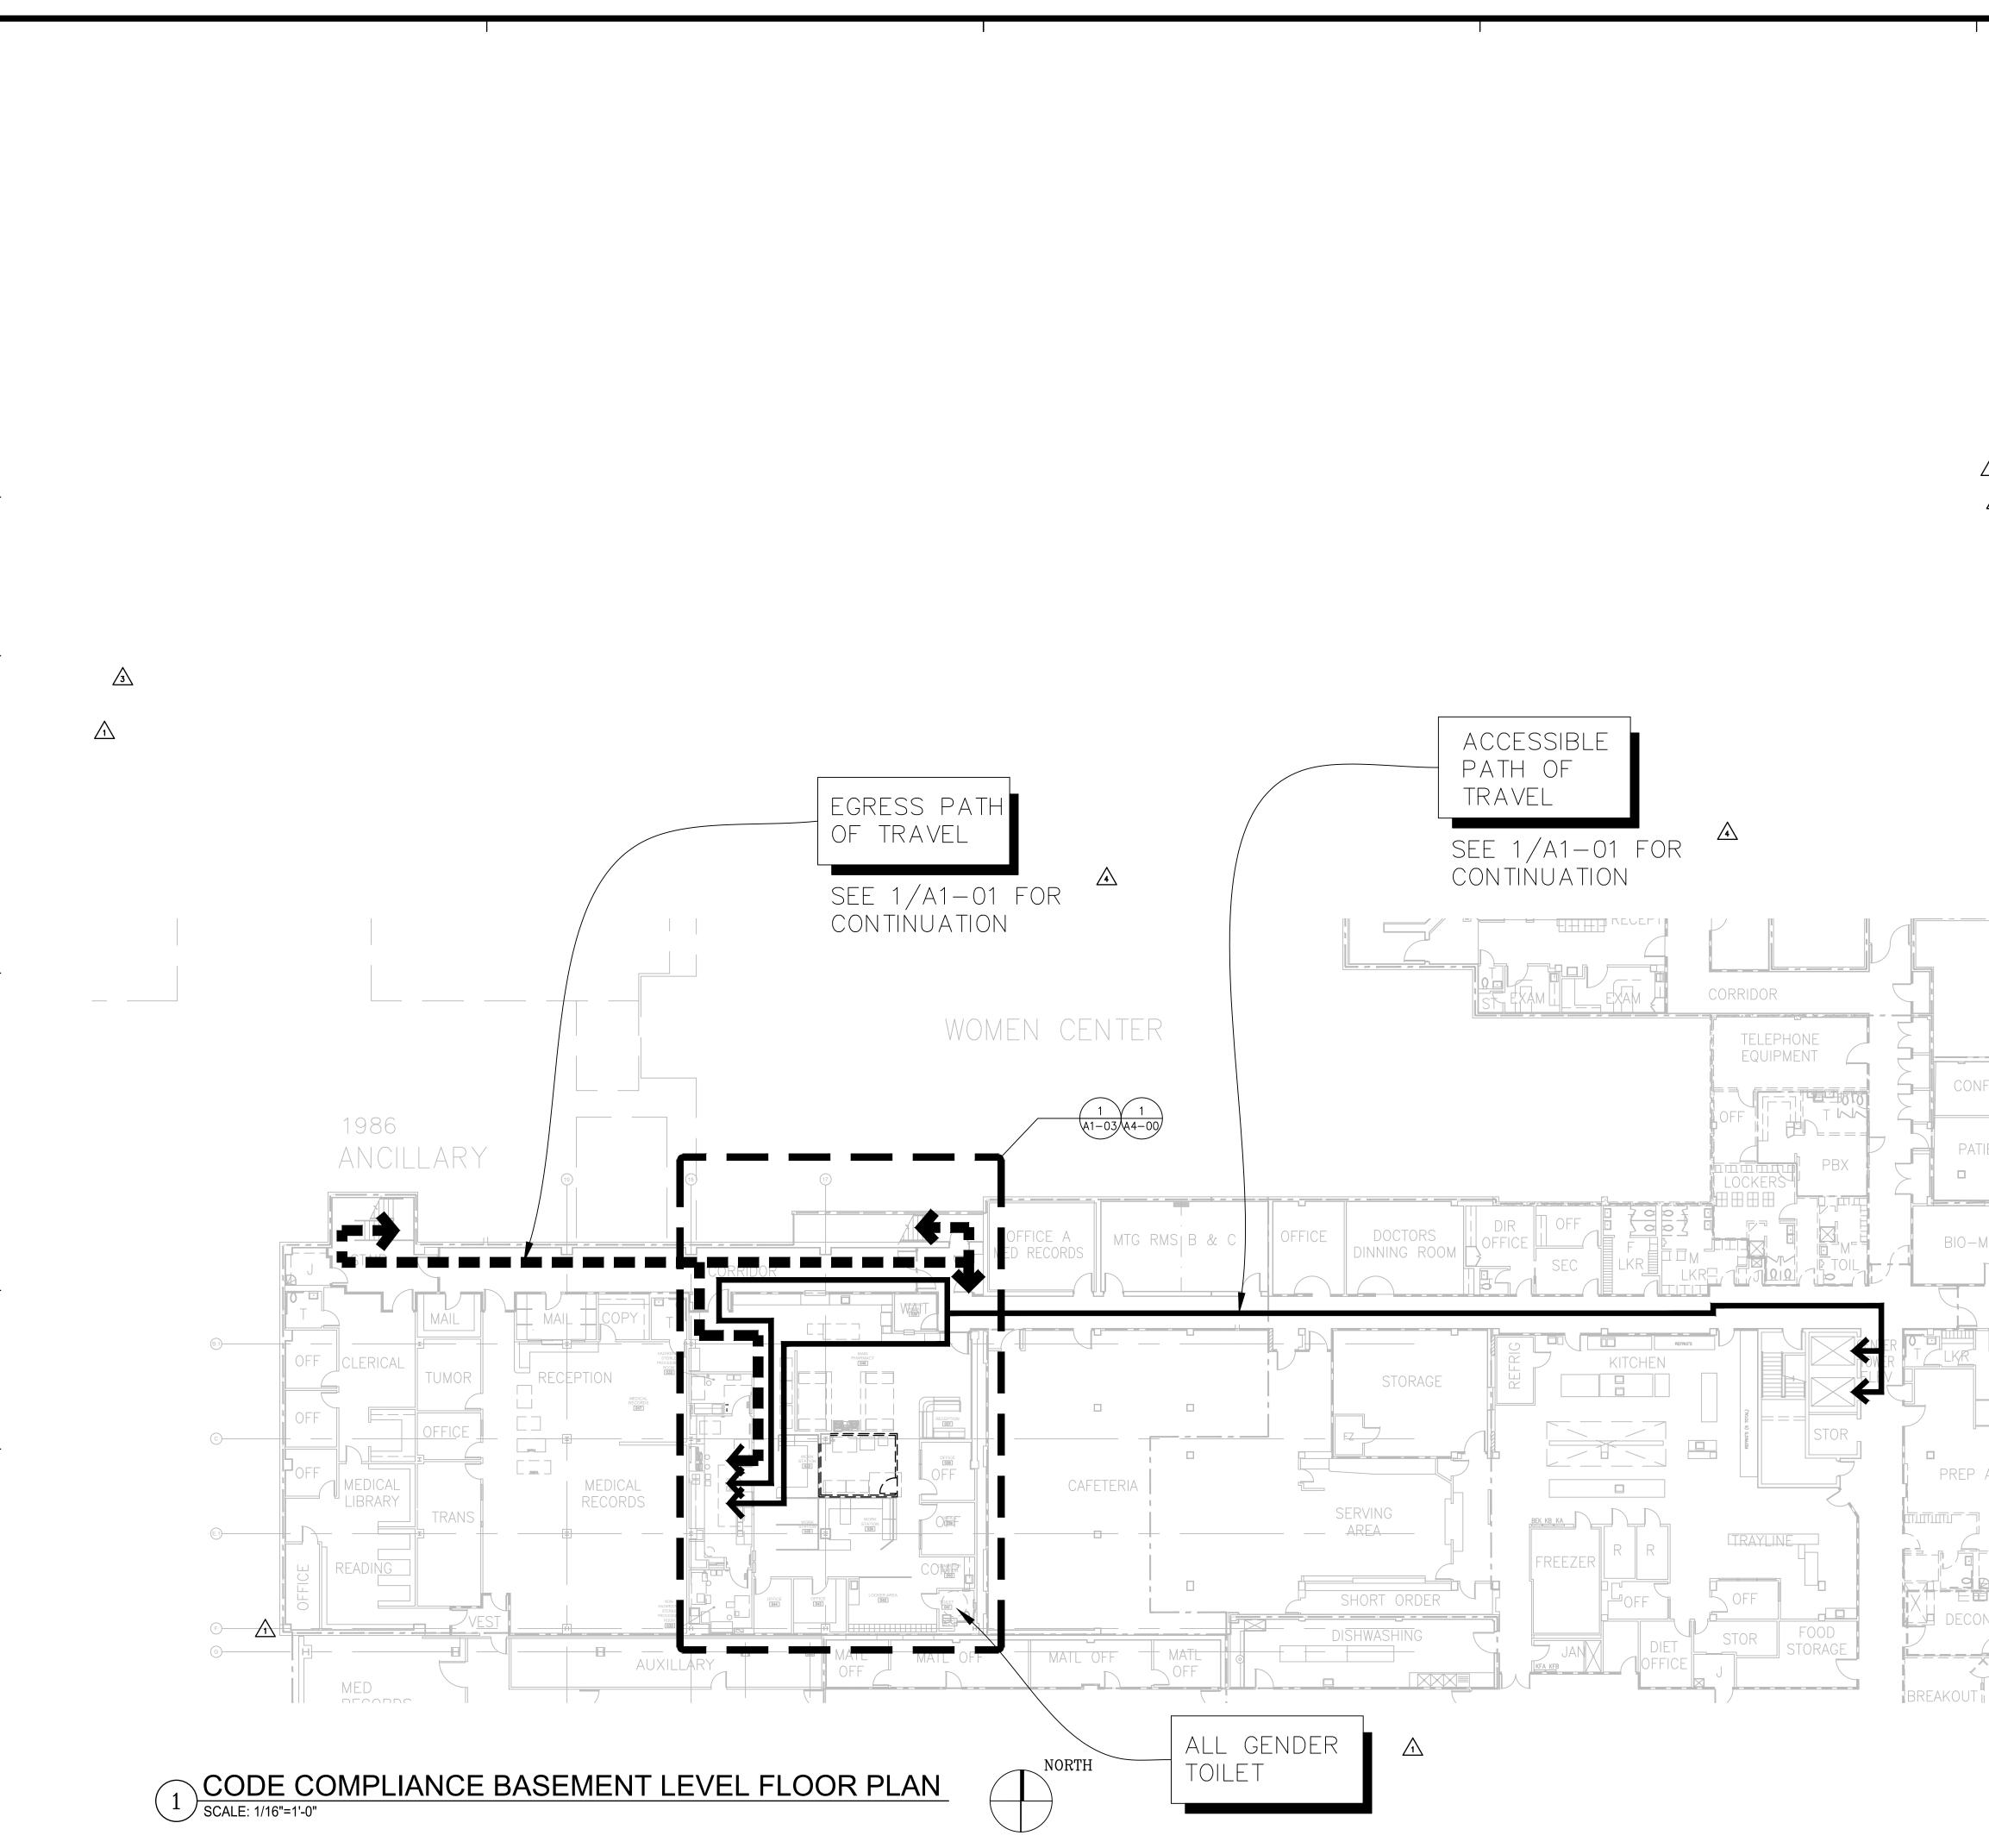

GENERAL NOTES:

- 1. THE GENERAL CONTRACTOR SHALL VERIFY ALL EXISTING CONDITIONS AND MEASUREMENTS IN THE FIELD PRIOR TO STARTING CONSTRUCTION.
- 2. REFER TO GENERAL NOTES ON SHEET A0-00 FOR INFORMATION NOT INDICATED ON THIS SHEET.

PARTITION LEGEND:

ACCESSIBLE PATH OF TRAVEL. EGRESS PATH OF TRAVEL. ONE-HOUR RATED CORRIDOR. _____ INDICATES AN EXISTING MEMBRANE OF PARTITION OR _____ PARTITION TO BE REMOVED. REFER TO DEMOLITION PLAN FOR FURTHER REQUIREMENTS. INDICATES AN EXISTING PARTITION TO REMAIN. REFER TO PLAN FOR UPGRADE REQUIREMENTS. $\sqrt{1}$ SB SB SB SB SB III INDICATES AN EXISTING 1 HOUR SMOKE BARRIER 3 SP SP SP SP SP INDICATES AN EXISTING 1 HOUR SMOKE PARTITION PARTITION TO REMAIN. ALL PENETRATIONS SHALL BE PROTECTED WITH A UL-LISTED FIRE STOP SYSTEM. FB FB FB FB FB FB INDICATES AN EXISTING ONE HOUR RATED FIRE BARRIER TO REMAIN, ALL PENETRATIONS SHALL BE PROTECTED WITH A UL-LISTED FIRE STOP SYSTEM. FB FB FB FB FB FB IINDICATES AN EXISTING TWO HOUR RATED FIRE BARRIER TO REMAIN, ALL PENETRATIONS SHALL BE PROTECTED WITH A UL-LISTED FIRE STOP SYSTEM. SB SB SB SB INDICATES A NEW 1 HOUR SMOKE BARRIER INDICATES A NEW 1 HOUR SMOKE PARTITION FP ------ INDICATES A NEW ONE HOUR RATED FIRE PARTITION EXTENDING TO THE UNDERSIDE OF THE STRUCTURE ABOVE. ALL PENETRATIONS SHALL BE PROTECTED WITH A UL-LISTED FIRE STOP SYSTEM. EXTENDING TO THE UNDERSIDE OF THE STRUCTURE ABOVE. ALL PENETRATIONS SHALL BE PROTECTED WITH A UL-LISTED FIRE STOP SYSTEM. THICK LINE INDICATES NEW SURFACE FINISH. WALL TO REMAIN. LOCATE REINFORCING STEEL AND

 $\langle x \rangle$ WALL TYPE REFERENCE REFER TO SHEET A5-10. PARTITION NOTES:

ALL DIMENSIONS SHOWN ARE TO FINISHED FACE OF GYP. BOARD, 1. TYPICAL U.O.N. REFER TO SHEET A5-10 FOR GENERAL NOTES AND REQUIREMENTS FOR PARTITIONS.

OBTAIN APPROVAL FROM STRUCTURAL ENGINEER

PRIOR TO CORING AND/ OR CUTTING.

EXISTING WALLS WERE CONSTRUCTED WITH MANY PERMITS AND/OR 2. CONTRACTS. FIELD VERIFY CONSTRUCTION AND WIDTH PRIOR TO FABRICATION OF DOOR FRAMES OR COMPONENTS WHICH REQUIRE THE WIDTH OF WALL TO BE SET.



5151 Shoreham Place, Suite 100 San Diego, Ca 92122

P: 619-299-3917 F: 619-299-5084 www.sfeirarch.com

TCMC PHARMACY USP 800 UPGRADE

er

Tri-(City Medical	Cente
	ista Way side, California 92056	
OWNER:	TRI-CITY MEDICAL CENTER 4002 VISTA WAY OCEANSIDE, CALIFORNIA 92	
ARCHITEC1	T: SFEIR ARCHITECTS 5151 SHOREHAM PLACE, S SAN DIEGO, CALIFORNIA 92 TEL(619)299–3917 FAX(6	2122
MEP:	P2S ENGINEERING, INC. 9665 CHESAPEAKE DRIVE, SAN DIEGO, CA 92123 TEL(619)618–2347	SUITE 230
STRUCTUR	AL: SUN STRUCTURAL ENGINEE 2091 LAS PALMAS DRIVE, CARLSBAD, CA 92011 TEL(760)438–1188	
	NICHA NICHA 1-31-19 DF CALIFORNIT	· · · · · · · · · · · · · · · · · · ·
$\sqrt[2]{\frac{1}{\sqrt{2}}}$ -	HPD COMMENTS	<u> </u>
$\sqrt{\frac{2}{3}}$	HPD COMMENTS	12-11-17
$\wedge \sim$	SIGN CHANGES	12-11-17
$\wedge \rightarrow \rightarrow$	HPD COMMENTS	5-15-18 ~~~~~~~
	SIGN CHANGES	<u>6-05-18</u>
REV: DES	CRIPTION:	DATE:
CONSULTANT		

CONSULTANT

OSHPD APPROVAL STAMP: OSHPD #: S171641-37-00

SHEET TITLE:

CODE COMPLIANCE **BASEMENT LEVEL** FLOOR PLAN

SHEET NUMBE

PROJECT TITLE: TCMC USP 800

PROJECT #: 01667.00 DRAWN BY: LN CHECKED BY: SCALE: AS SHOWN

DATE:

A1-02






PREP AI





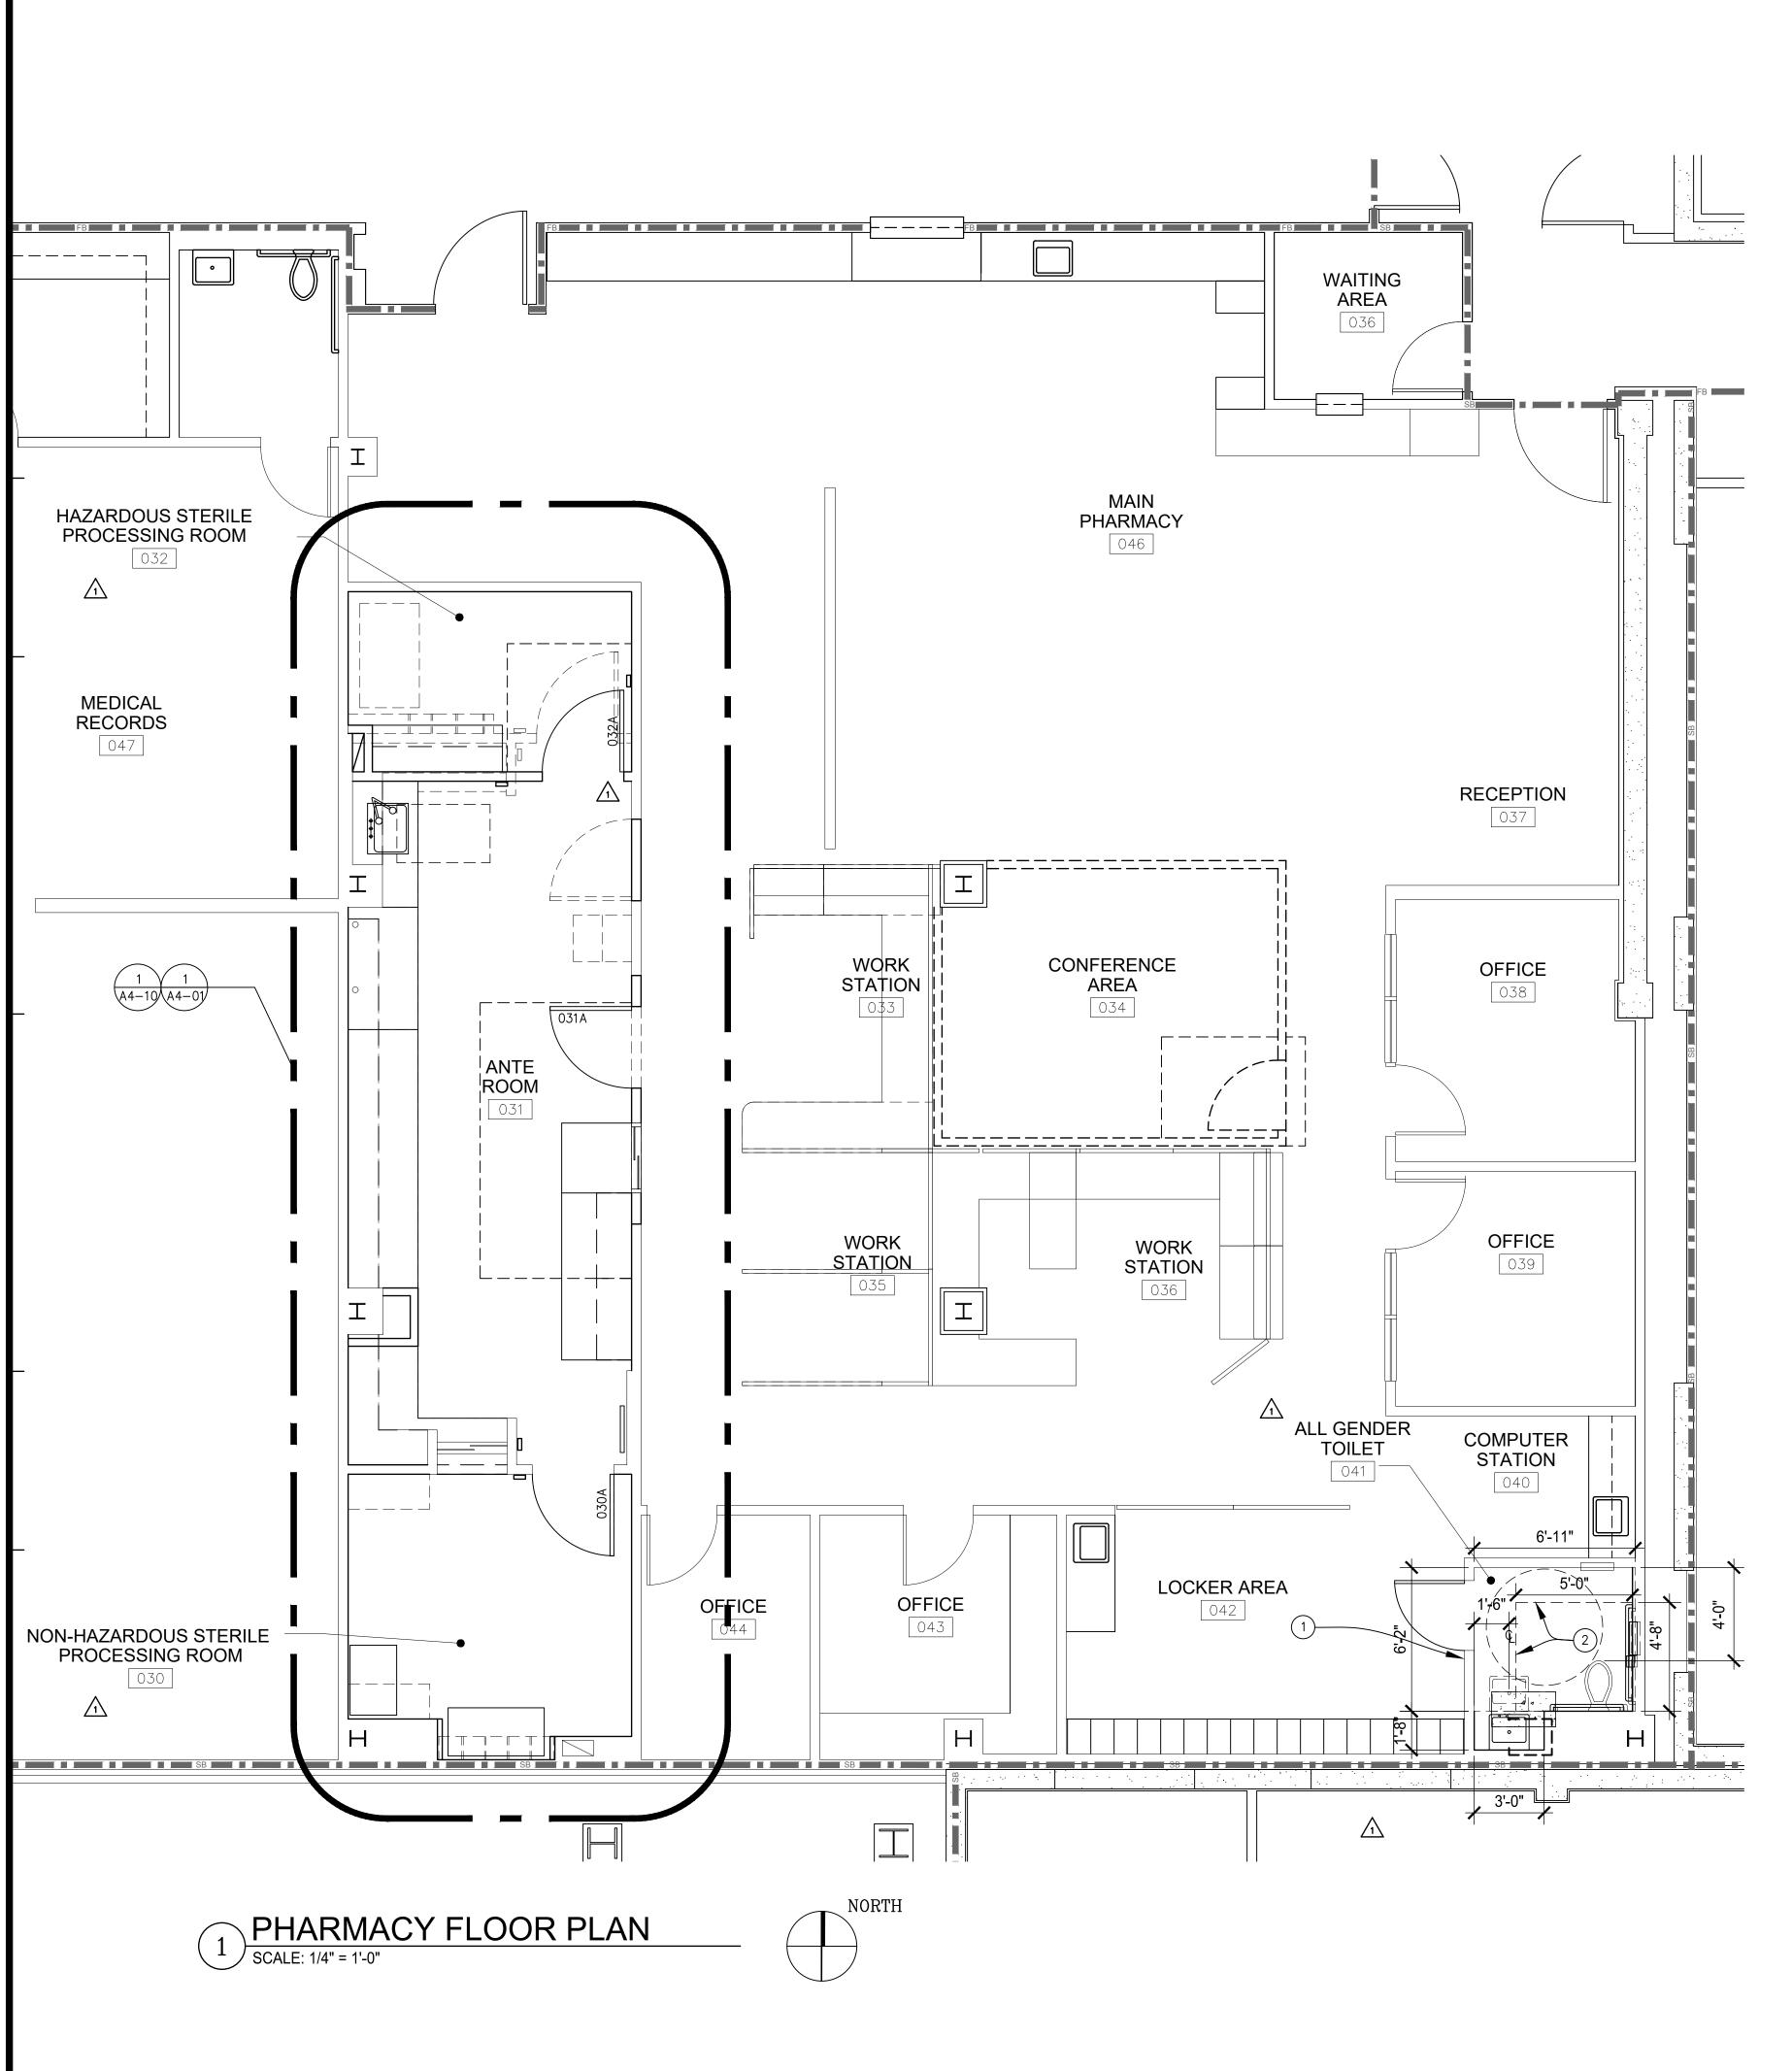


All rights reserved. No part of this work may be reproduced or copied in any form or by any means, graphic, electronic, or mechanical, including photocopying, recording, taping, or in

 Λ

S F R **GENERAL NOTES:** 1. THE GENERAL CONTRACTOR SHALL VERIFY ALL EXISTING CONDITIONS A R C H I T E C T S AND MEASUREMENTS IN THE FIELD PRIOR TO STARTING CONSTRUCTION. 2. REFER TO GENERAL NOTES ON SHEET A0-00 FOR INFORMATION NOT INDICATED ON THIS SHEET. 5151 Shoreham Place, Suite 100 San Diego, Ca 92122 P: 619-299-3917 F: 619-299-5084 PARTITION LEGEND: www.sfeirarch.com TCMC ACCESSIBLE PATH OF TRAVEL. PHARMACY EGRESS PATH OF TRAVEL. USP 800 ONE-HOUR RATED CORRIDOR. UPGRADE ____ INDICATES AN EXISTING MEMBRANE OF PARTITION OR _____ PARTITION TO BE REMOVED. REFER TO DEMOLITION PLAN FOR FURTHER REQUIREMENTS. INDICATES AN EXISTING PARTITION TO REMAIN. REFER TO PLAN FOR UPGRADE REQUIREMENTS. <u>_1</u> **Tri-City Medical Center** SP SP SP SP SP INDICATES AN EXISTING 1 HOUR SMOKE PARTITION 4002 Vista Way PARTITION TO REMAIN. ALL PENETRATIONS SHALL Oceanside, California 92056 BE PROTECTED WITH A UL-LISTED FIRE STOP SYSTEM. FB FB FB FB FB III INDICATES AN EXISTING ONE HOUR RATED FIRE BARRIER TO REMAIN, ALL PENETRATIONS SHALL BE TRI-CITY MEDICAL CENTER OWNER: PROTECTED WITH A UL-LISTED FIRE STOP SYSTEM. 4002 VISTA WAY OCEANSIDE, CALIFORNIA 92056 FB FB FB FB FB FB IINDICATES AN EXISTING TWO HOUR RATED FIRE BARRIER TO REMAIN, ALL PENETRATIONS SHALL BE PROTECTED WITH A UL-LISTED FIRE STOP SYSTEM. ARCHITECT: SFEIR ARCHITECTS 5151 SHOREHAM PLACE, SUITE 100 SB SB SB SB SB INDICATES A NEW 1 HOUR SMOKE BARRIER SAN DIEGO, CALIFORNIA 92122 TEL(619)299-3917 FAX(619)299-5084 INDICATES A NEW 1 HOUR SMOKE PARTITION MEP: P2S ENGINEERING, INC. FP ------ INDICATES A NEW ONE HOUR RATED FIRE PARTITION 9665 CHESAPEAKE DRIVE, SUITE 230 EXTENDING TO THE UNDERSIDE OF THE STRUCTURE SAN DIEGO, CA 92123 ABOVE. ALL PENETRATIONS SHALL BE PROTECTED TEL(619)618-2347 WITH A UL-LISTED FIRE STOP SYSTEM. STRUCTURAL: SUN STRUCTURAL ENGINEERING EXTENDING TO THE UNDERSIDE OF THE STRUCTURE 2091 LAS PALMAS DRIVE, SUITE D ABOVE. ALL PENETRATIONS SHALL BE PROTECTED CARLSBAD, CA 92011 WITH A UL-LISTED FIRE STOP SYSTEM. TEL(760)438-1188 THICK LINE INDICATES NEW SURFACE FINISH. INDICATES AN EXISTING STRUCTURAL CONSTRUCT WALL TO REMAIN. LOCATE REINFORCING STEEL AND OBTAIN APPROVAL FROM STRUCTURAL ENGINEER PRIOR TO CORING AND/ OR CUTTING. WALL TYPE REFERENCE REFER TO SHEET A5-10. $\prec x >$ No. C 28543 🗖 PARTITION NOTES: A PRA 1-31-1 1. ALL DIMENSIONS SHOWN ARE TO FINISHED FACE OF GYP. BOARD, TYPICAL U.O.N. REFER TO SHEET A5-10 FOR GENERAL NOTES AND, OF CALIF REQUIREMENTS FOR PARTITIONS. ••••• 2. EXISTING WALLS WERE CONSTRUCTED WITH MANY PERMITS AND/OR _____ 10-09-17 OSHPD COMMENTS CONTRACTS. FIELD VERIFY CONSTRUCTION AND WIDTH PRIOR TO FABRICATION OF DOOR FRAMES OR COMPONENTS WHICH REQUIRE THE WIDTH OF WALL TO BE SET. 10-09-17 DESIGN CHANGES 12-11-17 OSHPD COMMENTS DESIGN CHANGES 12-11-17 PHARMACY FLOOR PLAN KEYNOTES: $\sim\sim\sim\sim$ 5-15-18 OSHPD COMMENTS $\sim \sim \sim \sim$ (1) REMOVE EXISTING SIGNAGE AND ADD NEW SIGNAGE PER DETAIL 2/A1-04. DESIGN CHANGES 6-05-18 3 (2) 60" WIDE BY 56" DEEP SPACE. DATE: REV: DESCRIPTION: CONSULTANT OSHPD APPROVAL STAMP: OSHPD #: S171641-37-00 SHEET TITLE: PHARMACY FLOOR PLAN

PROJECT TITLE: TCMC USP 800

PROJECT #: 01667.00 DRAWN BY: CHECKED B $\frac{1}{4"} = 1' - 0"$ DATE: 07/31/17

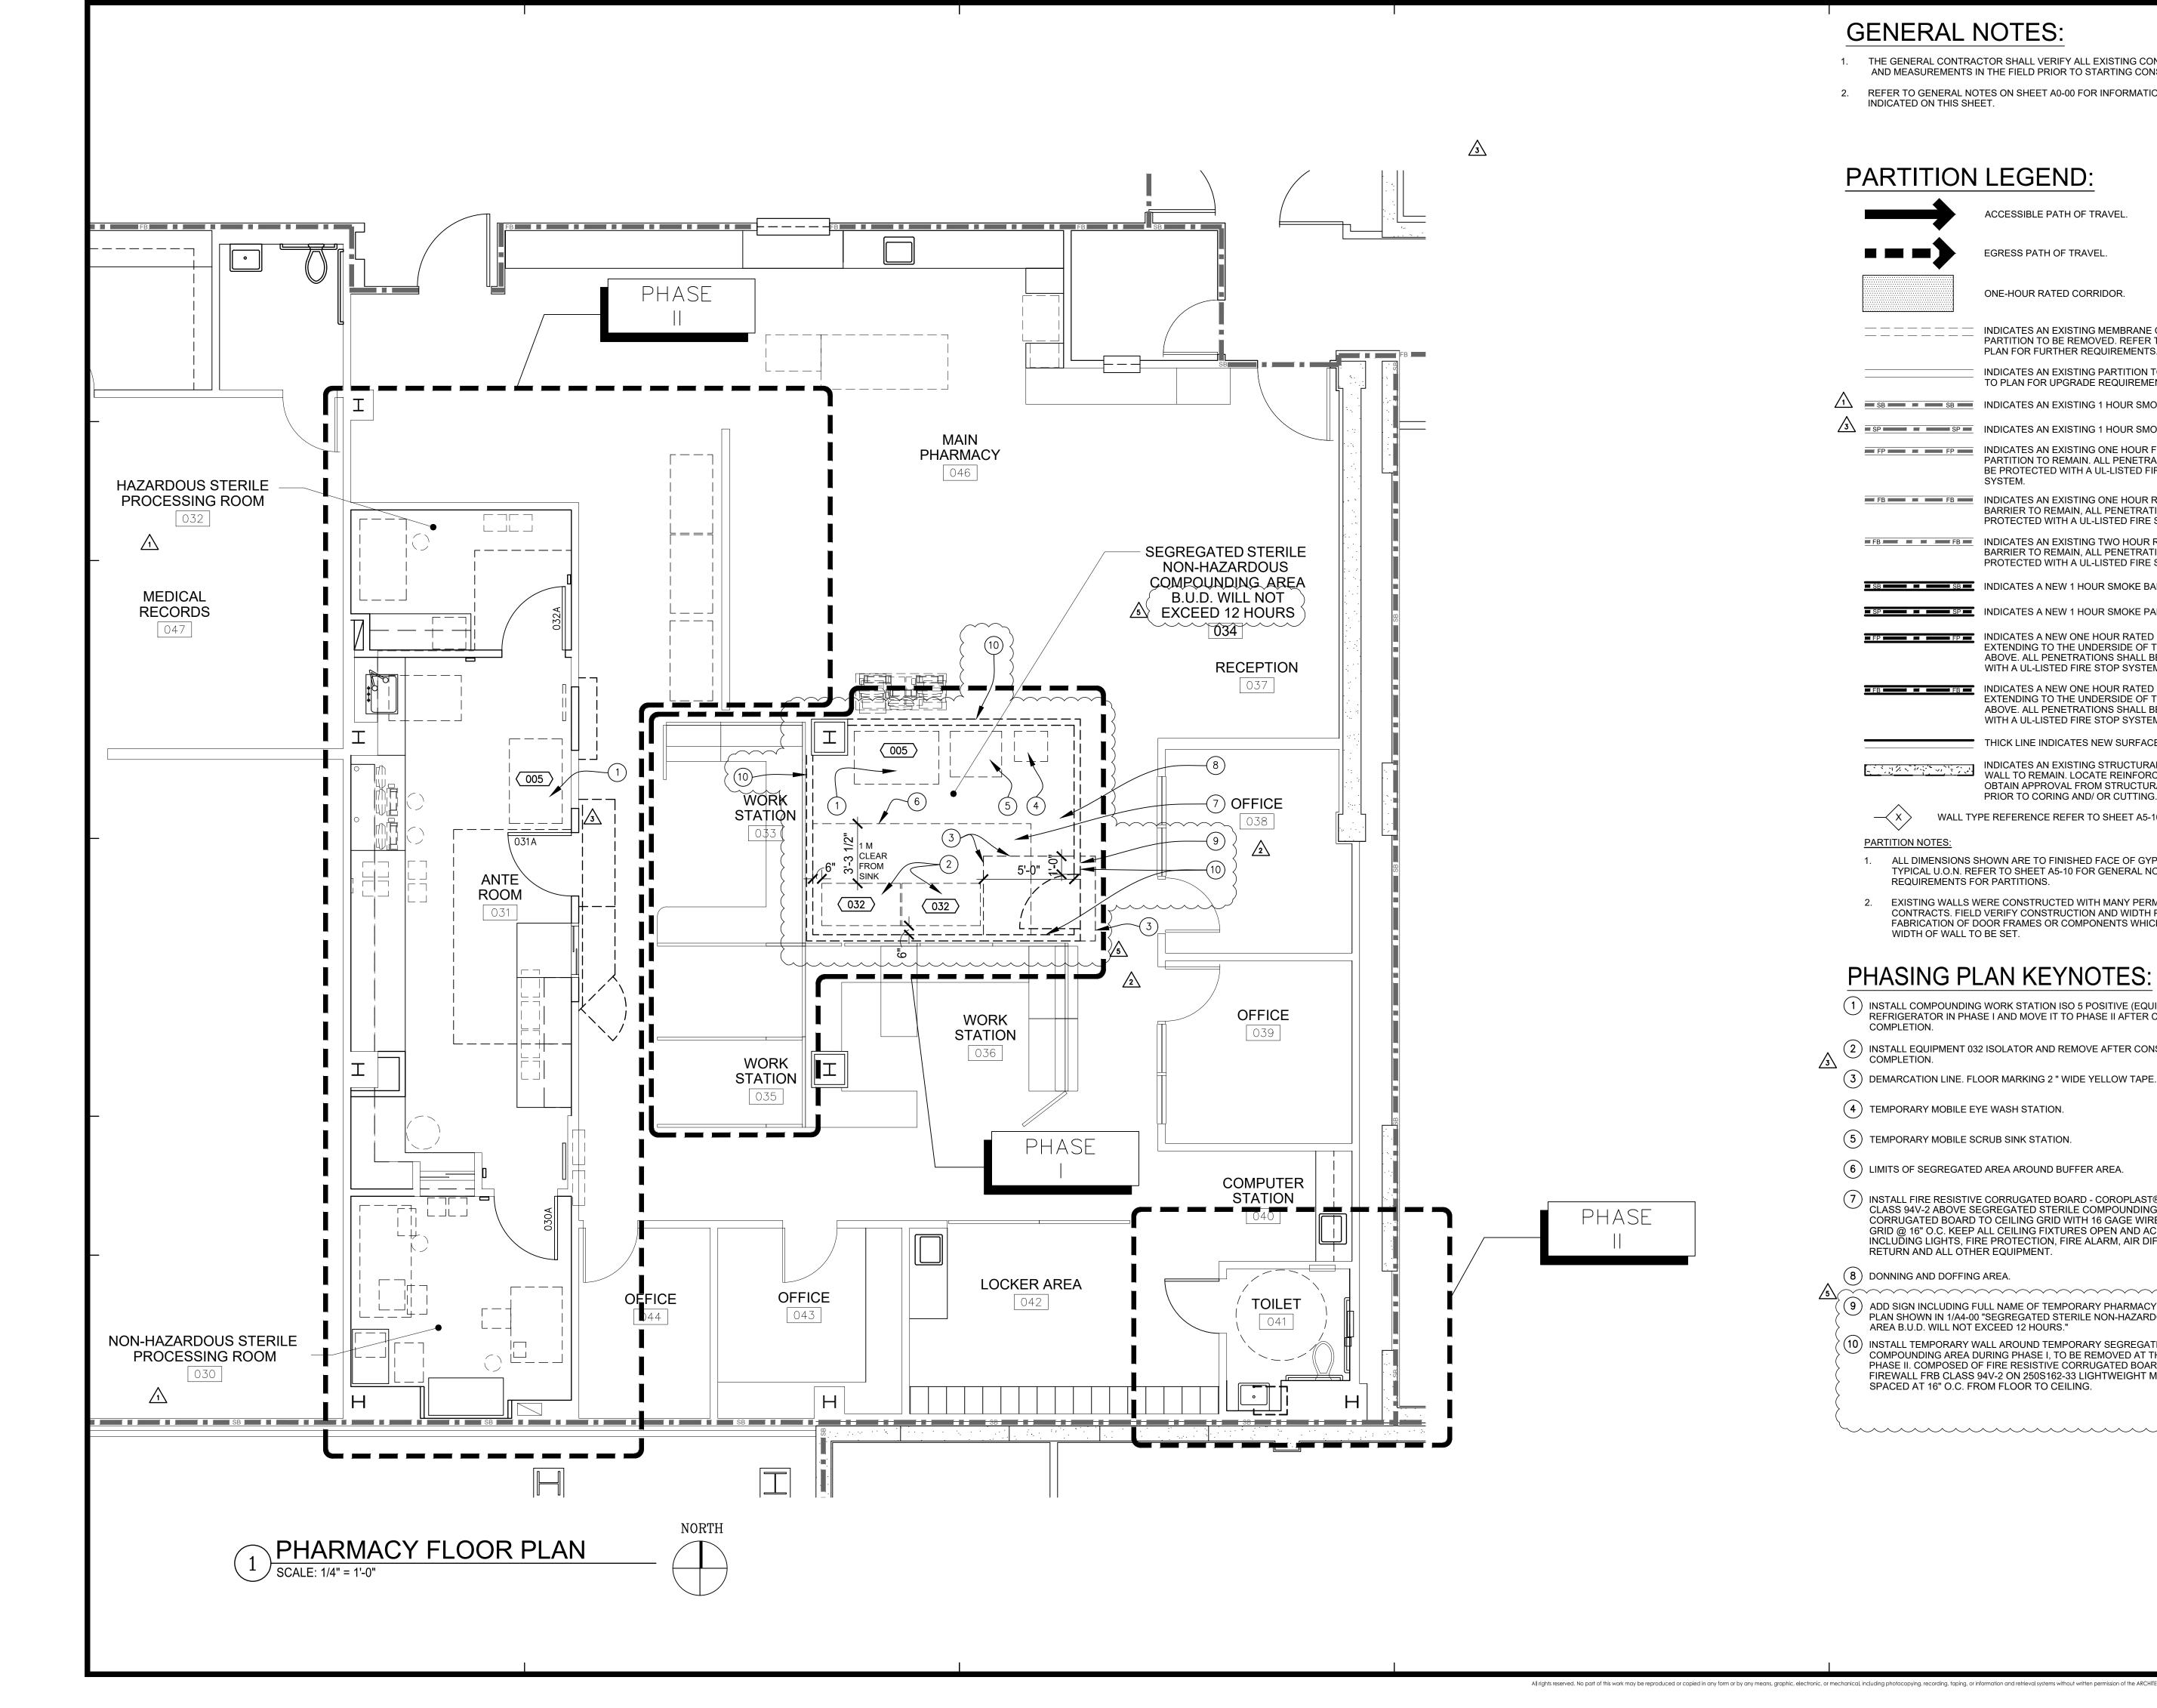

GENERAL NOTES:

- 1. THE GENERAL CONTRACTOR SHALL VERIFY ALL EXISTING CONDITIONS AND MEASUREMENTS IN THE FIELD PRIOR TO STARTING CONSTRUCTION.
- 2. REFER TO GENERAL NOTES ON SHEET A0-00 FOR INFORMATION NOT INDICATED ON THIS SHEET.

PARTITION LEGEND:

	\rightarrow	ACCESSIBLE PATH OF TRAVEL.
	>	EGRESS PATH OF TRAVEL.
		ONE-HOUR RATED CORRIDOR.
		INDICATES AN EXISTING MEMBRANE OF PARTITION OR PARTITION TO BE REMOVED. REFER TO DEMOLITION PLAN FOR FURTHER REQUIREMENTS.
		INDICATES AN EXISTING PARTITION TO REMAIN. REFER TO PLAN FOR UPGRADE REQUIREMENTS.
\triangle	SB SB SB SB SB	INDICATES AN EXISTING 1 HOUR SMOKE BARRIER
3	SP SP SP SP SP	INDICATES AN EXISTING 1 HOUR SMOKE PARTITION
	FP FP FP	INDICATES AN EXISTING ONE HOUR FIRE RATED PARTITION TO REMAIN. ALL PENETRATIONS SHALL BE PROTECTED WITH A UL-LISTED FIRE STOP SYSTEM.
	FB FB FB FB FB	INDICATES AN EXISTING ONE HOUR RATED FIRE BARRIER TO REMAIN, ALL PENETRATIONS SHALL BE PROTECTED WITH A UL-LISTED FIRE STOP SYSTEM.
	EFB FB FFB FFB FFB FFB	INDICATES AN EXISTING TWO HOUR RATED FIRE BARRIER TO REMAIN, ALL PENETRATIONS SHALL BE PROTECTED WITH A UL-LISTED FIRE STOP SYSTEM.
	SB SB SB	INDICATES A NEW 1 HOUR SMOKE BARRIER
	SP SP SP SP SP SP	INDICATES A NEW 1 HOUR SMOKE PARTITION
	EFP E FP FP	INDICATES A NEW ONE HOUR RATED FIRE PARTITION EXTENDING TO THE UNDERSIDE OF THE STRUCTURE ABOVE. ALL PENETRATIONS SHALL BE PROTECTED WITH A UL-LISTED FIRE STOP SYSTEM.
		INDICATES A NEW ONE HOUR RATED FIRE BARRIER EXTENDING TO THE UNDERSIDE OF THE STRUCTURE ABOVE. ALL PENETRATIONS SHALL BE PROTECTED WITH A UL-LISTED FIRE STOP SYSTEM.
		THICK LINE INDICATES NEW SURFACE FINISH.
		INDICATES AN EXISTING STRUCTURAL CONCRETE WALL TO REMAIN. LOCATE REINFORCING STEEL AND OBTAIN APPROVAL FROM STRUCTURAL ENGINEER PRIOR TO CORING AND/ OR CUTTING.

WALL TYPE REFERENCE REFER TO SHEET A5-10.

PARTITION NOTES:

 $-\langle x \rangle$

 $\sqrt{3}$

- 1. ALL DIMENSIONS SHOWN ARE TO FINISHED FACE OF GYP. BOARD, TYPICAL U.O.N. REFER TO SHEET A5-10 FOR GENERAL NOTES AND, REQUIREMENTS FOR PARTITIONS.
- 2. EXISTING WALLS WERE CONSTRUCTED WITH MANY PERMITS AND/OR CONTRACTS. FIELD VERIFY CONSTRUCTION AND WIDTH PRIOR TO FABRICATION OF DOOR FRAMES OR COMPONENTS WHICH REQUIRE THE WIDTH OF WALL TO BE SET.

PHASING PLAN KEYNOTES:

- 1 INSTALL COMPOUNDING WORK STATION ISO 5 POSITIVE (EQUIPMENT 005) -REFRIGERATOR IN PHASE I AND MOVE IT TO PHASE II AFTER CONSTRUCTION COMPLETION.
- (2) INSTALL EQUIPMENT 032 ISOLATOR AND REMOVE AFTER CONSTRUCTION COMPLETION.
- (3) DEMARCATION LINE. FLOOR MARKING 2 " WIDE YELLOW TAPE.
- (4) TEMPORARY MOBILE EYE WASH STATION.
- (5) TEMPORARY MOBILE SCRUB SINK STATION.
- (6) LIMITS OF SEGREGATED AREA AROUND BUFFER AREA.
- (7) INSTALL FIRE RESISTIVE CORRUGATED BOARD COROPLAST® FIREWALL FRB CLASS 94V-2 ABOVE SEGREGATED STERILE COMPOUNDING AREA. SECURE CORRUGATED BOARD TO CEILING GRID WITH 16 GAGE WIRE TIE TO CEILING GRID @ 16" O.C. KEEP ALL CEILING FIXTURES OPEN AND ACCESSIBLE INCLUDING LIGHTS, FIRE PROTECTION, FIRE ALARM, AIR DIFFUSERS AND RETURN AND ALL OTHER EQUIPMENT.

(8) DONNING AND DOFFING AREA.

- (9) ADD SIGN INCLUDING FULL NAME OF TEMPORARY PHARMACY ROOM NAME PER PLAN SHOWN IN 1/A4-00 "SEGREGATED STERILE NON-HAZARDOUS COMPOUNDING" AREA B.U.D. WILL NOT EXCEED 12 HOURS."
- (10) INSTALL TEMPORARY WALL AROUND TEMPORARY SEGREGATED STERILE COMPOUNDING AREA DURING PHASE I, TO BE REMOVED AT THE COMPLETION OF PHASE II. COMPOSED OF FIRE RESISTIVE CORRUGATED BOARD - COROPLAST® FIREWALL FRB CLASS 94V-2 ON 250S162-33 LIGHTWEIGHT METAL STUDS SPACED AT 16" O.C. FROM FLOOR TO CEILING.

C	F	F	ł	
S	F	Ε	I	R
A R	СНІ	ΤI	E C	T S
5151 Shorek San Diego,	nam Place, Su Ca 92122	uite 100		
P: 619-299 F: 619-299 www.sfeirarc	9–5084			
US UP	ARN P 80 GRA)0 \DE		
Tri-C	ity Mo	edica	al C	enter
4002 Vis Oceansio	ta Way de, Califorr	nia 9205	56	
OWNER:	4002 VIST	IEDICAL CE A WAY , CALIFORN		
ARCHITECT:	SFEIR ARC 5151 SHOR	HITECTS REHAM PLAC	CE, SUITE	100

SAN DIEGO, CALIFORNIA 92122

P2S ENGINEERING, INC.

SAN DIEGO, CA 92123 TEL(619)618-2347

CARLSBAD, CA 92011

TEL(760)438-1188

No. C 28543

1-35

OF CALLES

OSHPD COMMENTS

DESIGN CHANGES

OSHPD COMMENTS

DESIGN CHANGES

OSHPD COMMENTS

DESIGN CHANGES

CONSULTANT

REV: DESCRIPTION:

OSHPD APPROVAL STAMP:

OSHPD #: S171641-37-00

SA PER

STRUCTURAL: SUN STRUCTURAL ENGINEERING

MEP:

TEL(619)299-3917 FAX(619)299-5084

9665 CHESAPEAKE DRIVE, SUITE 230

2091 LAS PALMAS DRIVE, SUITE D

•••••

10-09-17

10-09-17

12-11-17

12-11-17

 \sim

5–15–18 <

6-05-18 <

~ ~ ~ ~ ~ /

 \sim

DATE:

SHEET TITLE:	
PHASING	
PLAN	

PROJECT TITLE: TCMC USP 800

DATE:


PROJECT # 01667.00 DRAWN BY: CHECKED BY $\overline{\text{SCALE:}} \quad 1/4" = 1'-0"$

SHEET NUMB



100% CONSTRUCTION DOCUMENT

07/31/17

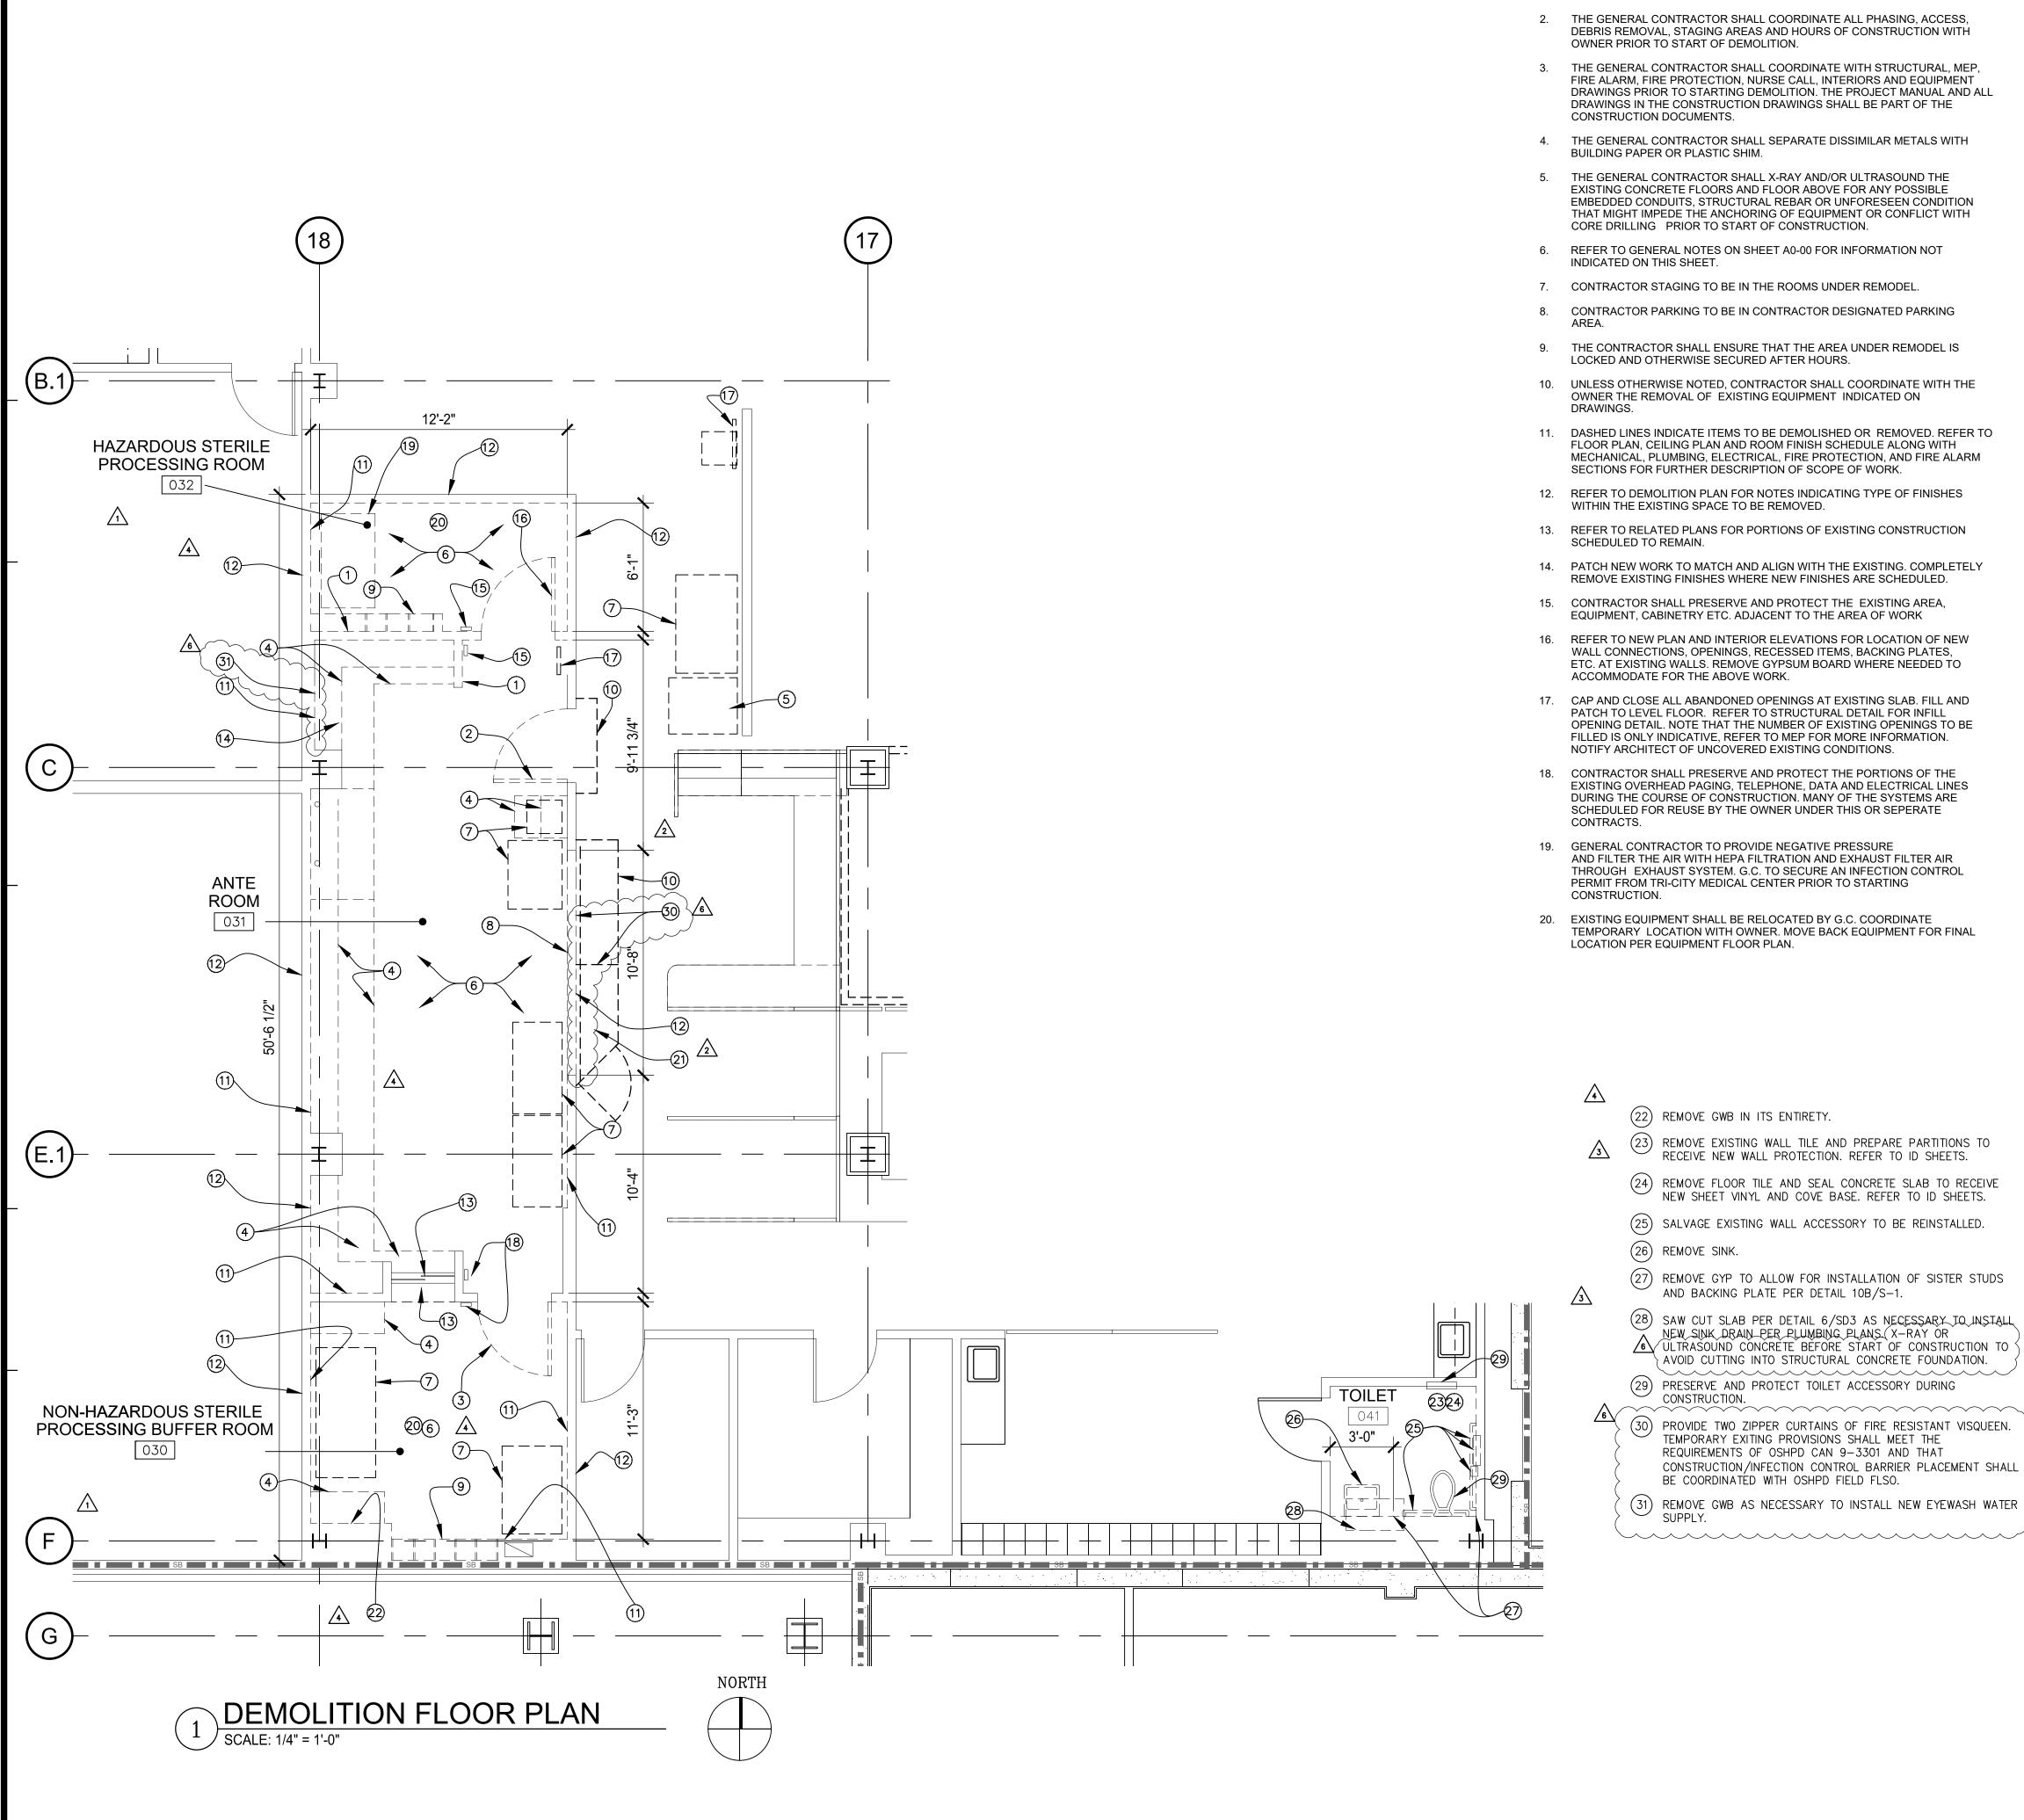

DEMOLITION GENERAL NOTES:

- 1. THE GENERAL CONTRACTOR SHALL VERIFY ALL EXISTING CONDITIONS AND MEASUREMENTS IN THE FIELD PRIOR TO STARTING DEMOLITION.
- 2. THE GENERAL CONTRACTOR SHALL COORDINATE ALL PHASING, ACCESS, DEBRIS REMOVAL. STAGING AREAS AND HOURS OF CONSTRUCTION WITH
- 3. THE GENERAL CONTRACTOR SHALL COORDINATE WITH STRUCTURAL, MEP, FIRE ALARM, FIRE PROTECTION, NURSE CALL, INTERIORS AND EQUIPMENT DRAWINGS PRIOR TO STARTING DEMOLITION. THE PROJECT MANUAL AND ALL DRAWINGS IN THE CONSTRUCTION DRAWINGS SHALL BE PART OF THE
- 4. THE GENERAL CONTRACTOR SHALL SEPARATE DISSIMILAR METALS WITH
- THE GENERAL CONTRACTOR SHALL X-RAY AND/OR ULTRASOUND THE EXISTING CONCRETE FLOORS AND FLOOR ABOVE FOR ANY POSSIBLE EMBEDDED CONDUITS, STRUCTURAL REBAR OR UNFORESEEN CONDITION THAT MIGHT IMPEDE THE ANCHORING OF EQUIPMENT OR CONFLICT WITH CORE DRILLING PRIOR TO START OF CONSTRUCTION.
- 6. REFER TO GENERAL NOTES ON SHEET A0-00 FOR INFORMATION NOT
- 7. CONTRACTOR STAGING TO BE IN THE ROOMS UNDER REMODEL
- 8. CONTRACTOR PARKING TO BE IN CONTRACTOR DESIGNATED PARKING
- 9. THE CONTRACTOR SHALL ENSURE THAT THE AREA UNDER REMODEL IS LOCKED AND OTHERWISE SECURED AFTER HOURS.
- 10. UNLESS OTHERWISE NOTED, CONTRACTOR SHALL COORDINATE WITH THE OWNER THE REMOVAL OF EXISTING EQUIPMENT INDICATED ON
- 11. DASHED LINES INDICATE ITEMS TO BE DEMOLISHED OR REMOVED. REFER TO FLOOR PLAN, CEILING PLAN AND ROOM FINISH SCHEDULE ALONG WITH MECHANICAL, PLUMBING, ELECTRICAL, FIRE PROTECTION, AND FIRE ALARM SECTIONS FOR FURTHER DESCRIPTION OF SCOPE OF WORK.
- 12. REFER TO DEMOLITION PLAN FOR NOTES INDICATING TYPE OF FINISHES WITHIN THE EXISTING SPACE TO BE REMOVED.
- 13. REFER TO RELATED PLANS FOR PORTIONS OF EXISTING CONSTRUCTION
- 14. PATCH NEW WORK TO MATCH AND ALIGN WITH THE EXISTING. COMPLETELY REMOVE EXISTING FINISHES WHERE NEW FINISHES ARE SCHEDULED.
- 15. CONTRACTOR SHALL PRESERVE AND PROTECT THE EXISTING AREA, EQUIPMENT, CABINETRY ETC. ADJACENT TO THE AREA OF WORK
- 16. REFER TO NEW PLAN AND INTERIOR ELEVATIONS FOR LOCATION OF NEW WALL CONNECTIONS, OPENINGS, RECESSED ITEMS, BACKING PLATES, ETC. AT EXISTING WALLS. REMOVE GYPSUM BOARD WHERE NEEDED TO ACCOMMODATE FOR THE ABOVE WORK.
- 17. CAP AND CLOSE ALL ABANDONED OPENINGS AT EXISTING SLAB. FILL AND PATCH TO LEVEL FLOOR. REFER TO STRUCTURAL DETAIL FOR INFILL OPENING DETAIL. NOTE THAT THE NUMBER OF EXISTING OPENINGS TO BE FILLED IS ONLY INDICATIVE, REFER TO MEP FOR MORE INFORMATION. NOTIFY ARCHITECT OF UNCOVERED EXISTING CONDITIONS.
- 18. CONTRACTOR SHALL PRESERVE AND PROTECT THE PORTIONS OF THE EXISTING OVERHEAD PAGING, TELEPHONE, DATA AND ELECTRICAL LINES DURING THE COURSE OF CONSTRUCTION. MANY OF THE SYSTEMS ARE SCHEDULED FOR REUSE BY THE OWNER UNDER THIS OR SEPERATE
- 19. GENERAL CONTRACTOR TO PROVIDE NEGATIVE PRESSURE AND FILTER THE AIR WITH HEPA FILTRATION AND EXHAUST FILTER AIR THROUGH EXHAUST SYSTEM. G.C. TO SECURE AN INFECTION CONTROL PERMIT FROM TRI-CITY MEDICAL CENTER PRIOR TO STARTING
- 20. EXISTING EQUIPMENT SHALL BE RELOCATED BY G.C. COORDINATE TEMPORARY LOCATION WITH OWNER. MOVE BACK EQUIPMENT FOR FINAL LOCATION PER EQUIPMENT FLOOR PLAN.

GENERAL NOTES:

- THE GENERAL CONTRACTOR SHALL VERIFY ALL EXISTING CONDITIONS AND MEASUREMENTS IN THE FIELD PRIOR TO STARTING CONSTRUCTION.
- 2. REFER TO GENERAL NOTES ON SHEET A0-00 FOR INFORMATION NOT INDICATED ON THIS SHEET.

PARTITION LEGEND:

ACCESSIBLE PATH OF TRAVEL. EGRESS PATH OF TRAVEL. ONE-HOUR RATED CORRIDOR. _____ _____

	SYSTEM.
FB FB FB	INDICATES AN EXIS BARRIER TO REMA PROTECTED WITH
EFB FB FB FB FB	INDICATES AN EXIS BARRIER TO REMA PROTECTED WITH
SB SB SB SB SB	INDICATES A NEW
SP SP SP	INDICATES A NEW
	INDICATES A NEW EXTENDING TO TH ABOVE. ALL PENE ⁻ WITH A UL-LISTED
	INDICATES A NEW EXTENDING TO TH ABOVE. ALL PENET WITH A UL-LISTED
	THICK LINE INDICA
	INDICATES AN EXIS

INDICATES AN EXISTING MEMBRANE OF PARTITION OR PARTITION TO BE REMOVED. REFER TO DEMOLITION PLAN FOR FURTHER REQUIREMENTS. INDICATES AN EXISTING PARTITION TO REMAIN. REFER TO PLAN FOR UPGRADE REQUIREMENTS. SB - SB - SB - SB - INDICATES AN EXISTING 1 HOUR SMOKE BARRIER 3 = SP = SP = INDICATES AN EXISTING 1 HOUR SMOKE PARTITION FP FP FP FP FP INDICATES AN EXISTING ONE HOUR FIRE RATED PARTITION TO REMAIN. ALL PENETRATIONS SHALL BE PROTECTED WITH A UL-LISTED FIRE STOP STING ONE HOUR RATED FIRE AIN, ALL PENETRATIONS SHALL BE A UL-LISTED FIRE STOP SYSTEM. STING TWO HOUR RATED FIRE AIN, ALL PENETRATIONS SHALL BE A UL-LISTED FIRE STOP SYSTEM.

1 HOUR SMOKE BARRIER

1 HOUR SMOKE PARTITION

ONE HOUR RATED FIRE PARTITION IE UNDERSIDE OF THE STRUCTURE TRATIONS SHALL BE PROTECTED FIRE STOP SYSTEM.

ONE HOUR RATED FIRE BARRIER IE UNDERSIDE OF THE STRUCTURE TRATIONS SHALL BE PROTECTED FIRE STOP SYSTEM.

ATES NEW SURFACE FINISH.

STING STRUCTURAL CONCRETE . LOCATE REINFORCING STEEL AND OBTAIN APPROVAL FROM STRUCTURAL ENGINEER PRIOR TO CORING AND/ OR CUTTING.

WALL TYPE REFERENCE REFER TO SHEET A5-10. $-\langle x \rangle$

PARTITION NOTES

ALL DIMENSIONS SHOWN ARE TO FINISHED FACE OF GYP. BOARD, TYPICAL U.O.N. REFER TO SHEET A5-10 FOR GENERAL NOTES AND REQUIREMENTS FOR PARTITIONS.

2. EXISTING WALLS WERE CONSTRUCTED WITH MANY PERMITS AND/OR CONTRACTS. FIELD VERIFY CONSTRUCTION AND WIDTH PRIOR TO FABRICATION OF DOOR FRAMES OR COMPONENTS WHICH REQUIRE THE WIDTH OF WALL TO BE SET.

DEMOLITION KEYNOTES:

		$\left(1\right)$	REMOVE EXISTING PARTITION IN ITS ENTIRETY.
	•	2	REMOVE EXISTING DOOR AND FRAME.
	6	-3	REMOVE DOOR. FRAME TO REMAIN.
<u>_6</u>	6	4	REMOVE EXISTING BASE AND OVERHEAD CABINETS IN THEIR ENTIRETY INSIDE THE PHARMACY.
		5	REMOVE EXISTING EQUIPMENT. RETURN EQUIPMENT NOT TO BE RELOCATED TO OWNER.
		6	REMOVE EXISTING FLOOR FINISHES AND BASE.
		7	REMOVE EXISTING EQUIPMENT AND SALVAGE. SEE A6-20 FOR NEW LOCATIONS. RETURN EQUIPMENT NOT TO BE RELOCATED TO OWNER.
		8	CUT OPENING IN EXISTING WALL FOR NEW DOOR AND SLIDING WINDOW.
	$\sqrt{2}$	9	REMOVE EXISTING MILLWORK.
<u>/2</u>	<u></u>	10	FIRE RESISTIVE CORRUGATED BOARD – Coroplast®Firewall FRB Class 94V–2. TEMPORARY EXITING PROVISIONS SHALL MEET THE REQUIREMENTS OF OSHPD CAN 9–3301 AND THAT CONSTRUCTION/INFECTION CONTROL BARRIER PLACEMENT SHALL BE COORDINATED WITH OSHPD FIELD FLSO. SEPARATE CONSTRUCTION AREA FROM ADJACENT OCCUPIED SPACE ABOVE CEILING WITH FIRE RESISTIVE VISQUEEN.
Ş		(11)	REMOVE EXISTING GWB AS NEEDED TO INSTALL BACKING PLATE. \bigtriangleup
)		(12)	ERECT AND TIGHTLY SEAL FROM TOP OF PARTITION TO UNDERSIDE OF DECK WITH VISQUEEN. TAPE ALL EDGES TO STOP AIR LEAKAGE.
6		13	SLIDING WINDOW & WALL FRAMING TO REMAIN. REMOVE CORIAN COUNTER TO IN IV PREP ROM & REPLACE WITH STAINLESS STEEL COUNTER TOP. REMOVE PLASTIC LAMINATED SHELVING & COUNTER TOP & REPLACE WITH STAINLESS STEEL CABINET & COUNTER.
		(14)	REMOVE SINK & EYE WASH.
		(15)	SALVAGE DOOR OPERATOR & SENSOR PLATE TO REINSTALL.
	(16)	REMOVE DOOR. SALVAGE FRAME TO REINSTALL, PRIME & PAINT.	
		(17)	REMOVE WALL MOUNTED BOARD TO TURN OVER TO OWNER.
		(18)	EXISTING DOOR OPERATOR TO REMAIN.
		(19)	REMOVE EXISTING EQUIPMENT & DISCARD.
Ĺ	2	20	REMOVE WALL PROTECTION.
<u> </u>	(21)	INFECTION CONTROL ANTEROOM.	

S A R C H I T E C T S

5151 Shoreham Place, Suite 100 San Diego, Ca 92122

P: 619-299-3917 F: 619-299-5084 www.sfeirarch.com

TCMC PHARMACY **USP 800** UPGRADE

Tri-City Medical Center

4002 Vista Way Oceanside, California 92056			
OWNER:	TRI-CITY MEDICAL CENTER 4002 VISTA WAY OCEANSIDE, CALIFORNIA 92056		
ARCHITECT:	SFEIR ARCHITECTS 5151 SHOREHAM PLACE, SUITE 100 SAN DIEGO, CALIFORNIA 92122 TEL(619)299–3917 FAX(619)299–5084		
MEP:	P2S ENGINEERING, INC. 9665 CHESAPEAKE DRIVE, SUITE 230 SAN DIEGO, CA 92123 TEL(619)618–2347		
STRUCTURAL:	SUN STRUCTURAL ENGINEERING 2091 LAS PALMAS DRIVE, SUITE D CARLSBAD, CA 92011 TEL(760)438–1188		

· · · ·	SED RH NICHON No. C 28543 70 ★ ROL 1-31-19 NOF CALIFORNIA OF CALIFORNIA	
	OSHPD COMMENTS	10-09-17
$\frac{2}{2}$	DESIGN CHANGES	10-09-17
$\frac{\sqrt{3}}{\sqrt{3}}$	OSHPD COMMENTS	12-11-17
	DESIGN CHANGES	12-11-17
5	OSHPD COMMENTS	5-15-18
	DESIGN CHANGES	6-05-18
REV:	DESCRIPTION:	DATE:
CONSUL	TANT	

OSHPD APPROVAL STAMP: OSHPD #: S171641-37-00

SHEET TITLE: DEMOLITION **FLOOR PLAN**

PROJECT TITLE: TCMC USP 800


PROJECT #: 01667.00 DRAWN BY: CHECKED BY

SCALE: 1/4" = 1'-0"

DATE:

100% CONSTRUCTION DOCUMENT

07/31/17

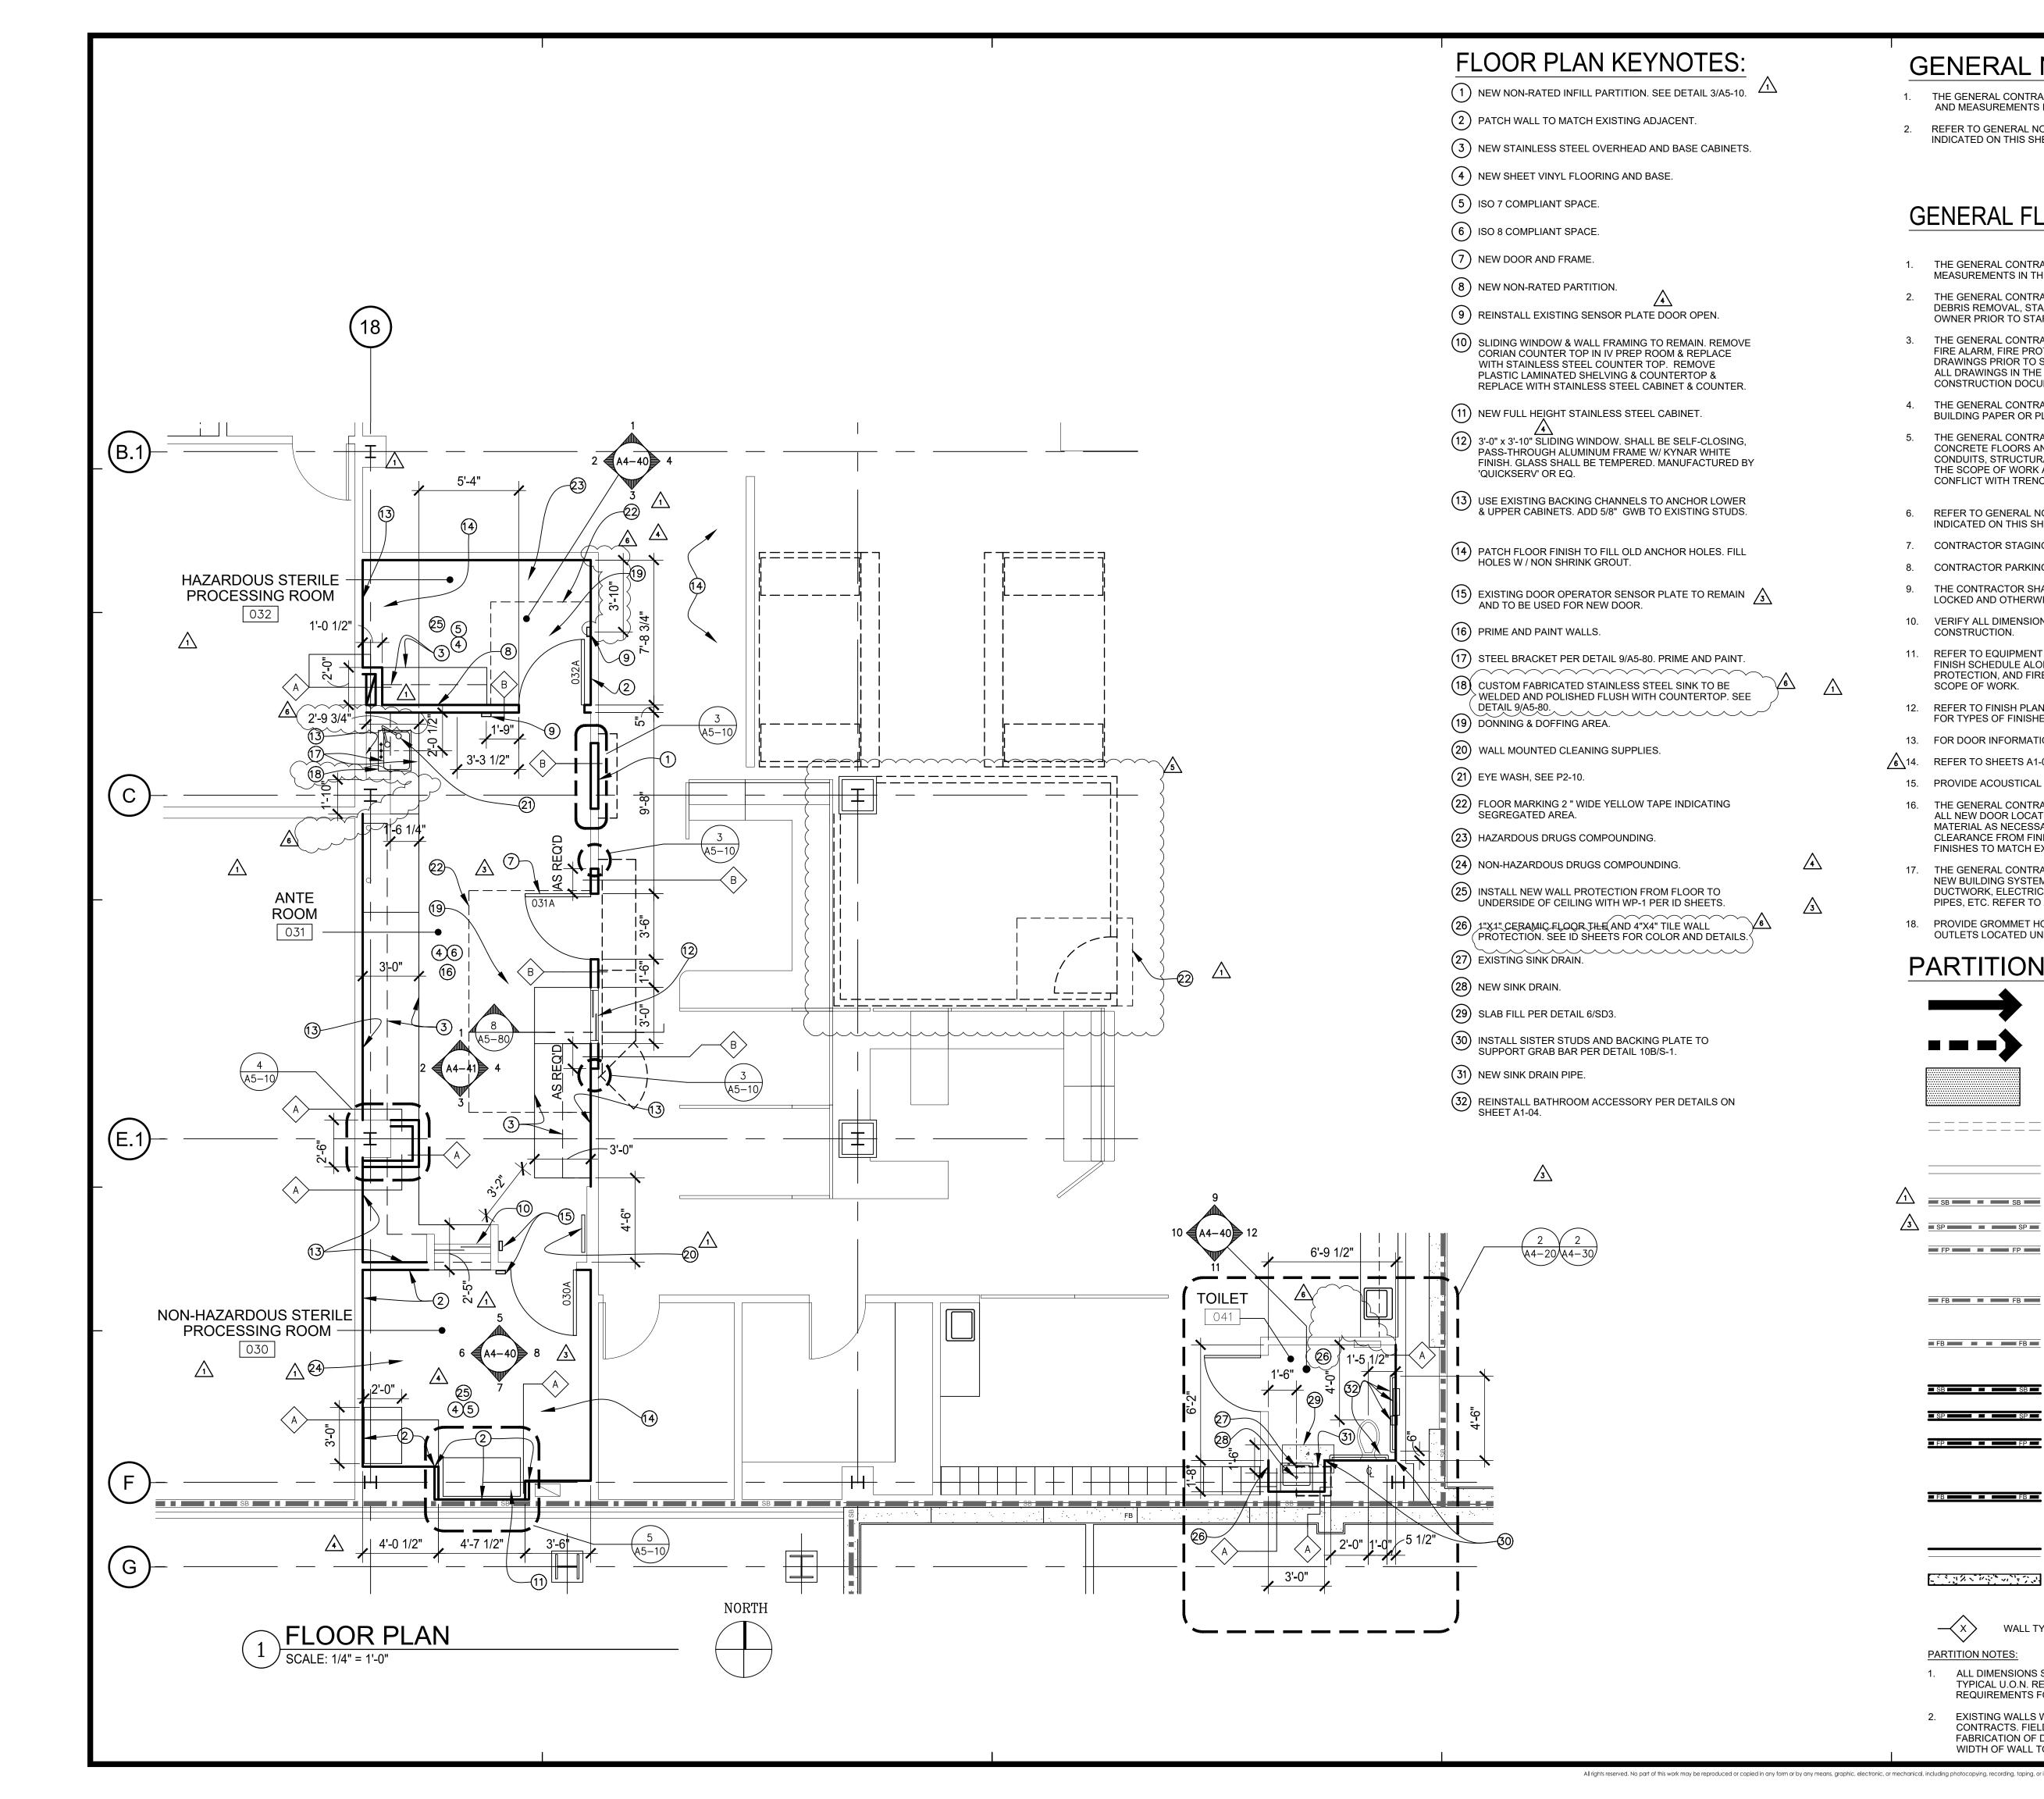


G	ENERAL	NOTES:	S F	EIR
1.		ACTOR SHALL VERIFY ALL EXISTING CONDITIONS IN THE FIELD PRIOR TO STARTING CONSTRUCTION.	A R C	HITECTS
2.	REFER TO GENERAL NO INDICATED ON THIS SH	DTES ON SHEET A0-00 FOR INFORMATION NOT EET.	5151 Shoreham San Diego, Ca S	Place, Suite 100 92122
			P: 619-299-39	
G	ENERAL FL	OOR PLAN NOTES:	F: 619-299-50 www.sfeirarch.co	m
1.		ACTOR SHALL VERIFY ALL EXISTING CONDITIONS AND IE FIELD PRIOR TO STARTING CONSTRUCTION.	TCM	C
2.	DEBRIS REMOVAL, STA	ACTOR SHALL COORDINATE ALL PHASING, ACCESS, AGING AREAS AND HOURS OF CONSTRUCTION WITH RT OF CONSTRUCTION.		RMACY
3.	FIRE ALARM, FIRE PRO DRAWINGS PRIOR TO S	ACTOR SHALL COORDINATE WITH STRUCTURAL, MEP, ITECTION, NURSE CALL, INTERIORS AND EQUIPMENT STARTING CONSTRUCTION. THE PROJECT MANUAL AND CONSTRUCTION DRAWINGS SHALL BE PART OF THE IMENTS.	USP UPG	800 RADE
4.	THE GENERAL CONTRA BUILDING PAPER OR P	ACTOR SHALL SEPARATE DISSIMILAR METALS WITH LASTIC SHIM.		
5.	CONCRETE FLOORS AI CONDUITS, STRUCTUR THE SCOPE OF WORK	ACTOR SHALL X-RAY AND/OR ULTRASOUND THE EXISTING ND FLOOR ABOVE FOR ANY POSSIBLE EMBEDDED AL REBAR OR UNFORESEEN CONDITION THAT IS OUTSIDE AND MIGHT IMPEDE THE ANCHORING OF EQUIPMENT OR CHING PRIOR TO CONSTRUCTION.		y Medical Center
6.	INDICATED ON THIS SH		4002 Vista V Oceanside, (Vay California 92056
7. 8.		G TO BE IN THE ROOMS UNDER REMODEL. G TO BE IN CONTRACTOR DESIGNATED PARKING AREA.		RI-CITY MEDICAL CENTER
9.		ALL ENSURE THAT THE AREA UNDER REMODEL IS ISE SECURED AFTER HOURS.		002 VISTA WAY CEANSIDE, CALIFORNIA 92056
10. 11.	CONSTRUCTION.	NS WITH EQUIPMENT SCHEDULE PRIOR TO START OF PLAN, CEILING PLAN, INTERIOR ELEVATIONS AND ROOM	5 S	FEIR ARCHITECTS 151 SHOREHAM PLACE, SUITE 100 AN DIEGO, CALIFORNIA 92122
	FINISH SCHEDULE ALO PROTECTION, AND FIR SCOPE OF WORK.	NG WITH MECHANICAL, ELECTRICAL, PLUMBING, FIRE E ALARM SECTIONS FOR FURTHER DESCRIPTION OF	MEP: P 9	EL(619)299–3917 FAX(619)299–5084 2S ENGINEERING, INC. 665 CHESAPEAKE DRIVE, SUITE 230
12.	FOR TYPES OF FINISHE			AN DIEGO, CA 92123 EL(619)618–2347
13. 14. 15.	REFER TO SHEETS A1-	ON REFER TO DOOR SCHEDULE, SHEET A6-00. 00 AND A1-04 FOR ACCESSIBILITY REQUIREMENTS. INSULATION IN ALL NEW WALL ASSEMBLIES.	2 C	UN STRUCTURAL ENGINEERING 091 LAS PALMAS DRIVE, SUITE D ARLSBAD, CA 92011 EL(760)438–1188
16.	ALL NEW DOOR LOCAT MATERIAL AS NECESS	ACTOR SHALL VERIFY THE LEVELNESS OF THE SLAB AT TONS PRIOR TO CONSTRUCTION. APPLY LEVELING ARY DURING CONSTRUCTION TO ACHIEVE MAX. OF 3/8" IISH FLOOR TO UNDERSIDE OF NEW DOOR, REPLACE XISTING AS NEEDED.	ENSED A	
17.	THE GENERAL CONTRANEW BUILDING SYSTEM DUCTWORK, ELECTRIC	ACTOR SHALL SEISMICALLY ANCHOR ALL EXISTING AND MS ABOVE CEILING INCLUDING BUT NOT LIMITED TO CAL CONDUITS AND TRAYS, SPRINKLER PIPES, PLUMBING	₩ S No. C 285	
18.		A0-00 FOR MORE INFORMATION. OLE IN COUNTER ABOVE ALL POWER AND DATA	VA PER 1-31	.9 J
P		I LEGEND: -		
<u> </u>		ACCESSIBLE PATH OF TRAVEL.	$ \begin{array}{c c} \hline 1 \\ \hline 2 \\ \hline 3 \\ \hline $	GES 10-09-17
	>	EGRESS PATH OF TRAVEL.	4 DESIGN CHAN	
		ONE-HOUR RATED CORRIDOR.		GES 6-05-18
		INDICATES AN EXISTING MEMBRANE OF PARTITION OR PARTITION TO BE REMOVED. REFER TO DEMOLITION PLAN FOR FURTHER REQUIREMENTS.		
		INDICATES AN EXISTING PARTITION TO REMAIN. REFER TO PLAN FOR UPGRADE REQUIREMENTS.		
	SB SB SB SB	INDICATES AN EXISTING 1 HOUR SMOKE BARRIER	REV: DESCRIPTION:	DATE:
<u>_3</u>	SP S	INDICATES AN EXISTING 1 HOUR SMOKE PARTITION INDICATES AN EXISTING ONE HOUR FIRE RATED		
	FB FB	PARTITION TO REMAIN. ALL PENETRATIONS SHALL BE PROTECTED WITH A UL-LISTED FIRE STOP SYSTEM. INDICATES AN EXISTING ONE HOUR RATED FIRE	OSHPD APPROVAL STAMF	»;
	FB	BARRIER TO REMAIN, ALL PENETRATIONS SHALL BE PROTECTED WITH A UL-LISTED FIRE STOP SYSTEM.	OSHPD #:	S171641-37-00
		BARRIER TO REMAIN, ALL PENETRATIONS SHALL BE PROTECTED WITH A UL-LISTED FIRE STOP SYSTEM.		
		INDICATES A NEW 1 HOUR SMOKE BARRIER		
		INDICATES A NEW ONE HOUR RATED FIRE PARTITION EXTENDING TO THE UNDERSIDE OF THE STRUCTURE ABOVE. ALL PENETRATIONS SHALL BE PROTECTED		
	FB FB FB FB FB FB	EXTENDING TO THE UNDERSIDE OF THE STRUCTURE ABOVE. ALL PENETRATIONS SHALL BE PROTECTED	SHEET TITLE:	
		WITH A UL-LISTED FIRE STOP SYSTEM. THICK LINE INDICATES NEW SURFACE FINISH.		OOR PLAN
		INDICATES AN EXISTING STRUCTURAL CONCRETE WALL TO REMAIN. LOCATE REINFORCING STEEL AND OBTAIN APPROVAL FROM STRUCTURAL ENGINEER		
		PRIOR TO CORING AND/ OR CUTTING. (PE REFERENCE REFER TO SHEET A5-10.	PROJECT TITLE: TCMC USP 800	
	PARTITION NOTES:		PROJECT # 01667	7.00 SHEET NUMBER:
		SHOWN ARE TO FINISHED FACE OF GYP. BOARD, EFER TO SHEET A5-10 FOR GENERAL NOTES AND OR PARTITIONS.	DRAWN BY:	MK
	CONTRACTS. FIEL	WERE CONSTRUCTED WITH MANY PERMITS AND/OR D VERIFY CONSTRUCTION AND WIDTH PRIOR TO	$\frac{\text{CHECKED BY:}}{\text{SCALE:}} 1/4" = 1$	<u>Js</u> A4-10

EXISTING WALLS WERE CONSTRUCTED WITH MANY PERMITS AND/OR CONTRACTS. FIELD VERIFY CONSTRUCTION AND WIDTH PRIOR TO FABRICATION OF DOOR FRAMES OR COMPONENTS WHICH REQUIRE THE WIDTH OF WALL TO BE SET.

100% CONSTRUCTION DOCUMENT


07/31/17

DATE:

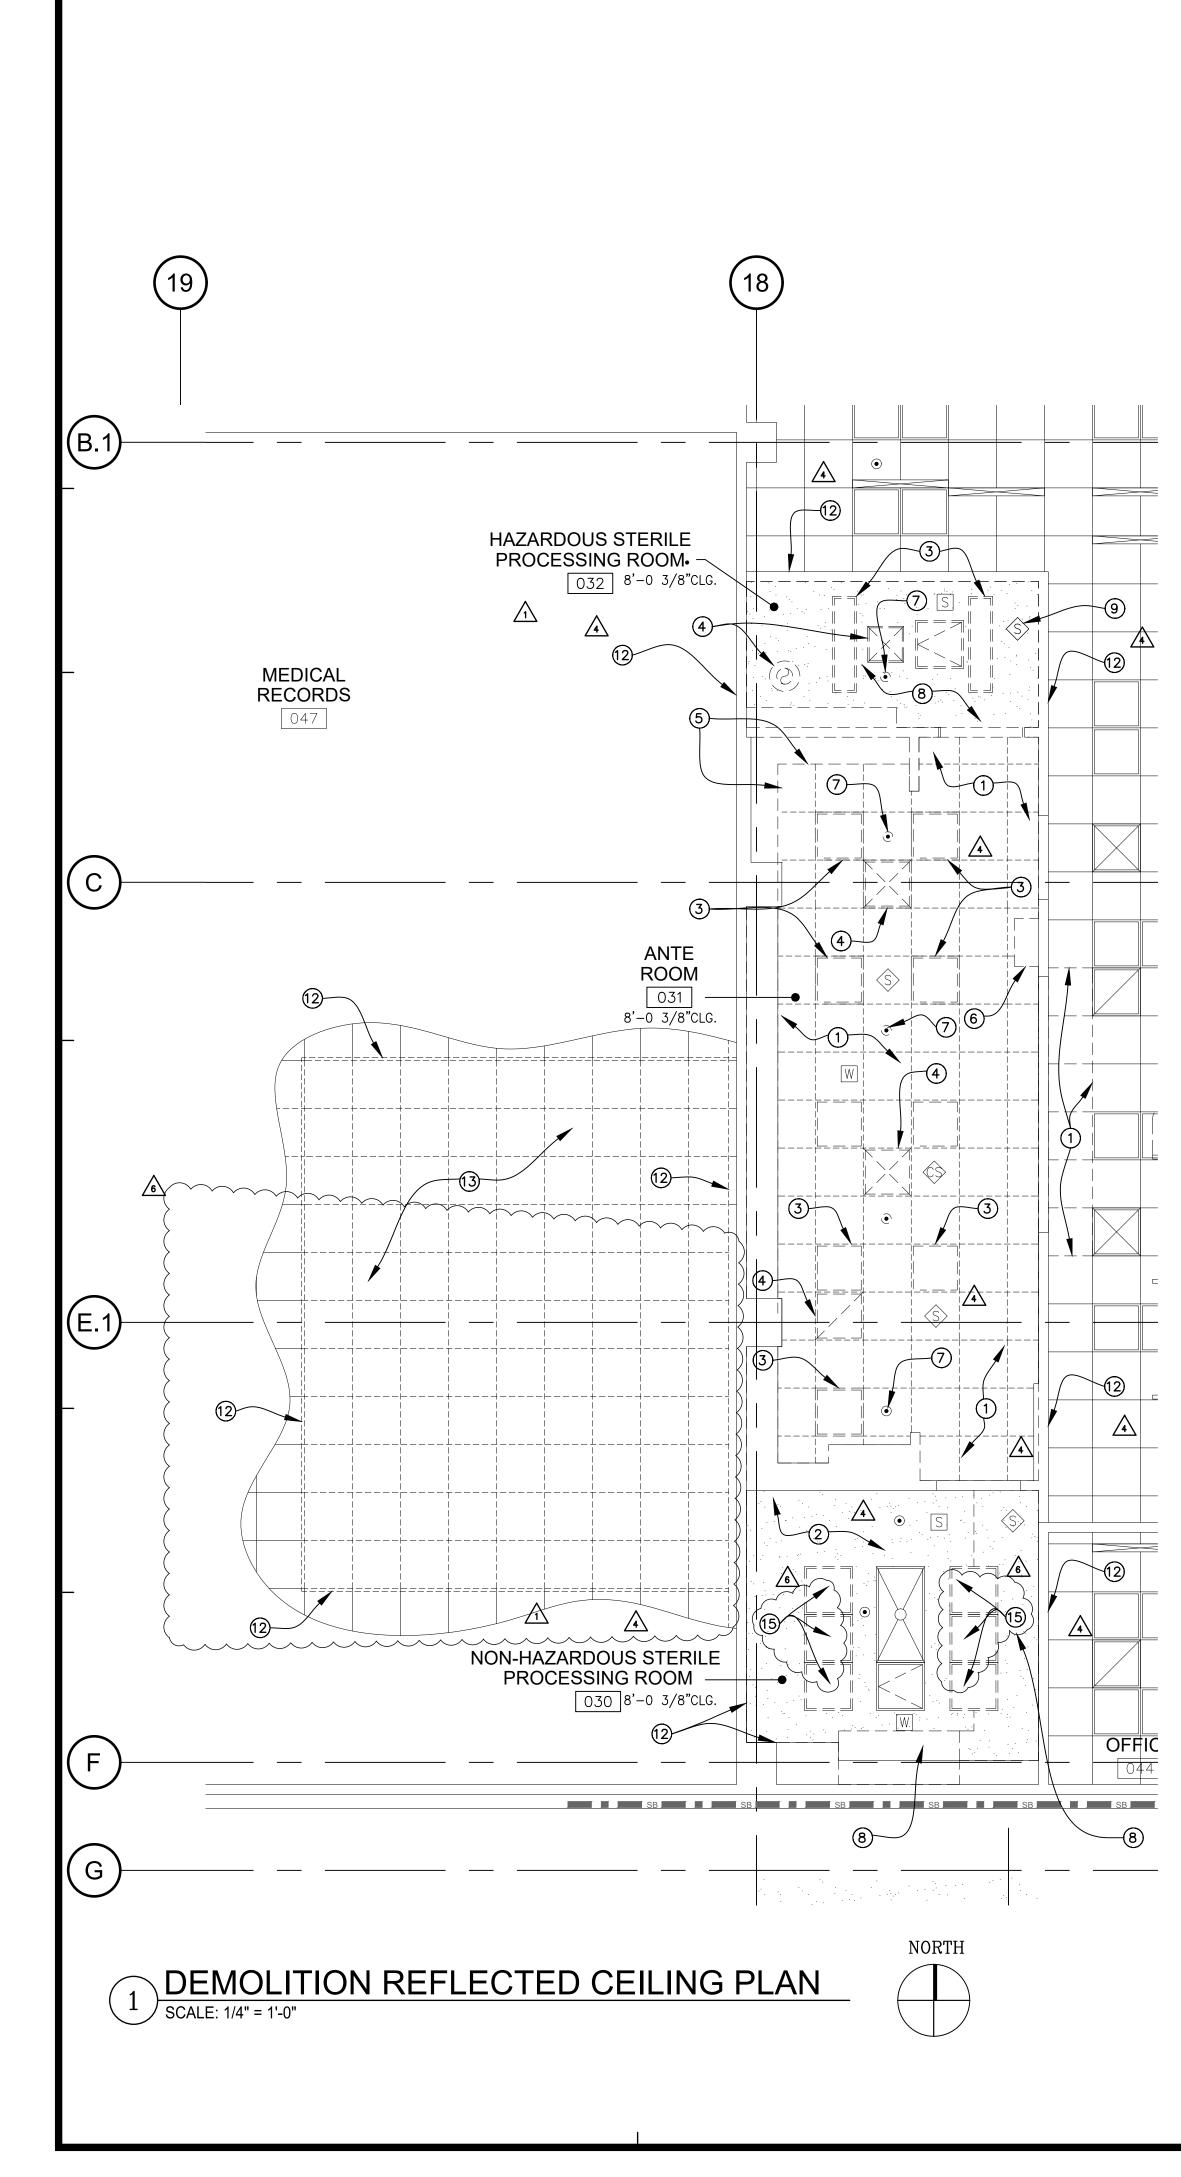

RCP DEMOLITION KEYNOTES:


- (1) REMOVE 24"X24" ACP CEILING.
- (2) GWB CEILING TO REMAIN.
- 3 REMOVE LIGHT FIXTURE, REFER TO ELEC. DWGS.
- (4) REMOVE MECH. AIR REGISTER REFER TO MECH.
- DWGS. 5 REMOVE EXISTING GWB AND SOFFIT.
- (6) REMOVE EXISTING GYPSUM BOARD SOFFIT AND
- METAL FRAMING.
- 7 REMOVE SPRINKLER HEAD.
- 8 REMOVE EXISTING GWB CEILING.
- (9) REMOVE EXISTING CEILING DEVICE, SAVE TO REINSTALL.
- 10 NOT USED.
- 11) NOT USED.
- (12) ERECT AND TIGHTLY SEAL TO TOP OF PARTITION AND TO UNDERSIDE OF DECK WITH VISQUEEN. TAPE ALL EDGES TO STOP AIR LEAKAGE.
- (13) REMOVE EXISTING CEILING TILES, LIGHTS, HVAC GRILLS AS A NEEDED TO ERECT DUCTWORK ABOVE. PROVIDE TEMPORARY INFECTION CONTROL PARTITION WITH HEPA-FILTERED NEGATIVE AIR TO COVER AREA AS NEEDED.

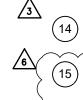

	NEGATIVE AIR TO COVER AREA AS NEEDED.
)	SALVAGE OR PRESERVE AND PROTECT ALL CEILING EQUIPMENT AND TILES ALL TO BE REINSTALLED.
)	REMOVE EXISTING LIGHT FIXTURE, SAVE FOR REINSTALLATION.

MATERIAL LEGEND:

	2X2 ACOUSTICAL CEILING TILE
	SUSPENDED GYP. BOARD CEILING RECESSED LAY-IN LED LIGHT FIXTURE
	PROVIDE (2) SLACK SAFETY WIRES AT DIAGONAL CORNERS
\bigcirc	RECESSED "CAN" LIGHT PROVIDE (1) SLACK SAFETY WIRE
	RECESSED "CAN" LIGHT DIRECTED TOWARD WALL PROVIDE (1) SLACK SAFETY WIRE
\bigotimes	EXIT SIGN PROVIDE (1) SLACK SAFETY WIRE AT CLG MOUNTED FIXTURES
Ś	SMOKE DETECTOR PROVIDE (1) SLACK SAFETY WIRE
S	PAGING SPEAKER PROVIDE (1) SLACK SAFETY WIRE
R	2'-0' RETURN AIR
	RETURN AIR OR EXHAUST PROVIDE (2) SLACK SAFETY WIRES AT DIAGONAL CORNERS.
\$	3'-0" SUPPLY AIR DIFFUSER
	SUPPLY AIR DIFFUSER PROVIDE (2) SLACK SAFETY WIRES AT DIAGONAL CORNERS
	2' X 2' CEILING ACCESS PANEL
\bigvee	1' X 1' CEILING ACCESS PANEL
	1' X 1' CEILING EXHAUST
	1' X 1' CEILING HVAC SUPPLY
	1' X 1' CEILING HVAC RETURN
	1' X 4' FLOURESCENT CEILING LIGHT
C	CAMERA
\odot	SPRINKLER HEAD
\rightarrow	AUDIBLE NURSE CALL
	HEPA FILTER
$\triangle \diamondsuit$	CHIME / STROBE
S	STROBE
	BSC EXHAUST
∠₄ ₩	WI-FI
	All rights reserved. No part of this work may be reproduced or copied in any form or by any means, graphic, elec

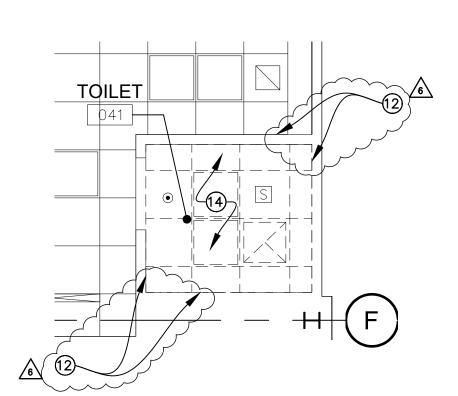



GENERAL NOTES:

- THE GENERAL CONTRACTOR SHALL VERIFY ALL EXISTING CONDITIONS AND MEASUREMENTS IN THE FIELD PRIOR TO STARTING CONSTRUCTION.
- 2. REFER TO GENERAL NOTES ON SHEET A0-00 FOR INFORMATION NOT INDICATED ON THIS SHEET.

RCP DEMOLITION NOTES:


- 1. THE GENERAL CONTRACTOR SHALL VERIFY ALL EXISTING CONDITIONS AND MEASUREMENTS IN THE FIELD PRIOR TO STARTING DEMOLITION.
- 2. THE GENERAL CONTRACTOR SHALL COORDINATE ALL PHASING, ACCESS, DEBRIS REMOVAL, STAGING AREAS AND HOURS OF CONSTRUCTION WITH OWNER PRIOR TO START OF DEMOLITION.
- 3. THE GENERAL CONTRACTOR SHALL COORDINATE WITH STRUCTURAL, MEP, FIRE ALARM, FIRE PROTECTION, NURSE CALL, INTERIORS AND EQUIPMENT DRAWINGS PRIOR TO STARTING DEMOLITION. THE PROJECT MANUAL AND ALL DRAWINGS IN THE CONSTRUCTION DRAWINGS SHALL BE PART OF THE CONSTRUCTION DOCUMENTS.
- 4. THE GENERAL CONTRACTOR SHALL SEPARATE DISSIMILAR METALS WITH BUILDING PAPER OR PLASTIC SHIM.
- 5. THE GENERAL CONTRACTOR SHALL X-RAY AND/OR ULTRASOUND THE EXISTING CONCRETE FLOORS FOR ANY POSSIBLE EMBEDDED CONDUITS, STRUCTURAL REBAR OR UNFORESEEN CONDITION THAT IS OUTSIDE THE SCOPE OF WORK AND MIGHT IMPEDE THE ANCHORING OF EQUIPMENT OR CONFLICT WITH TRENCHING PRIOR TO CONSTRUCTION.
- 6. REFER TO GENERAL NOTES ON SHEET A0-00 FOR INFORMATION NOT INDICATED ON THIS SHEET.
- 7. CONTRACTOR STAGING TO BE IN THE ROOMS UNDER REMODEL.
- 8. CONTRACTOR PARKING TO BE IN CONTRACTOR DESIGNATED PARKING AREA.
- 9. THE CONTRACTOR SHALL ENSURE THAT THE AREA UNDER REMODEL IS LOCKED AND OTHERWISE SECURED AFTER HOURS.
- 10. UNLESS OTHERWISE NOTED, CONTRACTOR SHALL COORDINATE WITH THE OWNER THE REMOVAL OF EXISTING EQUIPMENT INDICATED ON DRAWINGS.
- 11. DASHED LINES INDICATE ITEMS TO BE DEMOLISHED OR REMOVED. REFER TO CEILING PLAN, ROOM FINISH SCHEDULE ALONG WITH MECHANICAL AND ELECTRICAL SECTIONS FOR FURTHER DESCRIPTION OF SCOPE OF WORK.
- 12. REFER TO DEMOLITION PLAN FOR NOTES INDICATING TYPE OF FINISHES WITHIN THE EXISTING SPACE TO BE REMOVED.
- 13. REFER TO RELATED PLANS FOR PORTIONS OF EXISTING CONSTRUCTION SCHEDULED TO REMAIN.
- 14. PATCH NEW WORK TO MATCH AND ALIGN WITH THE EXISTING. COMPLETELY REMOVE EXISTING FINISHES WHERE NEW FINISHES ARE SCHEDULED.
- 15. CONTRACTOR SHALL PRESERVE AND PROTECT THE EXISTING OVERHEAD EQUIPMENT, LIGHTING, FIRE ALARM, FIRE SPRINKLER, PAGING, PHONE, DATA, ELECTRICAL LINES, ETC. SCHEDULED TO REMAIN DURING THE COURSE OF DEMOLITION. MANY OF THE SYSTEMS ARE SCHEDULED FOR REUSE BY THE OWNER UNDER THIS OR SEPARATE CONTRACTS.
- 16. PROVIDE DUST CURTAIN ABOVE CEILING AND ISOLATE CONSTRUCTION AREA FROM THE REMAINDER OF THE FLOOR. PROVIDE A FLEX DUCT FROM SEALED AREA ABOVE CONSTRUCTION AREA, ROUTED AND EXHAUSTED INTO EXISTING EXHAUST SYSTEM.

PARTITION LEGEND:

REQUIREMENTS FOR PARTITIONS.

WIDTH OF WALL TO BE SET

EXISTING WALLS WERE CONSTRUCTED WITH MANY PERMITS AND/OR CONTRACTS. FIELD VERIFY CONSTRUCTION AND WIDTH PRIOR TO FABRICATION OF DOOR FRAMES OR COMPONENTS WHICH REQUIRE THE

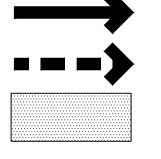

ACCESSIBLE PATH OF TRAVEL.

EGRESS PATH OF TRAVEL.

ONE-HOUR RATED CORRIDOR.

		INDICATES AN EXISTING MEMBRANE OF PARTITION OR PARTITION TO BE REMOVED. REFER TO DEMOLITION PLAN FOR FURTHER REQUIREMENTS.		
		INDICATES AN EXISTING PARTITION TO REMAIN. REFER TO PLAN FOR UPGRADE REQUIREMENTS.		
7	SB SB SB SB SB	INDICATES AN EXISTING 1 HOUR SMOKE BARRIER	_	
3	SP SP SP SP SP SP	INDICATES AN EXISTING 1 HOUR SMOKE PARTITION		REV:
	FP FP FFF FFF FFF	INDICATES AN EXISTING ONE HOUR FIRE RATED PARTITION TO REMAIN. ALL PENETRATIONS SHALL BE PROTECTED WITH A UL-LISTED FIRE STOP SYSTEM.		CONSULTA
	FB FB FB FB FB	INDICATES AN EXISTING ONE HOUR RATED FIRE BARRIER TO REMAIN, ALL PENETRATIONS SHALL BE PROTECTED WITH A UL-LISTED FIRE STOP SYSTEM.		oshpd af
	EFB HERE IN IN AND FB HERE	INDICATES AN EXISTING TWO HOUR RATED FIRE BARRIER TO REMAIN, ALL PENETRATIONS SHALL BE PROTECTED WITH A UL-LISTED FIRE STOP SYSTEM.		OSH
	SB SB SB	INDICATES A NEW 1 HOUR SMOKE BARRIER		
	SP SP SP SP SP	INDICATES A NEW 1 HOUR SMOKE PARTITION		
		INDICATES A NEW ONE HOUR RATED FIRE PARTITION EXTENDING TO THE UNDERSIDE OF THE STRUCTURE ABOVE. ALL PENETRATIONS SHALL BE PROTECTED WITH A UL-LISTED FIRE STOP SYSTEM.	I	
		INDICATES A NEW ONE HOUR RATED FIRE BARRIER EXTENDING TO THE UNDERSIDE OF THE STRUCTURE ABOVE. ALL PENETRATIONS SHALL BE PROTECTED WITH A UL-LISTED FIRE STOP SYSTEM.	I	SHEET TIT
		THICK LINE INDICATES NEW SURFACE FINISH.		DEN
		INDICATES AN EXISTING STRUCTURAL CONCRETE WALL TO REMAIN. LOCATE REINFORCING STEEL AND OBTAIN APPROVAL FROM STRUCTURAL ENGINEER PRIOR TO CORING AND/ OR CUTTING.		CEII
	X WALL TY	PE REFERENCE REFER TO SHEET A5-10.		PROJECT
	PARTITION NOTES:			TCMC
		HOWN ARE TO FINISHED FACE OF GYP. BOARD, FER TO SHEET A5-10 FOR GENERAL NOTES AND		PROJECT

S F E I R A R C H I T E C T S

5151 Shoreham Place, Suite 100 San Diego, Ca 92122

P: 619-299-3917 F: 619-299-5084 www.sfeirarch.com

TCMC PHARMACY USP 800 UPGRADE

Tri-City Medical Center

4002 Vista Way Oceanside, California 92056

OWNER:	TRI-CITY MEDICAL CENTER 4002 VISTA WAY OCEANSIDE, CALIFORNIA 92056
ARCHITECT:	SFEIR ARCHITECTS 5151 SHOREHAM PLACE, SUITE 100 SAN DIEGO, CALIFORNIA 92122 TEL(619)299-3917 FAX(619)299-5084
MEP:	P2S ENGINEERING, INC. 9665 CHESAPEAKE DRIVE, SUITE 230 SAN DIEGO, CA 92123 TEL(619)618–2347

STRUCTURAL: SUN STRUCTURAL ENGINEERING 2091 LAS PALMAS DRIVE, SUITE D CARLSBAD, CA 92011 TEL(760)438–1188

*	No. C 28543 TO No. C 28543 TO POP 1-31-19 C CALIFORNIC OF CALIFORNIC	
$\frac{1}{\sqrt{2}}$	OSHPD COMMENTS	10-09-17
$\frac{2}{\sqrt{2}}$	DESIGN CHANGES	10-09-17
$\frac{3}{\sqrt{3}}$	OSHPD COMMENTS	12-11-17
	DESIGN CHANGES	12-11-17
$\frac{5}{5}$	OSHPD COMMENTS	5-15-18
	DESIGN CHANGES	6-05-18
REV:	DESCRIPTION:	 DATE:

OSHPD APPROVAL STA

OSHPD #: S171641-37-00

DEMOLITION REFLECTED CEILING PLAN

PROJECT TITLE: TCMC USP 800


 PROJECT #:
 01667.00
 SHEET NUMBER:

 DRAWN BY:
 NI

 CHECKED BY:
 JS

 SCALE:
 1/4" = 1'-0"

 DATE:
 07/31/17

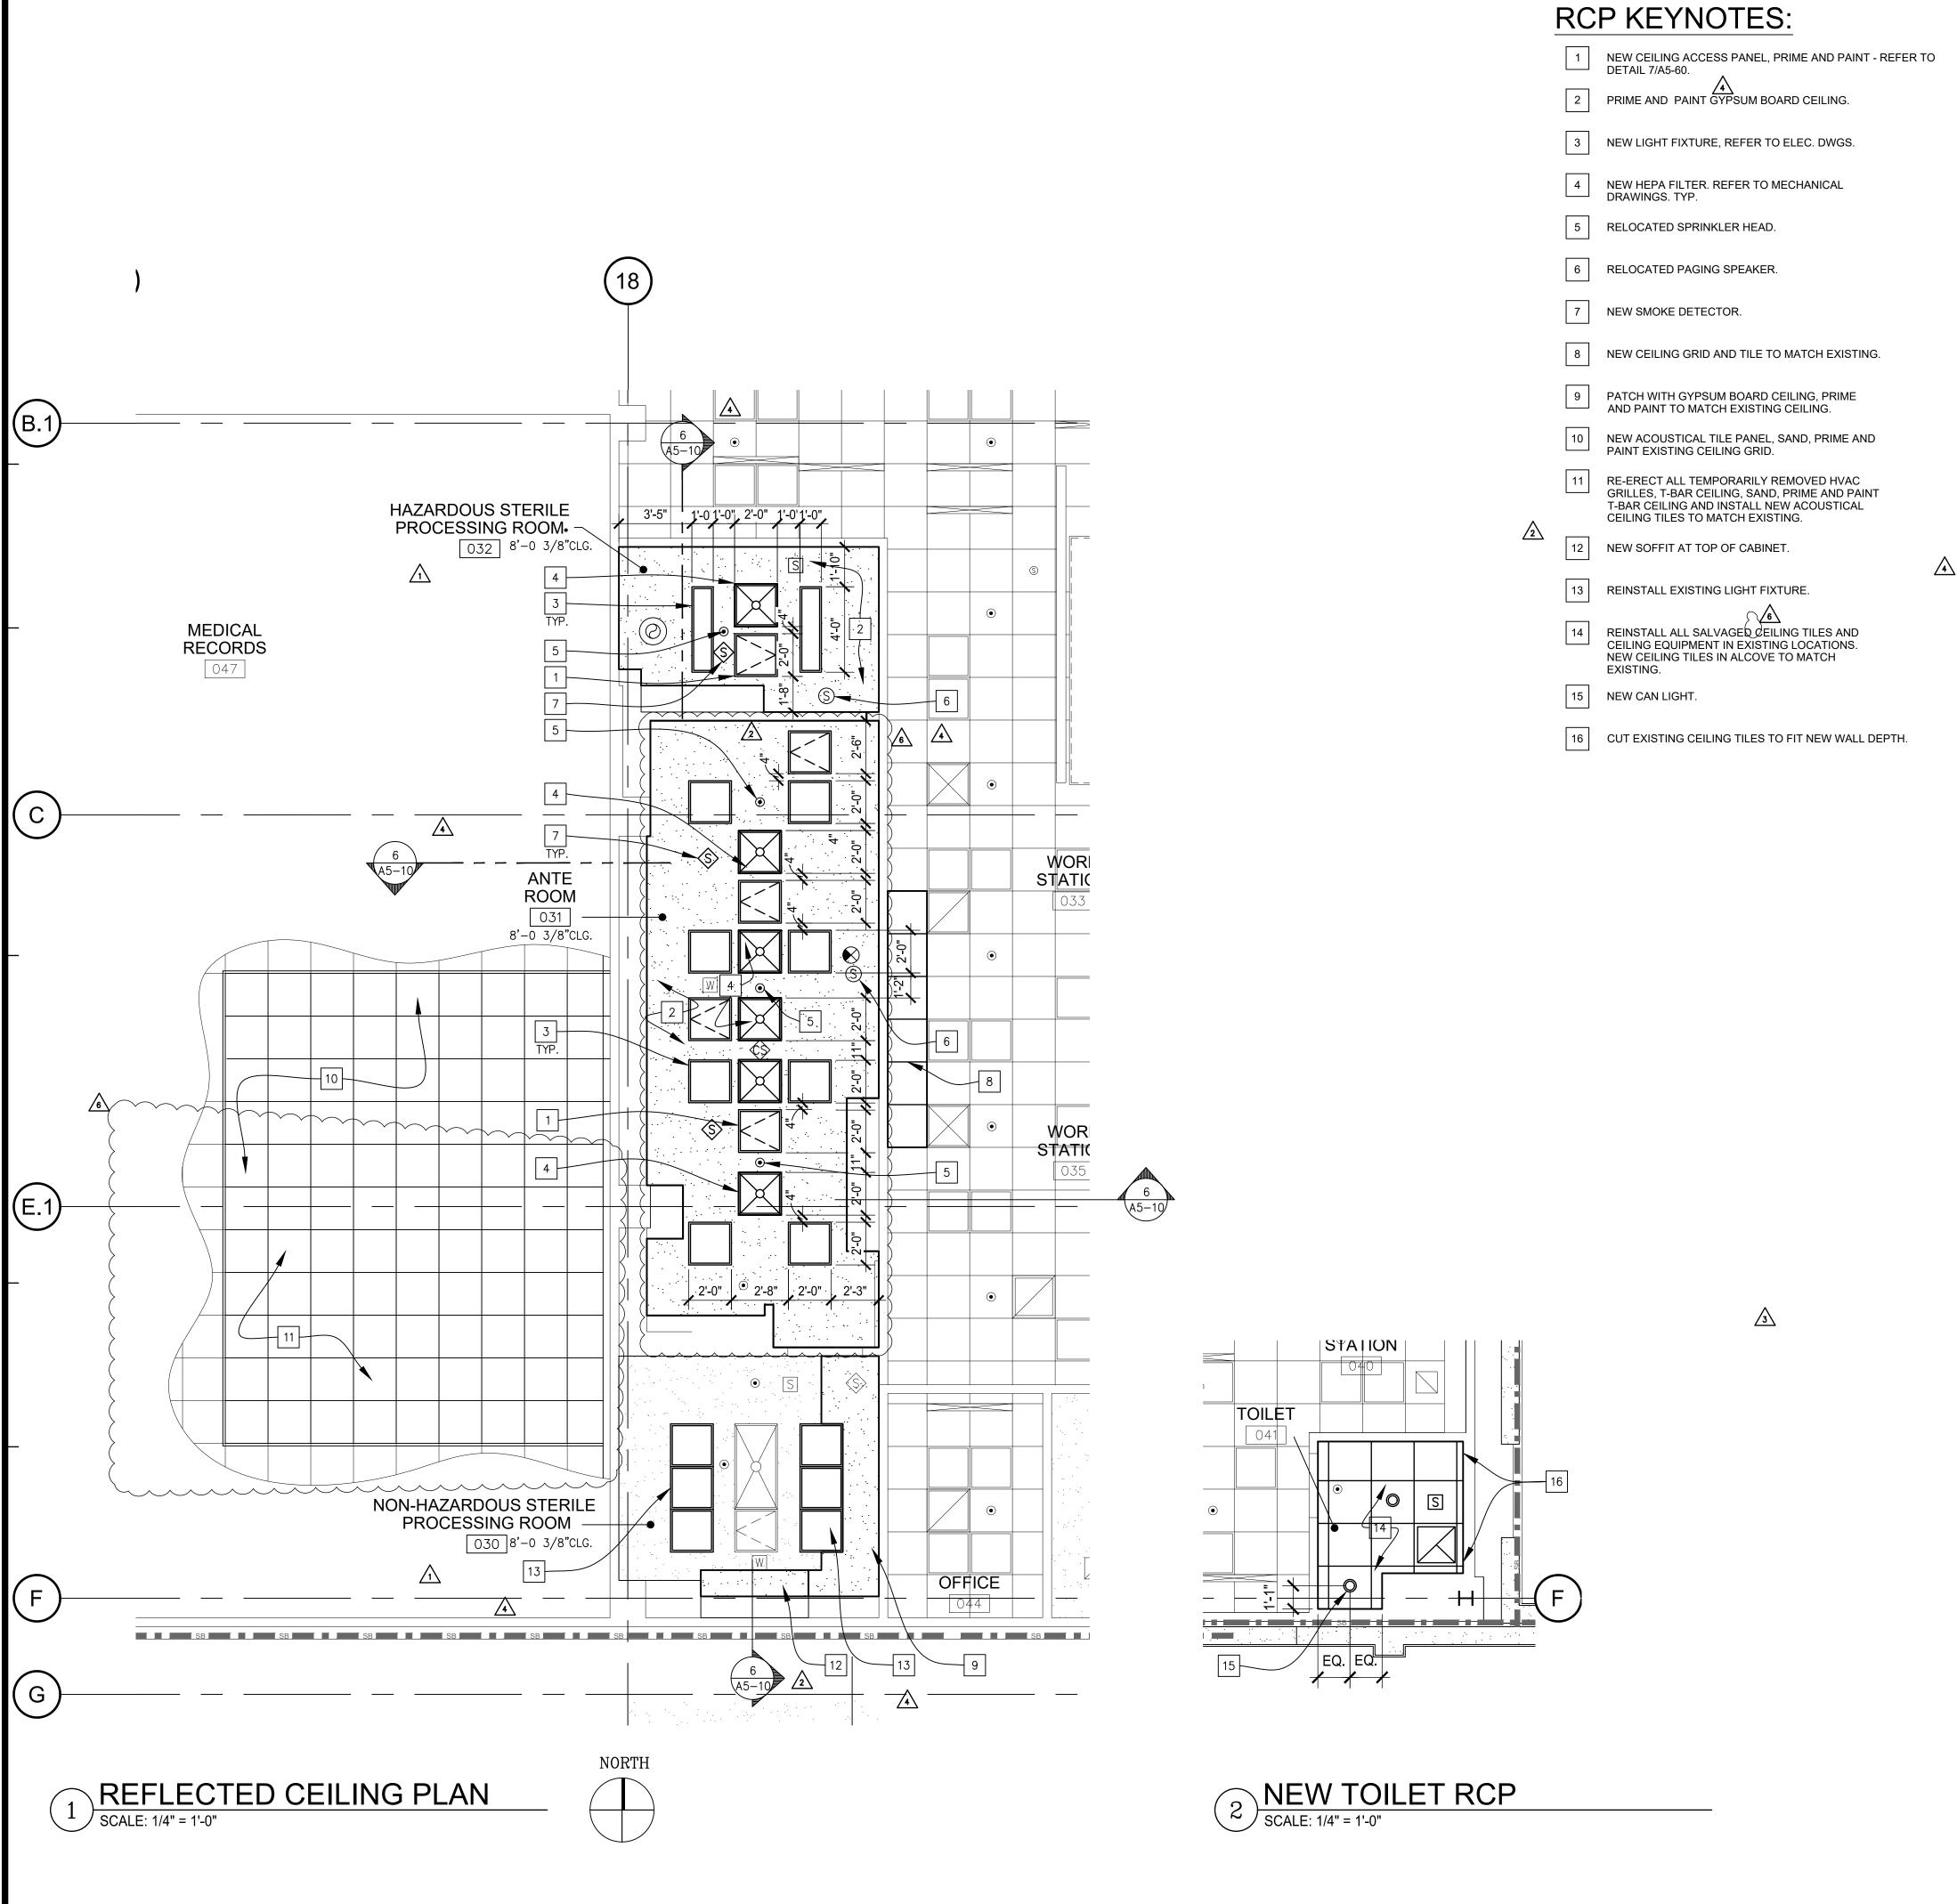

Il rights reserved. No part of this work may be reproduced or copied in any form or by any means, graphic, electronic, or mechanical, including photocopying, recording, taping, or

GENERAL NOTES:

- 1. THE GENERAL CONTRACTOR SHALL VERIFY ALL EXISTING CONDITIONS AND MEASUREMENTS IN THE FIELD PRIOR TO STARTING CONSTRUCTION.
- 2. REFER TO GENERAL NOTES ON SHEET A0-00 FOR INFORMATION NOT INDICATED ON THIS SHEET.

RCP GENERAL NOTES:

- THE GENERAL CONTRACTOR SHALL VERIFY ALL EXISTING CONDITIONS AND MEASUREMENTS IN THE FIELD PRIOR TO STARTING CONSTRUCTION.
- THE GENERAL CONTRACTOR SHALL COORDINATE ALL PHASING, ACCESS, DEBRIS REMOVAL, STAGING AREAS AND HOURS OF CONSTRUCTION WITH 2. OWNER PRIOR TO START OF CONSTRUCTION.
- THE GENERAL CONTRACTOR SHALL COORDINATE WITH STRUCTURAL, MEP, 3. FIRE ALARM, FIRE PROTECTION, NURSE CALL, INTERIORS AND EQUIPMENT DRAWINGS PRIOR TO STARTING CONSTRUCTION. THE PROJECT MANUAL AND ALL DRAWINGS IN THE CONSTRUCTION DRAWINGS SHALL BE PART OF THE CONSTRUCTION DOCUMENTS.
- THE GENERAL CONTRACTOR SHALL SEPARATE DISSIMILAR METALS WITH BUILDING PAPER OR PLASTIC SHIM.
- THE GENERAL CONTRACTOR SHALL X-RAY AND/OR ULTRASOUND THE 5 EXISTING CONCRETE FLOORS FOR ANY POSSIBLE EMBEDDED CONDUITS, STRUCTURAL REBAR OR UNFORESEEN CONDITION THAT IS OUTSIDE THE SCOPE OF WORK AND MIGHT IMPEDE THE ANCHORING OF EQUIPMENT OR CONFLICT WITH TRENCHING PRIOR TO CONSTRUCTION.
- REFER TO GENERAL NOTES ON SHEET A0-00 FOR INFORMATION NOT 6. INDICATED ON THIS SHEET.
- 7. CONTRACTOR STAGING TO BE IN THE ROOMS UNDER REMODEL.
- CONTRACTOR PARKING TO BE IN CONTRACTOR DESIGNATED PARKING 8. AREA.
- THE CONTRACTOR SHALL ENSURE THAT THE AREA UNDER REMODEL IS 9. LOCKED AND OTHERWISE SECURED AFTER HOURS.
- 10. CEILING HEIGHTS TO MATCH EXISITNG UNLESS OTHERWISE NOTED (NOT LESS THAN 8'-0")
- 11. REFER TO SHEET A5-60 AND A5-70 FOR CEILING DETAILS. 12. REFER TO ELECTRICAL DRAWINGS FOR LIGHT FIXTURE TYPES.
- 13. FIRE SPRINKLER HEAD LAYOUT MUST BE APPROVED BY ARCHITECT PRIOR TO INSTALLATION, ALL EXPOSED SPRINKLER HEAD COMPONENTS SHALL BE WHITE.
- 14. REPLACE EXISTING LENSES FOR 2X2 AND 2X4 LIGHT FIXTURES.

15. REPLACE ALL GRILLES, DIFFUSERS AND REGISTERS WITH NEW. MATERIAL LEGEND:

2X2 ACOUSTICAL CEILING TILE	STRUCTURAL: SUN S 2091 L CARLSE TEL(76
SUSPENDED GYP. BOARD CEILING RECESSED LAY-IN LED LIGHT FIXTURE PROVIDE (2) SLACK SAFETY WIRES AT DIAGONAL CORNERS	CENSED ARCHINE
RECESSED "CAN" LIGHT PROVIDE (1) SLACK SAFETY WIRE RECESSED "CAN" LIGHT DIRECTED TOWARD WALL PROVIDE (1) SLACK SAFETY WIRE EXIT SIGN PROVIDE (1) SLACK SAFETY WIRE AT CLG MOUNTED FIXTURES SMOKE DETECTOR PROVIDE (1) SLACK SAFETY WIRE PAGING SPEAKER PROVIDE (1) SLACK SAFETY WIRE 2'-O' RETURN AIR RETURN AIR OR EXHAUST PROVIDE (2) SLACK SAFETY WIRES AT DIAGONAL CORNERS. 3'-O" SUPPLY AIR DIFFUSER SUPPLY AIR DIFFUSER	Image: Construction of the second
 PROVIDE (2) SLACK SAFETY WIRES AT DIAGONAL CORNERS 2' X 2' CEILING ACCESS PANEL 1' X 1' CEILING ACCESS PANEL 1' X 1' CEILING EXHAUST 1' X 1' CEILING HVAC SUPPLY 	oshpd approval stamp: OSHPD #:S171
1' X 1' CEILING HVAC RETURN 1' X 4' FLOURESCENT CEILING LIGHT CAMERA SPRINKLER HEAD AUDIBLE NURSE CALL	SHEET TITLE: REFLECTED CEILING PL
HEPA FILTER CHIME / STROBE STROBE BSC EXHAUST	PROJECT TITLE: TCMC USP 800 PROJECT #: 01667.00 DRAWN BY: NI CHECKED BY: JS SCALE: 1/4" = 1'-0"
	DATE: 07/31/17

S R F A R C H I T E C T S

5151 Shoreham Place, Suite 100 San Diego, Ca 92122

P: 619-299-3917 F: 619-299-5084 www.sfeirarch.com

TCMC PHARMACY USP 800 UPGRADE

Tri-City Medical Center


REV:	DESCRIPTION:		DATE:
<u></u>	DESIGN CHANGES		6-05-18
		******	5-15-18
	DESIGN CHANGES	~~~~~~~~~~~~~~~~~~~~~~~~~~~~~~~~~~~~~~~	12-11-1
$\frac{\sqrt{3}}{\sqrt{3}}$	OSHPD COMMENTS		12–11–1
	DESIGN CHANGES		10-09-1
	OSHPD COMMENTS		10-09-1
415 JOSEC EL	DED ARC MICHIN No. C 28543		····
STRUCT	2091 CARL	STRUCTURAL ENGIN LAS PALMAS DRIVE SBAD, CA 92011 760)438–1188	
MEP:	9665 SAN	ENGINEERING, INC. CHESAPEAKE DRIV DIEGO, CA 92123 519)618–2347	e, suite 230
ARCHIT	5151 SAN	R ARCHITECTS SHOREHAM PLACE, DIEGO, CALIFORNIA 519)299–3917 FAX	92122
		CITY MEDICAL CENTE VISTA WAY NSIDE, CALIFORNIA	

IPD APPROVAL STAMP: DSHPD #: S171641-37-00

REFLECTED CEILING PLAN

 1/4" = 1'−0' 07/31/17


00% CONSTRUC	TION DOCUMENT

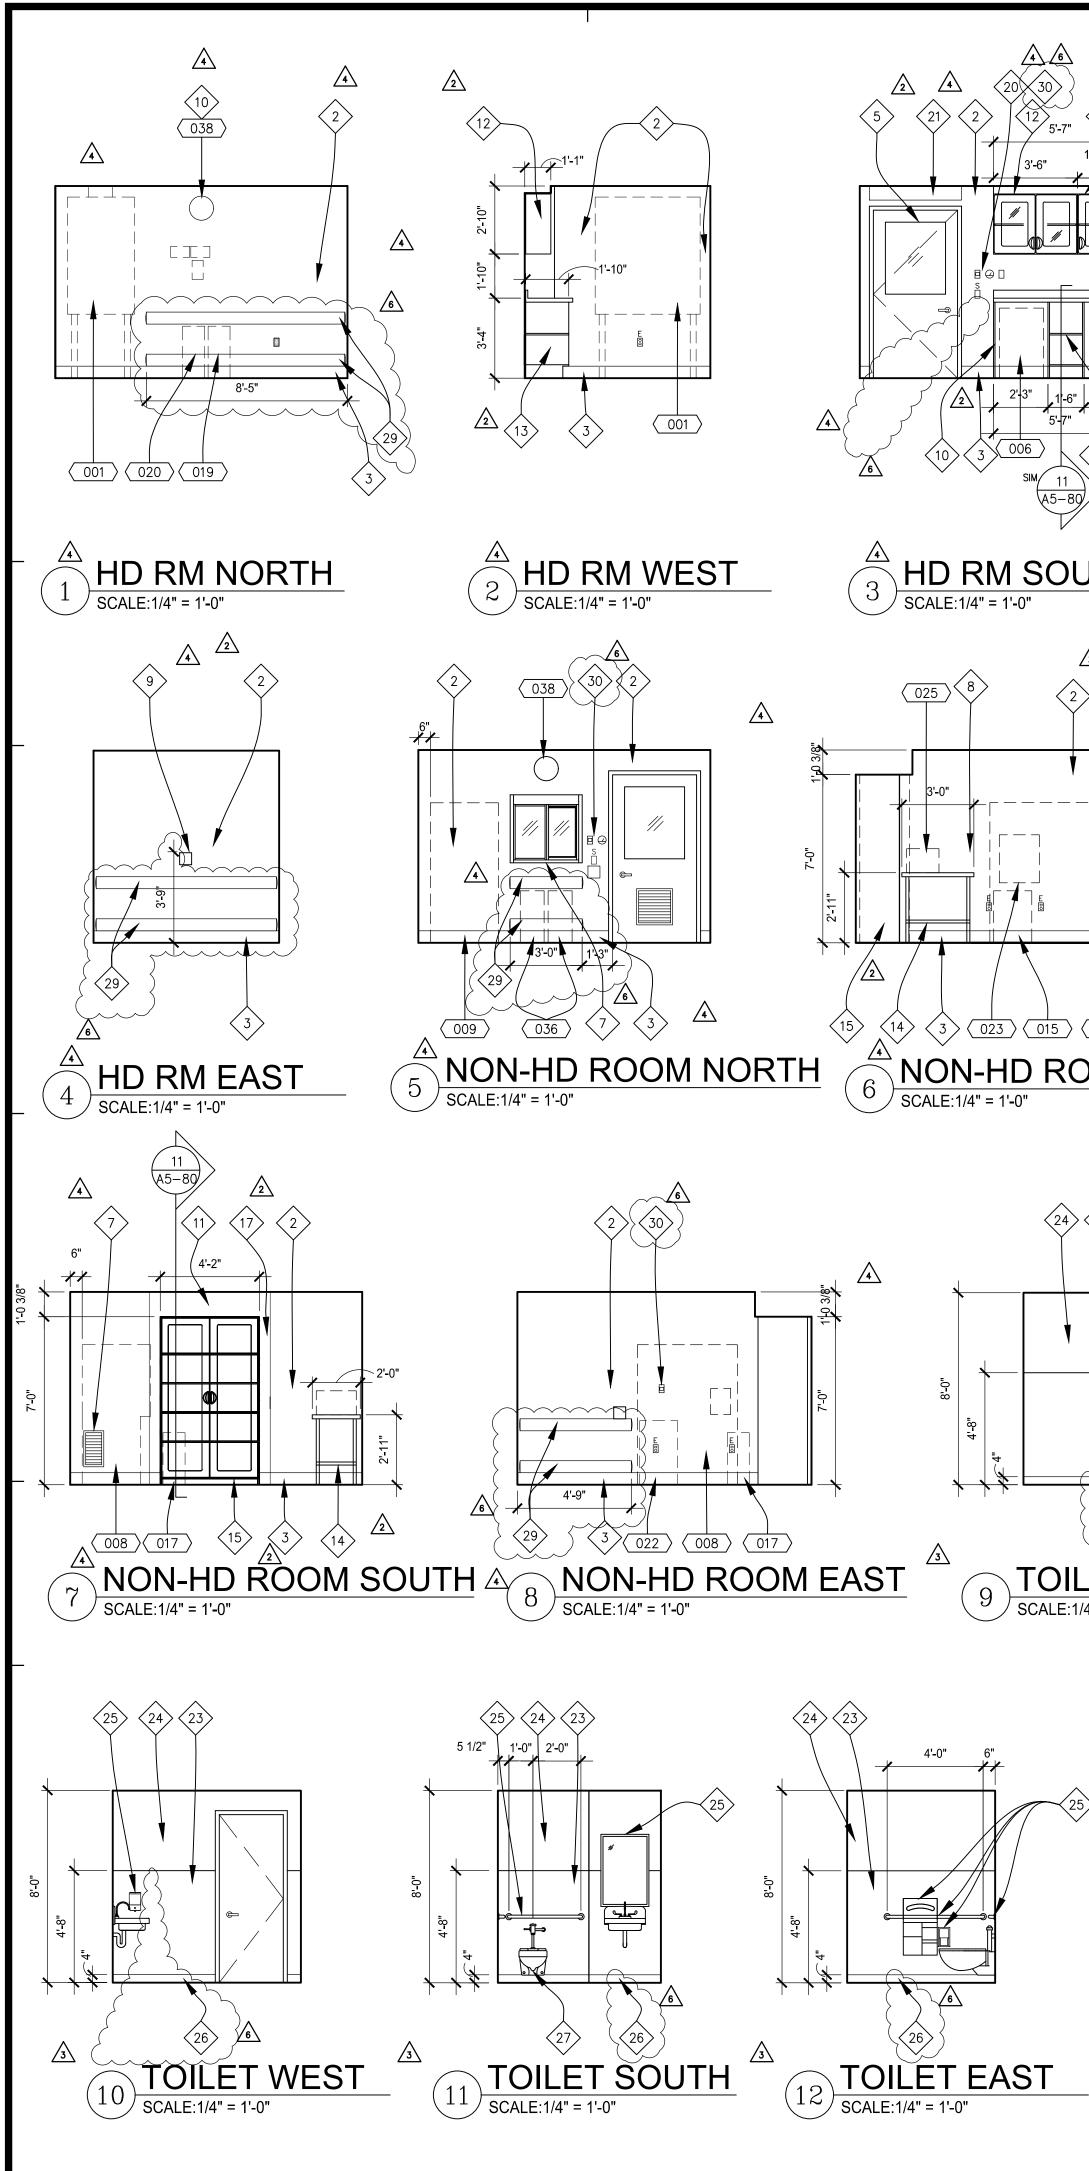

6

2	LEC	GEN	D:						NNEI	<u>NOTES:</u>
	***	REFER T	O EQUIPMENT SCHEDULE.			1	PAINT TO	MATCH EXIS	STING.	1
7" 11	*	NOTES				2	WALL PRO	TECTION SH	EETING SEE	ID SHEET.
1'-6") 7"	CAS	EWOF	RK LEGEND:			3	6" VINYL E	BASE TO M	ATCH EXISTIN	NG.
	CASE	ID NUM	BER H	<u>HEIGHT</u>		4	NEW STAIN EYEWASH.	ILESS STEEI	_ COUNTER ,	/BACKSPLASH WITH SINK AND
			NCHES) $(= AS REQ'D.)$	NUMBER H	EIGHT	5				IE AND PAINT, WITH NEW DOOR 1
	Lc/		EFER TO W.I.C.)		18" 24" 27"	\times	4" BACK S	$\bigcirc \bigcirc$		
	D M	PECIAL PREFIX = DOUBLE = MODIFY	`	D	27 30" 30"	X		AIR EXHAUS		2
		24" TASK LIG 36" TASK LIG		F G	33" 36"	\times			ADD WALL F	
	TASK48 =	48" TASK LIC		HJ	39" 42"	\times				NSOR PLATE.
			. ON ELEVATIONS)	K L M	48" 54" 72"	\times			PORT PANEL	4
	LOWER	CASE: 24'	DEEP U.O.N.	N N P	80" 86"	\sim				٨
1 λ		CASE: 14" \SE: 14"		Q R	96" AS REQ'D.	X			AIL 6/A5-10	
-80 4			RIPTION			\times			EEL CABINETS	6
	C — (CODE BLU	JE O –	NITROUS OXYGEN		\times	4		EL CABINETS	S.
DUTH	DP — [DATA DICTAPHC DIMMER S	NE S –	NURSE C SWITCH TELEPHON	ALL PULL STATIO			LESS STEEL		4 7
	E — [ELECT. OUTLET TL -	TASK LIG	HT					ABINET. COORDINATE ROUGH MANUFACTURER.
Δ	IC — II	NTERCOM	BOX V - VC -	VACUUM VOLUME	CONTROL	(16)	EXISTING T	o remain.		
2	N — N	NURSE CA	all VS –	VACUUM	SLIDE	(17)	NEW INFILL	. PARTITION		9
γ						(18)	DONNING A	ND DOFFIN	G AREA.	10
¥ 1						19	WALL MOU	NTED CLEAN	NING SUPPLIE	ES.
						\times	\sim	\sim	\sim	COMPLY WITH DETAIL
							(3/A1-04.	DOOR OPE	~ ~ ~ ~ /	
						X				
						\times				\sim
							4 X4 GLA	ZED CERAM		~~~~~~~~~~~~~~~~~~~~~~~~~~~~~~~~~~~~~~~
						24	SEMIGLOSS	PAINT. PR	IME AND PAI	INT TO MATCH EXISTING.
						25	REMOVE AI	ND REINSTA	LL TOILET A	CCESSORY.
						26	1"x1"_CER/	MIC FLOOR	ILE	
OOM WEST									ECT TOILET A	ACCESSORY.
		OFCI : O	WNER FURNISHED, OWNER INSTALLE WNER FURNISHED, CONTRACTOR IN:			\sim	ITPICAL C	UUNTER SU	PPURI SIMILI	AR TO DETAIL $8/A5-80.$
4 23 27			EQUIPMENT SC	OR INSTAL						
4 23 27		EQUIP #	EQUIPMENT SC DESCRIPTION	TOR INSTAL	ULE WEIGHT(APPROX.)		WDTH=b		ELEV/SHT	REMARKS
4 23 27		E	EQUIPMENT SC	TOR INSTAL	ULE	HEIGHT=h 90.5" 16"	WIDTH=b 52.5" 15"	DEPTH=d 33.5" 7.5"	ELEV/SHT -/A-9 -/-	
4 23 27		EQUIP # 001 002 003	EQUIPMENT SC DESCRIPTION BSC WORKSTATION MONITOR CPU	TOR INSTAL	ULE WEIGHT(APPROX.) 800 LBS N/A N/A	90.5" 16" 18"	52.5" 15" 6"	33.5" 7.5" 18"	-/A-9 -/- -/-	REMARKS
4 23 27		EQUIP # 001 002	EQUIPMENT SC DESCRIPTION BSC WORKSTATION MONITOR	TOR INSTAL	ULE WEIGHT(APPROX.) 800 LBS N/A	90.5" 16"	52.5 " 15"	33.5" 7.5"	-/A-9 -/-	REMARKS
		EQUIP # 001 002 003 004 004 005 005	EQUIPMENT SC DESCRIPTION BSC WORKSTATION MONITOR CPU KEYBOARD PHARMACY REFRIGERATOR CHEMOTHERAPY REFRIGERAT	R TOR	ULE WEIGHT(APPROX.) 800 LBS N/A N/A N/A 1,470 LBS 100 LBS	90.5" 16" 18" 3" 84" 35"	52.5" 15" 6" 18" 56" 22"	33.5" 7.5" 18" 6" 35" 21"	-/A-9 -/- -/- -/- -/-	REMARKS VBM SG404 BAKER STERILO
		EQUIP # 001 002 003 003 004 005	EQUIPMENT SC DESCRIPTION BSC WORKSTATION MONITOR CPU KEYBOARD PHARMACY REFRIGERATOR	R TOR E	ULE WEIGHT(APPROX.) 800 LBS N/A N/A N/A 1,470 LBS	90.5" 16" 18" 3" 84"	52.5" 15" 6" 18" 56"	33.5" 7.5" 18" 6" 35"	-/A-9 -/- -/- -/-	REMARKS VBM SG404 BAKER STERILO KELVINATOR/MODEL BT30RO
		EQUIP # 001 002 003 003 004 005 005 005 005 005 005 005	EQUIPMENT SC DESCRIPTION BSC WORKSTATION MONITOR CPU KEYBOARD PHARMACY REFRIGERATOR CHEMOTHERAPY REFRIGERATOR CHEMOTHERAPY REFRIGERAT PHARMACEUTICAL WAST LAMINAR FLOW WORK BENCH	TOR INSTAL	ULE WEIGHT(APPROX.) 800 LBS N/A N/A N/A 1,470 LBS 100 LBS N/A 440 LBS 680 LBS	90.5" 16" 18" 3" 84" 35" 26" 70" 70"	52.5" 15" 6" 18" 56" 22" 12" 50" 74"	33.5" 7.5" 18" 6" 35" 21" 18" 34" 34"	-/A-9 -/- -/- -/- -/- -/- -/- -/- -/-	REMARKS VBM SG404 BAKER STERILO KELVINATOR/MODEL BT30RO KENMORE 564 BAKER "EDGEGARD"/MODEL E
		EQUIP # 001 002 003 004 004 005 005 006 006	EQUIPMENT SC DESCRIPTION BSC WORKSTATION MONITOR CPU KEYBOARD PHARMACY REFRIGERATOR CHEMOTHERAPY REFRIGERATOR CHEMOTHERAPY REFRIGERAT PHARMACEUTICAL WAST LAMINAR FLOW WORK BENCH	TOR INSTAL	ULE WEIGHT(APPROX.) 800 LBS N/A N/A N/A 1,470 LBS 100 LBS N/A 440 LBS	90.5" 16" 18" 3" 84" 35" 26" 70"	52.5" 15" 6" 18" 56" 22" 12" 50"	33.5" 7.5" 18" 6" 35" 21" 18" 34"	-/A-9 -/- -/- -/- -/- -/- -/-	REMARKS VBM SG404 BAKER STERILO KELVINATOR/MODEL BT30RO KENMORE 564 BAKER "EDGEGARD"/MODEL E
		EQUIP # 001 002 003 004 004 005 005 005 005 005 005 005 005	EQUIPMENT SC DESCRIPTION BSC WORKSTATION MONITOR CPU KEYBOARD PHARMACY REFRIGERATOR CHEMOTHERAPY REFRIGERATOR CHEMOTHERAPY REFRIGERATOR CHEMOTHERAPY REFRIGERATOR CHEMOTHERAPY REFRIGERATOR CHEMOTHERAPY REFRIGERATOR CHEMOTHERAPY REFRIGERATOR CHEMOTHERAPY REFRIGERATOR PHARMACEUTICAL WAST LAMINAR FLOW WORK BENCH LAMINAR FLOW WORK STATI PYXIS SUPPLY-AUXILLARY PYXIS SUPPLY-MAIN - NOT USED -	TOR INSTAL	ULE WEIGHT(APPROX.) 800 LBS N/A N/A N/A N/A 1,470 LBS 100 LBS N/A 440 LBS 680 LBS 680 LBS 1,000 LBS 1,000 LBS N/A	90.5" 16" 18" 3" 84" 35" 26" 70" 70" 78" 78" -	52.5" 15" 6" 18" 56" 22" 12" 50" 74" 52" 52" 52" -	33.5" 7.5" 18" 6" 35" 21" 18" 34" 34" 28" 28" -	-/A-9 -/- -/- -/- -/- -/- -/- -/- -/- -/- -	REMARKS VBM SG404 BAKER STERILO KELVINATOR/MODEL BT30RO KENMORE 564.
		EQUIP # 001 002 003 004 004 005 005 005 005 005 005 009 009 009 009	EQUIPMENT SC DESCRIPTION BSC WORKSTATION MONITOR CPU KEYBOARD PHARMACY REFRIGERATOR CHEMOTHERAPY REFRIGERATOR CHEMOTHERAPY REFRIGERAT PHARMACEUTICAL WAST LAMINAR FLOW WORK BENCH LAMINAR FLOW WORK STATI PYXIS SUPPLY-AUXILLARY PYXIS SUPPLY-MAIN	TOR INSTAL CHED	ULE WEIGHT(APPROX.) 800 LBS N/A N/A N/A 1,470 LBS 100 LBS N/A 440 LBS 680 LBS 1,000 LBS 1,000 LBS	90.5" 16" 18" 3" 84" 35" 26" 70" 70" 78" 78"	52.5" 15" 6" 18" 56" 22" 12" 50" 74" 52" 52"	33.5" 7.5" 18" 6" 35" 21" 18" 34" 34" 28" 28"	-/A-9 -/- -/- -/- -/- -/- -/- -/- -/- -/- -	REMARKS VBM SG404 BAKER STERILO KELVINATOR/MODEL BT30RO KENMORE 564 BAKER "EDGEGARD"/MODEL E
		EQUIP # 001 002 003 004 004 005 005 005 005 005 005 005 005	EQUIPMENT SC DESCRIPTION BSC WORKSTATION MONITOR CPU KEYBOARD PHARMACY REFRIGERATOR CHEMOTHERAPY REFRIGERATOR CHEMOTHERAPY REFRIGERATOR CHEMOTHERAPY REFRIGERAT PHARMACEUTICAL WAST LAMINAR FLOW WORK BENCH LAMINAR FLOW WORK BENCH LAMINAR FLOW WORK STATI PYXIS SUPPLY-AUXILLARY PYXIS SUPPLY-AUXILLARY PYXIS SUPPLY-AUXILLARY PYXIS SUPPLY-MAIN - NOT USED - REGULAR WASTE CONTAINER, SHARPS WASTE CONTAINER	TYPE 1	ULE WEIGHT(APPROX.) 800 LBS N/A N/A N/A N/A 1,470 LBS 100 LBS 100 LBS 680 LBS 680 LBS 1,000 LBS 1,000 LBS N/A N/A N/A N/A N/A N/A	90.5" 16" 18" 3" 84" 35" 26" 70" 70" 78" 78" - - 27" 26"	52.5" 15" 6" 18" 56" 22" 12" 50" 74" 52" 52" - 22ø" 13"	33.5" 7.5" 18" 6" 35" 21" 18" 34" 28" 28" - - 19"	-/A-9 -/- -/- -/- -/- -/- -/- -/- -	REMARKS VBM SG404 BAKER STERILO KELVINATOR/MODEL BT30RO KENMORE 564. BAKER "EDGEGARD"/MODEL E
ILET NORTH		EQUIP # 001 002 003 004 004 005 005 005 005 005 007 005 009 009 009 009 009 009 009 009 009	EQUIPMENT SC DESCRIPTION BSC WORKSTATION MONITOR CPU KEYBOARD PHARMACY REFRIGERATOR CHEMOTHERAPY REFRIGERATOR CHEMOTHERAPY REFRIGERAT PHARMACEUTICAL WAST LAMINAR FLOW WORK BENCH LAMINAR FLOW WORK BENCH LAMINAR FLOW WORK STATI PYXIS SUPPLY-AUXILLARY PYXIS SUPPLY-AUXILLARY PYXIS SUPPLY-MAIN - NOT USED - REGULAR WASTE CONTAINER,	TYPE 1	ULE WEIGHT(APPROX.) 800 LBS N/A N/A N/A 1,470 LBS 100 LBS N/A 440 LBS 680 LBS 1,000 LBS 1,000 LBS N/A N/A N/A N/A	90.5" 16" 18" 3" 84" 35" 26" 70" 70" 70" 78" 78" - - 27"	52.5" 15" 6" 18" 56" 22" 12" 50" 74" 52" 52" - - 22\$"	33.5" 7.5" 18" 6" 35" 21" 18" 34" 34" 28"	-/A-9 -/- -/- -/- -/- -/- -/- -/- -/- -/- -	REMARKS VBM SG404 BAKER STERILO KELVINATOR/MODEL BT30RO KENMORE 564 BAKER "EDGEGARD"/MODEL E
ILET NORTH		EQUIP # 001 002 003 004 005 005 005 005 005 005 007 005 007 008 009 009 009 009 009 009 009 009 009	EQUIPMENT SC DESCRIPTION BSC WORKSTATION MONITOR CPU KEYBOARD PHARMACY REFRIGERATOR CHEMOTHERAPY REFRIGERATOR CHEMOTHERAPY REFRIGERAT PHARMACEUTICAL WAST LAMINAR FLOW WORK BENCH LAMINAR FLOW WORK BENCH LAMINAR FLOW WORK STATI PYXIS SUPPLY-AUXILLARY PYXIS SUPPLY-AUXILLARY PYXIS SUPPLY-MAIN - NOT USED - REGULAR WASTE CONTAINER, SHARPS WASTE CONTAINER, SHARPS WASTE CONTAINER, MULTI-ADD PUMP ROLLABLE STOOL IV LABEL PRINTER	TYPE 1	ULE WEIGHT(APPROX.) 800 LBS N/A N/A N/A N/A 1,470 LBS 100 LBS 100 LBS 680 LBS 680 LBS 680 LBS 1,000 LBS 1,000 LBS 1,000 LBS N/A N/A N/A N/A N/A N/A 25 LBS N/A 25 LBS	90.5" 16" 18" 3" 84" 35" 26" 70" 70" 70" 78" 78" - - 27" 26" 13" - 13"	52.5" 15" 6" 18" 56" 22" 12" 50" 74" 52" 52" 52" - - 22ø" 13" 8" - 10"	33.5" 7.5" 18" 6" 35" 21" 18" 34" 34" 28" 28" - 19" 10" - 19"	-/A-9 -/- -/- -/- -/- -/- -/- -/- -	REMARKS VBM SG404 BAKER STERILO KELVINATOR/MODEL BT30RO KENMORE 564. BAKER "EDGEGARD"/MODEL E
ILET NORTH		EQUIP # 001 002 003 004 005 006 005 006 007 007 008 009 009 009 009 009 009 009 009 009	EQUIPMENT SC DESCRIPTION BSC WORKSTATION MONITOR CPU KEYBOARD PHARMACY REFRIGERATOR CHEMOTHERAPY REFRIGERATOR CHEMOTHERAPY REFRIGERAT PHARMACEUTICAL WAST LAMINAR FLOW WORK BENCH LAMINAR FLOW WORK BENCH LAMINAR FLOW WORK STATI PYXIS SUPPLY-AUXILLARY PYXIS SUPPLY-AUXILLARY PYXIS SUPPLY-AUXILLARY PYXIS SUPPLY-MAIN - NOT USED - REGULAR WASTE CONTAINER, SHARPS WASTE CONTAINER, MULTI-ADD PUMP ROLLABLE STOOL	TYPE 1 ER CONT.	ULE WEIGHT(APPROX.) 800 LBS N/A N/A N/A 1,470 LBS 100 LBS 100 LBS 440 LBS 680 LBS 680 LBS 1,000 LBS 1,000 LBS 1,000 LBS N/A N/A N/A N/A N/A N/A N/A	90.5" 16" 18" 3" 84" 35" 26" 70" 70" 78" 78" - - 27" 26" 13" - 13" 16"	52.5" 15" 6" 18" 56" 22" 12" 50" 74" 52" - 22ø" 13" 8" - 10" 12ø	33.5" 7.5" 18" 6" 35" 21" 18" 34" 28" 28" - - 19" 10" - 19"	-/A-9 -/- -/- -/- -/- -/- -/- -/- -/- -/- -	REMARKS VBM SG404 BAKER STERILO KELVINATOR/MODEL BT30RO KENMORE 564 BAKER "EDGEGARD"/MODEL E
ILET NORTH		EQUIP # 001 002 003 004 005 006 007 006 007 008 009 009 009 009 009 001 001 001 010 012 010 010 012 013 012 013 013 014 015 015 015 015 015 016 015 015 016 015 015 016 015 015 015 015 015 015 015 015 015 015	EQUIPMENT SC DESCRIPTION BSC WORKSTATION MONITOR CPU KEYBOARD PHARMACY REFRIGERATOR CHEMOTHERAPY REFRIGERATOR CHEMOTHERAPY REFRIGERAT PHARMACEUTICAL WAST LAMINAR FLOW WORK BENCH LAMINAR FLOW WORK BENCH LAMINAR FLOW WORK STATI PYXIS SUPPLY-AUXILLARY PYXIS SUPPLY-AUXILLARY PYXIS SUPPLY-AUXILLARY PYXIS SUPPLY-AUXILLARY PYXIS SUPPLY-MAIN - NOT USED - REGULAR WASTE CONTAINER, SHARPS WASTE CONTAINER, MULTI-ADD PUMP ROLLABLE STOOL IV LABEL PRINTER HAZARDOUS PHARMA. WASTE O	TYPE 1 ER CONT.	ULE WEIGHT(APPROX.) 800 LBS N/A N/A N/A N/A 1,470 LBS 100 LBS 100 LBS 680 LBS 680 LBS 680 LBS 680 LBS 1,000 LBS 1,000 LBS 1,000 LBS N/A N/A N/A N/A N/A N/A N/A N/A 25 LBS N/A 25 LBS N/A	90.5" 16" 18" 3" 84" 35" 26" 70" 70" 70" 78" 78" - - 27" 26" 13" - 13"	52.5" 15" 6" 18" 56" 22" 12" 50" 74" 52" 52" 52" - 220" 13" 8" - 10"	33.5" 7.5" 18" 6" 35" 21" 18" 34" 34" 28" 28" - 19" 10" - 19"	-/A-9 -/- -/- -/- -/- -/- -/- -/- -	REMARKS VBM SG404 BAKER STERILO KELVINATOR/MODEL BT30RO KENMORE 564 BAKER "EDGEGARD"/MODEL E
ILET NORTH		EQUIP # 001 002 003 004 005 005 005 005 005 005 007 008 009 009 009 001 001 001 001 001 001 001	EQUIPMENT SC DESCRIPTION BSC WORKSTATION MONITOR CPU KEYBOARD PHARMACY REFRIGERATOR CHEMOTHERAPY REFRIGERATOR CHEMOTHERAPY REFRIGERAT PHARMACEUTICAL WAST LAMINAR FLOW WORK BENCH LAMINAR FLOW WORK BENCH LAMINAR FLOW WORK STATI PYXIS SUPPLY-AUXILLARY PYXIS SUPPLY-AUXILLARY PYXIS SUPPLY-AUXILLARY PYXIS SUPPLY-AUXILLARY PYXIS SUPPLY-MAIN - NOT USED - REGULAR WASTE CONTAINER, SHARPS WASTE CONTAINER, SHARPS WASTE CONTAINER, MULTI-ADD PUMP ROLLABLE STOOL IV LABEL PRINTER HAZARDOUS PHARMA. WASTE O TRACE CHEMO CONTAINER - NOT USED - TABLE	TYPE 1 ER CONT.	ULE WEIGHT(APPROX.) 800 LBS N/A N/A N/A N/A 1,470 LBS 100 LBS 100 LBS 100 LBS 680 LBS 680 LBS 680 LBS 680 LBS 1,000 LBS 1,000 LBS 1,000 LBS 1,000 LBS N/A N/A N/A N/A N/A N/A N/A N/A 25 LBS N/A N/A 25 LBS N/A	90.5" 16" 18" 3" 84" 35" 26" 70" 70" 70" 78" 78" - 27" 26" 13" - 13" 16" 18" - 34"	52.5" 15" 6" 18" 56" 22" 12" 50" 74" 52" 52" 52" 74" 52" - - 22ø" 13" 8" - 10" 12ø 11" - 26"	33.5" 7.5" 18" 6" 35" 21" 18" 34" 34" 28" 28" - - 19" 10" - 19" 19" 19" 19" 19" 19" 19" 19" 19" 19" 19" 19" 19" 19" 19" 19" 19" 19" 19"	-/A-9 -/- -/- -/- -/- -/- -/- -/- -	REMARKS VBM SG404 BAKER STERILO KELVINATOR/MODEL BT30RO KENMORE 564 BAKER "EDGEGARD"/MODEL E
ILET NORTH		EQUIP # 001 002 003 004 005 006 005 006 007 007 008 009 009 009 009 001 001 001 001 010 012 010 012 013 012 013 012 013 015 015 015 015 015 015 015 015 015 015	EQUIPMENT SC DESCRIPTION BSC WORKSTATION MONITOR CPU KEYBOARD PHARMACY REFRIGERATOR CHEMOTHERAPY REFRIGERATOR CHEMOTHERAPY REFRIGERAT PHARMACEUTICAL WAST LAMINAR FLOW WORK BENCH LAMINAR FLOW WORK BENCH LAMINAR FLOW WORK STATI PYXIS SUPPLY-AUXILLARY PYXIS SUPPLY-AUXILLARY PYXIS SUPPLY-AUXILLARY PYXIS SUPPLY-AUXILLARY PYXIS SUPPLY-AUXILLARY PYXIS SUPPLY-AUXILLARY PYXIS SUPPLY-AUXILLARY NOT USED – REGULAR WASTE CONTAINER, SHARPS WASTE CONTAINER, MULTI-ADD PUMP ROLLABLE STOOL IV LABEL PRINTER HAZARDOUS PHARMA. WASTE O TRACE CHEMO CONTAINER	TYPE 1 ER CONT.	ULE WEIGHT(APPROX.) 800 LBS N/A N/A N/A N/A 1,470 LBS 100 LBS 100 LBS A40 LBS 680 LBS 680 LBS A40 LBS 680 LBS A1,000 LBS 1,000 LBS N/A	90.5" 16" 18" 3" 84" 35" 26" 70" 70" 70" 70" 70" 70" 78" 78" - 27" 26" 13" - 13" 16" 18" -	52.5" 15" 6" 18" 56" 22" 12" 50" 74" 52" 52" 52" 74" 52" 74" 52" 74 52" 74 52" 74 52" 74 52" 74 52" 74 52" 74 52" 74 52" 74 720" 13" 8" - 10" 120 11" -	33.5" 7.5" 18" 6" 35" 21" 18" 34" 34" 28" 28" - 19" 10" - 19" 15"	-/A-9 -/- -/- -/- -/- -/- -/- -/- -	REMARKS VBM SG404 BAKER STERILO KELVINATOR/MODEL BT30RO KENMORE 564 BAKER "EDGEGARD"/MODEL E
$\int_{26} \int_{26} ILET NORTH$ =:1/4" = 1'-0"		EQUIP # 001 002 003 004 005 006 007 006 007 008 009 009 009 001 001 010 010 010 010 010	EQUIPMENT SC DESCRIPTION BSC WORKSTATION MONITOR CPU KEYBOARD PHARMACY REFRIGERATOR CHEMOTHERAPY REFRIGERATOR CHEMOTHERAPY REFRIGERATOR CHEMOTHERAPY REFRIGERATOR CHEMOTHERAPY REFRIGERATOR CHEMOTHERAPY REFRIGERATOR LAMINAR FLOW WORK BENCH LAMINAR FLOW WORK BENCH LAMINAR FLOW WORK STATI PYXIS SUPPLY-AUXILLARY PYXIS SUPPLY-AUXILLARY PYXIS SUPPLY-MAIN - NOT USED - - NOT USED - REGULAR WASTE CONTAINER, SHARPS WASTE CONTAINER, SHARPS WASTE CONTAINER, SHARPS WASTE CONTAINER, MULTI-ADD PUMP ROLLABLE STOOL IV LABEL PRINTER HAZARDOUS PHARMA. WASTE O TRACE CHEMO CONTAINER - NOT USED - TABLE MULTI-ADD PUMP - NOT USED - PRINTER	TYPE 1 ER CONT.	ULE WEIGHT(APPROX.) 800 LBS N/A N/A N/A N/A 1,470 LBS 100 LBS 100 LBS 440 LBS 680 LBS 680 LBS 680 LBS 680 LBS 1,000 LBS 1,000 LBS 1,000 LBS 1,000 LBS N/A X/A N/A N/A N/A N/A N/A N/A N/A N/A N/A N	90.5" 16" 18" 3" 84" 35" 26" 70" 70" 70" 78" 78" - 27" 26" 13" - 13" 16" 18" - 34" 24" - 16"	52.5" 15" 6" 18" 56" 22" 12" 50" 74" 52" 52" 52" 52" 74" 52" 74" 52" 74 13" 8" - 10" 12ø 11" 26" 20" - 20"	33.5" 7.5" 18" 6" 35" 21" 18" 34" 34" 28" 28" - 19" 10" - 19" 10" - 19" 10" - 19" 10" - 19" 10" - 19" 16"	-/A-9 -/- -/- -/- -/- -/- -/- -/- -	REMARKS VBM SG404 BAKER STERILO KELVINATOR/MODEL BT30RO KENMORE 564 BAKER "EDGEGARD"/MODEL E
$\int_{26} \int_{26} ILET NORTH$ =:1/4" = 1'-0"		EQUIP # 001 002 003 004 005 006 007 006 007 008 009 009 009 001 001 001 010 010 010 010	EQUIPMENT SC DESCRIPTION BSC WORKSTATION MONITOR CPU KEYBOARD PHARMACY REFRIGERATOR CHEMOTHERAPY REFRIGERATOR CHEMOTHERAPY REFRIGERATOR CHEMOTHERAPY REFRIGERATOR CHEMOTHERAPY REFRIGERATOR CHEMOTHERAPY REFRIGERATOR CHEMOTHERAPY REFRIGERATOR CHEMOTHERAPY REFRIGERATOR CHEMOTHERAPY REFRIGERATOR PYXIS SUPPLY-AUXILLARY PYXIS SUPLY PYXIS SUPPLY-AUXILLARY	TYPE 1 ER CONT.	ULE WEIGHT(APPROX.) 800 LBS N/A N/A N/A N/A 1,470 LBS 100 LBS 100 LBS 440 LBS 680 LBS 680 LBS 680 LBS 680 LBS 680 LBS 1,000 LB	90.5" 16" 18" 3" 84" 35" 26" 70" 70" 70" 78" 78" - 27" 26" 13" - 13" 16" 18" - 34" 24" -	52.5" 15" 6" 18" 56" 22" 12" 50" 74" 52" - - 22ø" 13" 8" - 10" 12ø 11" 26" 20" -	33.5" 7.5" 18" 6" 35" 21" 18" 34" 34" 28" - 19" 10" - 19" 10" - 19" 10" - 19" 17" - 19"	-/A-9 -/- -/- -/- -/- -/- -/- -/- -	REMARKS VBM SG404 BAKER STERILO KELVINATOR/MODEL BT30RO KENMORE 564. BAKER "EDGEGARD"/MODEL E
$\int_{26} \int_{26} ILET NORTH$ =:1/4" = 1'-0"		EQUIP # 001 002 003 004 005 005 006 007 005 008 009 009 009 001 001 001 001 001 001 001	EQUIPMENT SC DESCRIPTION BSC WORKSTATION MONITOR CPU KEYBOARD PHARMACY REFRIGERATOR CHEMOTHERAPY REFRIGERATOR CHEMOTHERAPY REFRIGERATOR CHEMOTHERAPY REFRIGERATOR CHEMOTHERAPY REFRIGERATOR CHEMOTHERAPY REFRIGERATOR LAMINAR FLOW WORK BENCH LAMINAR FLOW WORK BENCH LAMINAR FLOW WORK STATI PYXIS SUPPLY-AUXILLARY PYXIS SUPPLY-AUXILLARY PYXIS SUPPLY-AUXILLARY PYXIS SUPPLY-AUXILLARY PYXIS SUPPLY-MAIN - NOT USED - REGULAR WASTE CONTAINER, SHARPS WASTE CONTAINER, SHARPS WASTE CONTAINER, SHARPS WASTE CONTAINER, MULTI-ADD PUMP ROLLABLE STOOL IV LABEL PRINTER HAZARDOUS PHARMA. WASTE O TRACE CHEMO CONTAINER - NOT USED - TABLE MULTI-ADD PUMP - NOT USED - PRINTER - NOT USED - MONITOR (PHARMACIST STATION WHITE BOARD	TYPE 1 ER CONT.	ULE WEIGHT(APPROX.) 800 LBS N/A N/A N/A N/A 1,470 LBS 100 LBS 100 LBS 440 LBS 680 LBS 680 LBS 680 LBS 680 LBS 1,000 LBS 1,000 LBS 1,000 LBS 1,000 LBS 1,000 LBS N/A X/A N/A S S N/A N/A N/A N/A 1,000 LBS N/A N/A 10 LBS N/A 10 LBS N/A 10 LBS N/A	90.5" 16" 18" 3" 84" 35" 26" 70" 70" 70" 78" 78" - 27" 26" 13" - 13" 16" 18" - 34" 24" - 16" 18" - 18" 36"	52.5" 15" 6" 18" 56" 22" 12" 50" 74" 52" 52" 52" 74" 52" - 22ø" 13" 8" - 10" 12ø 11" - 26" 20" - 18" 24"	33.5" 7.5" 18" 6" 35" 21" 18" 34" 34" 28" 28" - - - 19" 10" - 19" 10" - 19" 10" - 19" 10" - 19" 10" - 19" 10" - 19" 10" - 19" 10" - 19" 10" 6" 19"	-/A-9 $-/-$	REMARKS
$\int_{26} \int_{26} ILET NORTH$ =:1/4" = 1'-0"		EQUIP # 001 002 003 004 005 005 006 007 006 007 008 009 009 000 001 001 001 001 001 001 001	EQUIPMENT SC DESCRIPTION BSC WORKSTATION MONITOR CPU KEYBOARD PHARMACY REFRIGERATOF CHEMOTHERAPY REFRIGERATOF CHEMOTHERAPY REFRIGERATOR CHEMOTHERAPY REFRIGERATOR CHEMOTHERAPY REFRIGERATOR CHEMOTHERAPY REFRIGERATOR PHARMACEUTICAL WAST LAMINAR FLOW WORK BENCH LAMINAR FLOW WORK STATI PYXIS SUPPLY-AUXILLARY PYXIS SUPPLY-AUXILLARY PYXIS SUPPLY-AUXILLARY PYXIS SUPPLY-AUXILLARY PYXIS SUPPLY-MAIN - NOT USED - REGULAR WASTE CONTAINER, SHARPS WASTE CONTAINER, SHARPS WASTE CONTAINER, SHARPS WASTE CONTAINER, SHARPS WASTE CONTAINER, MULTI-ADD PUMP ROLLABLE STOOL IV LABEL PRINTER HAZARDOUS PHARMA. WASTE O TRACE CHEMO CONTAINER - NOT USED - TABLE MULTI-ADD PUMP - NOT USED - REFRIGERATOR	CONT.	ULE WEIGHT(APPROX.) 800 LBS N/A N/A N/A N/A 1,470 LBS 100 LBS 100 LBS 680 LBS 680 LBS 680 LBS 680 LBS 680 LBS 1,000 LBS 1,000 LBS 1,000 LBS 1,000 LBS N/A N/A N/A N/A N/A N/A N/A N/A 25 LBS N/A N/A 25 LBS N/A N/A 120 LBS N/A N/A 120 LBS N/A N/A 120 LBS N/A N/A N/A 120 LBS N/A N/A 120 LBS N/A	90.5" 16" 18" 3" 84" 35" 26" 70" 70" 78" 78" - 27" 26" 13" - 13" 16" 18" - 34" 24" - 16" 18"	52.5" 15" 6" 18" 56" 22" 12" 50" 74" 52" 52" 52" 74" 52" - - 22ø" 13" 8" - 10" 12ø 11" - 26" 20" - 20" - 18"	33.5" 7.5" 18" 6" 35" 21" 18" 34" 34" 28" 28" 28" - - - 19" 10" - 19" 10" - 19" 10" - 19" 10" - 19" 10" - 19" 10" - 19" 10" - 19" 10" - 10" - 19" 10" - 10" - 10" - 10" - - - - - - - - - - - - -	-/A-9 $-/-$	REMARKS VBM SG404 BAKER STERILO KELVINATOR/MODEL BT30RO KENMORE 564 BAKER "EDGEGARD"/MODEL E
$\int_{26} \int_{26} ILET NORTH$ =:1/4" = 1'-0"		EQUIP # 001 002 003 004 005 005 006 007 005 008 009 009 009 001 001 001 001 001 001 001	EQUIPMENT SC DESCRIPTION BSC WORKSTATION MONITOR CPU KEYBOARD PHARMACY REFRIGERATOR CHEMOTHERAPY REFRIGERATOR CHEMOTHERAPY REFRIGERATOR CHEMOTHERAPY REFRIGERATOR CHEMOTHERAPY REFRIGERATOR CHEMOTHERAPY REFRIGERATOR LAMINAR FLOW WORK BENCH LAMINAR FLOW WORK STATI PYXIS SUPPLY-AUXILLARY PYXIS SUPLY-AUXILLARY PYXIS SUPPLY-AUXILLARY PYXIS SUPPLY-AUXILL	CON T. CON T.	ULE WEIGHT(APPROX.) 800 LBS N/A N/A N/A N/A 1,470 LBS 100 LBS 100 LBS 680 LBS 680 LBS 680 LBS 680 LBS 680 LBS 1,000 LBS 1,000 LBS 1,000 LBS 1,000 LBS N/A N/A N/A N/A N/A N/A 25 LBS N/A 25 LBS N/A 25 LBS N/A 120 LBS N/A 10 LBS N/A	90.5" 16" 18" 3" 84" 35" 26" 70" 70" 78" 78" 78" 78" 78" 78" 78" 78	52.5" 15" 6" 18" 56" 22" 12" 50" 74" 52" 52" 52" 74" 52" - - 22ø" 13" 8" - 10" 12ø 11" - 26" 20" - 18" 24" 53" - - - - - 20" - - 18" 24" 53" - - - - - - - - - - - - -	33.5" 7.5" 18" 6" 35" 21" 18" 34" 34" 28" 28" - - 19" 10" - 19" 10" - 19" 10" - 19" 10" - 19" 10" - 16" - 16" - 6" N/A 30" - - - 16"	-/A-9 $-/-$	REMARKS
$\int_{26} \int_{26} ILET NORTH$ =:1/4" = 1'-0"		EQUIP # 001 002 003 004 005 005 006 007 008 009 000 007 008 009 001 001 001 001 001 001 001 001 001	EQUIPMENT SC DESCRIPTION BSC WORKSTATION MONITOR CPU KEYBOARD PHARMACY REFRIGERATOR CHEMOTHERAPY REFRIGERATOR CHEMOTHERAPY REFRIGERATOR CHEMOTHERAPY REFRIGERATOR CHEMOTHERAPY REFRIGERATOR CHEMOTHERAPY REFRIGERATOR CHEMOTHERAPY REFRIGERATOR CHEMOTHERAPY REFRIGERATOR NOT USED - NOT USED - NOT USED - REGULAR WASTE CONTAINER, SHARPS WASTE CONTAINER, SHARPS WASTE CONTAINER, SHARPS WASTE CONTAINER, MULTI-ADD PUMP ROLLABLE STOOL IV LABEL PRINTER HAZARDOUS PHARMA. WASTE O TRACE CHEMO CONTAINER - NOT USED - TABLE MULTI-ADD PUMP - NOT USED - TABLE MULTI-ADD PUMP - NOT USED - TABLE MULTI-ADD PUMP - NOT USED - TABLE MULTI-ADD PUMP MULTI-ADD PUMP - NOT USED - TABLE MULTI-ADD PUMP - NOT USED - MONITOR (PHARMACIST STATION WHITE BOARD REFRIGERATOR MOBILE INCINERATION WASTE WALL HUNG CLEANING SUPPLI	TYPE 1 ER CONT.	ULE WEIGHT(APPROX.) 800 LBS N/A N/A N/A N/A 1,470 LBS 100 LBS 100 LBS 680 LBS 680 LBS 680 LBS 680 LBS 680 LBS 680 LBS 1,000 LBS 1,000 LBS 1,000 LBS 1,000 LBS N/A N/A N/A N/A N/A N/A N/A 25 LBS N/A 25 LBS N/A 25 LBS N/A 120 LBS N/A 10 LBS 10	90.5" 16" 18" 3" 84" 35" 26" 70" 70" 70" 78" 78" 78" 78" 78" 78" 78" 78	52.5" 15" 6" 18" 56" 22" 12" 50" 74" 52" 52" 52" 74" 52" - - 220" 13" 8" - 10" 12Ø 11" - 26" 20" - 20" - 20" - 20" - 20" - 20" - 18" 24" 53" - 51"	33.5" 7.5" 18" 6" 35" 21" 18" 34" 34" 28" 28" - - 19" 10" - 19" 10" - 19" 10" - 19" 10" - 19" 10" - 19" 10" - 15" - 16" - 16" - 28"	-/A-9 $-/-$	REMARKS
$\int_{26} \int_{26} ILET NORTH$ =:1/4" = 1'-0"		EQUIP # 001 002 003 004 005 006 007 006 007 008 009 009 009 001 001 001 001 001 001 001	EQUIPMENT SC DESCRIPTION BSC WORKSTATION MONITOR CPU KEYBOARD PHARMACY REFRIGERATOR CHEMOTHERAPY REFRIGERATOR CHEMOTHERAPY REFRIGERATOR CHEMOTHERAPY REFRIGERATOR CHEMOTHERAPY REFRIGERATOR CHEMOTHERAPY REFRIGERATOR LAMINAR FLOW WORK BENCH LAMINAR FLOW WORK STATI PYXIS SUPPLY-AUXILLARY PYXIS SUPLY-AUXILLARY PYXIS SUPPLY-AUXILLARY PYXIS SUPPLY-AUXILL	TYPE 1 ER CONT.	ULE WEIGHT(APPROX.) 800 LBS N/A N/A N/A N/A 1,470 LBS 100 LBS 100 LBS 680 LBS 680 LBS 680 LBS 680 LBS 680 LBS 1,000 LBS 1,000 LBS 1,000 LBS 1,000 LBS N/A N/A N/A N/A N/A N/A 25 LBS N/A 25 LBS N/A 25 LBS N/A 120 LBS N/A 10 LBS N/A	90.5" 16" 18" 3" 84" 35" 26" 70" 70" 78" 78" 78" 78" 78" 78" 78" 78	52.5" 15" 6" 18" 56" 22" 12" 50" 74" 52" 52" 52" 74" 52" - - 22ø" 13" 8" - 10" 12ø 11" - 26" 20" - 18" 24" 53" - - - - - 20" - - 18" 24" 53" - - - - - - - - - - - - -	33.5" 7.5" 18" 6" 35" 21" 18" 34" 34" 28" 28" - - 19" 10" - 19" 10" - 19" 10" - 19" 10" - 19" 10" - 16" - 16" - 6" N/A 30" - - - 16"	-/A-9 $-/-$	REMARKS
$\int_{26} \int_{26} ILET NORTH$ =:1/4" = 1'-0"		EQUIP # 001 002 003 004 005 006 007 006 007 008 009 000 000 001 001 001 001 001 001 001	EQUIPMENT SC DESCRIPTION BSC WORKSTATION MONITOR CPU KEYBOARD PHARMACY REFRIGERATOR CHEMOTHERAPY REFRIGERATOR CHEMOTHERAPY REFRIGERATOR CHEMOTHERAPY REFRIGERATOR CHEMOTHERAPY REFRIGERATOR PHARMACEUTICAL WAST LAMINAR FLOW WORK BENCH LAMINAR FLOW WORK BENCH LAMINAR FLOW WORK STATI PYXIS SUPPLY-AUXILLARY PYXIS SUPLY PYXIS SUPPLY-AUXILLARY PYXIS SUPP	TYPE 1 ER CONT.	ULE WEIGHT(APPROX.) 800 LBS N/A N/A N/A N/A 1,470 LBS 100 LBS N/A 440 LBS 680 LBS 1,000 LBS 1,000 LBS 1,000 LBS N/A N/A <t< td=""><td>90.5" 16" 18" 3" 84" 35" 26" 70" 70" 70" 70" 78" 78" 78" 78" 78" 78" 78" 78</td><td>52.5" 15" 6" 18" 56" 22" 12" 50" 74" 52" 52" 52" 74" 52" - - 220" 13" 8" - 10" 12ø 11" - 26" 20" - 20" - 20" - 20" - 53" - 51" - - 51"</td><td>33.5" 7.5" 18" 6" 35" 21" 18" 34" 34" 28" 28" - 19" 10" - 19" 10" - 19" 10" - 19" 10" - 19" - 19" - 19" - 10" - 18" - 19" - 16" - 28" - 28" - 28" - 28" - 28" - - 28" - - - 28" -<!--</td--><td>-/A-9 $-/-$ $-/-$</td><td>REMARKS</td></td></t<>	90.5" 16" 18" 3" 84" 35" 26" 70" 70" 70" 70" 78" 78" 78" 78" 78" 78" 78" 78	52.5" 15" 6" 18" 56" 22" 12" 50" 74" 52" 52" 52" 74" 52" - - 220" 13" 8" - 10" 12ø 11" - 26" 20" - 20" - 20" - 20" - 53" - 51" - - 51"	33.5" 7.5" 18" 6" 35" 21" 18" 34" 34" 28" 28" - 19" 10" - 19" 10" - 19" 10" - 19" 10" - 19" - 19" - 19" - 10" - 18" - 19" - 16" - 28" - 28" - 28" - 28" - 28" - - 28" - - - 28" - </td <td>-/A-9 $-/-$ $-/-$</td> <td>REMARKS</td>	-/A-9 $-/-$	REMARKS
$\int_{26} \int_{26} ILET NORTH$ =:1/4" = 1'-0"		EQUIP # 001 002 003 004 005 006 007 008 009 000 000 001 001 001 001 001 001 001	EQUIPMENT SC DESCRIPTION BSC WORKSTATION MONITOR CPU KEYBOARD PHARMACY REFRIGERATOF CHEMOTHERAPY REFRIGERATOF CHEMOTHERAPY REFRIGERATOF CHEMOTHERAPY REFRIGERATOF CHEMOTHERAPY REFRIGERATOF LAMINAR FLOW WORK BENCH LAMINAR FLOW WORK STATI PYXIS SUPPLY-AUXILLARY PYXIS SUPPLY-AUXILLARY PYXIS SUPPLY-AUXILLARY PYXIS SUPPLY-AUXILLARY PYXIS SUPPLY-AUXILLARY PYXIS SUPPLY-MAIN - NOT USED - REGULAR WASTE CONTAINER, SHARPS WASTE CONTAINER, SHARPS WASTE CONTAINER, SHARPS WASTE CONTAINER, MULTI-ADD PUMP ROLLABLE STOOL IV LABEL PRINTER HAZARDOUS PHARMA. WASTE O TRACE CHEMO CONTAINER HAZARDOUS PHARMA. WASTE O TRACE CHEMO CONTAINER - NOT USED - TABLE MULTI-ADD PUMP - NOT USED - PRINTER - NOT USED - PRINTER - NOT USED - MONITOR (PHARMACIST STATION WHITE BOARD REFRIGERATOR MOBILE INCINERATION WASTE WALL HUNG CLEANING SUPPLI GLOVE CAC ISOLATOR - NOT USED - IV STORAGE(MOBILE) INCINERATION WASTE	TYPE 1 ER CONT.	ULE WEIGHT(APPROX.) 800 LBS N/A N/A N/A N/A 1,470 LBS 100 LBS 100 LBS 680 LBS 680 LBS 680 LBS 680 LBS 680 LBS 1,000 LBS 1,000 LBS 1,000 LBS 1,000 LBS N/A N/A N/A N/A N/A N/A N/A 25 LBS N/A 25 LBS N/A 25 LBS N/A 120 LBS N/A 10 LBS N/A	90.5" 16" 18" 3" 84" 35" 26" 70" 70" 70" 78" 78" 78" 78" 78" 78" 78" 78	52.5" 15" 6" 18" 56" 22" 12" 50" 74" 52" 52" 52" 74" 52" 74" 52" 74" 52" 74" 52" 74" 52" 74" 52" 74" 52" 74" 52" 74" 52" 74" 52" 74" 8" - 10" 12ø 11" - 20" - 20" - 20" - 18" 24" 53" - - - - - -	33.5" 7.5" 18" 6" 35" 21" 18" 34" 34" 28" 28" - - 19" 10" - 19" 10" - 19" 10" - 19" 10" - 19" 10" - 19" 10" - 18" - 19" 10" - 16" - 28" - 28" - 28" - 28" - - 28" - 14"	-/A-9 $-/-$	REMARKS
$\int_{26} \int_{26} ILET NORTH$ =:1/4" = 1'-0"		EQUIP # 001 002 003 004 005 006 007 006 007 008 009 000 000 001 001 001 001 001 001 001	EQUIPMENT SC DESCRIPTION BSC WORKSTATION MONITOR CPU KEYBOARD PHARMACY REFRIGERATOR CHEMOTHERAPY REFRIGERATOR CHEMOTHERAPY REFRIGERATOR CHEMOTHERAPY REFRIGERATOR CHEMOTHERAPY REFRIGERATOR PHARMACEUTICAL WAST LAMINAR FLOW WORK BENCH LAMINAR FLOW WORK BENCH LAMINAR FLOW WORK STATI PYXIS SUPPLY-AUXILLARY PYXIS SUPLY PYXIS SUPPLY-AUXILLARY PYXIS SUPP	TYPE 1 ER CONT.	ULE WEIGHT(APPROX.) 800 LBS N/A N/A N/A 1,470 LBS 100 LBS 100 LBS 100 LBS 100 LBS 1,000 LBS 680 LBS 1,000 LBS 1,000 LBS N/A N/A <td>90.5" 16" 18" 3" 84" 35" 26" 70" 70" 70" 78" 78" 78" 78" 78" 78" 78" 78</td> <td>52.5" 15" 6" 18" 56" 22" 12" 50" 74" 52" 52" 52" 74" 52" - - 220" 13" 8" - 10" 12ø 11" - 26" 20" - 20" - 20" - 20" - 53" - 51" - - 51"</td> <td>33.5" 7.5" 18" 6" 35" 21" 18" 34" 34" 28" 28" - 19" 10" - 19" 10" - 19" 10" - 19" 10" - 19" - 19" - 19" - 10" - 18" - 19" - 16" - 28" - 28" - 28" - 28" - 28" - - 28" - - - 28" -<!--</td--><td>-/A-9 $-/-$ $-/-$</td><td>REMARKS</td></td>	90.5" 16" 18" 3" 84" 35" 26" 70" 70" 70" 78" 78" 78" 78" 78" 78" 78" 78	52.5" 15" 6" 18" 56" 22" 12" 50" 74" 52" 52" 52" 74" 52" - - 220" 13" 8" - 10" 12ø 11" - 26" 20" - 20" - 20" - 20" - 53" - 51" - - 51"	33.5" 7.5" 18" 6" 35" 21" 18" 34" 34" 28" 28" - 19" 10" - 19" 10" - 19" 10" - 19" 10" - 19" - 19" - 19" - 10" - 18" - 19" - 16" - 28" - 28" - 28" - 28" - 28" - - 28" - - - 28" - </td <td>-/A-9 $-/-$ $-/-$</td> <td>REMARKS</td>	-/A-9 $-/-$	REMARKS
$\int_{26} \int_{26} ILET NORTH$ =:1/4" = 1'-0"		EQUIP # 001 002 003 004 005 005 006 007 008 009 001 010 001 011 001 011 012 013 013 014 015 016 017 018 016 017 018 019 020 021 021 023 022 023 023 024 025 025 026 027 028 029 030 031 031 032 033 034 035 036 037 037	EQUIPMENT SC DESCRIPTION BSC WORKSTATION MONITOR CPU KEYBOARD PHARMACY REFRIGERATOR CHEMOTHERAPY REFRIGERATOR CHEMOTHERAPY REFRIGERATOR CHEMOTHERAPY REFRIGERATOR CHEMOTHERAPY REFRIGERATOR CHEMOTHERAPY REFRIGERATOR PHARMACEUTICAL WAST LAMINAR FLOW WORK BENCH LAMINAR FLOW WORK STATI PYXIS SUPPLY-AUXILLARY PYXIS SUPPLY-AUXILLARY NULTI-ADD PUMP ROLLABLE STOOL IV LABEL PRINTER AUXIT-ADD PUMP - NOT USED - PRINTER - NOT USED - PRINTER - NOT USED - MONITOR (PHARMACIST STATINY WALL HUNG CLEANING SUPPLI CLOVE CAC ISOLATOR - NOT USED - - NOT	CONT.	ULE WEIGHT(APPROX.) 800 LBS N/A N/A N/A N/A 1,470 LBS 100 LBS N/A 440 LBS 680 LBS 1,000 LBS 1,000 LBS 1,000 LBS N/A N/A <t< td=""><td>90.5" 16" 18" 3" 84" 35" 26" 70" 70" 70" 78" 78" 78" 78" 78" 78" 78" 78</td><td>52.5" 15" 6" 18" 56" 22" 12" 50" 74" 52" - - 220" 13" 8" - 10" 12Ø 11" - 20" - 20" - 20" - 20" - 118" 24" 53" - - 51" - 14" 13"</td><td>33.5" 7.5" 18" 6" 35" 21" 18" 34" 34" 28" 28" - - 19" 10" - 19" 10" - 19" 10" - 19" 10" - 19" 10" - 19" 10" - 18" - 19" 10" - 16" - 28" - 28" - 28" - 28" - - 28" - 14"</td><td>-/A-9 -/- -/- -/- -/- -/- -/- -/- -</td><td>REMARKS</td></t<>	90.5" 16" 18" 3" 84" 35" 26" 70" 70" 70" 78" 78" 78" 78" 78" 78" 78" 78	52.5" 15" 6" 18" 56" 22" 12" 50" 74" 52" - - 220" 13" 8" - 10" 12Ø 11" - 20" - 20" - 20" - 20" - 118" 24" 53" - - 51" - 14" 13"	33.5" 7.5" 18" 6" 35" 21" 18" 34" 34" 28" 28" - - 19" 10" - 19" 10" - 19" 10" - 19" 10" - 19" 10" - 19" 10" - 18" - 19" 10" - 16" - 28" - 28" - 28" - 28" - - 28" - 14"	-/A-9 -/- -/- -/- -/- -/- -/- -/- -	REMARKS


GENERAL	NO	TES	<u>S:</u>						S F E I R
 THE GENERAL CONTR AND MEASUREMENTS REFER TO GENERAL N 	IN THE I	FIELD PRI	IOR TO ST	ARTING CO	NSTRU	CTION.			ARCHITECTS
INDICATED ON THIS S		N SHEET /	AU-UU FOR			I			5151 Shoreham Place, Suite 100 San Diego, Ca 92122
	LΕV	/ATI	ON (GENE	ERA		NO.	TES:	P: 619–299–3917 F: 619–299–5084 www.sfeirarch.com
1. NOT USED.									TCMC
2. NOT USED.									PHARMACY
3. NOT USED.									USP 800
т.									UPGRADE
5. IN CASES OF CABINET FIELD AND PROVIDE FIL WIDTH AS REQUIRED TO	LER PAN	IEL STRIP	S AT ENE	DS OR REDI					UFGRADE
6. ALL CABINET DOORS AN CABINET DOORS AND F VERTICALLY. DRAWERS	ULL HEIG	GHT CABIN	NETS SHA	LL HAVE P					Tri-City Medical Cente
7. ALL FILE DRAWERS SHA RODS EXTENDING FRON	ILL BE S	IZED FOR CK OF DI	R 8 1/2"x RAWER UN	11" FORMS	6. PRC 	VIDE F	FILE		4002 Vista Way
8. COORDINATE HEIGHT AN STUD FRAMING CONTRA FURTHER INFORMATION.									Oceanside, California 92056
9. REFER TO SHEET A5-8 ANCHORAGE/BACKING	RACK CO	ONNECTIC	DN.						OWNER: TRI-CITY MEDICAL CENTER 4002 VISTA WAY OCEANSIDE, CALIFORNIA 92056
10. GENERAL CONTRACTOR COORDINATE W/OWNER SHOP DRAWINGS AND F	FOR ALL	EQUIPM						D	ARCHITECT: SFEIR ARCHITECTS 5151 SHOREHAM PLACE, SUITE 100 SAN DIEGO, CALIFORNIA 92122 TEL(619)299-3917 FAX(619)299-5084
									MEP: P2S ENGINEERING, INC. 9665 CHESAPEAKE DRIVE, SUITE 230 SAN DIEGO, CA 92123 TEL(619)618–2347
3									STRUCTURAL: SUN STRUCTURAL ENGINEERING 2091 LAS PALMAS DRIVE, SUITE D CARLSBAD, CA 92011 TEL(760)438–1188
NEW CRASH RAILS. SEE 4/1 HUMIDITY MONITOR & PRESS DETAIL 3/A1~04.	SURE MOI	NITOR. M	OUNTING	HEIGHT TO	COMPL	Y WITH	\langle		State of the second se
									$-\underbrace{\bigwedge_{\Lambda}}_{\Lambda} \underbrace{\overbrace{\Lambda}}_{\text{OSHPD COMMENTS}} 10-09-17$
KS ILGARD, CALCS BY SSE	EXIS.	NEW O	FOI OFCI X	CFCI QNT	Y HVAC X	ELEC1	DATA N/A	SEISMIC X	$ \begin{array}{c c} \hline 2 \\ \hline 3 \\ \hline 0 \\ \hline 5 \\ \hline 10 \\ \hline 12 \\ \hline 11 \\ \hline 12 $
	X X		X X	4	N/A	N/A N/A		N/A N/A	4 4 DESIGN CHANGES 12-11-17 5 5 0SHPD COMMENTS 5-15-18
RG-4.1, CALCS BY SSE	X X		X X	4	N/A X	N/A X	N/A N/A	N/A X	6 DESIGN CHANGES 6-05-18 6 0 0
4.9149510	X X		X X	1	N/A N/A			N/A N/A	
EG4252, CALCS BY SSE CALCS BY SSE	X X		X X	1	X X	X X	N/A N/A	X X	
	X X		X X	1	X X	X X	X X	X X	REV: DESCRIPTION: DATE:
	X		x		N/A	N/A	N/A	N/A	
	× × ×		× ×	1	N/A X	<u> </u>		N/A N/A	OSHPD APPROVAL STAMP:
	X X		x x	9	N/A	N/A X		N/A N/A	OSHPD #: S171641-37-00
	× × ×		x x	1	N/A	N/A	N/A	N/A N/A	
	x								
	X		X	1	N/A	X	N/A	N/A	
	X		×	2	N/A	X	×	N/A	
	X X		x x	2	N/A N/A	<u> </u>	-	N/A N/A	SHEET TITLE:
ORG-3, CALCS BY SSE	X X		X						ELEVATIONS
	X	×	X	2					PROJECT TITLE:
									TCMC USP 800
	X X								PROJECT #: 01667.00 DRAWN BY: NI
	X X								$\frac{\text{CHECKED BY:}}{\text{SCALE:}} \frac{\text{JS}}{1/4" = 1'-0"} \text{A4-40}$
		X							$\frac{1/4}{DATE} = \frac{1-0}{07/31/17}$ OF

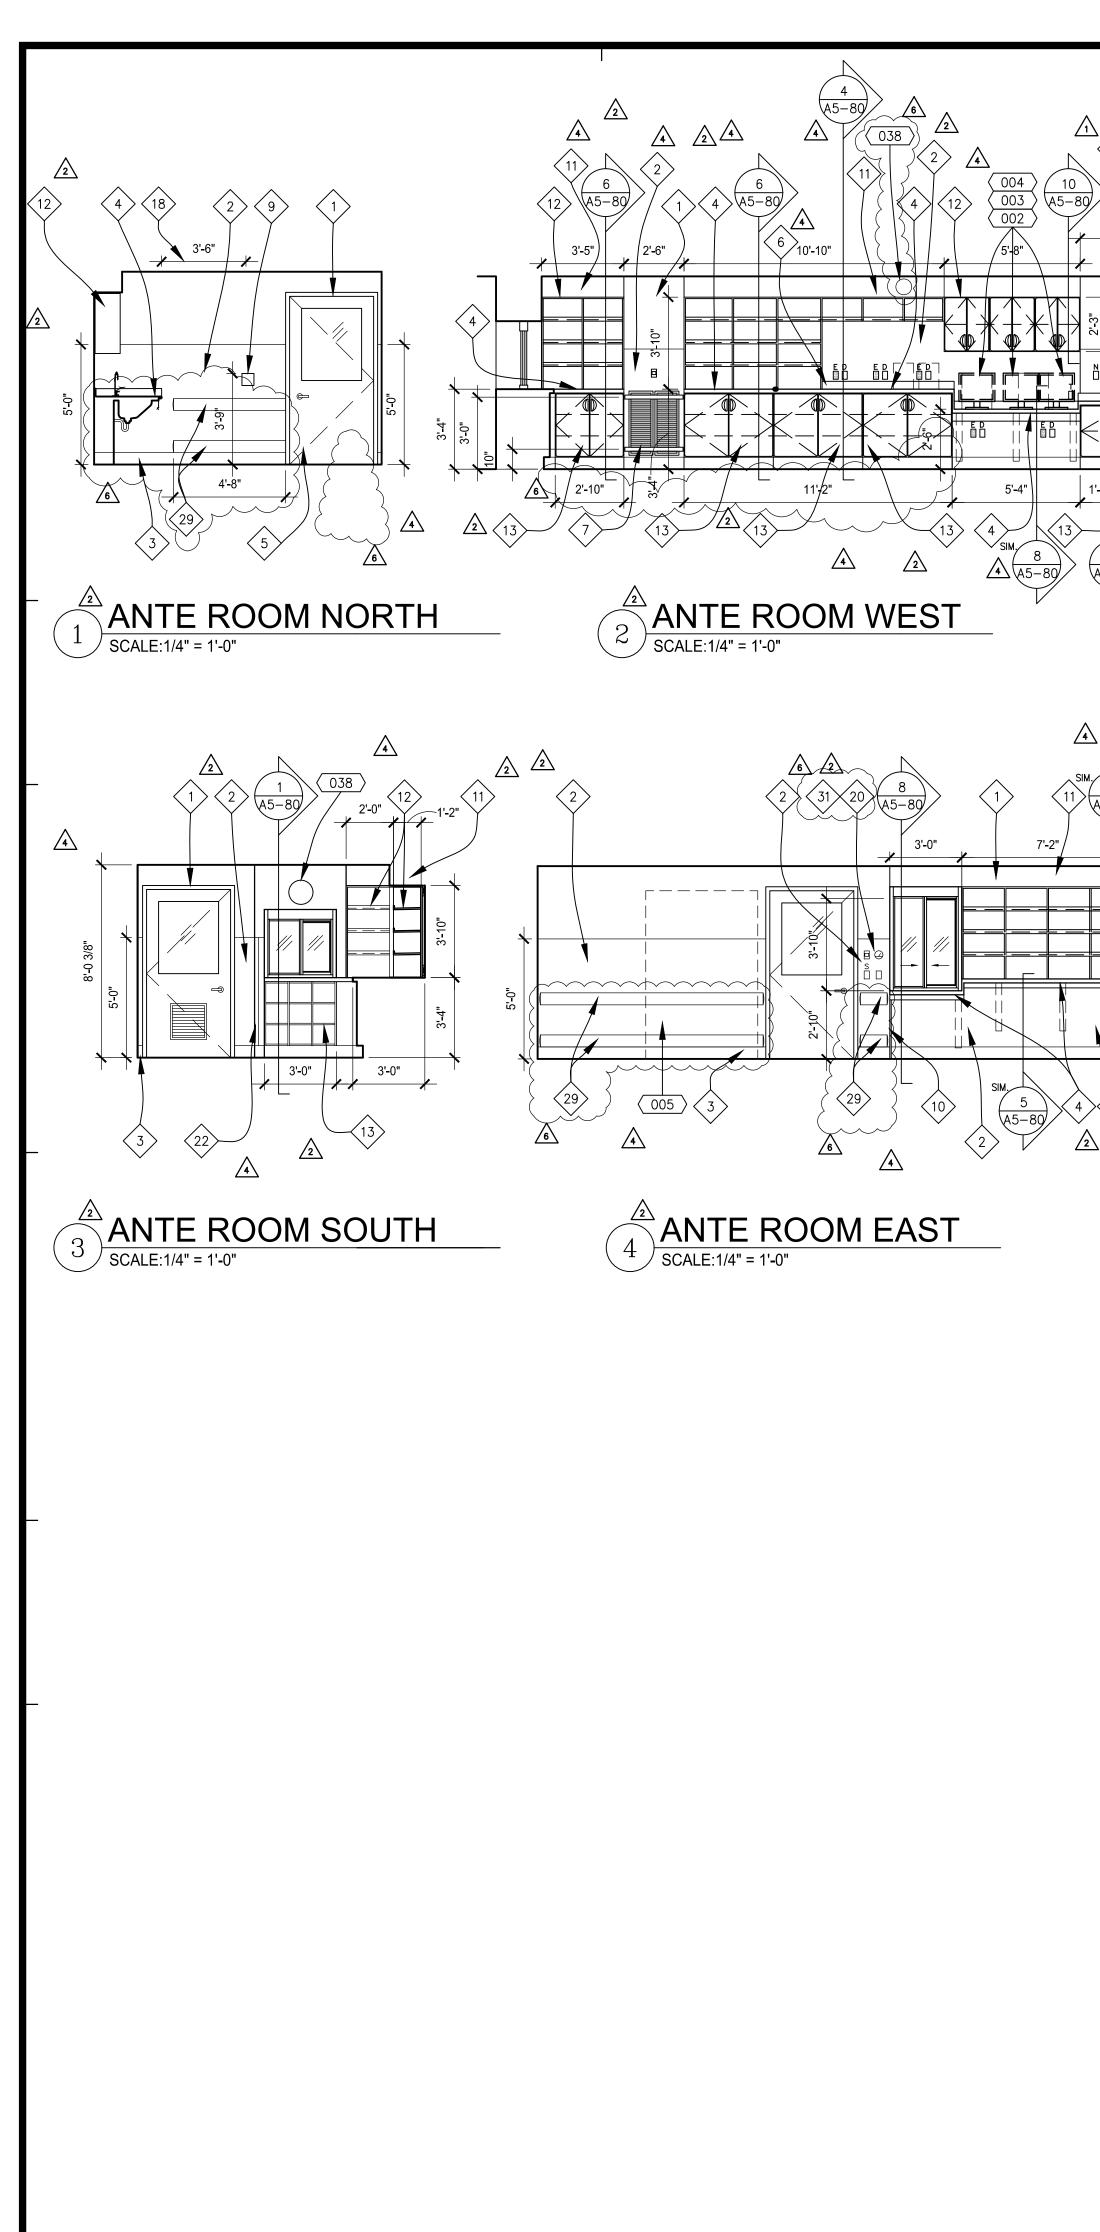


	LE	EGEN	ND:		Ι		ELEV	ΆΤΙΟ	N KE	YNOTES:
Λ	***	REFE	R TO EQUIPMENT SCHEDULE.			$\sqrt{1}$		O MATCH E	XISTING.	
	*	NOTE	S			2	> WALL PR	ROTECTION S	SHEETING SEE	e id sheet.
	Ċ	ASEW(ORK LEGEND:			3	∕ ∑6" VINYI	BASE TO	MATCH EXIST	ΓING.
5'-5"		SE ID N		<u>HEIGH</u>	T	4	`			/BACKSPLASH WITH SINK AND
	D100G			NUMBER	HEIGHT	\checkmark	EYEWASH			
			TH (INCHES) (= AS REQ'D.) SHT	——————————————————————————————————————	18" 24"	5	REINSTAL		R FRAME, PR	RIME AND PAINT, WITH NEW DOOR,
5-3			REFIX BLE		24 27" 30"	6	≻4" ВАСК	SPLASH.		
	3/8			E F	30" 33"	XT	>NEW LOW	V AIR EXHA	UST GRILLE.	
	TASK3	36 = 36" TAS	SK LIGHT MODULE SK LIGHT MODULE	G H	36" 39"	8	>NO LOWE	R CABINET	S. ADD WALL	PROTECTION.
			SK LIGHT MODULE NOT CONTROL PEDALS	J K	42" 48"	9	REINSTAL	LED DOOR	OPERATOR S	SENSOR PLATE.
		<u>PTH (U.(</u>	D.N. ON ELEVATIONS)	L M	54" 72"	\times			UPPORT PAN	
1'-11 3'-6"	LOW	ER CASE:	24" DEEP U.O.N. 14" DEEP U.O.N.	N P	80" 86" 96"	X				\wedge
	🔪 TALI		14" DEEP U.O.N. 14" DEEP U.O.N.	Q R	AS REQ'D.	X			ETAIL 6/A5-	10.
7 SIM. 9	<u> </u>		<u>SCRIPTION</u>			<12 ×	>UPPER S	STAINLESS S	STEEL CABINE	ITS.
A5-80 (4 A5-80)		- CODE		NO – NITRO D – OXYGE	EN	\sim	>LOWER S	TAINLESS S	STEEL CABINE	TS.
		 DATA DICTAF 		S – SWITC	E CALL PULL ST H	TATION 14	>NEW STA	NINLESS STE	EL TABLE.	
	Е	- DUPLE	R SWITCH I X ELECT. OUTLET I	T – TELEP TL – TASK	LIGHT	(15				CABINET. COORDINATE ROUGH
	IC	- FAX M - INTERC	COM \	TV – TELEV V – VACUU	JM	\sim	\sim	\sim	\sim	MANUFACTURER.
\wedge		JUNCTNURSE		VC – VOLUN VS – VACUU		(16	EXISTING	TO REMAIN	۱.	
<u>4</u>						<17 X	>new infi	LL PARTITIC	DN.	
						(18		AND DOFF	ING AREA.	
A5-80 (12) (19)	\wedge					19	> wall mc	UNTED CLE	ANING SUPPL	LIES.
10 3/8	4					20			TING HEIGHT	TO COMPLY WITH DETAIL
						21	3/A1-04 REINSTAL	I. L DOOR OF	PERATOR.	
						22		GUARD.		•
	3/8"					X				
i i i i i i i i i i i i i i i i i i i	-0- -1- -1-					25		AZED CERA		
						24		SS PAINT. F	PRIME AND P	AINT TO MATCH EXISTING.
						25	REMOVE	AND REINS	TALL TOILET	ACCESSORY.
1 June 1	1					26	>1"x1" CE	RAMIC FLOO	DR_ TILE.	·····)
8	\rightarrow									~~~~~~~~~~~~~~~~~~~~~~~~~~~~~~~~~~~~~~
2 (10) (28)	<u>~</u>					2 7	> PRESERV	E AND PRC	TECT TOILET	ACCESSORY.
						\times				(🗙
			WNER FURNISHED, OWNER INSTA WNER FURNISHED, CONTRACTOR			28		COUNTER S	SUPPORT SIMI	ILAR TO DETAIL 8/A5-80.
\checkmark \checkmark		OFCI : 0 ¹ CFCI : CC	WNER FURNISHED, CONTRACTOR ONTRACTOR FURNISHED, CONTRA	INSTALLED ACTOR INSTAL		28		COUNTER S	SUPPORT SIMI	ILAR TO DETAIL 8/A5-80.
\checkmark \checkmark		OFCI : 0 ¹ CFCI : CC	WNER FURNISHED, CONTRACTOR	INSTALLED ACTOR INSTAL		28		COUNTER S	SUPPORT SIMI	ILAR TO DETAIL 8/A5-80.
\checkmark \checkmark		OFCI : O' CFCI : CC	WNER FURNISHED, CONTRACTOR ONTRACTOR FURNISHED, CONTRA EQUIPMENT S DESCRIPTION	INSTALLED ACTOR INSTAL	ULE WEIGHT(APPROX.)	HEIGHT=h	WDTH=b	DEPTH=d	ELEV/SHT	REMARKS
\checkmark \checkmark		OFCI : 0 CFCI : CC EQUIP # 001	WNER FURNISHED, CONTRACTOR ONTRACTOR FURNISHED, CONTRA EQUIPMENT S DESCRIPTION BSC WORKSTATION	INSTALLED ACTOR INSTAL	ULE WEIGHT(APPROX.) 800 LBS	HEIGHT=h 90.5"	WIDTH=b 52.5"	DEPTH=d 33.5"	ELEV/SHT -/A-9	
\checkmark \checkmark		OFCI : O' CFCI : CC	WNER FURNISHED, CONTRACTOR ONTRACTOR FURNISHED, CONTRA EQUIPMENT S DESCRIPTION	INSTALLED ACTOR INSTAL	ULE WEIGHT(APPROX.)	HEIGHT=h	WDTH=b	DEPTH=d	ELEV/SHT	REMARKS
\checkmark \checkmark		OFCI : 0 CFCI : CC EQUIP # 001 002 003 004	WNER FURNISHED, CONTRACTOR ONTRACTOR FURNISHED, CONTRACTOR EQUIPMENT S DESCRIPTION BSC WORKSTATION MONITOR CPU KEYBOARD	INSTALLED ACTOR INSTAL	ULE WEIGHT(APPROX.) 800 LBS N/A N/A N/A	HEIGHT=h 90.5" 16" 18" 3"	WDTH=b 52.5" 15" 6" 18"	DEPTH=d 33.5" 7.5" 18" 6"	ELEV/SHT -/A-9 -/- -/-	REMARKS VBM SG404 BAKER STERILO
\checkmark \checkmark		OFCI : 0 CFCI : CC EQUIP # 001 002 003 004 005	WNER FURNISHED, CONTRACTOR ONTRACTOR FURNISHED, CONTRACTOR EQUIPMENT S DESCRIPTION BSC WORKSTATION MONITOR CPU KEYBOARD PHARMACY REFRIGERA	INSTALLED ACTOR INSTAL	ULE WEIGHT(APPROX.) 800 LBS N/A N/A N/A 1,470 LBS	HEIGHT=h 90.5" 16" 18" 3" 84"	WIDTH=b 52.5" 15" 6" 18" 56"	DEPTH=d 33.5" 7.5" 18" 6" 35"	ELEV/SHT -/A-9 -/- -/- -/-	REMARKS VBM SG404 BAKER STERILO KELVINATOR/MODEL BT30RO
\checkmark \checkmark		OFCI : 0 CFCI : CC EQUIP # 001 002 003 004	WNER FURNISHED, CONTRACTOR ONTRACTOR FURNISHED, CONTRACTOR EQUIPMENT S DESCRIPTION BSC WORKSTATION MONITOR CPU KEYBOARD	INSTALLED ACTOR INSTAL CHED	ULE WEIGHT(APPROX.) 800 LBS N/A N/A N/A	HEIGHT=h 90.5" 16" 18" 3"	WDTH=b 52.5" 15" 6" 18"	DEPTH=d 33.5" 7.5" 18" 6"	ELEV/SHT -/A-9 -/- -/-	REMARKS VBM SG404 BAKER STERILO
\checkmark \checkmark		OFCI : 0 CFCI : CC EQUIP # 001 002 002 003 004 004 005 006 006 007	WNER FURNISHED, CONTRACTOR ONTRACTOR FURNISHED, CONTRACTOR EQUIPMENTS DESCRIPTION BSC WORKSTATION MONITOR CPU KEYBOARD PHARMACY REFRIGERA CHEMOTHERAPY REFRIGER PHARMACEUTICAL WA LAMINAR FLOW WORK BEI	INSTALLED ACTOR INSTAL CHED	ULE WEIGHT(APPROX.) 800 LBS N/A N/A N/A 1,470 LBS 100 LBS N/A 440 LBS	HEIGHT=h 90.5" 16" 18" 3" 84" 35" 26" 70"	WDTH=b 52.5" 15" 6" 18" 56" 22" 12" 50"	DEPTH=d 33.5" 7.5" 18" 6" 35" 21" 18" 34"	ELEV/SHT -/A-9 -/- -/- -/- -/- -/- -/-	REMARKS VBM SG404 BAKER STERILO KELVINATOR/MODEL BT30RO KENMORE 564. BAKER "EDGEGARD"/MODEL E
\checkmark \checkmark		OFCI : 0 CFCI : CC EQUIP # 001 002 003 004 004 005 005 006 007 008 009	WNER FURNISHED, CONTRACTOR ONTRACTOR FURNISHED, CONTRACTOR FURNISHED, CONTRACTOR DESCRIPTION BSC WORKSTATION MONITOR CPU KEYBOARD PHARMACY REFRIGERA CHEMOTHERAPY REFRIGERA CHEMOTHERAPY REFRIGER PHARMACEUTICAL WA LAMINAR FLOW WORK BEI	INSTALLED ACTOR INSTAL CHED TOR RATOR ASTE NCH ATION	ULE WEIGHT(APPROX.) 800 LBS N/A N/A N/A 1,470 LBS 100 LBS N/A 440 LBS 680 LBS	HEIGHT=h 90.5" 16" 18" 3" 84" 35" 26" 70" 70"	WDTH=b 52.5" 15" 6" 18" 56" 22" 12" 50" 74"	DEPTH=d 33.5" 7.5" 18" 6" 35" 21" 18" 34" 34"	ELEV/SHT -/A-9 -/- -/- -/- -/- -/- -/- -/-	REMARKS VBM SG404 BAKER STERILO KELVINATOR/MODEL BT30RO KENMORE 564.
\checkmark \checkmark		OFCI : 0 CFCI : CC EQUIP # 001 002 002 003 004 004 005 006 006 007	WNER FURNISHED, CONTRACTOR ONTRACTOR FURNISHED, CONTRACTOR EQUIPMENTS DESCRIPTION BSC WORKSTATION MONITOR CPU KEYBOARD PHARMACY REFRIGERA CHEMOTHERAPY REFRIGER PHARMACEUTICAL WA LAMINAR FLOW WORK BEI	INSTALLED ACTOR INSTAL CHED TOR RATOR ASTE NCH ATION	ULE WEIGHT(APPROX.) 800 LBS N/A N/A 1,470 LBS 100 LBS N/A 440 LBS 680 LBS	HEIGHT=h 90.5" 16" 18" 3" 84" 35" 26" 70"	WDTH=b 52.5" 15" 6" 18" 56" 22" 12" 50"	DEPTH=d 33.5" 7.5" 18" 6" 35" 21" 18" 34"	ELEV/SHT -/A-9 -/- -/- -/- -/- -/- -/-	REMARKS VBM SG404 BAKER STERILO KELVINATOR/MODEL BT30RO KENMORE 564. BAKER "EDGEGARD"/MODEL E
\checkmark \checkmark		OFCI : 0 CFCI : CC EQUIP # 001 002 003 004 004 005 006 005 006 007 006 007 008 009 009 009 009	WNER FURNISHED, CONTRACTOR ONTRACTOR FURNISHED, CONTRACTOR EQUIPMENT S DESCRIPTION BSC WORKSTATION MONITOR CPU KEYBOARD PHARMACY REFRIGERA CHEMOTHERAPY REFRIGERA CHEMOTHERAPY REFRIGERA CHEMOTHERAPY REFRIGERA PHARMACEUTICAL WA LAMINAR FLOW WORK BEI LAMINAR FLOW WORK ST PYXIS SUPPLY-AUXILLA PYXIS SUPPLY-MAIN - NOT USED -	INSTALLED ACTOR INSTAL CHED TOR RATOR ASTE NCH ATION	ULE WEIGHT(APPROX.) 800 LBS N/A N/A N/A 1,470 LBS 100 LBS N/A 440 LBS 680 LBS 1,000 LBS 1,000 LBS N/A	HEIGHT=h 90.5" 16" 18" 3" 84" 35" 26" 70" 70" 70" 78"	WDTH=b 52.5" 15" 6" 18" 56" 22" 12" 50" 74" 52" 52" 52" -	DEPTH=d 33.5" 7.5" 18" 6" 35" 21" 18" 34" 34" 28"	ELEV/SHT -/A-9 -/- -/- -/- -/- -/- -/- -/- -	REMARKS VBM SG404 BAKER STERILO KELVINATOR/MODEL BT30RO KENMORE 564. BAKER "EDGEGARD"/MODEL E
\checkmark \checkmark		OFCI : 0 CFCI : CO EQUIP # 001 002 003 004 005 006 006 007 006 006 007 008 009 009 009 010 010 011 012 013	WNER FURNISHED, CONTRACTOR ONTRACTOR FURNISHED, CONTRACTOR FURNISHED, CONTRACTOR DESCRIPTION BSC WORKSTATION MONITOR CPU KEYBOARD PHARMACY REFRIGERA CHEMOTHERAPY REFRIGER PHARMACEUTICAL WA LAMINAR FLOW WORK BEI LAMINAR FLOW WORK ST PYXIS SUPPLY-AUXILLA PYXIS SUPPLY-AUXILLA PYXIS SUPPLY-MAIN - NOT USED - - NOT USED -	INSTALLED ACTOR INSTAL CHED	ULE WEIGHT(APPROX.) 800 LBS N/A N/A N/A 1,470 LBS 100 LBS 100 LBS 680 LBS 680 LBS 1,000 LBS 1,000 LBS N/A N/A N/A	HEIGHT=h 90.5" 16" 18" 3" 84" 35" 26" 70" 70" 70" 78" 78" - - -	WDTH=b 52.5" 15" 6" 18" 56" 22" 12" 50" 74" 52" 52" 52" - -	DEPTH=d 33.5" 7.5" 18" 6" 35" 21" 18" 34" 34" 28" 28"	ELEV/SHT -/A-9 -/- -/- -/- -/- -/- -/- -/- -	REMARKS VBM SG404 BAKER STERILO KELVINATOR/MODEL BT30RO KENMORE 564. BAKER "EDGEGARD"/MODEL E
\checkmark \checkmark		OFCI : 0 CFCI : CO EQUIP # 001 002 003 004 004 005 006 005 006 007 006 007 008 009 009 009 009 009 009 009 009 009	WNER FURNISHED, CONTRACTOR ONTRACTOR FURNISHED, CONTRACTOR EQUIPMENT S DESCRIPTION BSC WORKSTATION MONITOR CPU KEYBOARD PHARMACY REFRIGERA CHEMOTHERAPY REFRIGERA CHEMOTHERAPY REFRIGERA CHEMOTHERAPY REFRIGERA PHARMACEUTICAL WA LAMINAR FLOW WORK BEI LAMINAR FLOW WORK ST PYXIS SUPPLY-AUXILLA PYXIS SUPPLY-MAIN - NOT USED -	INSTALLED ACTOR INSTAL CHED	ULE WEIGHT(APPROX.) 800 LBS N/A N/A N/A 1,470 LBS 100 LBS N/A 440 LBS 680 LBS 1,000 LBS 1,000 LBS N/A	HEIGHT=h 90.5" 16" 18" 3" 84" 35" 26" 70" 70" 70" 70" 78" 78" -	WDTH=b 52.5" 15" 6" 18" 56" 22" 12" 50" 74" 52" 52" 52" -	DEPTH=d 33.5" 7.5" 18" 6" 35" 21" 18" 34" 34" 28" 28" 28" - -	ELEV/SHT -/A-9 -/- -/- -/- -/- -/- -/- -/- -	REMARKS VBM SG404 BAKER STERILO KELVINATOR/MODEL BT30RO KENMORE 564. BAKER "EDGEGARD"/MODEL E
\checkmark \checkmark		OFCI : 0 CFCI : CO EQUIP # 001 002 003 004 004 005 006 007 006 007 006 007 006 007 008 009 009 009 009 009 009 009 009 009	WNER FURNISHED, CONTRACTOR ONTRACTOR FURNISHED, CONTRACTOR EQUIPMENTS DESCRIPTION BSC WORKSTATION MONITOR CPU KEYBOARD PHARMACY REFRIGERA CHEMOTHERAPY REFRIGER PHARMACEUTICAL WA LAMINAR FLOW WORK BEI LAMINAR FLOW WORK ST PYXIS SUPPLY-AUXILLA PYXIS SUPPLY-AUXILLA PYXIS SUPPLY-AUXILLA PYXIS SUPPLY-AUXILLA PYXIS SUPPLY-MAIN - NOT USED - REGULAR WASTE CONTAINE SHARPS WASTE CONTAINE	INSTALLED ACTOR INSTAL CHED	ULE WEIGHT(APPROX.) 800 LBS N/A N/A N/A 1,470 LBS 100 LBS 1,000 LBS 440 LBS 680 LBS 1,000 LBS 1,000 LBS 1,000 LBS N/A N/A N/A N/A N/A N/A	HEIGHT=h 90.5" 16" 18" 3" 84" 35" 26" 70" 70" 70" 70" 78" 78" 78" 78" 78" 78" 78" 78" 78" 78	WDTH=b 52.5" 15" 6" 18" 56" 22" 12" 50" 74" 52" 52" - 22@" 13" 8"	DEPTH=d 33.5" 7.5" 18" 6" 35" 21" 18" 34" 28" 28" 28" 28" - - - - 19" 10"	ELEV/SHT -/A-9 -/////////	REMARKS VBM SG404 BAKER STERILO KELVINATOR/MODEL BT30RO KENMORE 564. BAKER "EDGEGARD"/MODEL E
\checkmark \checkmark		OFCI : 0 CFCI : CO EQUIP # 001 002 003 004 004 005 006 005 006 007 006 007 008 009 009 009 009 009 009 009 009 009	WNER FURNISHED, CONTRACTOR ONTRACTOR FURNISHED, CONTRACTOR EQUIPMENTS DESCRIPTION BSC WORKSTATION MONITOR CPU KEYBOARD PHARMACY REFRIGERA CHEMOTHERAPY REFRIGER PHARMACEUTICAL WA LAMINAR FLOW WORK BEI LAMINAR FLOW WORK ST PYXIS SUPPLY-AUXILLA PYXIS SUPPLY-AUXILLA PYXIS SUPPLY-MAIN - NOT USED - REGULAR WASTE CONTAINE SHARPS WASTE CONTAINE	INSTALLED ACTOR INSTAL CHED	ULE WEIGHT(APPROX.) 800 LBS N/A N/A N/A 1,470 LBS 100 LBS N/A 440 LBS 680 LBS 1,000 LBS 1,000 LBS N/A N/A N/A N/A	HEIGHT=h 90.5" 16" 18" 3" 84" 35" 26" 70" 70" 70" 70" 70" 78" 78" 78" - - 27" 26"	WDTH=b 52.5" 15" 6" 18" 56" 22" 12" 50" 74" 52" 52" - - 22ø" 13"	DEPTH=d 33.5" 7.5" 18" 6" 35" 21" 18" 34" 28" 28" 28" - - - - 19"	ELEV/SHT -/A-9 -/////////	REMARKS VBM SG404 BAKER STERILO KELVINATOR/MODEL BT30RO KENMORE 564. BAKER "EDGEGARD"/MODEL E
\checkmark \checkmark		OFCI : 0 CFCI : CO EQUIP # 001 002 003 004 005 006 007 006 006 007 006 007 008 009 009 000 009 009 000 000 000 001 001	WNER FURNISHED, CONTRACTOR ONTRACTOR FURNISHED, CONTRACTOR EQUIPMENTS DESCRIPTION BSC WORKSTATION MONITOR CPU KEYBOARD PHARMACY REFRIGERA CHEMOTHERAPY REFRIGER PHARMACEUTICAL WA LAMINAR FLOW WORK BEI LAMINAR FLOW WORK BEI LAMINAR FLOW WORK ST PYXIS SUPPLY-AUXILLA PYXIS SUPPLY-AUXILLA PYXIS SUPPLY-AUXILLA PYXIS SUPPLY-AUXILLA PYXIS SUPPLY-MAIN - NOT USED - REGULAR WASTE CONTAINE SHARPS WASTE CONTAINE ROLLABLE STOOL	INSTALLED ACTOR INSTAL CHED	ULE WEIGHT(APPROX.) 800 LBS N/A N/A N/A 1,470 LBS 100 LBS 100 LBS 440 LBS 680 LBS 1,000 LBS 1,000 LBS 1,000 LBS N/A N/A N/A N/A N/A N/A N/A	HEIGHT=h 90.5" 16" 18" 3" 84" 35" 26" 70" 70" 70" 70" 78" 78" - - 27" 26" 13" -	WDTH=b 52.5" 15" 6" 18" 56" 22" 12" 50" 74" 52" 52" 52" 13" 8" -	DEPTH=d 33.5" 7.5" 18" 6" 35" 21" 18" 34" 34" 28" 28" 28" - - - - 19" 10" -	ELEV/SHT -/A-9 -/////////	REMARKS VBM SG404 BAKER STERILO KELVINATOR/MODEL BT30RO KENMORE 564. BAKER "EDGEGARD"/MODEL E
\checkmark \checkmark		OFCI : 0 CFCI : CI EQUIP # (001) (002) (003) (004) (005) (006) (007) (008) (007) (008) (007) (008) (001) (011) (012) (013) (014) (015) (016) (017) (018) (019) (020)	WNER FURNISHED, CONTRACTOR ONTRACTOR FURNISHED, CONTRACTOR DESCRIPTION BSC WORKSTATION MONITOR CPU KEYBOARD PHARMACY REFRIGERA CHEMOTHERAPY REFRIGER PHARMACEUTICAL WA LAMINAR FLOW WORK BEI LAMINAR FLOW WORK ST PYXIS SUPPLY-AUXILLA PYXIS SUPPLY-AUXILLA PYXIS SUPPLY-AUXILLA PYXIS SUPPLY-AUXILLA SUPPLY-AUXILLA PYXIS SUPPLY-AUXILLA PYXIS SUPPLY-AUXILLA	INSTALLED ACTOR INSTAL CHED	ULE WEIGHT(APPROX.) 800 LBS N/A N/A N/A 1,470 LBS 100 LBS 100 LBS 440 LBS 680 LBS 680 LBS 1,000 LBS 1,000 LBS 1,000 LBS N/A N/A N/A N/A N/A N/A N/A N/A	HEIGHT=h 90.5" 16" 18" 3" 84" 35" 26" 70" 70" 70" 70" 78" 78" 78" 78" 78" 78" 78" 78" 78" 78	WDTH=b 52.5" 15" 6" 18" 56" 22" 12" 50" 74" 52" 52" 52" 74" 52" 74" 52" 11"	DEPTH=d 33.5" 7.5" 18" 6" 35" 21" 18" 34" 28" 28" 28" - - 19" 10" - 19" 10" - 19" 10" - 19" 15"	ELEV/SHT -/A-9 -/////////	REMARKS VBM SG404 BAKER STERILO KELVINATOR/MODEL BT30RO KENMORE 564. BAKER "EDGEGARD"/MODEL E
\checkmark \checkmark		0FCI : 0 CFCI : CI EQUIP # 001 002 003 004 005 006 007 006 007 008 009 010 010 011 012 013 014 015 014 015 016 017 018 019 020 021 021	WNER FURNISHED, CONTRACTOR ONTRACTOR FURNISHED, CONTRACTOR ONTRACTOR FURNISHED, CONTRACTOR DESCRIPTION BSC WORKSTATION MONITOR CPU KEYBOARD PHARMACY REFRIGERA CHEMOTHERAPY REFRIGER PHARMACEUTICAL WA LAMINAR FLOW WORK BEI LAMINAR FLOW WORK BEI LAMINAR FLOW WORK ST PYXIS SUPPLY-AUXILLA PYXIS SUPPLY-AUXILLA	INSTALLED ACTOR INSTAL CHED	ULE WEIGHT(APPROX.) 800 LBS N/A N/A N/A 1,470 LBS 100 LBS 100 LBS 440 LBS 680 LBS 1,000 LBS 1,000 LBS 1,000 LBS N/A N/A N/A N/A N/A N/A N/A N/A	HEIGHT=h 90.5" 16" 18" 3" 84" 35" 26" 70" 70" 70" 70" 70" 70" 70" 70" 70" 70	WDTH=b 52.5" 15" 6" 18" 56" 22" 12" 50" 74" 52" 52" 52" - - 22\$\vee 13" 8" - 10" 12\$\vee 11" -	DEPTH=d 33.5" 7.5" 18" 6" 35" 21" 18" 34" 34" 28" 28" 28" 28" 28" - - - - 19" 10" - - 19" 10" - - 19" 10" - - 19" 10" - - 19"	ELEV/SHT -/A-9 -/////////	REMARKS VBM SG404 BAKER STERILO KELVINATOR/MODEL BT30RO KENMORE 564. BAKER "EDGEGARD"/MODEL E
\checkmark \checkmark		OFCI : 0 CFCI : CI EQUIP # (001) (002) (003) (004) (005) (006) (007) (008) (007) (008) (007) (008) (001) (011) (012) (013) (014) (015) (016) (017) (018) (019) (020)	WNER FURNISHED, CONTRACTOR ONTRACTOR FURNISHED, CONTRACTOR DESCRIPTION BSC WORKSTATION MONITOR CPU KEYBOARD PHARMACY REFRIGERA CHEMOTHERAPY REFRIGER PHARMACEUTICAL WA LAMINAR FLOW WORK BEI LAMINAR FLOW WORK ST PYXIS SUPPLY-AUXILLA PYXIS SUPPLY-AUXILLA PYXIS SUPPLY-AUXILLA PYXIS SUPPLY-AUXILLA SUPPLY-AUXILLA PYXIS SUPPLY-AUXILLA PYXIS SUPPLY-AUXILLA	INSTALLED ACTOR INSTAL CHED	ULE WEIGHT(APPROX.) 800 LBS N/A N/A N/A 1,470 LBS 100 LBS 100 LBS 440 LBS 680 LBS 680 LBS 1,000 LBS 1,000 LBS 1,000 LBS N/A N/A N/A N/A N/A N/A N/A N/A	HEIGHT=h 90.5" 16" 18" 3" 84" 35" 26" 70" 70" 70" 70" 78" 78" 78" 78" 78" 78" 78" 78" 78" 78	WDTH=b 52.5" 15" 6" 18" 56" 22" 12" 50" 74" 52" 52" 52" 74" 52" 74" 52" 11"	DEPTH=d 33.5" 7.5" 18" 6" 35" 21" 18" 34" 28" 28" 28" - - 19" 10" - 19" 10" - 19" 10" - 19" 15"	ELEV/SHT -/A-9 -/////////	REMARKS VBM SG404 BAKER STERILO KELVINATOR/MODEL BT30RO KENMORE 564. BAKER "EDGEGARD"/MODEL E
\checkmark \checkmark		OFCI : 0 CFCI : CI EQUIP # (001) (002) (003) (004) (005) (006) (007) (008) (007) (008) (001) (010) (011) (012) (013) (014) (015) (016) (017) (018) (017) (018) (019) (020) (021) (022) (023) (024)	WNER FURNISHED, CONTRACTOR ONTRACTOR FURNISHED, CONTRACTOR EQUIPMENT S DESCRIPTION BSC WORKSTATION MONITOR CPU KEYBOARD PHARMACY REFRIGERA CHEMOTHERAPY REFRIGERA CHEMOTHERAPY REFRIGERA CHEMOTHERAPY REFRIGERA PHARMACEUTICAL WA LAMINAR FLOW WORK BEI LAMINAR FLOW WORK BEI LAMINAR FLOW WORK ST PYXIS SUPPLY-AUXILLA PYXIS SUPPLY-AUXILLA PYXIS SUPPLY-AUXILLA PYXIS SUPPLY-AUXILLA SUPPLY-AUXILLA PYXIS SUPPLY-MAIN - NOT USED - REGULAR WASTE CONTAINE SHARPS WASTE CONTAINE SHARPS WASTE CONTAINE SHARPS WASTE CONTAINE MULTI-ADD PUMP ROLLABLE STOOL IV LABEL PRINTER HAZARDOUS PHARMA. WAST TRACE CHEMO CONTAIN - NOT USED - TABLE MULTI-ADD PUMP	INSTALLED ACTOR INSTAL CHED	ULE WEIGHT(APPROX.) 800 LBS N/A N/A N/A 1,470 LBS 100 LBS 1,000 LBS 440 LBS 680 LBS 1,000 LBS 1,000 LBS 1,000 LBS 1,000 LBS N/A 25 LBS N/A N/A N/A 25 LBS N/A N/A 125 LBS N/A 120 LBS N/A	HEIGHT=h 90.5" 16" 18" 3" 84" 35" 26" 70" 70" 70" 78" 78" 78" 78" 78" 78" 78" 78" 78" 78	WDTH=b 52.5" 15" 6" 18" 56" 22" 12" 50" 74" 52" 52" 52" 74" 52" 74" 52" 13" 8" - 10" 12ø 11" 26" 20" -	DEPTH=d 33.5" 7.5" 18" 6" 35" 21" 18" 34" 28" 28" 28" 28" - 19" 10" - 19" 10" - 19" 10" - 19" 10" - 19" 17" -	ELEV/SHT -/A-9 -/////////	REMARKS VBM SG404 BAKER STERILO KELVINATOR/MODEL BT30RO KENMORE 564. BAKER "EDGEGARD"/MODEL E
\checkmark \checkmark		OFCI : 0 CFCI : CI EQUIP # (001) (002) (003) (004) (005) (006) (007) (008) (007) (008) (001) (010) (011) (012) (013) (014) (015) (016) (017) (018) (017) (018) (012) (021) (022) (021) (022) (023) (024) (025)	WNER FURNISHED, CONTRACTOR ONTRACTOR FURNISHED, CONTRACTOR FURNISHED, CONTRACTOR ONTRACTOR FURNISHED, CONTRACTOR DESCRIPTION BSC WORKSTATION MONITOR CPU KEYBOARD PHARMACY REFRIGERAT CHEMOTHERAPY REFRIGER PHARMACEUTICAL WA LAMINAR FLOW WORK BEN LAMINAR FLOW WORK BEN LAMINAR FLOW WORK ST PYXIS SUPPLY-AUXILLA PYXIS SUPPLY-AUXILLA PYXIS SUPPLY-AUXILLA PYXIS SUPPLY-MAIN - NOT USED - REGULAR WASTE CONTAINE SHARPS WASTE CONTAINE SHARPS WASTE CONTAINE SHARPS WASTE CONTAINE SHARPS WASTE CONTAINE MULTI-ADD PUMP ROLLABLE STOOL IV LABEL PRINTER HAZARDOUS PHARMA. WAST TRACE CHEMO CONTAIN - NOT USED - TABLE MULTI-ADD PUMP - NOT USED -	INSTALLED ACTOR INSTAL CHED	ULE WEIGHT(APPROX.) 800 LBS N/A N/A N/A N/A 1,470 LBS 100 LBS 100 LBS 100 LBS 440 LBS 680 LBS 680 LBS 440 LBS 680 LBS 1,000 LBS 1,000 LBS N/A AN/A N/A N/A N/A N/A N/A N/A N/A N/	HEIGHT=h 90.5" 16" 18" 3" 84" 35" 26" 70" 70" 70" 70" 70" 70" 70" 70" 70" 70	WDTH=b 52.5" 15" 6" 18" 56" 22" 12" 50" 74" 52" 52" - 22ø" 13" 8" - 10" 12ø 11" 26" 20"	DEPTH=d 33.5" 7.5" 18" 6" 35" 21" 18" 34" 28" 28" 28" - 19" 10" - 19" 10" - 19" 10" - 19" 10" - 19" 15" - 19" 17"	ELEV/SHT -/A-9 -/- -/- -/- <	REMARKS VBM SG404 BAKER STERILO KELVINATOR/MODEL BT30RO KENMORE 564. BAKER "EDGEGARD"/MODEL E
\checkmark \checkmark		OFCI : 0 CFCI : CI EQUIP # (001) (002) (003) (004) (005) (006) (007) (008) (007) (008) (001) (010) (011) (012) (013) (014) (015) (016) (017) (018) (017) (018) (019) (020) (021) (022) (023) (024)	WNER FURNISHED, CONTRACTOR ONTRACTOR FURNISHED, CONTRACTOR EQUIPMENT S DESCRIPTION BSC WORKSTATION MONITOR CPU KEYBOARD PHARMACY REFRIGERA CHEMOTHERAPY REFRIGERA CHEMOTHERAPY REFRIGERA CHEMOTHERAPY REFRIGERA PHARMACEUTICAL WA LAMINAR FLOW WORK BEI LAMINAR FLOW WORK BEI LAMINAR FLOW WORK ST PYXIS SUPPLY-AUXILLA PYXIS SUPPLY-AUXILLA PYXIS SUPPLY-AUXILLA PYXIS SUPPLY-AUXILLA SUPPLY-AUXILLA PYXIS SUPPLY-MAIN - NOT USED - REGULAR WASTE CONTAINE SHARPS WASTE CONTAINE SHARPS WASTE CONTAINE SHARPS WASTE CONTAINE MULTI-ADD PUMP ROLLABLE STOOL IV LABEL PRINTER HAZARDOUS PHARMA. WAST TRACE CHEMO CONTAIN - NOT USED - TABLE MULTI-ADD PUMP	INSTALLED ACTOR INSTAL CHED	ULE WEIGHT(APPROX.) 800 LBS N/A N/A N/A 1,470 LBS 100 LBS 1,000 LBS 440 LBS 680 LBS 1,000 LBS 1,000 LBS 1,000 LBS 1,000 LBS N/A 25 LBS N/A N/A N/A 25 LBS N/A N/A 125 LBS N/A 120 LBS N/A	HEIGHT=h 90.5" 16" 18" 3" 84" 35" 26" 70" 70" 70" 70" 78" 78" 78" 78" 78" 78" 78" 78" 78" 78	WDTH=b 52.5" 15" 6" 18" 56" 22" 12" 50" 74" 52" 52" 52" 74" 52" - 22ø" 13" 8" - 10" 12ø 11" - 26" 20"	DEPTH=d 33.5" 7.5" 18" 6" 35" 21" 18" 34" 28" 28" 28" 28" - 19" 10" - 19" 10" - 19" 10" - 19" 10" - 19" 10" - 15" - 19" 10" - 15" - 16"	ELEV/SHT -/A-9 -/////////	REMARKS VBM SG404 BAKER STERILO KELVINATOR/MODEL BT30RO KENMORE 564. BAKER "EDGEGARD"/MODEL E
\checkmark \checkmark		OFCI : 0 CFCI : C EQUIP # (001) (002) (003) (004) (005) (006) (007) (008) (007) (008) (007) (008) (001) (011) (012) (013) (014) (015) (016) (017) (018) (017) (018) (019) (021) (022) (023) (024) (025) (026)	WNER FURNISHED, CONTRACTOR ONTRACTOR FURNISHED, CONTRACTOR EQUIPMENT S DESCRIPTION BSC WORKSTATION MONITOR CPU KEYBOARD PHARMACY REFRIGERA CHEMOTHERAPY REFRIGER PHARMACEUTICAL WA LAMINAR FLOW WORK BEI LAMINAR FLOW WORK BEI LAMINAR FLOW WORK ST PYXIS SUPPLY-AUXILLA PYXIS SUPPLY-AUXILLA NULTI-ADD PUMP AULTI-ADD PUMP	INSTALLED ACTOR INSTAL CHED	ULE WEIGHT(APPROX.) 800 LBS N/A N/A N/A N/A 1,470 LBS 100 LBS 100 LBS 440 LBS 680 LBS 680 LBS 680 LBS 680 LBS 1,000 LBS 1,000 LBS 1,000 LBS 1,000 LBS N/A 25 LBS N/A N/A 25 LBS N/A 25 LBS N/A 25 LBS N/A 10 LBS N/A 120 LBS N/A 120 LBS N/A 10 LBS N/A	HEIGHT=h 90.5" 16" 18" 3" 84" 35" 26" 70" 70" 70" 70" 78" 78" 78" 78" 78" 78" 78" 78" 78" 78	WIDTH=b 52.5" 15" 6" 18" 56" 22" 12" 50" 74" 52" 52" 74" 52" 74" 52" 74" 52" 74 12" 13" 8" - 10" 12ø 11" - 26" 20" - 20" - 18" 24"	DEPTH=d 33.5" 7.5" 18" 6" 35" 21" 18" 34" 28" 28" 28" 28" 28" - 19" 10" - 19" 10" - 19" 10" - 19" 10" - 19" 10" - 19" 10" - 19" 10" - 15" - 16" - 16" - 16" - 16" - 16" - 16" - 16" - 16" - 16" - 16" - 16" - 16" - 16" - 16" - 16" - 16" - 16" - 16" - 18" - 18" - 18" - - - - - - - - - - - - -	ELEV/SHT -/A-9 -/- -/- -/- <	REMARKS VBM SG404 BAKER STERILO KELVINATOR/MODEL BT30RO KENMORE 564. BAKER "EDGEGARD"/MODEL E
\checkmark \checkmark		OFCI : 0 CFCI : CI EQUIP # (001) (002) (003) (004) (005) (006) (007) (008) (007) (008) (001) (010) (011) (012) (013) (014) (015) (016) (017) (018) (017) (018) (017) (018) (017) (018) (017) (018) (017) (018) (017) (018) (017) (021) (022) (021) (022) (021) (022) (021) (022) (023) (024) (025) (026) (027) (028) (029)<	WNER FURNISHED, CONTRACTOR ONTRACTOR FURNISHED, CONTRACTOR DESCRIPTION BSC WORKSTATION MONITOR CPU KEYBOARD PHARMACY REFRIGERA CHEMOTHERAPY REFRIGER PHARMACEUTICAL WA LAMINAR FLOW WORK BEI LAMINAR FLOW WORK ST PYXIS SUPPLY-AUXILLA PYXIS SUPPLY-AUXILLA PYXIS SUPPLY-AUXILLA PYXIS SUPPLY-AUXILLA PYXIS SUPPLY-AUXILLA SUPPLY-AUXILLA PYXIS SUPPLY-AUXILLA NOT USED – REGULAR WASTE CONTAINE SHARPS WASTE CONTAINE SHARPS WASTE CONTAINE SHARPS WASTE CONTAINE SHARPS WASTE CONTAINE SHARPS WASTE CONTAINE MULTI-ADD PUMP ROLLABLE STOOL IV LABEL PRINTER HAZARDOUS PHARMA. WAST TRACE CHEMO CONTAIN - NOT USED – TABLE MULTI-ADD PUMP - NOT USED – TABLE MULTI-ADD PUMP	INSTALLED ACTOR INSTAL CHED	ULE WEIGHT(APPROX.) 800 LBS N/A N/A N/A N/A 1,470 LBS 100 LBS 100 LBS 440 LBS 680 LBS 680 LBS 680 LBS 680 LBS 1,000 LBS 1,000 LBS 1,000 LBS N/A	HEIGHT=h 90.5" 16" 18" 3" 84" 35" 26" 70" 78" 78" 78" 78" 13" 16" 13" 16" 13" - 34" 24" - 34" 24" - 16" 18" 36" 79"	WIDTH=b 52.5" 15" 6" 18" 56" 22" 12" 50" 74" 52" 52" - 220" 11" - 20" 11" - 26" 20" - 20" - 18" 24" 53"	DEPTH=d 33.5" 7.5" 18" 6" 35" 21" 18" 34" 28" 28" 28" 28" 28" - 19" 10" - 10" - 19" 10" - 19" 10" - 19" 10" - 19" 10" - 10" - 19" 10" - - 10" - - 10" - - - - 10" - - - - 10" - - - - - 10" - - - - - - - - - - - - -	ELEV/SHT -/A-9 -/- -/- -/- <	REMARKS VBM SG404 BAKER STERILO KELVINATOR/MODEL BT30RO KENMORE 564. BAKER "EDGEGARD"/MODEL E
\checkmark \checkmark		OFCI :: 0 CFCI :: CI EQUIP # (001) (002) (003) (004) (005) (006) (007) (008) (007) (008) (001) (010) (011) (012) (013) (014) (015) (016) (017) (018) (017) (018) (017) (018) (017) (018) (017) (018) (017) (021) (022) (021) (022) (023) (024) (025) (026) (027) (028) (029) (030)	WNER FURNISHED, CONTRACTOR ONTRACTOR FURNISHED, CONTRACTOR DESCRIPTION BSC WORKSTATION MONITOR CPU KEYBOARD PHARMACY REFRIGERA CHEMOTHERAPY REFRIGER PHARMACEUTICAL WA LAMINAR FLOW WORK BEI LAMINAR FLOW WORK BEI LAMINAR FLOW WORK ST PYXIS SUPPLY-AUXILLA PYXIS SUPPLY-AUXILLA SUPLY PY	INSTALLED ACTOR INSTAL CHED	ULE WEIGHT(APPROX.) 800 LBS N/A N/A N/A N/A 1,470 LBS 100 LBS 100 LBS 440 LBS 680 LBS 680 LBS 680 LBS 680 LBS 1,000 LBS 1,000 LBS 1,000 LBS 1,000 LBS N/A 25 LBS N/A N/A 25 LBS N/A 25 LBS N/A 25 LBS N/A 10 LBS N/A 120 LBS N/A 120 LBS N/A 10 LBS N/A	HEIGHT=h 90.5" 16" 18" 3" 84" 35" 26" 70" 70" 70" 70" 78" 78" 78" 78" 78" 78" 78" 78" 78" 78	WIDTH=b 52.5" 15" 6" 18" 56" 22" 12" 50" 74" 52" 52" 74" 52" 74" 52" 74" 52" 74 12" 13" 8" - 10" 12ø 11" - 26" 20" - 20" - 18" 24"	DEPTH=d 33.5" 7.5" 18" 6" 35" 21" 18" 34" 28" 28" 28" 28" - 19" 10" - 19" 10" - 19" 10" - 19" 10" - 19" 10" - 19" 10" - 19" 10" - 19" 10" - 19" 10" - 19" 10" - 19" 10" - 10" - 19" 10" - 19" 10" - 19" 10" - 19" 10" - 19" 10" - 19" 10" - 19" 10" - 19" 10" - 19" 10" - 19" 10" - 19" 10" - 19" 10" - 19" 10" - 19" 10" - 10" - 19" 10" - 19" 10" - 19" 10" - 19" 10" - 19" 10" - 19" 10" - 19" 10" - 10" - 19" 10" - - 10" - - 10" - - 10" - - 10" - - - 10" - - - - - - - - - - - - -	ELEV/SHT -/A-9 -/- -/- -/- <	REMARKS
\checkmark \checkmark	Δı	OFCI : 0 CFCI : CI EQUIP # (001) (002) (003) (004) (005) (006) (007) (008) (007) (008) (001) (010) (011) (012) (013) (014) (015) (016) (017) (018) (017) (018) (017) (018) (017) (018) (017) (018) (017) (018) (017) (018) (017) (021) (022) (021) (022) (021) (022) (021) (022) (023) (024) (025) (026) (027) (028) (029)<	WNER FURNISHED, CONTRACTOR ONTRACTOR FURNISHED, CONTRACTOR DESCRIPTION BSC WORKSTATION MONITOR CPU KEYBOARD PHARMACY REFRIGERA CHEMOTHERAPY REFRIGER PHARMACEUTICAL WA LAMINAR FLOW WORK BEI LAMINAR FLOW WORK ST PYXIS SUPPLY-AUXILLA PYXIS SUPPLY-AUXILLA PYXIS SUPPLY-AUXILLA PYXIS SUPPLY-AUXILLA PYXIS SUPPLY-AUXILLA SUPPLY-AUXILLA PYXIS SUPPLY-AUXILLA NOT USED – REGULAR WASTE CONTAINE SHARPS WASTE CONTAINE SHARPS WASTE CONTAINE SHARPS WASTE CONTAINE SHARPS WASTE CONTAINE SHARPS WASTE CONTAINE MULTI-ADD PUMP ROLLABLE STOOL IV LABEL PRINTER HAZARDOUS PHARMA. WAST TRACE CHEMO CONTAIN - NOT USED – TABLE MULTI-ADD PUMP - NOT USED – TABLE MULTI-ADD PUMP	ACTOR INSTALLED ACTOR INSTAL CHED	ULE WEIGHT(APPROX.) 800 LBS N/A N/A N/A N/A 1,470 LBS 100 LBS 100 LBS 440 LBS 680 LBS 680 LBS 1,000 LBS 1,000 LBS 1,000 LBS 1,000 LBS N/A AN/A N/A N/A N/A N/A N/A N/A 25 LBS N/A 25 LBS N/A 25 LBS N/A 120 LBS N/A 10 LBS N/A 10 LBS N/A 1,654 LBS N/A	HEIGHT=h 90.5" 16" 18" 3" 84" 35" 26" 70" 70" 70" 70" 78" 78" 78" 78" 78" 78" 78" 78" 78" 78	WDTH=b 52.5" 15" 6" 18" 56" 22" 12" 50" 74" 52" 52" 52" 74" 52" - 22Ø" 13" 8" - 10" 12Ø 11" - 20" - 20" - 20" - 20" - 20" - 20" - 20" - 18" 24" 53"	DEPTH=d 33.5" 7.5" 18" 6" 35" 21" 18" 34" 28" 28" 28" 28" 28" 28" 28" 28" 28" 10" 	ELEV/SHT -/A-9 -/- -/- -/- <	REMARKS
\checkmark \checkmark		0FCI :: 0 CFCI :: CI EQUIP # 001 002 003 032	WNER FURNISHED, CONTRACTOR ONTRACTOR FURNISHED, CONTRACTOR DESCRIPTION BSC WORKSTATION MONITOR CPU KEYBOARD PHARMACY REFRIGERA CHEMOTHERAPY REFRIGER PHARMACEUTICAL WA LAMINAR FLOW WORK BER LAMINAR FLOW WORK BER LAMINAR FLOW WORK ST PYXIS SUPPLY-AUXILLA PYXIS SUPPLY-AUXILLA NOT USED - NOT USED - NOT USED - MONITOR (PHARMACIST ST WHITE BOARD REFRIGERATOR MOBILE INCINERATION WA WALL HUNG CLEANING SUP GLOVE CAC ISOLATOR MOBILE INCINERATION WA WALL HUNG CLEANING SUP	ACTOR INSTALLED ACTOR INSTAL CHED	ULE WEIGHT(APPROX.) 800 LBS N/A N/A N/A 1,470 LBS 100 LBS 100 LBS 440 LBS 680 LBS 680 LBS 1,000 LBS 1,000 LBS 1,000 LBS N/A N/A N/A N/A N/A N/A N/A N/A	HEIGHT=h 90.5" 16" 18" 3" 84" 35" 26" 70" 78" 78" 78" 78" 78" 13" 13" 13" 16" 13" 78" 78" 78" 78" 78" 78" 78" 78" 78" 78" 78" 78" 78" 78" 78" 78" 78" 78" 79" 79" 79" 79" 79" 79" 79" 70 70 70 70 70 70 70 70 70 70 </td <td>WIDTH=b 52.5" 15" 6" 18" 56" 22" 12" 50" 74" 52" - 22ø" 13" 8" - 10" 12ø 11" - 26" 20" - 20" - 20" - 20" - 20" - 20" - 18" 24" 53" - 51"</td> <td>DEPTH=d 33.5" 7.5" 18" 6" 35" 21" 18" 34" 28" 28" 28" - 19" 10" - 10" - 19" 10" - 10" - 19" 10" - - 10" - - 10" - - 10" - - 10" - - - 28" - - - - 28" - - - - - - - - - - - - -</td> <td>ELEV/SHT -/A-9 -/- -/- -/- <</td> <td>REMARKS</td>	WIDTH=b 52.5" 15" 6" 18" 56" 22" 12" 50" 74" 52" - 22ø" 13" 8" - 10" 12ø 11" - 26" 20" - 20" - 20" - 20" - 20" - 20" - 18" 24" 53" - 51"	DEPTH=d 33.5" 7.5" 18" 6" 35" 21" 18" 34" 28" 28" 28" - 19" 10" - 10" - 19" 10" - 10" - 19" 10" - - 10" - - 10" - - 10" - - 10" - - - 28" - - - - 28" - - - - - - - - - - - - -	ELEV/SHT -/A-9 -/- -/- -/- <	REMARKS
\checkmark \checkmark	Â	OFCI : 0 CFCI : CI EQUIP # (001) (002) (003) (004) (005) (006) (007) (008) (001) (002) (003) (004) (005) (006) (007) (008) (001) (010) (011) (012) (013) (014) (015) (016) (017) (018) (017) (018) (017) (018) (017) (018) (017) (021) (022) (023) (021) (022) (023) (021) (022) (023) (021) (022) (023) (031) (032) (033)<	WNER FURNISHED, CONTRACTOR DNTRACTOR FURNISHED, CONTRACTOR DESCRIPTION BSC WORKSTATION MONITOR CPU KEYBOARD PHARMACY REFRIGERA CHEMOTHERAPY REFRIGERA CHEMOTHERAPY REFRIGER PHARMACEUTICAL WA LAMINAR FLOW WORK BEI LAMINAR FLOW WORK BEI LAMINAR FLOW WORK ST PYXIS SUPPLY-AUXILLA PYXIS SUPPLY-AUXILLA PYXIS SUPPLY-AUXILLA PYXIS SUPPLY-AUXILLA SUPPLY-AUXILLA PYXIS SUPPLY-AUXILLA PYXIS SUPPLY-AUXILLA SUPPLY-AUXILLA PYXIS SUPPLY-AUXILLA PYXIS SUPPLY-AUXILLA PYXIS SUPPLY-AUXILLA SUPPLY-AUXILLA PYXIS SUPPLY-AUXILLA PYXIS SUPPLY-AUXILLA NULTI-ADD PUMP ROLLABLE STOOL IV LABEL PRINTER HAZARDOUS PHARMA. WAST TRACE CHEMO CONTAIN - NOT USED – NOT USED – MONITOR (PHARMACIST STA WHITE BOARD REFRIGERATOR MOBILE INCINERATION WA WALL HUNG CLEANING SUP GLOVE CAC ISOLATO - NOT USED – NOT USED –	ACTOR INSTALLED ACTOR INSTAL CHED	ULE WEIGHT(APPROX.) 800 LBS N/A N/A N/A N/A 1,470 LBS 100 LBS 100 LBS 440 LBS 680 LBS 440 LBS 680 LBS 680 LBS 1,000 LBS 1,000 LBS 1,000 LBS N/A 1,000 LBS N/A 25 LBS N/A 120 LBS N/A 10 LBS N/A 10 LBS N/A	HEIGHT=h 90.5" 16" 18" 3" 84" 35" 26" 70" 70" 78" - 27" 26" 13" - 27" 26" 13" - 27" 26" 13" - 23" 24" - 34" 24" - 16" 18" - 36" 79" - 85" - - 85"	WIDTH=b 52.5" 15" 6" 18" 56" 22" 12" 50" 74" 52" - 22ø" 13" 8" - 10" 12ø 11" - 26" 20" - 20" - 20" - 20" - 20" - 20" - 20" - 53" - 51"	DEPTH=d 33.5" 7.5" 18" 6" 35" 21" 18" 34" 28" 28" 28" 28" - 19" 10" - 10" - 19" 10" - 10" - 10" - 10" - 10" - 10" - 10" - 10" - 10" - 10" - 10" - - 10" - - 10" - - 10" - - - 10" - - - 10" - - - - - 28" - - - - - - - - - - - - -	ELEV/SHT -/A-9 -/- -/- -/- <	REMARKS
\checkmark \checkmark		0FCI :: 0 CFCI :: CI EQUIP # 001 002 003 032	WNER FURNISHED, CONTRACTOR ONTRACTOR FURNISHED, CONTRACTOR DESCRIPTION BSC WORKSTATION MONITOR CPU KEYBOARD PHARMACY REFRIGERA CHEMOTHERAPY REFRIGER PHARMACEUTICAL WA LAMINAR FLOW WORK BER LAMINAR FLOW WORK BER LAMINAR FLOW WORK ST PYXIS SUPPLY-AUXILLA PYXIS SUPPLY-AUXILLA NOT USED - NOT USED - NOT USED - MONITOR (PHARMACIST ST WHITE BOARD REFRIGERATOR MOBILE INCINERATION WA WALL HUNG CLEANING SUP GLOVE CAC ISOLATOR MOBILE INCINERATION WA WALL HUNG CLEANING SUP	INSTALLED ACTOR INSTAL CHED TOR RATOR ASTE NCH ASTE NCH ATION ARY C R, TYPE 1 AINER ER, TYPE 1 AINER	ULE WEIGHT(APPROX.) 800 LBS N/A N/A N/A 1,470 LBS 100 LBS 100 LBS 440 LBS 680 LBS 680 LBS 1,000 LBS 1,000 LBS 1,000 LBS N/A N/A N/A N/A N/A N/A N/A N/A	HEIGHT=h 90.5" 16" 18" 3" 84" 35" 26" 70" 78" 78" 78" 78" 78" 13" 13" 13" 16" 13" 78" 78" 78" 78" 78" 78" 78" 78" 78" 78" 78" 78" 78" 78" 78" 78" 78" 78" 79" 79" 79" 79" 79" 79" 79" 70 70 70 70 70 70 70 70 70 70 </td <td>WIDTH=b 52.5" 15" 6" 18" 56" 22" 12" 50" 74" 52" 52" 52" 74" 52" 74" 52" 74 52" 74 52" 74 52" 74" 52" 74 52" 74" 52" 74" 52" 74" 52" 74" 60" 74" 720" 7 7 7 7 7 7 7 7 7 7 7 7 7 7 7 7 7 7<td>DEPTH=d 33.5" 7.5" 18" 6" 35" 21" 18" 34" 28" 28" 28" - 19" 10" - 10" - 19" 10" - 10" - 19" 10" - - 10" - - 10" - - 10" - - 10" - - - 28" - - - - 28" - - - - - - - - - - - - -</td><td>ELEV/SHT -/A-9 -/- -/- -/- <</td><td>REMARKS</td></td>	WIDTH=b 52.5" 15" 6" 18" 56" 22" 12" 50" 74" 52" 52" 52" 74" 52" 74" 52" 74 52" 74 52" 74 52" 74" 52" 74 52" 74" 52" 74" 52" 74" 52" 74" 60" 74" 720" 7 7 7 7 7 7 7 7 7 7 7 7 7 7 7 7 7 7 <td>DEPTH=d 33.5" 7.5" 18" 6" 35" 21" 18" 34" 28" 28" 28" - 19" 10" - 10" - 19" 10" - 10" - 19" 10" - - 10" - - 10" - - 10" - - 10" - - - 28" - - - - 28" - - - - - - - - - - - - -</td> <td>ELEV/SHT -/A-9 -/- -/- -/- <</td> <td>REMARKS</td>	DEPTH=d 33.5" 7.5" 18" 6" 35" 21" 18" 34" 28" 28" 28" - 19" 10" - 10" - 19" 10" - 10" - 19" 10" - - 10" - - 10" - - 10" - - 10" - - - 28" - - - - 28" - - - - - - - - - - - - -	ELEV/SHT -/A-9 -/- -/- -/- <	REMARKS
\checkmark \checkmark		0FCI :: 0 CFCI :: CI EQUIP # 001 002 003 034	WNER FURNISHED, CONTRACTOR DNTRACTOR FURNISHED, CONTRACTOR DESCRIPTION BSC WORKSTATION MONITOR CPU KEYBOARD PHARMACY REFRIGERAT CHEMOTHERAPY REFRIGER PHARMACEUTICAL WA LAMINAR FLOW WORK BEI LAMINAR FLOW WORK ST PYXIS SUPPLY-AUXILLA PYXIS SUPPLY-AUXILLA MULTI-ADD PUMP - NOT USED - NOT USED - PRINTER - NOT USED - PRINTER - NOT USED - MONITOR (PHARMACIST ST/ WHITE BOARD REFRIGERATOR MOBILE INCINERATION WA WALL HUNG CLEANING SUP GLOVE CAC ISOLATOR - NOT USED - - NOT USED - - NOT U	INSTALLED ACTOR INSTAL CHED TOR RATOR ASTE NCH ASTE NCH ATION ARY C R, TYPE 1 AINER ER, TYPE 1 AINER	ULE WEIGHT(APPROX.) 800 LBS N/A N/A N/A N/A 1,470 LBS 100 LBS 100 LBS 440 LBS 680 LBS 680 LBS 1,000 LBS 1,000 LBS 1,000 LBS 1,000 LBS N/A 1,000 LBS N/A N/A N/A N/A N/A N/A 25 LBS N/A 25 LBS N/A 25 LBS N/A N/A 120 LBS N/A N/A 120 LBS N/A N/A 120 LBS N/A	HEIGHT=h 90.5" 16" 18" 3" 84" 35" 26" 70" 70" 78" 79" 16" 18" 36" 79" - 18" 36" 79" - 85" - - - 85" - -	WIDTH=b 52.5" 15" 6" 18" 56" 22" 12" 50" 74" 52" 52" - 220" 13" 8" - 1020" 11" 26" 20" - 20" - 20" - 20" - 20" - 20" - 20" - 53" - 51"	DEPTH=d 33.5" 7.5" 18" 6" 35" 21" 18" 34" 28" 28" 28" - 19" 10" - 10" - 19" 10" - 19" 10" - 10" - 19" 10" - 10" - 10" - 10" - 10" - 10" - 10" - 10" - 10" - 10" - 10" - 10" - 10" - 10" - 10" - 10" - 10" - 10" - 10" - - 10" - - 10" - - 10" - - 10" - - - 10" - - - 10" - - - 10" - - - - 10" - - - - - - - - - - - - -	ELEV/SHT -/A-9 -/- -/- -/- <	REMARKS
\checkmark \checkmark		0FCI :: 0 CFCI :: CI EQUIP # 001 002 003 034	WNER FURNISHED, CONTRACTOR DNTRACTOR FURNISHED, CONTRACTOR DESCRIPTION BSC WORKSTATION MONITOR CPU KEYBOARD PHARMACY REFRIGERA CHEMOTHERAPY REFRIGER PHARMACEUTICAL WA LAMINAR FLOW WORK BEI LAMINAR FLOW WORK ST PYXIS SUPPLY-AUXILLA PYXIS SUPPLY-AUXILLA NULTI-ADD PUMP ROLLABLE STOOL IV LABEL PRINTER HAZARDOUS PHARMA. WAST TRACE CHEMO CONTAIN - NOT USED - TABLE MULTI-ADD PUMP - NOT USED - NOT USED - NOT USED - MONITOR (PHARMACIST STA WHITE BOARD REFRIGERATOR MOBILE INCINERATION WA WALL HUNG CLEANING SUP GLOVE CAC ISOLATO - NOT USED - IV STORAGE(MOBILE) INCINERATION WASTE	INSTALLED ACTOR INSTAL CHED	ULE WEIGHT(APPROX.) 800 LBS N/A N/A N/A N/A 1,470 LBS 100 LBS 100 LBS 440 LBS 680 LBS 680 LBS 1,000 LBS 1,000 LBS 1,000 LBS 1,000 LBS N/A 1,000 LBS N/A 525 LBS N/A 255 LBS N/A 255 LBS N/A 255 LBS N/A 255 LBS N/A 120 LBS N/A	HEIGHT=h 90.5" 16" 18" 3" 84" 35" 26" 70" 70" 78" 78" - 27" 26" 13" - 27" 26" 13" - 27" 26" 13" - 24" - 34" 24" - 16" - 36" 79" - 85" - - 85"	WIDTH=b 52.5" 15" 6" 18" 56" 22" 12" 50" 74" 52" 52" - 22ø" 13" 8" - 10" 12ø 11" - 20" - 20" - 20" - 20" - 20" - 20" - 18" 24" 53" - - 51" - 14"	DEPTH=d 33.5" 7.5" 18" 6" 35" 21" 18" 34" 28" 28" 28" 28" - 19" 10" - 11" 10" - 11" 11" 11" 11" - 11" 11" - 11" 11"	ELEV/SHT -/A-9 -/- -/- -/- <	REMARKS

GENERA		10	TE	<u>S:</u>								SFEIR
1. THE GENERAL CO AND MEASUREM	IENTS IN	THE F	IELD P	RIOR	FO STA	RTING	CONS	STRUC				ARCHITECTS
2. REFER TO GENE INDICATED ON TI			SHEE	T A0-00) FOR	INFOR	MATIOI	N NOT				5151 Shoreham Place, Suite 100 San Diego, Ca 92122
INTERIOR	ELE	EVA		ЛС	GI	ΞN	ER	AL	NC	DTE	S:	
R.) 1. NOT USED.												
2. NOT USED.												
3. NOT USED.												PHARMACY
4. NOT USED.												USP 800
5. IN CASES OF CABINE FIELD AND PROVIDE WIDTH AS REQUIRED	FILLER F	PANEL	STRIPS	S AT E	ENDS (.S, VEF DR REI	RIFY DI DUCE E	MENSI END C	ONS IN ABINET	l S		UPGRADE
 ALL CABINET DOORS CABINET DOORS AND VERTICALLY. DRAWER 	FULL H	IEIGHT	CABIN	ets s	HALL	HAVE						Tri-City Medical Cente
7. ALL FILE DRAWERS S RODS EXTENDING FRO	SHALL BE	e sizei	D FOR	8 1/2	2"x 11'	' FORM	IS. P	Rovide	E FILE			4002 Vista Way
8. COORDINATE HEIGHT STUD FRAMING CONT FURTHER INFORMATIC	RACTOR.									ł		Oceanside, California 92056
9. REFER TO SHEET A5 ANCHORAGE/BACKING	-80 FOF				STEEL	COUN	TER					OWNER: TRI-CITY MEDICAL CENTER 4002 VISTA WAY
10. GENERAL CONTRACTO COORDINATE W/OWNE	ER FOR	ALL E	QUIPME								_	OCEANSIDE, CALIFORNIA 92056 ARCHITECT: SFEIR ARCHITECTS
SHOP DRAWINGS AND	r abric ר	a hon										5151 SHOREHAM PLACE, SUITE 100 SAN DIEGO, CALIFORNIA 92122 TEL(619)299–3917 FAX(619)299–5084
												MEP: P2S ENGINEERING, INC. 9665 CHESAPEAKE DRIVE, SUITE 230 SAN DIEGO, CA 92123
											_	TEL(619)618-2347 STRUCTURAL: SUN STRUCTURAL ENGINEERING
												2091 LAS PALMAS DRIVE, SUITE D CARLSBAD, CA 92011 TEL(760)438–1188
												CUNSED ATO
NEW CRASH RAILS. SEE 4	/ID-2 F	OR MC	RE INF	FORMA	TION A	AND ID	PLAN	ON IE)−1 . }			★ S No. C 28543 = ★
> HUMIDITY MONITOR & PRE 									Ή			VALLEOF CALIFORNIA
		1	1					1	1			$\frac{1}{2} \frac{1}{2} \frac{1}$
<s LGARD, CALCS BY SSE</s 		NEW X		OFCI X	CFCI	1	X	Х	N/A		;	$\begin{array}{c c} \hline & \hline \\ \hline \\$
	X X		X X			4 2	N/A N/A	N/A		N/A		5 OSHPD COMMENTS 5-15-18
RG-4.1, CALCS BY SSE	X X		X	x		4 1	N/A X	N/A X	N/A N/A	N/A X	-	$\underbrace{6}_{\text{C}} \underbrace{6}_{\text{C}} \underbrace{1}_{\text{C}} \underbrace{1}$
4.9149510	X X			X X		1	N/A N/A	N/A N/A			-	
EG4252, CALCS BY SSE CALCS BY SSE	X X			X X		1	x x	x x	N/A N/A	X X		
	X			x		1	X	x	X	Х		REV: DESCRIPTION: DATE:
	X			X		1	X	X	X	X		REV: DESCRIPTION: DATE:
	x		x			1	N/A	N/A	N/A	N/A	-	
	X X		X X			1	N/A X	N/A X	N/A N/A			
	X		x			9	N/A	N/A	N/A	N/A		oshpd approval stamp: OSHPD #: S171641—37—00
	X X		X X			1	N/A N/A	X N/A	X N/A	N/A N/A		"
	X		X			1	N/A	N/A	N/A	N/A		
	X X		x			1	N/A	x	N/A	N/A		
	X		X			2	N/A	X	X	N/A		
	X X		X X			2 1	N/A N/A	N/A N/A		N/A N/A		SHEET TITLE:
RG-3, CALCS BY SSE	X X			X								ELEVATIONS
	X	×		x		2						
												PROJECT TITLE: TCMC USP 800
	x											PROJECT #: 01667.00 SHEET NUMBER:
	X											$\frac{DRAWN BY:}{CHECKED BY:} JS \Delta \Delta \Delta \Delta 1$
	X	X										$\frac{1/4" = 1'-0"}{1/4" = 1'-0"}$
1												07/31/17 OF

 ritten permission of the ARCHITECT. 100% CONSTRUCTION DOCUMENT



<image/>		•				S F E	I
<complex-block></complex-block>							
			/ FE	RROUS OR COPPER		San Diego, Ca 92122 P: 619-299-3917	0
				STALLED FULL HICKNESS OF SLAB IN		www.sfeirarch.com	
<image/>				(ISTING CONCRETE			
•				2			
<complex-block></complex-block>)E
<text></text>				<u>∕.</u>			
SINLE CAPTURE ALL CAPTURE CAPTURES SINLE AND METALLICE FLOOR PENETRATION METALICE FLOOR PENETRATION			NOTE: TH	ROUGH PENETRATION		•	cal
WITHOUS PROPERTIES PARENTICS State Mathematical State Sta			SHALL CO	OMPLY WITH CBC		•	2056
Solar Ends						4002 VISTA WAY	
Spear New V4-1001 Lar 12, 200 The UP Company of the UP	(·	R PENETRATION	J	-	5151 SHOREHAM	PLACE, SL
P Reting - 0.1.2.3 and the (See Theme 2.20 d) T Theory - 0.1.2.3 and the (See Theme 2.20 d) T Lealing A ManDiart - test that 1 CHW/s ft Ling A ManDiart - test that 1 CHW/s ft Us						TEL(619)299–391 MEP: P2S ENGINEERING	7 FAX(61 , INC.
1 starting At 400 F - loss than 1 CPM reg 1 Image: control of the starting At 400 F - loss than 1 CPM reg 1 1 starting At 400 F - loss than 1 CPM reg 1 Image: control of the starting At 400 F - loss than 1 CPM reg 1 1 starting At 400 F - loss than 1 CPM reg 1 Image: control of the starting At 400 F - loss than 1 CPM reg 1 1 starting At 400 F - loss than 1 CPM reg 1 Image: control of the starting At 400 F - loss than 1 CPM reg 1 1 starting At 400 F - loss than 1 CPM reg 1 Image: control of the starting At 400 F - loss than 1 CPM reg 1 1 starting At 400 F - loss than 1 CPM reg 1 Image: control of the starting At 400 F - loss than 1 CPM reg 1 1 starting At 400 F - loss than 1 CPM reg 1 Image: control of the starting At 400 F - loss than 1 CPM reg 1 2 starting At 400 F - loss than 1 CPM reg 2 Image: control of the starting At 400 F - loss than 1 CPM reg 2 2 starting At 400 F - loss than 1 CPM reg 2 Image: control of the starting At 400 F - loss than 1 CPM reg 2 2 starting At 400 F - loss than 1 CPM reg 2 Image: control of the starting At 400 F - loss than 1 CPM reg 2 2 starting At 400 F - loss than 1 CPM reg 2 Image: control of the starting At 400 F - loss than 1 CPM reg 2 2 starting At 400 F - loss than 1 CPM reg 2 Image: control of the starting At 400 F - loss than 1 CPM reg 2 2 starting At 400 F - loss than 1 CPM reg 2 Image: control of the start1 CPM reg 2 <td< td=""><td></td><td>F Ratings — 1, 2, 3 a T Ratings — 0, 1,</td><td>and 4 Hr (See Items 2 and 2, 3, and 4 Hr (See Item 3)</td><td></td><td></td><td>SAN DIEGO, CA 9 TEL(619)618–234</td><td>)2123 7</td></td<>		F Ratings — 1, 2, 3 a T Ratings — 0, 1,	and 4 Hr (See Items 2 and 2, 3, and 4 Hr (See Item 3)			SAN DIEGO, CA 9 TEL(619)618–234)2123 7
Control - C		L Rating At 400	-	(1A)	•	2091 LAS PALMA CARLSBAD, CA 92	S DRIVE, S 2011
Provide the provide of the prov		3		3		NSED AP	· · · · · ·
EVEN From the second of the material of t						₩ No. C 28543 7 ★	
L. Suda Secondly — The 1.2. 3 or if in the probability of particular our assembly shall be constructed of the materials and in the individual 1000 methods the individual 1000 methods in the 0.1 m is interested and the individual 1000 methods in the 0.1 m is interested and the individual 1000 methods in the 0.1 m is interested and the individual 1000 methods in the 0.1 m is individual 1000 method in the 0.1 m is individual 1000 methods in the 0.1 m is individual 1000 method in the 0.1 m is individual 1000 methods in t				-1B		VI PRI 1-31-19	
A. Stude – Walk framing may conside of ether wood stude (may 2 b) there and assembles) or state ideant stude. Wood stude to conside of a main 2 by 40. (15) ftm (10) cmm) there are plates and muse branch. Stude studes to be mis 3.58 min (25 mm) side (13 mm) Cole manuscale on 2 by 40. (15) mm) (100 mm) there are plates and muse branch. Stude studes to be mis 3.58 min (25 mm) side (13 mm) (16 h, 46, 112 or mm) incle and studes (100 mm) (20 mm) (20 mm) constrained (100 mm) (20	manner described	in the individual U300 or U400 Series Wall	allboard/stud wall assembly s				·
	nom 2 by 4 in. (51	by 102 mm) lumber spaced 16 in. (406 m	m) OC with nom 2 by 4 in. (5	1 by 102 mm) lumber end plate		3 3 4 4 5 5	
annular space between pipe, conductor tubing and periphery of opening shall be min of 0 in / (0 mm), (point contexp), (0 max 2 in, (01 mm) Pictures of space of the pipe of the pipe of tubing and periphery of opening shall be min of 0 in / (10 mm), (point contexp), (0 max 2 in, (01 mm) Pictures of tubing may be used: A. Steel Pipe – Nom 24 in, (610 mm) diam (or smaller) Schedule 10 (or heavier) cast iron soil pipe, nom 12 in (305 mm) diam (or smaller) are vice weight (or heavier) cast iron soil pipe, nom 12 in (305 mm) diam (or smaller) are vice weight (or heavier) cast iron soil pipe, nom 12 in (305 mm) diam (or smaller) C. Conduit – Nom 6 in, (152 mm) diam (or smaller) Steel conduit or nom 4 in (102 mm) diam (or smaller) are electrical metallic tubing D. Copper Tubing – Nom 6 in, (152 mm) diam (or smaller) Regular (or heavier) copper tubing E. Conduit C = Mino 4 in (152 mm) diam (or smaller) Regular (or heavier) copper tubing E. Through Penetrating Product* — flickble Metal gas piping. Plastic covering on piping may or may not be removed on both sides of foor or wall assembly. OBERD FILE A. Yom 1 in (2 S mm) diam (or smaller) steel flexible metal gas piping. Plastic covering on piping may or may not be removed on both sides of foor or wall assembly. A. Steel Pipe Carl Metal * Diam 1 for foor wing type of order if and the bury free and gas piping. Plastic covering on piping may or may not be removed on both sides of foor or wall assembly. Matter III. Carl Metal * Carl Metal * Sign 1, 1/4, 1-7/8 and 2/1/2 in. (16, 32, 48 and 64 mm) thickness of carls applic within a muus, fish with both surface or will. Nu 1/4 in. (6 mm) thin the struct of the will assembly in which	thickness, number UL Fire Resistance	of layers, fastener type and sheet orientat Directory. Max diam of opening is 26 in. (6	ion shall be as specified in the 660 mm).	individual U300 or U400 Series	Design in the		
B. Dor Pipe – Hom 24 in (610 mm) dam (or smaller) service weight (or heavier) cast iron soil pipe, nom 12 in (305 mm) diam (or smaller) or Class 50 (or heavier) ductile iron pressure pipe. C. Conduit – Nom 6 in. (152 mm) diam (or smaller) type L (or heavier) copper tubing E. Copper Pipe – Nom 6 in. (152 mm) diam (or smaller) Type L (or heavier) copper tubing E. Copper Pipe – Nom 6 in. (152 mm) diam (or smaller) Type L (or heavier) copper tubing E. Copper Pipe – Nom 6 in. (152 mm) diam (or smaller) Regular (or heavier) copper pipe. F. Through Penetrating Product* – Flexible Metal Piping The following types of steel flexible metal gas piping may be used: 1. Nom 2 in. (51 mm) diam (or smaller) steel flexible metal gas piping. Plastic covering on piping may or may not be removed on both sides of floor or wall assembly. CASTITE, DIV OF TITEFLEX 3. Nom 1 in. (25 mm) diam (or smaller) steel flexible metal gas piping. Plastic covering on piping may or may not be removed on both sides of floor or wall assembly. CASTITE, DIV OF TITEFLEX 3. Fill, Vidi or Cavity Material* – Caulk or Sealent – Min 5/8., 1-1/4,1-7/8 and 2-1/2 in. (16, 32, 48 and 64 mm) thickness of caulk for 1, and 4 hr rated assembles, respectively, applied within annulus, flush with both surfaces of wall. Nm1 1/4 in.(6 mm) dam bead of caulk apple prysum boord/penetrant interface at point contain to basid or vall. In 1/4 1/-7/8 and 2-1/2 in. (16, 32, 48 and 64 mm) thickness of caulk for 1, and 4 hr rated assembles, respectively, applied within annulus, flush with both surfaces of wall. Nm1 1/4 in.(6 mm) dam bead of caulk apple provide to take the body of the ming of the frestop system is dependent to perform the temper at point conduct to cation on both sides of 1/1/2 in 1/2	annular space betw conduit or tubing t be used:	veen pipe, conduit or tubing and periphery o be rigidly supported on both sides of wall	of opening shall be min of 0 i l assembly. The following type	n / (0 mm). (point contact) to m is and sizes of metallic pipes, co	nax 2 in. (51 mm) Pi		
D. Copper Tubing — Nom 6 in. (152 mm) diam (or smaller) Type L (or heavier) copper tubing Comper Pipe — Nom 6 in. (152 mm) diam (or smaller) Regular (or heavier) copper pipe. F. Through Penetrating Product* — Flexible Metal Piping The following types of steel flexible metal gas piping may or may not be removed on both sides of floor or wall assembly. Costen Tubing — Nom 6 in. (152 mm) diam (or smaller) steel flexible metal gas piping. Plastic covering on piping may or may not be removed on both sides of floor or wall assembly. Costen Tubing — Nom 6 in. (152 mm) diam (or smaller) steel flexible metal gas piping. Plastic covering on piping may or may not be removed on both sides of floor or wall assembly. Costen Tubing — Nom 6 in. (152 mm) diam (or smaller) steel flexible metal gas piping. Plastic covering on piping may or may not be removed on both sides of floor or wall assembly. Costen Tubing — Nom 6 in. (152 mm) diam (or smaller) steel flexible metal gas piping. Plastic covering on piping may or may not be removed on both sides of floor or wall assembly. Costen Tubing — Nom 6 in. (152 mm) diam (or smaller) steel flexible metal gas piping. Plastic covering on piping may or may not be removed on both sides of floor or wall assembly. Costen Tubing — Nom 6 in. (152 mm) diam (or smaller) steel flexible metal gas piping. Plastic covering on piping may or may not be removed on both sides of floor or wall assembly in which is installed, subwall hour bir freetop system is dependent upon houry fire rating of the wall assembly in which it is installed. In the freetop system is dependent upon houry fire rating of the wall assembly in which it is installed, as tabulated below: Steet muc Image: Not of the pipe or conduct and the houry free rating of the wall assembly in which it is installed, as tabulated below: FIRE RATED ASSEMBLIES <td>B. Iron Pipe — No or Class 50 (or hea</td> <td>m 24 in. (610 mm) diam (or smaller) serv vier) ductile iron pressure pipe.</td> <td>ice weight (or heavier) cast ir</td> <td>on soil pipe, nom 12 in (305 mm</td> <td>_</td> <td></td> <td></td>	B. Iron Pipe — No or Class 50 (or hea	m 24 in. (610 mm) diam (or smaller) serv vier) ductile iron pressure pipe.	ice weight (or heavier) cast ir	on soil pipe, nom 12 in (305 mm	_		
1. Nom 2 in. (51 mm) diam (or smaller) steel flexible metal gas piping. Plastic covering on piping may or may not be removed on both sides of floor or wall assembly. OMEGA FLEX INC 2. Nom 1 in. (25 mm) diam (or smaller) steel flexible metal gas piping. Plastic covering on piping may or may not be removed on both sides of floor or wall assembly. GASTIEF, DIV OF TITEFLEX 3. Nom 1 in. (25 mm) diam (or smaller) steel flexible metal gas piping. Plastic covering on piping may or may not be removed on both sides of floor or wall assembly. MARC MEFG LL C 3. Nom 1 in. (25 mm) diam (or smaller) steel flexible metal gas piping. Plastic covering on piping may or may not be removed on both sides of floor or wall assembly in which it is installed, as shown in the following table. The hourly F Rating of the frestop system is dependent upon bourly fire retring of the wall dassemble in which it is installed, as shown in which it is installed. The hourly F Rating flux for the pipe or conduit and the hourly fire rating of the frestop system is dependent upon hourly fire rating of the firestop system is dependent upon the type or size of the pipe or conduit and the hourly fire rating of the wall assembly in which it is installed, as the hourly fire rating of the wall assembly in which it is installed, as thown in complex dia walled below: <td>D. Copper Tubing</td> <td>– Nom 6 in. (152 mm) diam (or smaller)</td> <td>Type L (or heavier) copper tu</td> <td>bing</td> <td>metallic tubing</td> <td></td> <td></td>	D. Copper Tubing	– Nom 6 in. (152 mm) diam (or smaller)	Type L (or heavier) copper tu	bing	metallic tubing		
OMEGA FLEX INC Osero ArMotox State: 2. Nom 1 in. (25 mm) diam (or smaller) steel flexible metal gas piping. Plastic covering on piping may or may not be removed on both sides of floor or wall assembly. OSHPD #: S171641-37-00 3. Nom 1 in. (25 mm) diam (or smaller) steel flexible metal gas piping. Plastic covering on piping may or may not be removed on both sides of floor or wall assembly. OSHPD #: S171641-37-00 3. Nom 1 in. (25 mm) diam (or smaller) steel flexible metal gas piping. Plastic covering on piping may or may not be removed on both sides of floor or wall assembly. Sill, Void or Cavity Material* - Caulk or Sealant - Min 5/8. , 1-1/4,1-7/8 and 2-1/2 in. (16, 32, 48 and 64 mm) thickness of caulk piping gypum board/penetrant interface at point contact location on both sides of wall. The hourly F Rating of the firestop system is dependent upon hourly fire rating of the wall assembly in which it is installed, as tabulated below: SHEET TILE: Image: Simple in the firestop system is dependent upon hourly fire rating of the wall assembly in which it is installed, as tabulated below: SHEET TILE: Image: Simple in the firestop system is dependent upon hourly fire rating of the wall assembly in which it is installed, as tabulated below: SHEET TILE: Image: Simple in the firestop system is dependent upon hourly fire rating of the wall assembly in which it is installed, as tabulated below: SHEET TILE: Image: Simple in the firestop system is dependent upon hourly fire rating of the mater assemble in the firestop system is dependent upon hourly fire rating of the mater assemble in the finestop system is dependent upon hourly fire rating of	F. Through Pene 1. Nom 2 in. (51 n	rating Product* — Flexible Metal Piping T m) diam (or smaller) steel flexible metal g	he following types of steel fle	xible metal gas piping may be u			
SASTITE, DJV OF TITEFLEX Shom 1 in. (25 mm) diam (or smaller) steel flexible metal gas piping. Plastic covering on piping may or may not be removed on both sides of floor or wall assembly. SMED MFG L L C Sill, Void or Cavity Material* - Caulk or Sealant Min 5/8. 1-1/4/1-7/8 and 2-1/2 in. (16, 32, 48 and 64 mm) thickness of caulk for 1, and 4hr rated assemblies, respectively, applied within annulus, flush with both surfaces of wall. Min 1/4 in. (6 mm) diam bead of caulk applied pretrain interface at point contact location on both sides of wall. The hourly F Rating of the firestop system is dependent upon bourly fire rating of the wall assembly in which it is installed, as tabulated below: <u>max Pipe or Conduit and the hourly fire rating of the wall assembly in which it is installed, as tabulated below: <u>max Pipe or Conduit and the hourly fire rating of the wall assembly in which it is installed, as tabulated below: <u>max Pipe or Conduit and the hourly fire rating of the wall assembly in which it is installed, as tabulated below: <u>max Pipe or Conduit and the hourly fire rating of the wall assembly in which it is installed, as tabulated below: <u>max Pipe or Conduit and the hourly fire rating of the wall assembly in which it is installed, as tabulated below: <u>field (12) in 1 or 2 in</u></u></u></u></u></u>	OMEGA FLEX INC 2. Nom 1 in. (25 n	m) diam (or smaller) steel flexible metal g	as piping. Plastic covering on	piping may or may not be remo	ved on both sides of		7–00
floor or wall assembly. WARD MFG L L C 3. Fill, Void or Cavity Material* – Caulk or Sealant – Min 5/8. , 1-1/4,1-7/8 and 2-1/2 in. (16, 32, 48 and 64 mm) thickness of caulk for 1, and 4 hr rated assemblies, respectively, applied within annulus, flush with both surfaces of wall. Min 1/4 in. (6 mm) diam bead of caulk applied gypsum board/penetrant interface at point contact location on both sides of wall. The hourly F Rating of the firestop system is dependent upon hourly fire rating of the wall assembly in which it is installed, as shown in the following table. The hourly T Rating of the firestop system is dependent upon the type or size of the pipe or conduit and the hourly fire rating of the wall assembly in which it is installed, as tabulated below: $\frac{Max Pipe}{0 \text{ or Conduit}} \frac{F}{Pating} \frac{T}{Hr} \frac{T}{Pating} \frac{T}{Hr}$ $\frac{1 (25)}{1 (25)} \frac{1 \text{ or } 2}{1 (25)} \frac{3 \text{ or } 4}{3 \text{ or } 4} \frac{3 \text{ or } 4}{0}$ $\frac{1}{1 (25)} \frac{1 \text{ or } 2}{1 \text{ or } 2} \frac{0}{0}$ $\frac{1}{6 (152)} \frac{3 \text{ or } 4}{3 \text{ or } 4} \frac{0}{0}$ $\frac{1}{1 (235)} \frac{1 \text{ or } 2}{1 \text{ or } 2} \frac{0}{0}$	GASTITE, DIV OI 3. Nom 1 in. (25 n	TITEFLEX	as piping. Plastic covering on	piping may or may not be remo	ved on both sides of		
and 4 hr rated assemblies, respectively, applied within annulus, flush with both surfaces of wall. Min 1/4 in. (6 mm) diam bead of caulk applied gypsum board/penetrant interface at point contact location on both sides of wall. The hourly F Rating of the firstop system is dependent upon hourly fire rating of the wall assembly in which it is installed, as shown in the following table. The hourly T Rating of the firstop system is dependent upon the type or size of the pipe or conduit and the hourly fire rating of the wall assembly in which it is installed, as tabulated below: Max Pipe F F Rating Hr Hr F	WARD MFG L L C		5/8., 1-1/4.1-7/8 and 2-1/2	in. (16, 32, 48 and 64 mm) thick	kness of caulk for 1.		
or Conduit Diam In (mm) Rating Hr Rating Hr 1 (25) 1 or 2 0+, 1 or 2 1 (25) 3 or 4 3 or 4 4 (102) 1 or 2 0 6 (152) 3 or 4 0 12 (305) 1 or 2 0	and 4 hr rated ass gypsum board/per hourly fire rating c	emblies, respectively, applied within annulu etrant interface at point contact location or f the wall assembly in which it is installed,	us, flush with both surfaces of n both sides of wall. The hour as shown in the following tabl	wall. Min 1/4 in. (6 mm) diam b y F Rating of the firestop system e. The hourly T Rating of the fire	pead of caulk applied n is dependent upon estop system is depe		
1 (25) 3 or 4 3 or 4 4 (102) 1 or 2 0 6 (152) 3 or 4 0 12 (305) 1 or 2 0		or Conduit Diam In (mm)	Hr	Hr			
12 (305) 1 or 2 0		1 (25)	3 or 4	3 or 4			
*Bearing the UL Classification Mark	3M COMPANY —	e is used, T Rating is 0 h. CP 25WB+ or FB-3000 WT.				PROJECT # 01667.00 SHEET NUMB DRAWN BY: TJ	ER:

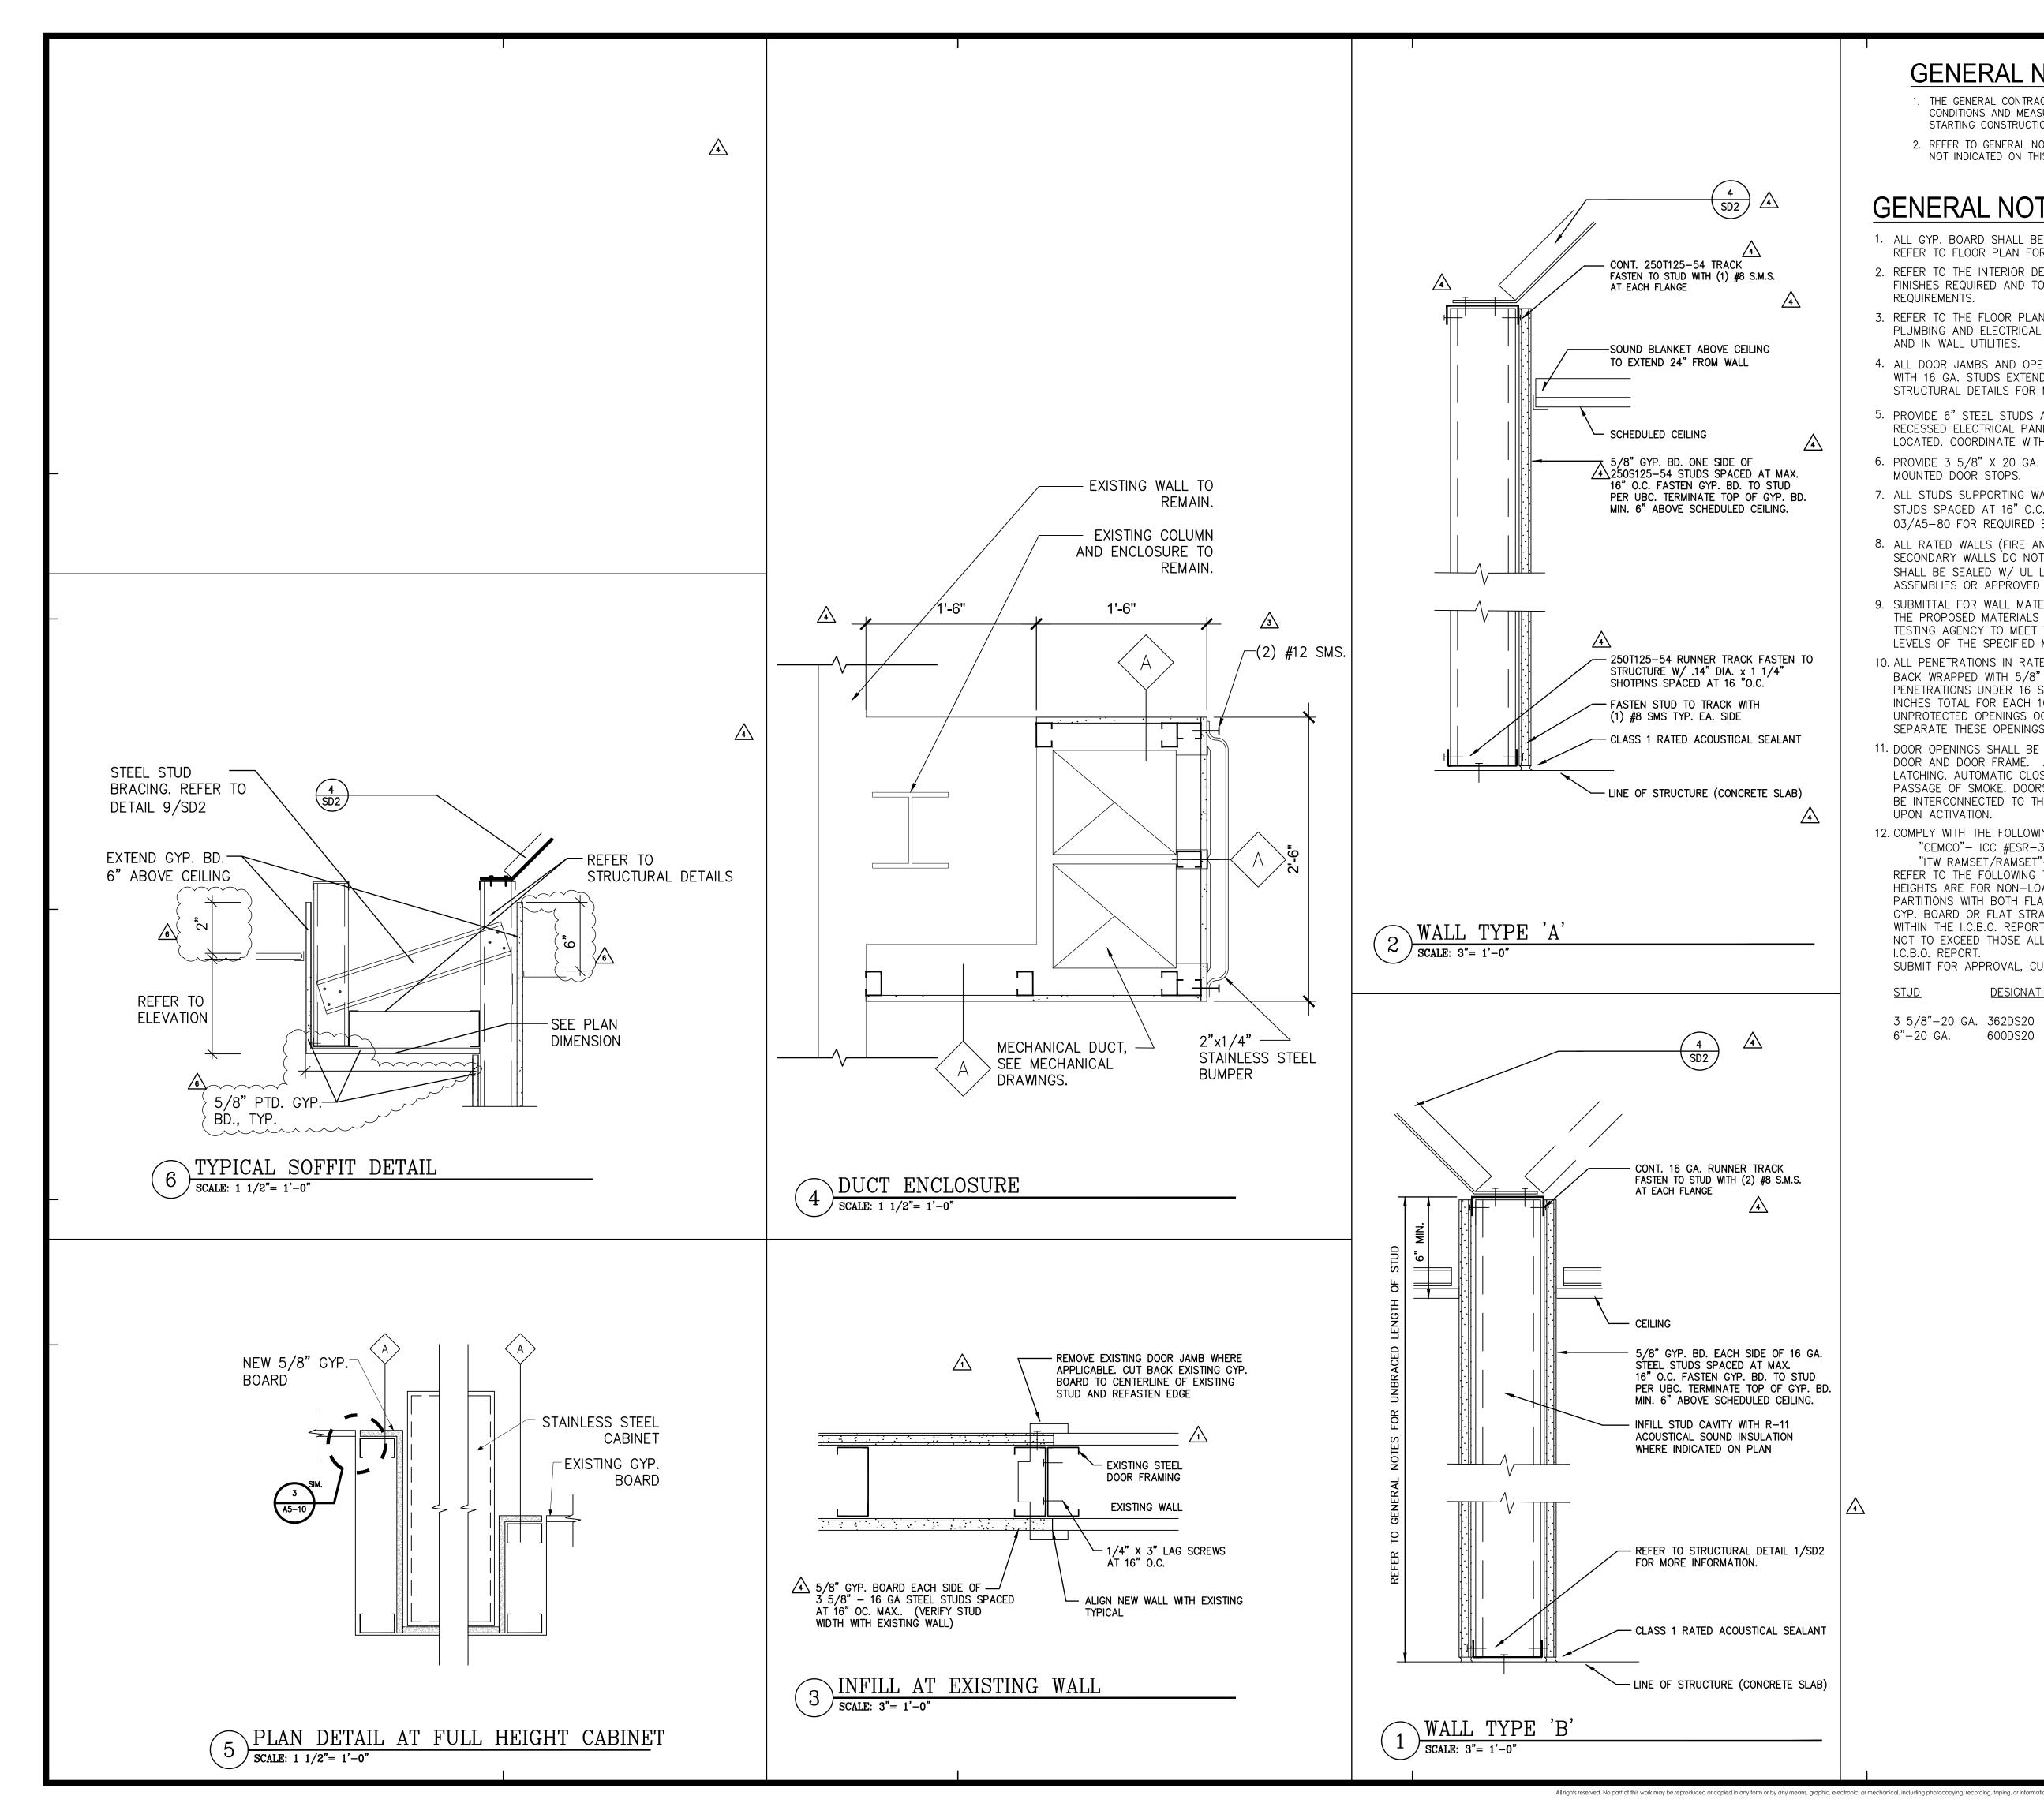

GENERAL NOTES:

- 1. THE GENERAL CONTRACTOR SHALL VERIFY ALL EXISTING CONDITIONS AND MEASUREMENTS IN THE FIELD PRIOR TO STARTING CONSTRUCTION.
- 2. REFER TO GENERAL NOTES ON SHEET A0-00 FOR INFORMATION NOT INDICATED ON THIS SHEET.

GENERAL NOTES FOR PARTITIONS:

- 1. ALL GYP. BOARD SHALL BE TYPE 'X'. REFER TO FLOOR PLAN FOR LOCATION OF WALL TYPES.
- 2. REFER TO THE INTERIOR DESIGN SHEET AND RELATED DETAILS FOR FINISHES REQUIRED AND TO THE MANUFACTURER FOR SURFACE PREP. REQUIREMENTS.
- 3. REFER TO THE FLOOR PLAN, INTERIOR ELEVATIONS, DETAILS, MECHANICAL PLUMBING AND ELECTRICAL PLANS FOR WALL BACKING REQUIREMENTS AND IN WALL UTILITIES.
- 4. ALL DOOR JAMBS AND OPENINGS OVER 24" SHALL BE DOUBLE STUDDED WITH 16 GA. STUDS EXTENDED TO STRUCTURE ABOVE REFER TO STRUCTURAL DETAILS FOR MORE INFORMATION.
- 5. PROVIDE 6" STEEL STUDS AT ALL WALLS AND/OR WALLS WHERE RECESSED ELECTRICAL PANELS OR FIRE EXTINGUISHER CABINETS ARE LOCATED. COORDINATE WITH RELATED SUB-CONTRACTORS.
- 6. PROVIDE 3 5/8" X 20 GA. STEEL TRACK BACKING AT ALL WALL MOUNTED DOOR STOPS.
- 7. ALL STUDS SUPPORTING WALL HUNG CABINETS SHALL BE MIN. 16 GA. STUDS SPACED AT 16" O.C. MAXIMUM. REFER TO DETAILS 02 AND 03/A5-80 FOR REQUIRED BACKING MATERIAL AND CONNECTION.
- 8. ALL RATED WALLS (FIRE AND SMOKE) SHALL BE CONSTRUCTED SO THAT SECONDARY WALLS DO NOT PENETRATE SYSTEM. ALL PENETRATIONS SHALL BE SEALED W/ UL LISTED FIRE STOP SEALANT, UL LISTED ASSEMBLIES OR APPROVED EQUAL.
- 9. SUBMITTAL FOR WALL MATERIALS SHALL BE PROVIDED TO SUBSTANTIATE THE PROPOSED MATERIALS HAVE BEEN TESTED BY A RECOGNIZED TESTING AGENCY TO MEET THE REQUIRED RATINGS AND PERFORMANCE LEVELS OF THE SPECIFIED MATERIALS.
- 10. ALL PENETRATIONS IN RATED WALLS OVER 16 SQ. INCHES $\sqrt{3}$ ALL BE $\frac{11}{3}$ BACK WRAPPED WITH 5/8" TYPE 'X' GYP. BD. UNPROTECTED PENETRATIONS UNDER 16 SQ. INCHES SHALL NOT EXCEED 100 SQ. INCHES TOTAL FOR EACH 100 SQ. FEET OF WALL AREA. WHERE SUCH UNPROTECTED OPENINGS OCCUR ON OPPOSITE SIDES OF THE WALL SEPARATE THESE OPENINGS BY MIN. 24 INCHES.
- 11. DOOR OPENINGS SHALL BE PROTECTED BY A U.L. LISTED (OR EQUAL) DOOR AND DOOR FRAME. ALL RATED DOORS SHALL BE POSITIVE LATCHING, AUTOMATIC CLOSING AND GASKETED TO PREVENT THE PASSAGE OF SMOKE. DOORS EQUIPPED WITH A HOLD OPEN DEVICE SHALL BE INTERCONNECTED TO THE FIRE ALARM WHICH SHALL CLOSE THE DOOR UPON ACTIVATION.
- 12. COMPLY WITH THE FOLLOWING I.C.B.O. REPORTS: "CEMCO"- ICC #ESR-3064P (STUDS AND TRACKS) "ITW RAMSET/RAMSET"- I.C.C. #1799 (POWDER DRIVEN PINS) REFER TO THE FOLLOWING TABLE FOR ALLOWABLE WALL HEIGHTS, HEIGHTS ARE FOR NON-LOAD BEARING STEEL STUDS USED FOR INTERIOR PARTITIONS WITH BOTH FLANGES OF STUDS CONTINUOUSLY BRACED WITH GYP. BOARD OR FLAT STRAPS. ALLOWABLE HEIGHTS ARE THOSE LISTED WITHIN THE I.C.B.O. REPORT. BRACE ALL STUDS AS REQUIRED SO AS, NOT TO EXCEED THOSE ALLOWED HEIGHTS SET BY THE MFR. AND THE I.C.B.O. REPORT. SUBMIT FOR APPROVAL, CURRENT I.C.B.O. REPORT.

<u>STUD</u>	DESIGNATION	MAXIMUM H	<u>HEIGHT</u>	REMARKS
		<u>16"0.C.</u>		
3 5/8"-20 GA.	362DS20	16'—1"	14'-1"	INTERIOR ONLY.
6"-20 GA.	600DS20	24'-1"	21'-1"	INTERIOR ONLY

S F R F ARCHITECTS

5151 Shoreham Place, Suite 100 San Diego, Ca 92122

P: 619-299-3917 F: 619-299-5084 www.sfeirarch.com

TCMC PHARMACY **USP 800** UPGRADE

Tri-City Medical Center

4002 Vista Way Oceanside, California 92056 OWNER: TRI-CITY MEDICAL CENTER

4002 VISTA WAY OCEANSIDE, CALIFORNIA 92056 ARCHITECT: SFEIR ARCHITECTS 5151 SHOREHAM PLACE, SUITE 100 SAN DIEGO, CALIFORNIA 92122 TEL(619)299-3917 FAX(619)299-5084

P2S ENGINEERING, INC.


SAN DIEGO, CA 92123

TEL(619)618-2347

MEP:

STRUCTURAL: SUN STRUCTURAL ENGINEERING 2091 LAS PALMAS DRIVE, SUITE D CARLSBAD, CA 92011 TEL(760)438-1188

9665 CHESAPEAKE DRIVE, SUITE 230

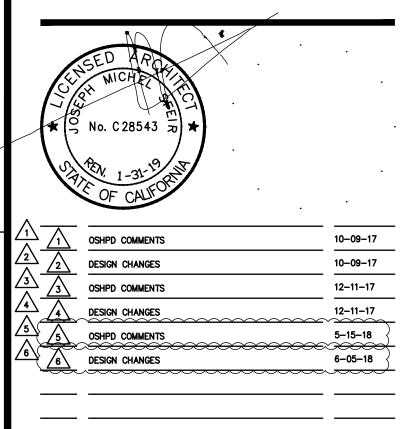

REV:	DESCRIPTION:	DATE	
REV: Consult		DATE	
		DAIE	

OSHPD APPROVAL STAMP:

OSHPD #: S171641-37-00

SHEET TITLE:

TYPICAL RATED PARTITION ASSEMBLIES

SHEET NUMB


PROJECT TITLE: TCMC USP 800


PROJECT #: 01667.00 DRAWN BY: LN CHECKED BY: SCALE: AS SHOWN

DATE:

A5-10

07/31/17

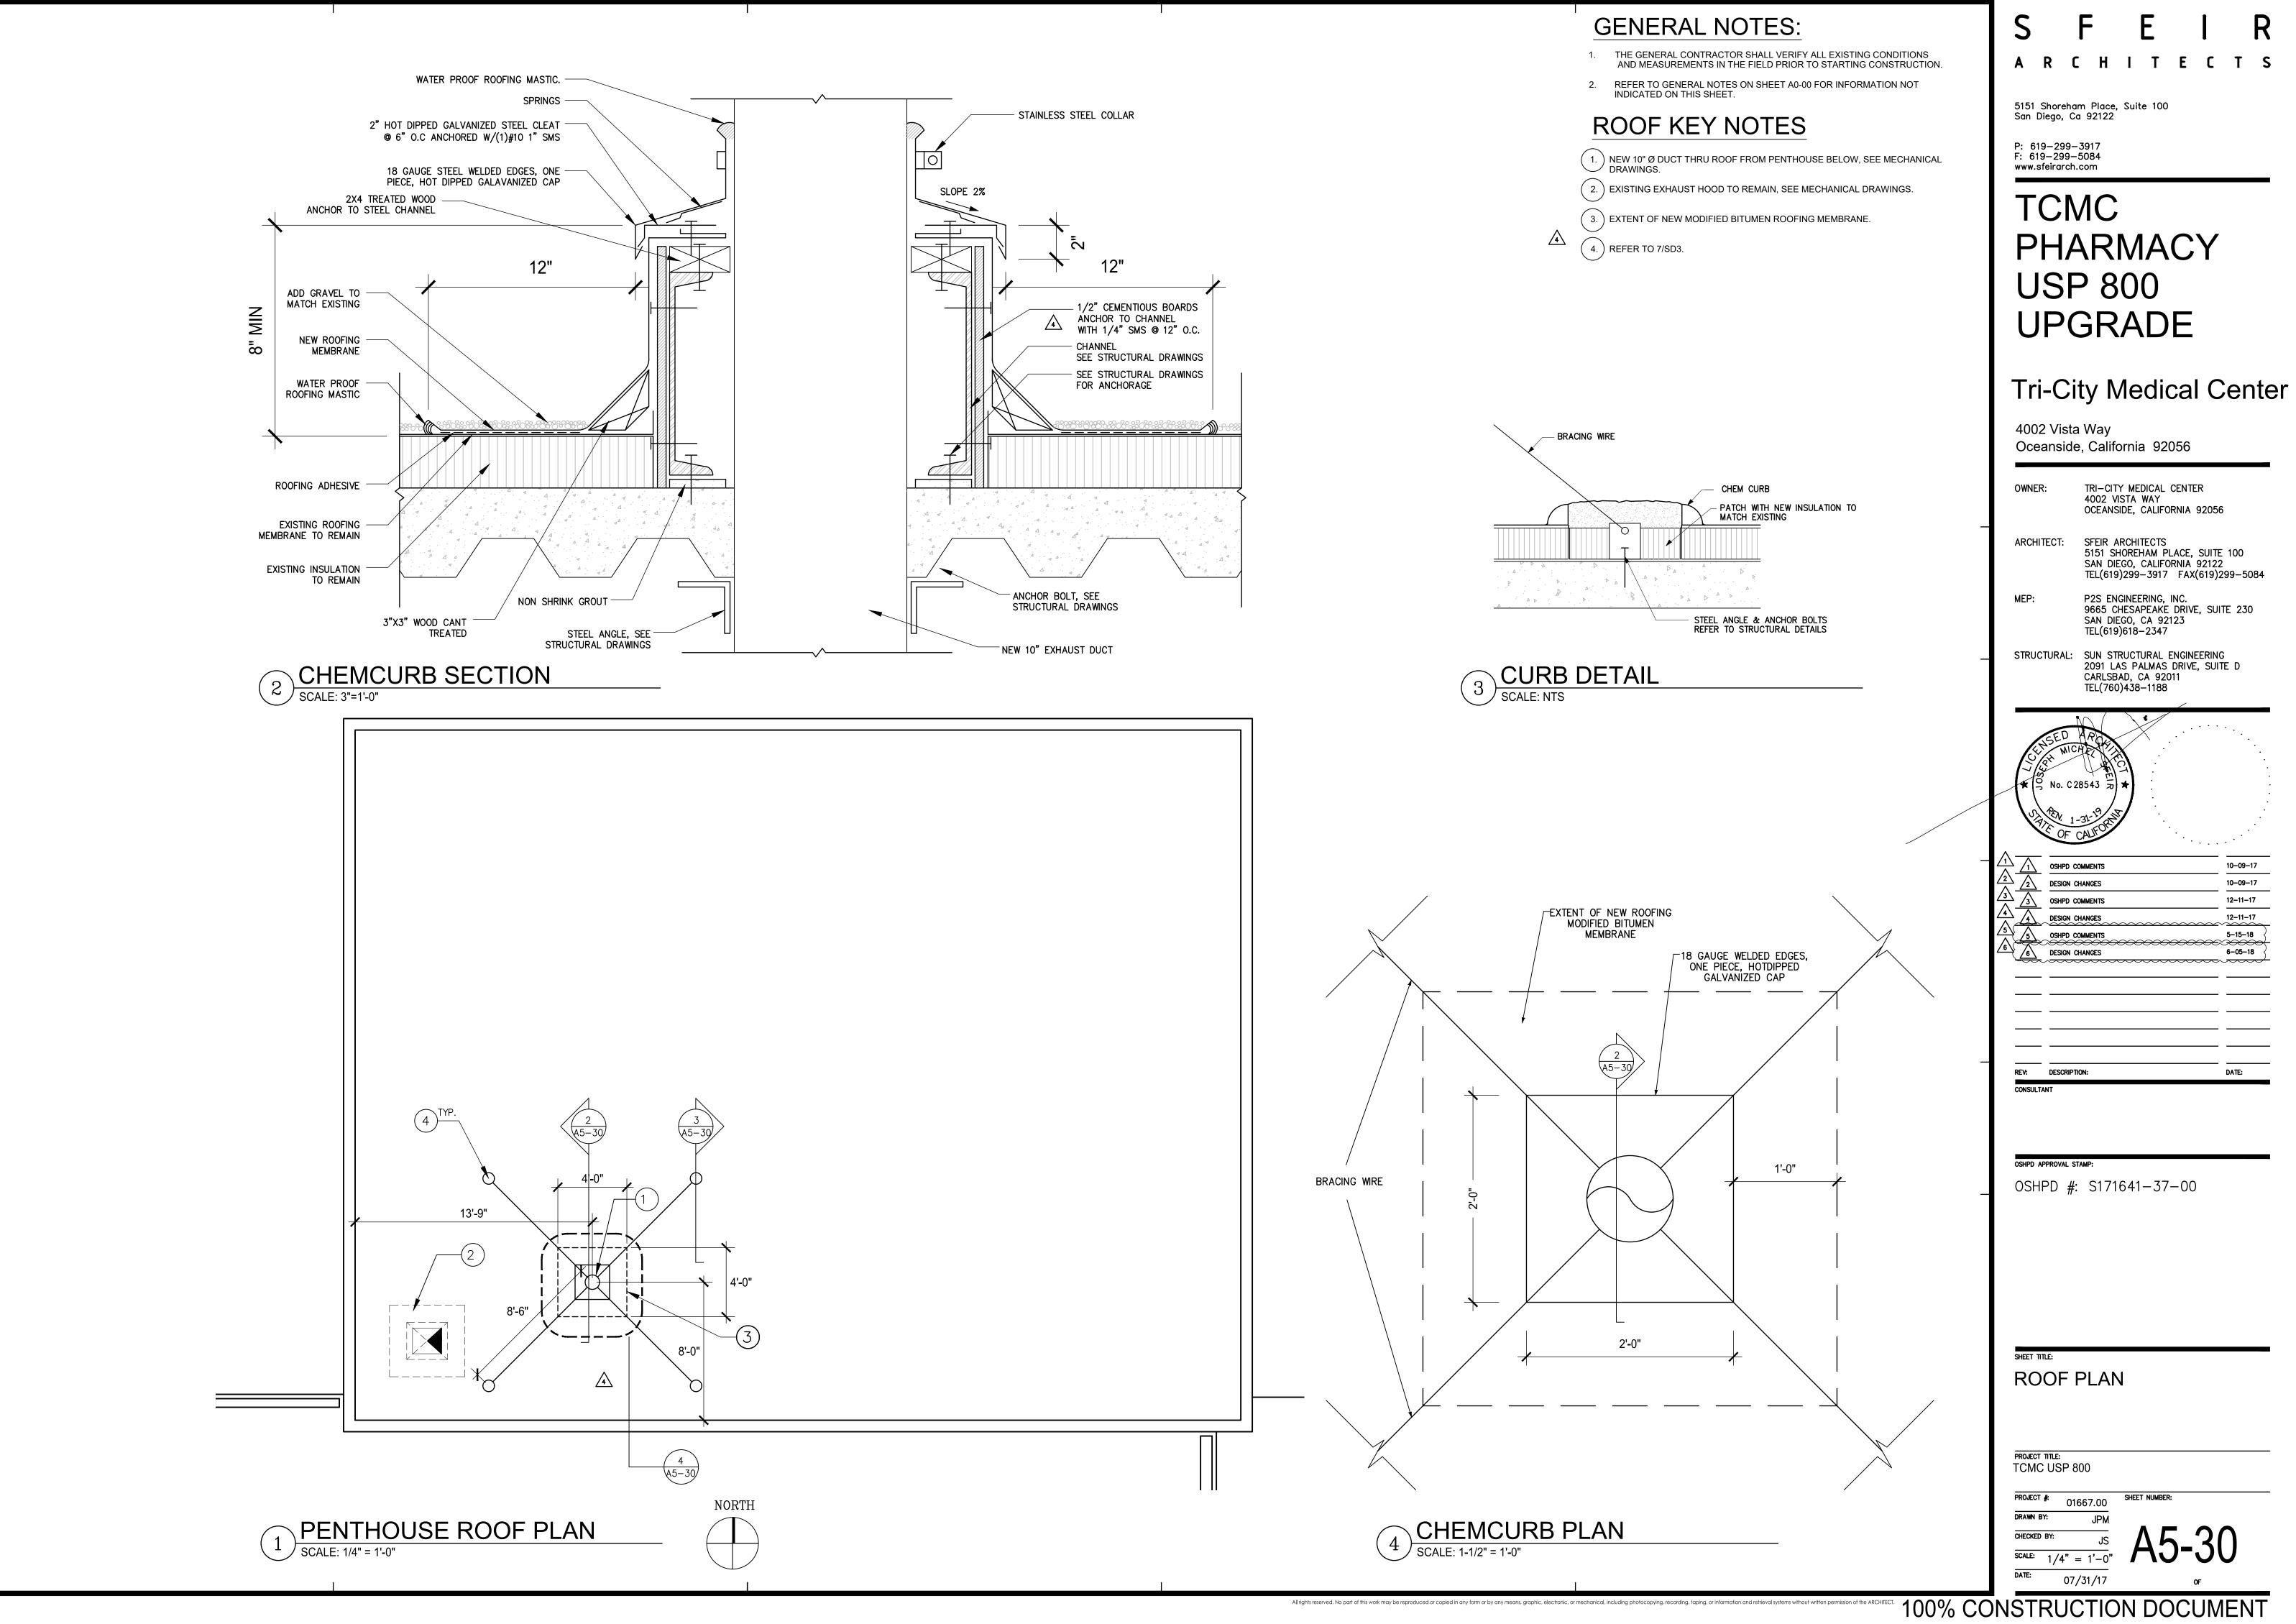

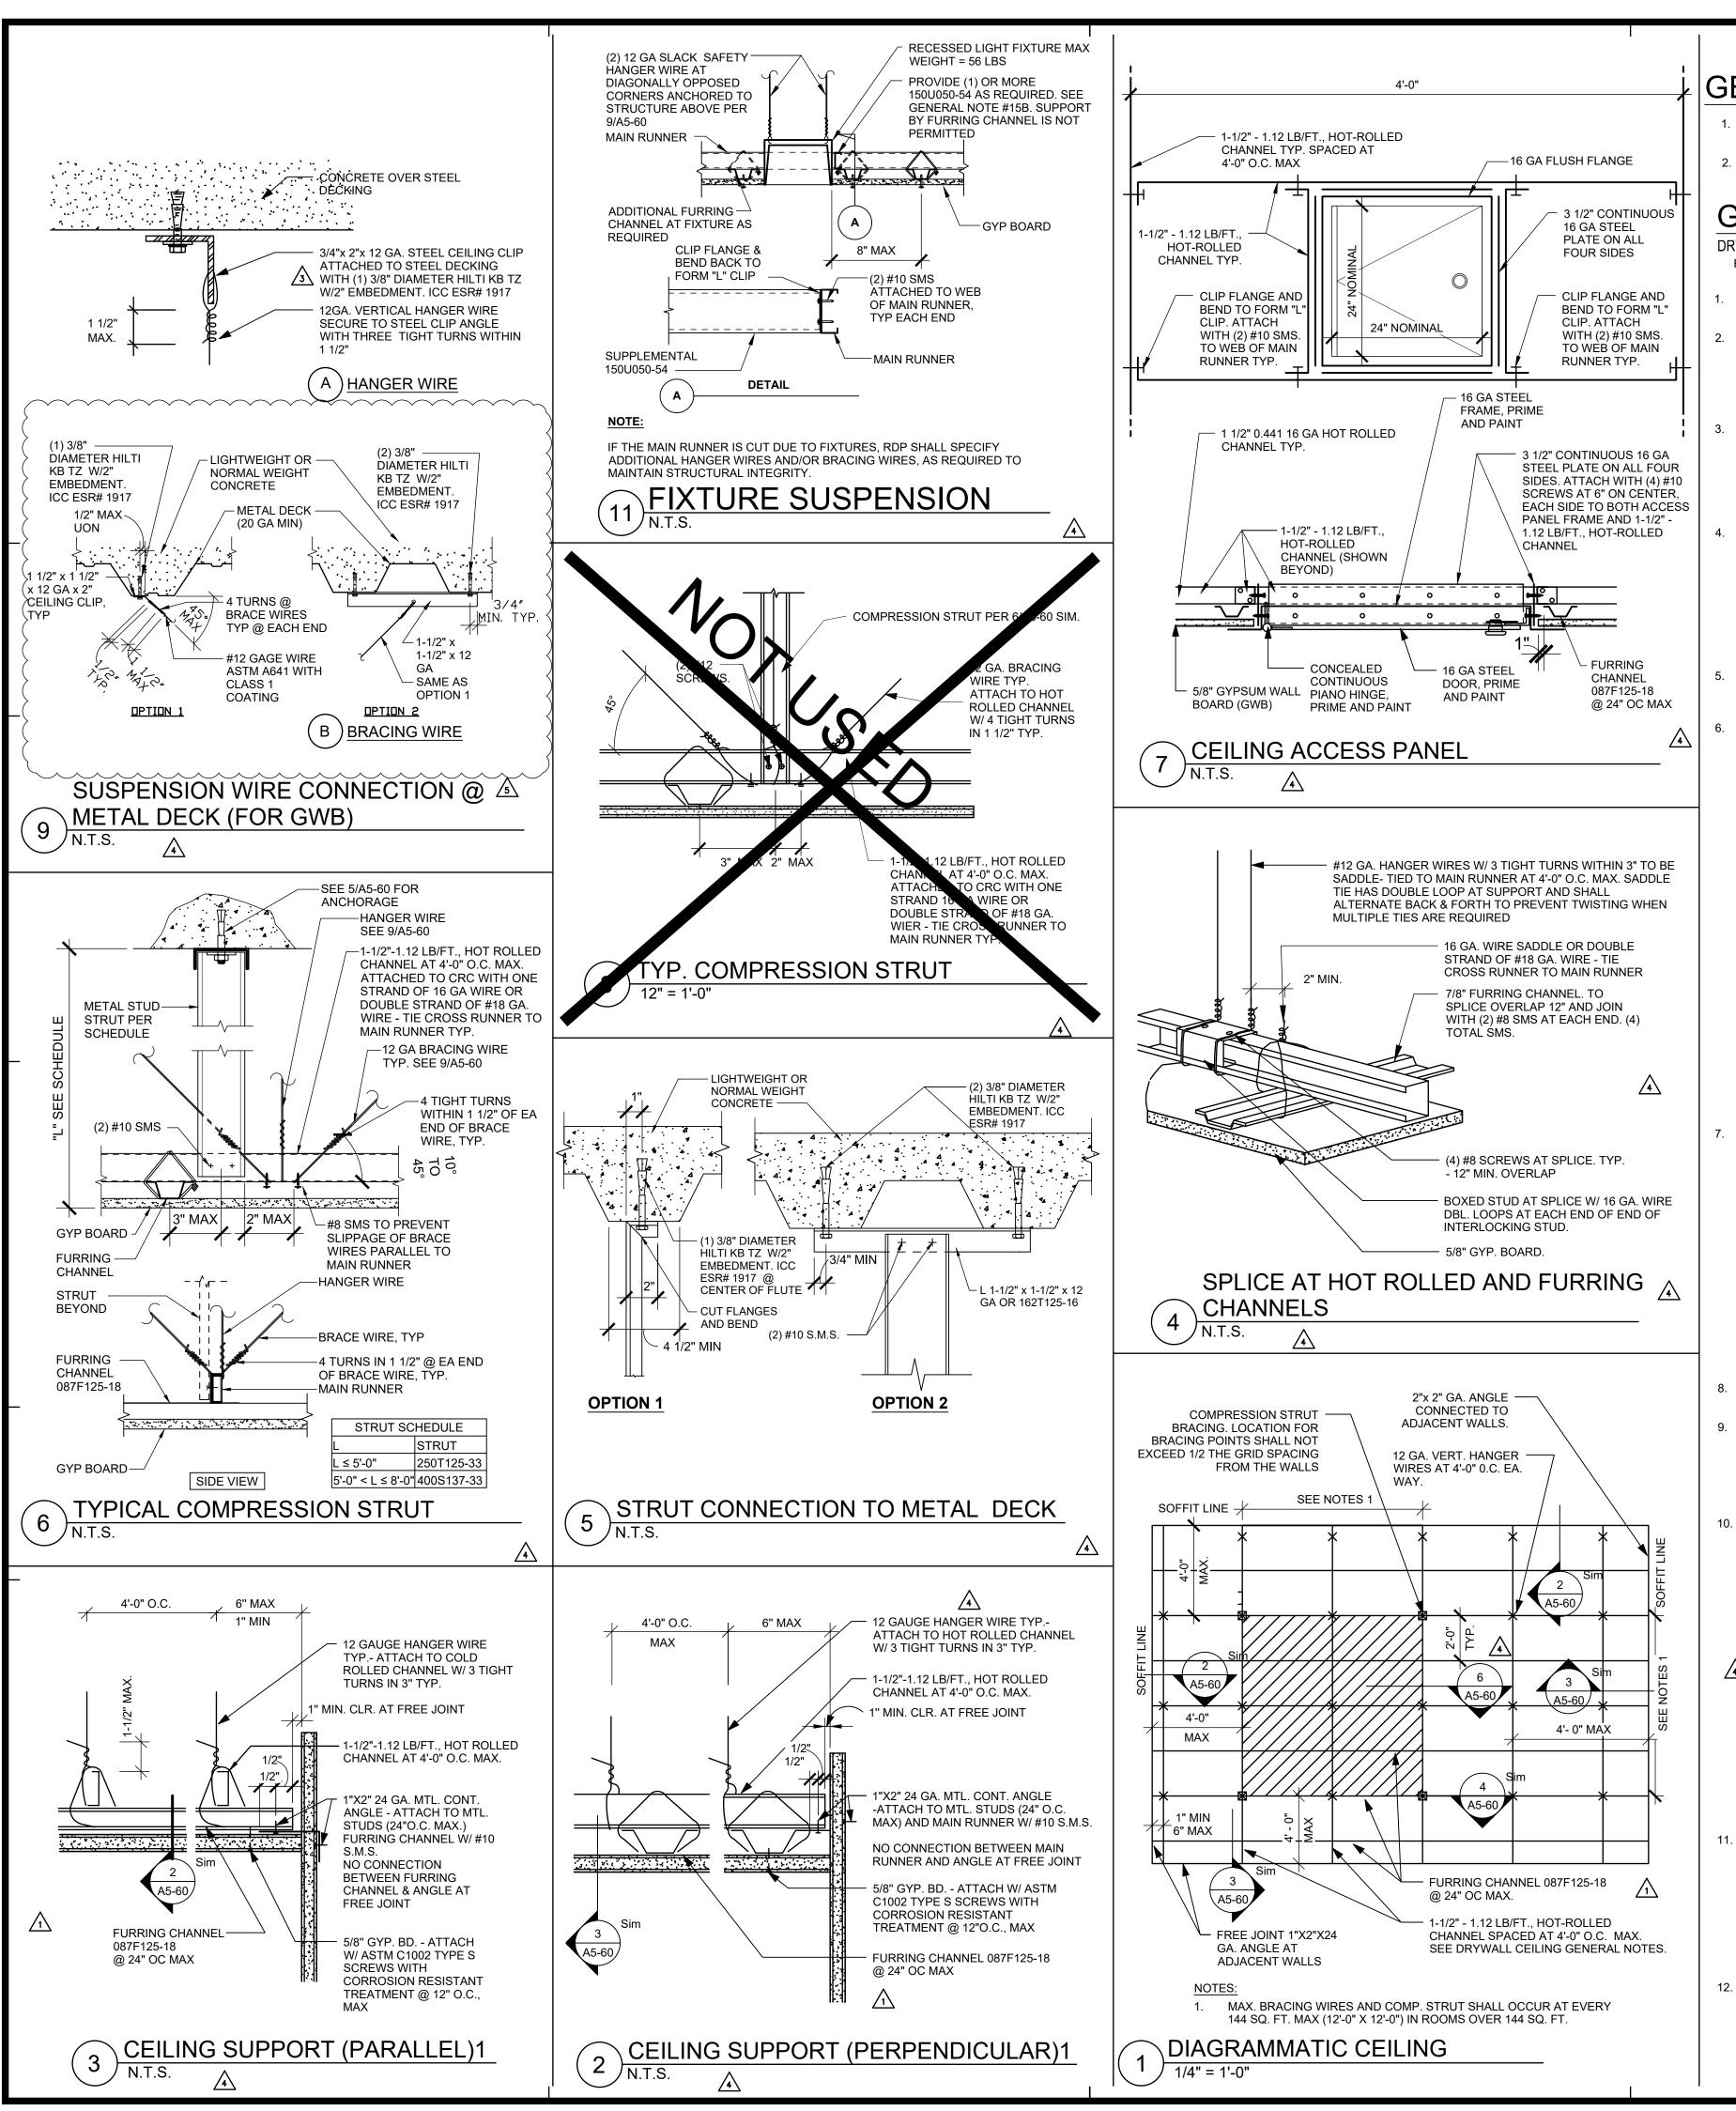

GENERAL NOTES:

- THE GENERAL CONTRACTOR SHALL VERIFY ALL EXISTING COND AND MEASUREMENTS IN THE FIELD PRIOR TO STARTING CONST
- REFER TO GENERAL NOTES ON SHEET A0-00 FOR INFORMATION NOT INDICATED ON THIS SHEET.

GENERAL NOTES GWB CEILING:

DRYWALL CEILING SUSPENSION; CONVENTIONAL CONSTRUCTION REF: CBC 2016 AND ASCE 7-10.

- CONSTRUCTION, WORKMANSHIP AND MATERIAL SHALL CONFO CALIFORNIA BUILDING STANDARDS CODE (CBSC 2016).
- THE CONTRACTOR SHALL NOTIFY OSHPD AND THE REGISTER PROFESSIONAL (RDP) IN RESPONSIBLE CHARGE WHERE A CO DISCREPANCY OCCURS BETWEEN THE CONSTRUCTION DRAW OTHER PORTION OF THE CONSTRUCTION DOCUMENTS, FIELD WHERE ANY CONDITIONS ARISE NOT COVERED BY THESE DOC WORK WILL NOT COMPLY WITH CODE REQUIREMENTS.
- THE INTENT OF THE DRAWINGS AND SPECIFICATIONS IS TO CO HOSPITAL BUILDING IN ACCORDANCE WITH THE CALIFORNIA B STANDARD CODE, 2016 (CBSC 2016). SHOULD ANY CONDITION COVERED BY THE APPROVED CONSTRUCTION DOCUMENTS W WORK WILL NOT COMPLY WITH CBSC 2016, A CHANGE ORDER SPECIFYING THE REQUIRED WORK SHALL BE SUBMITTED TO A OSHPD BEFORE PROCEEDING WITH THE WORK.
- GALVANIZED METAL STUDS, TRACKS AND SHEET STEEL SHAL ASTM A653-11 MATERIAL, OR OTHER EQUIVALENT ASTM LISTE SECTION A2.1 OF THE AISI SI00-07/S2-10; NORTH AMERICAN SF FOR THE DESIGN OF COLD-FORMED STEEL STRUCTURAL MEM SUPPLEMENT 2, DATED 2010, WITH A MINIMUM YIELD STRENG FOR 43 MIL (18 GAGE) AND LIGHTER AND MINIMUM YIELD STRE FOR HEAVIER GAGES. METAL STUDS AND TRACKS SHALL BE C THICKNESS AND SECTION PROPERTIES SHOWN ON TABLES 1-AISI MANUAL, COLD-FORMED STEEL DESIGN, 2008 EDITION. TH RESPONSIBLE CHARGE SHALL OBTAIN OSHPD APPROVAL FOR
- ELECTRICAL METALLIC TUBE (EMT) SHALL BE ANSI C80.3/UL 797 WITH G90 GALVANIZING. EMT SHALL HAVE MINIMUM YIELD STR KSI AND MINIMUM ULTIMATE STRENGTH OF (Fu =) 48 KSI.
- SELECTED FASTENER CAPACITIES SHALL MATCH OR EXCEED LISTED HEREIN. THE FOLLOWING REQUIREMENTS SHALL ALSO
- SHEET METAL SCREWS SHALL COMPLY WITH ASTM C 151 B18.6.4-98 (R2005) AND ICC-ES AC 118. PENETRATION OF THROUGH JOINED MATERIAL SHALL NOT BE LESS TH**AN**F THREADS.
- WELDING SHALL BE IN ACCORDANCE WITH AWS D1.3 US ELECTRODES. FIELD WELDING SHALL HAVE SPECIAL INS ACCORDANCE WITH 2016 CBC SECTION 1705A.2.
- POST- INSTALLED ANCHORS (E.G. EXPANSION ANCHORS AND POWER ACTUATED FASTENERS) SHALL HAVE SPEC AND TESTING IN ACCORDANCE WITH THE 2016 CBC SEC 1913A.7. FOR QUALIFICATION, DESIGN AND USE OF POST ANCHORS IN CONCRETE SEE THE 2016 CBC SECTIONS 1 1908A.1.1. LISTING OF CURRENT ICC-ES EVALUATION RE REPORTS FROM OTHER TESTING AGENCIES ACCEPTABL
- SHALL BE REQUIRED FOR FASTENER USED. POWER-ACTUATED FASTENERS (PAF), POWDER DRIVEN (PDF), POWER DRIVEN PINS (PDP) AND SHOT PINS ALL R SAMÉ FASTENER AND WILL HEREAFTER BE REFERRED. ACTUATED FASTENERS (PAF)PAF'S SHALL SATISFY THE ACCEPTANCE CRITERIA FOR FASTENERS POWER-DRIVE STEEL AND MASONRY ELEMENTS AND THE 2016 CBC SE LISTING OF CURRENT ICC ES EVALUATION REPORTS (OF OTHER TESTING AGENCIES ACCEPTABLE TO OSHPD) SH
- FOR FASTENERS USED.
- FOR PAF INSTALLED IN STEEL THE FASTENER PENETRA THE ENTIRE POINTED END OF THE FASTENER DRIVEN TH MFMBER. EXCEPT AS NOTED IN CURRENT REPORTS FRO AGENCIES ACCEPTABLE TO OSHPD. 7. DESIGN CRITERIA
 - BUILDING CODE: 2016 CALIFORNIA BUILDING CODE (2016 10, AISI S100-07/S2-10, ASTM C754-11. FOR LOAD COMBIN ALLOWABLE STRESS DESIGN SHALL BE IN ACCORDANCE CBC SECTION 1605A.3.1.
 - FASTENER CAPACITIES TABLES WERE DEVELOPED BASE REPORTS BY SEVERAL MANUFACTURERS. THE DESIGN ASSUMES THAT BUILDING ELEMENTS AND WHICH THE COMPONENTS ADDRESSED IN THIS DOCUME ANCHORED, HAVE SUFFICIENT CAPACITY TO CARRY THE IMPOSED BY THE COMPONENTS IN COMBINATION WITH /
- LOADS DESIGN CRITERIA IS LIMITED TO CEILING ASSEMBLIES HA DEAD WEIGHT OF 4 PSF, INCLUDING LIGHTING FIXTURES AND MECHANICAL SERVICES. EACH WEIGHING LESS THA ATTACHED TO CEILING FRAMING SYSTEM. HEAVIER SYS THOSE SUPPORTING LATERAL FORCES FROM PARTITION REQUIRE PROJECT SPECIFIC DESIGN.
- THE RDP SHALL VERIFY THE FIRE RESISTANCE AND ACOUSTI ALL CEILING ASSEMBLIES.
- 9. "CEILING WIRE" SHALL CONFORM WITH GALVANIZED SOFT ANI WIRE AS DEFINED IN ASTM A641 (CLASS 1 COATING) WITH 70 K STRENGTH:
- a. FOUR (4) TWISTS OF WIRE WITHIN 1.5" DEVELOPS THE AI THE WIRE. THREE (3) TWISTS WITHIN 3" MAY BE USED TO DEVELOP
- ALLOWABLE LOAD. 10. SUSPENSION SYSTEM COMPONENTS SHALL COMPLY WITH AS MAIN RUNNERS SHALL CONSIST OF 1-1/2"-1.12 LB/FT., HO AT 4'-0" OC MAX. MAIN RUNNERS SHALL BE SUPPORTED AT 4'-0" OC MAX AND WITHIN 6" FROM EACH END.
- FURRING CHANNEL SHALL CONSIST OF 25 GAGE 7/8" (HA CHANNELS (087F125-18) AT 2'-0" OC MAX. FURRING CHA SADDLE TIED TO MAIN RUNNERS WITH 16 GAGE TIE WIRE STRAND OF 18 GAGE TIE WIRE. MAIN RUNNERS SHALL BE SPLICED BY LAPPING IN ACCO
- DETAIL 4/A5-60. ۲ مل FURRING CHANNELS SHALL BE SPLICED BY LAPPING IN WITH DETAIL 6/A5-60.
- MAIN RUNNERS AND FURRING CHANNELS ALONG WITH INTERSECTION CONNECTORS, AND EXPANSION DEVICE DESIGNED AND CONSTRUCTED TO CARRY A MEAN ULTI OF NOT LESS THAN 270 LBS. IN COMPRESSION & TENSIO HANGER AND BRACING WIRES SHALL BE #12 GAGE (0.10 SOFT ANNEALED, AND GALVANIZED STEEL WIRES WITH COATING. THEY MAY BE USED FOR UP TO AND INCLUDIN
- GRID SPACING ALONG AND ATTACHED TO MAIN RUNNER NOT PERMITTED IN ANY HANGER WIRE. WIRE HANGERS SHALL BE SADDLE-TIED AROUND MAIN TO PREVENT TURNING OR TWISTING OF THE MEMBER.
- SUSPENSION SYSTEM INSTALLATION, SHALL COMPLY WITH A CEILING GRID MEMBERS SHALL BE ATTACHED TO TWO (WALLS. MAIN RUNNERS AND FURRING CHANNEL SHALL CLEAR OF OTHER WALL AND FURRING SHALL BE AT LEA OF OTHER WALL. IF WALLS RUN DIAGONAL TO THE CEIL RUNNERS, ONE END OF MAIN RUNNER AND FURRING SH TANDARD CLEARANCES.
- THE WIDTH OF THE PERIMETER SUPPORTING CLOSURE LESS THAN TWO (2) INCHES. USE OF ANGLES WITH SMA CONJUNCTION WITH PERIMETER CLIPS SHALL REQUIRE METHOD OF COMPLIANCE WITH ADEQUATE JUSTIFICATI
- 12. EXPANSION JOINTS, SEISMIC SEPARATIONS, AND PENETRATIC EXPANSION JOINTS SHALL BE PROVIDED IN THE CEILING INTERSECTIONS OF CORRIDORS AND AT JUNCTIONS OF LOBBIES OR OTHER SIMILAR AREAS.
- FOR CEILING AREAS EXCEEDING 2500 SQUARE FEET, A SEPARATION JOINT SHALL BE PROVIDED TO DIVIDE THE AREAS NOT EXCEEDING 2500 SQ. FT.

All rights reserved. No part of this work may be reproduced or copied in any form or by an

ITIONS	
RUCTION	

<u>=ILING:</u>		AND OTHER SIMILAR DEVICES THAT ARE NOT INTEGRALLY TIED TO THE CEILING SYSTEM IN THE LATERAL DIRECTION SHALL HAVE A
ION		TWO (2) INCH OVERSIZED RING, SLEEVE OR ADAPTER THROUGH THE CEILING TILE TO ALLOW FREE MOVEMENT OF ONE (1) INCH IN
		ALL HORIZONTAL DIRECTIONS. A FLEXIBLE SPRINKLER HOSE FITTING THAT CAN ACCOMMODATE ONE (1) INCH OF CEILING
ORM TO THE 2016		MOVEMENT SHALL BE PERMITTED TO BE USED IN LIEU OF THE OVERSIZED RING, SLEEVE OR ADAPTER. SUCH FLEXIBLE
RED DESIGN		SPRINKLER HOSE SHALL BE ADEQUATELY SUPPORTED FROM SOFFIT SO AS NOT TO EXCEED THE MAXIMUM TRIBUTARY WEIGHT
NFLICT OR WINGS AND ANY 13.		OF THE CEILING. RAL FORCE BRACING:
D CONDITIONS, OR DCUMENTS WHEREIN	LATE	RAL FORCE BRACING IS REQUIRED IN ACCORDANCE WITH THIS
		EPTION: LATERAL FORCE BRACING MAY BE OMITTED FOR
CONSTRUCT THE BUILDING	SUSE	PENDED ACOUSTICAL CEILING SYSTEMS WITH A CEILING AREA 44 SQ. FT. OR LESS, WHEN PERIMETER SUPPORT ARE
N DEVELOP NOT WHEREIN THE	PRO	VIDED AND PERIMETER WALLS ARE DESIGNED TO CARRY THE ING LATERAL FORCES.
R DETAILING AND AND APPROVED BY	a.	PROVIDE LATERAL-FORCE BRACING ASSEMBLIES CONSISTING OF A STRUT AND FOUR (4) #12 GAGE BRACING WIRES
	b.	ORIENTED 90 DEGREESFROM EACH OTHER. LATERAL-FORCE BRACING ASSEMBLIES SHALL BE SPACED IN
LL CONFORM TO ED MATERIALS IN	0.	ACCORDANCE WITH DETAILS 1/A5-60, 10/A5-60 & 14/A5-60 FROM EACH WALL AND AT THE EDGES OF ANY CHANGE OF
PECIFICATION MBERS WITH	C.	ELEVATION OF THE CEILING. THE SLOPE OF BRACING WIRES MAY BE FROM 10 TO 45
STH OF 33 KSI ENGTH OF 50 KSI	0.	DEGREES BUT MAY NOT EXCEED 45 DEGREES FROM THE PLANE OF THE CEILING AND WIRES SHALL BE TAUT.
OF SIZE, -1, 1-2 AND 1-3 OF THE	d.	STRUTS SHALL BE ADEQUATE TO RESIST THE VERTICAL COMPONENT INDUCED BY THE BRACING WIRES, AND SHALL
HE RDP IN R ANY SUBSTITUTIONS.		NOT BE MORE THAN 1 (HORIZONTAL) IN 6 (VERTICAL) OUT OF PLUMB.
97 CARBONSTEEL	ATTA	CHMENT OF HANGER AND BRACING WIRES:
RENGTH OF (Fy = 30)	a.	FASTEN #12 HANGER WIRES WITH NOT LESS THAN THREE (3) TIGHT TURN IN 3 INCHES. HANGER WIRE LOOPS SHALL
) THE STRENGTHS		BE TIGHTLY WRAPPED AND SHARPLY BENT TO PREVENT ANY VERTICAL MOVEMENT OR ROTATION OF THE MEMBER
O BE MET:	b.	WITHIN THE LOOPS. FASTEN #12 BRACING WIRES WITH FOUR (4) TIGHT TURNS.
513-10, ASME = SCREWS		MAKE ALL TIGHT TURNS WITHIN A DISTANCE OF 1 1/2" INCHES.
IREE EXPOSED	C.	HANGER OR BRACING WIRE ANCHORED TO THE STRUCTURE SHOULD BE INSTALLED IN SUCH A MANNER THAT THE
SING E60XX SERIES SPECTION IN		DIRECTION OF THE ANCHOR ALIGNS AS CLOSELY AS POSSIBLE WITH THE DIRECTION OF THE WIRE.
S, SCREW ANCHORS	d.	SEPARATE ALL CEILING HANGER AND BRACING WIRES AT LEAST SIX (6) INCHES FROM ALL UNBRACED DUCTS, PIPES
CIAL INSPECTION CTIONS 1705A.3 &	e.	CONDUITS, ETC. HANGER WIRES SHALL NOT BE ATTACHED TO OR BEND
T-INSTALLED 1616A.1.19 AND		AROUND INTERFERING MATERIAL OR EQUIPMENT. PROVIDE TRAPEZE OR OTHER SUPPLEMENTARY SUPPORT MEMBERS
EPORTS (OR BLE TO OSHPD)		AT OBSTRUCTIONS TO TYPICAL HANGER SPACING. PROVIDE ADDITIONAL HANGERS, STRUTS OR BRACES AS REQUIRED
N FASTENERS		AT ALL CEILING BREAKS, SOFFITS, OR DISCONTINUOUS AREAS.
REPRESENT THE TO AS POWER	f.	HANGER WIRES THAT ARE MORE THAN 1 (HORIZONTAL) IN 6 (VERTICAL) OUT OF PLUMB SHALL REQUIRE PROJECT
E CURRENT AC70- EN INTO CONCRETE,	g.	SPECIFIC DESIGN. WHEN DRILLED-IN CONCRETE ANCHORS OR PAF ARE USED
ECTION 1908A.1.1. R REPORTS FROM		IN REINFORCED CONCRETE FOR HANGER WIRES, 1 OUT OF 10 WIRE/ ANCHOR ASSEMBLIES SHALL BE FIELD TESTED
HALL BE REQUIRED		FOR 200 LBS. IN TENSION. WHEN DRILLED-IN CONCRETE ANCHORS ARE USED FOR BRACING WIRES, 1 OUT OF 2
ATION SHALL HAVE THROUGH THE STEEL		WIRE/ANCHOR ASSEMBLIES SHALL BE FIELD TESTED FOR 440 LBS. IN TENSION IN THE DIRECTION OF THE WIRE. PAF
OM TESTING 15.	CEIL	IN CONCRETE ARE NOT PERMITTED FOR BRACING WIRES.
6 CBC), ASCE 7-	a.	ALL LIGHT FIXTURES, AIR TERMINALS/GRILLS, OR OTHER DEVICES (REFERRED TO ALL BY COMMON TERM FIXTURES
NATIONS, E WITH 2016		HEREAFTER) SHALL BE MOUNTED IN A MANNER THAT WILL NOT COMPROMISE CEILING PERFORMANCE.
	b.	ALL FIXTURES SHALL BE SUPPORTED DIRECTLY BY MAIN RUNNERS OR BY SUPPLEMENTAL FRAMING WHICH IS
SUPPORTS, TO		SUPPORTED BY MAIN RUNNERS AND POSITIVELY ATTACHED WITH SCREWS OR OTHER APPROVED CONNECTORS.
IENT ARE IE LOADS	C.	SURFACE MOUNTED FIXTURES SHALL BE ATTACHED TO A MAIN RUNNER WITH A POSITIVE CLAMPING DEVICE MADE OF
ALL OTHER	d.	MATERIAL WITH A MINIMUM OF 14 GAGE. ROTATIONAL SPRING CLAMPS DO NOT COMPLY. ACCESS PANELS: ACCESS TO THE SPACE BETWEEN THE
HAVING MAXIMUM S (LUMINERIES)	u.	CEILING AND THE FLOOR OR ROOF ABOVE SHALL NOT BE ALLOWED. SMALL ACCESS PANELS FOR THE INSPECTION.
IAN 56 LBS AND STEM AND		ADJUSTMENT, OR REPAIR OF UTILITY SWITCHES, VALVES, SENSORS, ETC. MAY BE ALLOWED IF THE PANEL IS LESS THAN
ON WALLS WILL		300 SQUARE INCHES. SUCH PANELS SHALL ALSO HAVE A PERMANENT WARNING LABEL AS FOLLOWS:
ICAL RATINGS FOR WAR	NING:	1. DO NOT CLIMB, WALK, OR CRAWL ON THE GYPSUM
		BOARD CEILING. 2. DO NOT STORE OR STOW ANYTHING ON THE GYPSUM
NNEALED MILD STEEL KSI MINIMUM TENSILE	e.	BOARD CEILING. ALL FIXTURES WEIGHING LESS THAN OR EQUAL TO 10 LB. SHALL
ALLOWABLE LOAD FOR		HAVE ONE NO. 12 GAUGE SAFETY WIRE CONNECTED FROM FIXTURE HOUSING TO STRUCTURE ABOVE. IT IS NOT
P THE MAXIMUM 50% OF	f.	NECESSARY FOR THESE SAFETY WIRES TO BE TAUT. ALL FIXTURES WEIGHING GREATER THAN 10 LB BUT LESS THAN
STM C754:		OR EQUAL TO 56 LB SHALL HAVE TWO NO. 12 GAUGE SAFETY WIRE CONNECTED FROM FIXTURE HOUSING TO STRUCTURE
D BY HANGER WIRES		ABOVE. IT IS NOT NECESSARY FOR THESE SAFETY WIRES TO BE TAUT.
	g.	ALL FIXTURES WEIGHING GREATER THAN 56 LB SHALL BE SUPPORTED DIRECTLY FROM STRUCTURE ABOVE BY
IAT) FURRING ANNELS SHALL BE	h.	APPROVED HANGERS. PENDANT-HUNG FIXTURES SHALL BE SUPPORTED DIRECTLY
RE OR A DOUBLE		FROM THE STRUCTURE ABOVE USING NO LESS THAN NO. 0- GAUGE WIRE OR AN APPROVED ALTERNATE SUPPORT. THE C
ORDANCE WITH		EILING SUSPENSION SYSTEM SHALL NOT PROVIDE ANY DIRECT SUPPORT.
I ACCORDANCE	i.	ALL RECESSED OR DROP-IN FIXTURES SHALL BE SUPPORTED DIRECTLY FROM FIXTURE HOUSING TO THE STRUCTURE ABOVE
THEIR SPLICES, ES SHALL BE		WITH A MINIMUM OF TWO NO. 12 GAUGE WIRES LOCATED AT DIAGONALLY OPPOSITE CORNERS. LEVELING OR POSITIONING
IMATE TEST LOAD ON.		OF FIXTURES MAY BE PROVIDED BY CEILING GRID. FIXTURE SUPPORT WIRES MAY BE SLIGHTLY LOOSE TO ALLOW THE
06" DIAMETER), I CLASS 1		FIXTURE TO SEAT IN THE GRID SYSTEM. FIXTURES SHALL NOT BE SUPPORTED FROM MAIN RUNNERS OR FURRING CHANNELS
ING 4'-0" X 4'-0" ERS.SPLICES ARE		IF THE WEIGHT OF THE FIXTURES CAUSES TOTAL DEAD LOAD TO EXCEED THE DEFLECTION CAPABILITY OF THE CEILING
RUNNERS SO AS	16.	SUSPENSION SYSTEM. CEILINGS THAT ARE PART OF A FIRE RATED ASSEMBLY: PROVIDEA
ASTM C754:		DETAIL AND DESIGN NUMBER FOR RATED CEILING ASSEMBLIES FROM AN APPROVED TESTING AGENCY. THE COMPONENTS AND
(2) ADJACENT _ BE AT LEAST 1 INCH		INSTALLATION DETAILS SHALL CONFORM IN EVERY RESPECT WITH THE LISTED DETAIL AND NUMBER. DETAILS SHALL CLEARLY DEPICT
AST 3/4" INCH CLEAR LING GRID SYSTEM		ALL COMPONENTS, INCLUDING INSULATION MATERIALS, FRAMING AND ATTACHMENT OF THE DESIGN SO THAT THE
HOULD BE FREE WITH S		ASSEMBLY CAN BE CONSTRUCTED AND INSPECTED ACCORDINGLY. POP RIVETS, SCREWS, OR OTHER ATTACHMENTS ARE NOT
E ANGLE SHALL BE NOT ALLER WIDTHS IN		ACCEPTABLE UNLESS SPECIFICALLY DETAILED ON THE DRAWINGS AND APPROVED BY APPROVED TESTING AGENCY.
E AN ALTERNATE FION.	17.	GYPSUM BOARD INSTALLATION SHALL COMPLY WITH ASTM C840-11: a. GYPSUM BOARD SHALL CONSIST OF SINGLE-PLY 5/8"
IONS: IG AT		 a. GYPSUM BOARD SHALL CONSIST OF SINGLE-PLY 5/8" (4) THICK IN ACCORDANCE WITH ASTM C11-10a. b. GYPSUM BOARD SHALL BE INSTALLED PERPENDICULAR TO
F CORRIDORS WITH		D. GYPSOM BOARD SHALL BE INSTALLED PERPENDICULAR TO FURRING WITH SCREWS AT 12" OC MAXIMUM, IN ACCORDANCE WITH ASTM C840-11.
SEISMIC E CEILING INTO		 c. GYPSUM BOARD SHALL BE ATTACHED TO FURRING/FRAMING WITH ASTM C1002-07 TYPE S (ASTM A568-11b GRADES 1018 TO
I		1022) SCREWS (NOT LESS THAN, NO. 6, WITH MAJOR DIAMETER NOT LESS THAN 0.136 IN).
graphic, electronic, or mechanical, including photo	copying, re	· ·
		scording, taping, or information and retrieval systems without written permission of the ARCHITECT. $100\%~C$

AND OTHER SIMILAR DEVICES THAT ARE NOT INTEGRALLY TIED TO THE CEILING SYSTEM IN THE LATERAL DIRECTION SHALL HAVE A TWO (2) INCH OVERSIZED RING, SLEEVE OR ADAPTER THROUGH THE CEILING TILE TO ALLOW FREE MOVEMENT OF ONE (1) INCH IN	P: 619–299–3917 F: 619–299–5084 www.sfeirarch.com
ALL HORIZONTAL DIRECTIONS. A FLEXIBLE SPRINKLER HÓSE FITTING THAT CAN ACCOMMODATE ONE (1) INCH OF CEILING MOVEMENT SHALL BE PERMITTED TO BE USED IN LIEU OF THE OVERSIZED RING, SLEEVE OR ADAPTER. SUCH FLEXIBLE	TCMC
SPRINKLER HOSE SHALL BE ADEQUATELY SUPPORTED FROM SOFFIT SO AS NOT TO EXCEED THE MAXIMUM TRIBUTARY WEIGHT OF THE CEILING.	PHARMACY
ERAL FORCE BRACING: ERAL FORCE BRACING IS REQUIRED IN ACCORDANCE WITH THIS TION FOR ALL CEILING AREAS, UON.	USP 800
EPTION: LATERAL FORCE BRACING MAY BE OMITTED FOR PENDED ACOUSTICAL CEILING SYSTEMS WITH A CEILING AREA 144 SQ. FT. OR LESS, WHEN PERIMETER SUPPORT ARE OVIDED AND PERIMETER WALLS ARE DESIGNED TO CARRY THE LING LATERAL FORCES.	UPGRADE
PROVIDE LATERAL-FORCE BRACING ASSEMBLIES CONSISTING OF A STRUT AND FOUR (4) #12 GAGE BRACING WIRES ORIENTED 90 DEGREESFROM EACH OTHER. LATERAL-FORCE BRACING ASSEMBLIES SHALL BE SPACED IN ACCORDANCE WITH DETAILS 1/A5-60, 10/A5-60 & 14/A5-60	Tri-City Medical Center
FROM EACH WALL AND AT THE EDGES OF ANY CHANGE OF ELEVATION OF THE CEILING. THE SLOPE OF BRACING WIRES MAY BE FROM 10 TO 45 DEGREES BUT MAY NOT EXCEED 45 DEGREES FROM THE PLANE OF THE CEILING AND WIRES SHALL BE TAUT. STRUTS SHALL BE ADEQUATE TO RESIST THE VERTICAL	4002 Vista Way Oceanside, California 92056
COMPONENT INDUCED BY THE BRACING WIRES, AND SHALL NOT BE MORE THAN 1 (HORIZONTAL) IN 6 (VERTICAL) OUT OF PLUMB.	OWNER: TRI-CITY MEDICAL CENTER
ACHMENT OF HANGER AND BRACING WIRES: FASTEN #12 HANGER WIRES WITH NOT LESS THAN THREE (3) TIGHT TURN IN 3 INCHES. HANGER WIRE LOOPS SHALL BE TIGHTLY WRAPPED AND SHARPLY BENT TO PREVENT — ANY VERTICAL MOVEMENT OR ROTATION OF THE MEMBER	4002 VISTA WAY OCEANSIDE, CALIFORNIA 92056
WITHIN THE LOOPS. FASTEN #12 BRACING WIRES WITH FOUR (4) TIGHT TURNS. MAKE ALL TIGHT TURNS WITHIN A DISTANCE OF 1 1/2" INCHES.	ARCHITECT: SFEIR ARCHITECTS 5151 SHOREHAM PLACE, SUITE 100 SAN DIEGO, CALIFORNIA 92122 TEL(619)299–3917 FAX(619)299–5084
HANGER OR BRACING WIRE ANCHORED TO THE STRUCTURE SHOULD BE INSTALLED IN SUCH A MANNER THAT THE DIRECTION OF THE ANCHOR ALIGNS AS CLOSELY AS POSSIBLE WITH THE DIRECTION OF THE WIRE. SEPARATE ALL CEILING HANGER AND BRACING WIRES AT LEAST SIX (6) INCHES FROM ALL UNBRACED DUCTS, PIPES	MEP: P2S ENGINEERING, INC. 9665 CHESAPEAKE DRIVE, SUITE 230 SAN DIEGO, CA 92123 TEL(619)618-2347
CONDUITS, ETC. HANGER WIRES SHALL NOT BE ATTACHED TO OR BEND AROUND INTERFERING MATERIAL OR EQUIPMENT. PROVIDE TRAPEZE OR OTHER SUPPLEMENTARY SUPPORT MEMBERS AT OBSTRUCTIONS TO TYPICAL HANGER SPACING. PROVIDE ADDITIONAL HANGERS, STRUTS OR BRACES AS REQUIRED AT ALL CEILING BREAKS, SOFFITS, OR DISCONTINUOUS	STRUCTURAL: SUN STRUCTURAL ENGINEERING 2091 LAS PALMAS DRIVE, SUITE D CARLSBAD, CA 92011 TEL(760)438–1188
AREAS. HANGER WIRES THAT ARE MORE THAN 1 (HORIZONTAL) IN 6 (VERTICAL) OUT OF PLUMB SHALL REQUIRE PROJECT SPECIFIC DESIGN. WHEN DRILLED-IN CONCRETE ANCHORS OR PAF ARE USED	CENSED APPEN
IN REINFORCED CONCRETE FOR HANGER WIRES, 1 OUT OF 10 WIRE/ ANCHOR ASSEMBLIES SHALL BE FIELD TESTED FOR 200 LBS. IN TENSION. WHEN DRILLED-IN CONCRETE ANCHORS ARE USED FOR BRACING WIRES, 1 OUT OF 2 WIRE/ANCHOR ASSEMBLIES SHALL BE FIELD TESTED FOR	₩ (²) No. C 28543 7
440 LBS. IN TENSION IN THE DIRECTION OF THE WIRE. PAF IN CONCRETE ARE NOT PERMITTED FOR BRACING WIRES. ING FIXTURES, TERMINALS, AND DEVICES:	VAN 1-31-19 MIT
ALL LIGHT FIXTURES, AIR TERMINALS/GRILLS, OR OTHER DEVICES (REFERRED TO ALL BY COMMON TERM FIXTURES — HEREAFTER) SHALL BE MOUNTED IN A MANNER THAT WILL NOT COMPROMISE CEILING PERFORMANCE.	$\frac{1}{2} \frac{1}{2} \frac{1}$
ALL FIXTURES SHALL BE SUPPORTED DIRECTLY BY MAIN RUNNERS OR BY SUPPLEMENTAL FRAMING WHICH IS SUPPORTED BY MAIN RUNNERS AND POSITIVELY ATTACHED	$\begin{array}{c} \overbrace{3}\\ \overbrace{4}\\ \overbrace{4}\\ \hline{5}\\ \hline \hline{5}\\ \hline{5}\\ \hline{5}\\ \hline \hline{5}\\ \hline \hline{5}\\ \hline \hline{5}\\ \hline \hline \hline{5}\\ \hline \hline$
WITH SCREWS OR OTHER APPROVED CONNECTORS. SURFACE MOUNTED FIXTURES SHALL BE ATTACHED TO A MAIN RUNNER WITH A POSITIVE CLAMPING DEVICE MADE OF	$\begin{array}{c c} \hline & \hline \\ \hline \\$
MATERIAL WITH A MINIMUM OF 14 GAGE. ROTATIONAL SPRING CLAMPS DO NOT COMPLY.	6 DESIGN CHANGES 6-05-18
ACCESS PANELS: ACCESS TO THE SPACE BETWEEN THE CEILING AND THE FLOOR OR ROOF ABOVE SHALL NOT BE ALLOWED. SMALL ACCESS PANELS FOR THE INSPECTION, ADJUSTMENT, OR REPAIR OF UTILITY SWITCHES, VALVES, SENSORS, ETC. MAY BE ALLOWED IF THE PANEL IS LESS THAN 300 SQUARE INCHES. SUCH PANELS SHALL ALSO HAVE A	
PERMANENT WARNING LABEL AS FOLLOWS: 1. DO NOT CLIMB, WALK, OR CRAWL ON THE GYPSUM	
BOARD CEILING. 2. DO NOT STORE OR STOW ANYTHING ON THE GYPSUM BOARD CEILING.	REV: DESCRIPTION: DATE:
ALL FIXTURES WEIGHING LESS THAN OR EQUAL TO 10 LB. SHALL HAVE ONE NO. 12 GAUGE SAFETY WIRE CONNECTED FROM FIXTURE HOUSING TO STRUCTURE ABOVE. IT IS NOT NECESSARY FOR THESE SAFETY WIRES TO BE TAUT. ALL FIXTURES WEIGHING GREATER THAN 10 LB BUT LESS THAN OR EQUAL TO 56 LB SHALL HAVE TWO NO. 12 GAUGE SAFETY WIRE CONNECTED FROM FIXTURE HOUSING TO STRUCTURE	CONSULTANT
ABOVE. IT IS NOT NECESSARY FOR THESE SAFETY WIRES TO BE TAUT. ALL FIXTURES WEIGHING GREATER THAN 56 LB SHALL BE	OSHPD APPROVAL STAMP:
SUPPORTED DIRECTLY FROM STRUCTURE ABOVE BY APPROVED HANGERS. PENDANT-HUNG FIXTURES SHALL BE SUPPORTED DIRECTLY FROM THE STRUCTURE ABOVE USING NO LESS THAN NO. 0- GAUGE WIRE OR AN APPROVED ALTERNATE SUPPORT. THE C	OSHPD #: S171641-37-00
EILING SUSPENSION SYSTEM SHALL NOT PROVIDE ANY DIRECT SUPPORT. ALL RECESSED OR DROP-IN FIXTURES SHALL BE SUPPORTED DIRECTLY FROM FIXTURE HOUSING TO THE STRUCTURE ABOVE WITH A MINIMUM OF TWO NO. 12 GAUGE WIRES LOCATED AT	
DIAGONALLY OPPOSITE CORNERS. LEVELING OR POSITIONING OF FIXTURES MAY BE PROVIDED BY CEILING GRID. FIXTURE SUPPORT WIRES MAY BE SLIGHTLY LOOSE TO ALLOW THE FIXTURE TO SEAT IN THE GRID SYSTEM. FIXTURES SHALL NOT BE SUPPORTED FROM MAIN RUNNERS OR FURRING CHANNELS IF THE WEIGHT OF THE FIXTURES CAUSES TOTAL DEAD LOAD TO	
EXCEED THE DEFLECTION CAPABILITY OF THE CEILING SUSPENSION SYSTEM.	SHEET TITLE:
CEILINGS THAT ARE PART OF A FIRE RATED ASSEMBLY: PROVIDEA DETAIL AND DESIGN NUMBER FOR RATED CEILING ASSEMBLIES FROM AN APPROVED TESTING AGENCY. THE COMPONENTS AND INSTALLATION DETAILS SHALL CONFORM IN EVERY RESPECT WITH THE LISTED DETAIL AND NUMBER. DETAILS SHALL CLEARLY DEPICT ALL COMPONENTS, INCLUDING INSULATION MATERIALS,	GYPSUM CEILING DETAILS

PENETRATIONS THROUGH THE CEILING FOR SPRINKLER HEADS

GYPSUM CEILING DETAILS N BE CONSTRUCTED AND INSPECTED ACCORDINGLY. PROJECT TITLE: JNLESS SPECIFICALLY DETAILED ON THE DRAWINGS TCMC USP 800 D INSTALLATION SHALL COMPLY WITH ASTM C840-1

SCALE:


S


A R C H I T E C T S

5151 Shoreham Place, Suite 100


San Diego, Ca 92122

SHEET NUMBER PROJECT #: 01667.00 DRAWN BY: Author

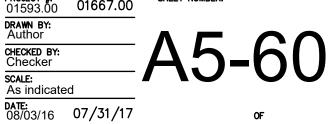

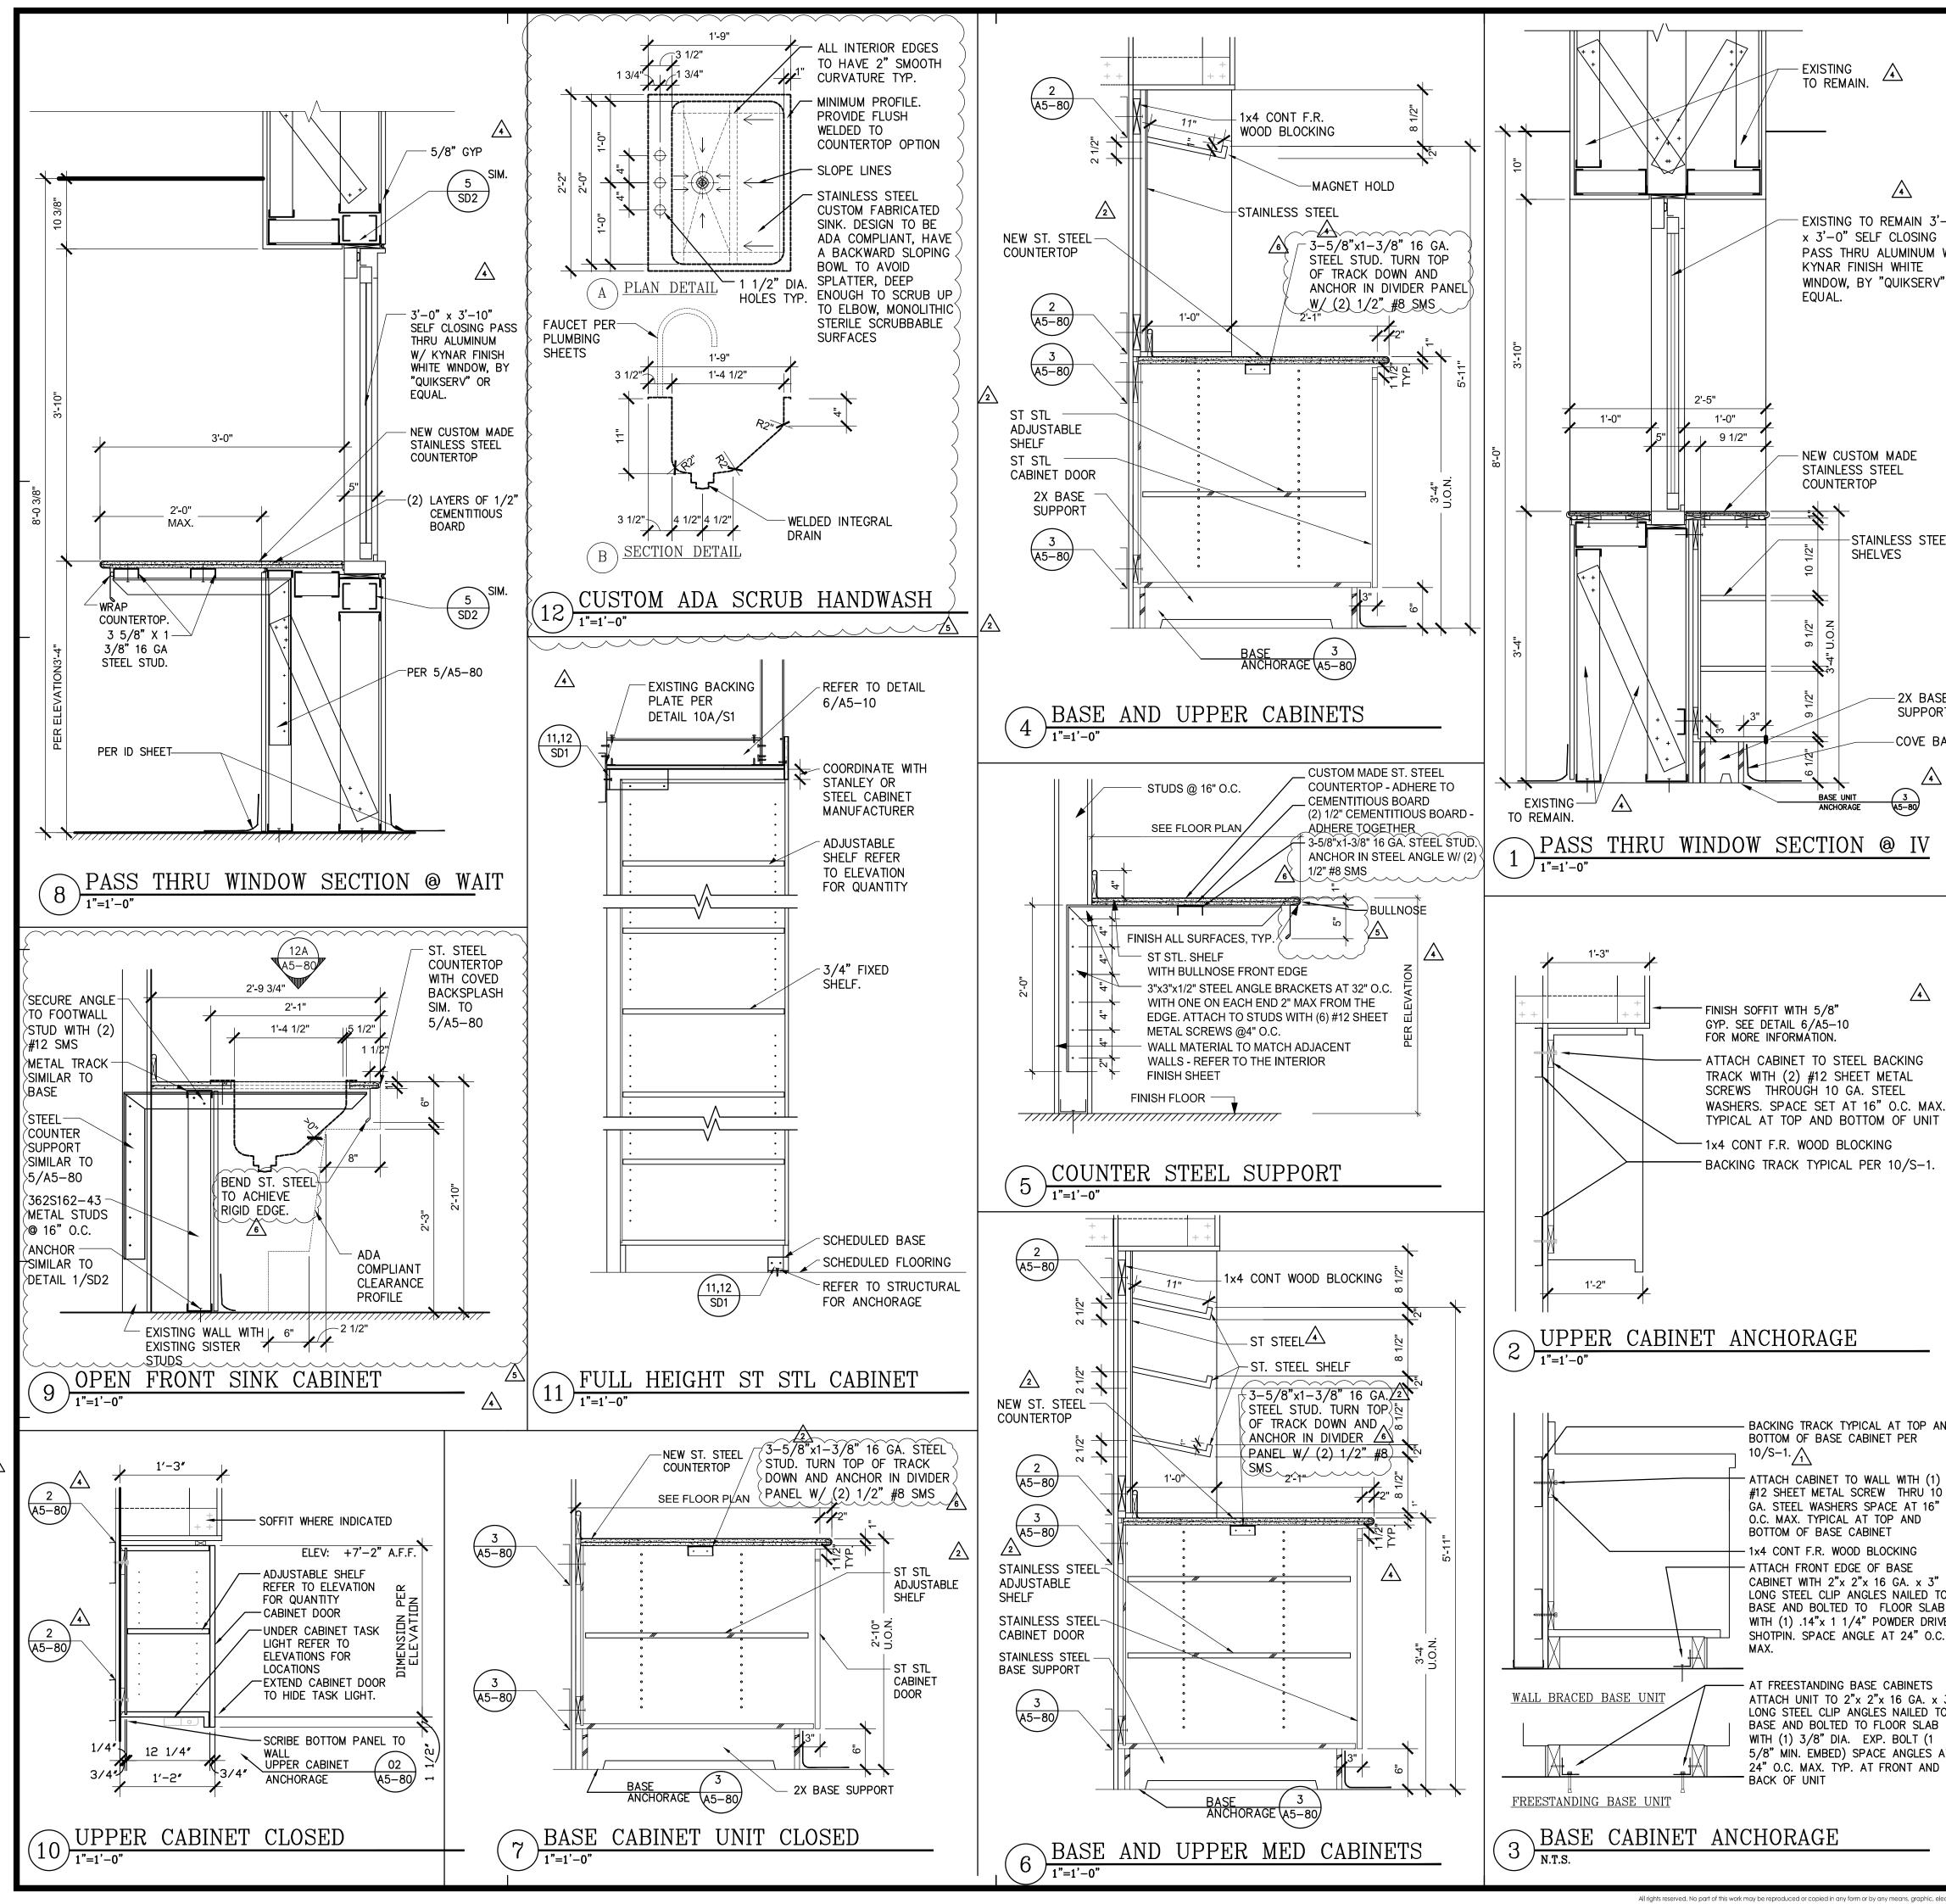

		SFEIR
		ARCHITECTS
	REFER TO EQUIPMENT SCHEDULE. * NOTES	5151 Shoreham Place, Suite 100 San Diego, Ca 92122
	CASEWORK LEGEND:	P: 619-299-3917
-0"	CASE ID NUMBER HEIGHT D100G24 NUMBER HEIGHT	F: 619—299—5084 www.sfeirarch.com
W/	$\begin{array}{ c c c c c c c c c c c c c c c c c c c$	TCMC
" OR	$\begin{array}{c c} \hline \\ \hline $	PHARMACY
	TASK24 = 24" TASK LIGHT MODULEF33"TASK36 = 36" TASK LIGHT MODULEG36"H39"	USP 800
	TASK48 = 48" TASK LIGHT MODULEII03FTPED = SINK FOOT CONTROL PEDALSJ42"K48"L54"	UPGRADE
	DEPTH (U.O.N. ON ELEVATIONS)M72"N80"LOWER CASE: 24" DEEPU.O.N.PUPPER CASE: 14" DEEPU.O.N.Q96"	UFGRADE
	UPPER CASE: 14" DEEPU.O.N.Q96"TALL CASE: 14" DEEPU.O.N.RAS REQ'D.	Tri-City Medical Center
	OUTLET DESCRIPTION A - MEDICAL COMPRESSED AIR N - NURSE CALL A - NURSE CALL	
EL	C– CODE BLUENO– NITROUS OXIDED– DATAO– OXYGENDP– DICTAPHONEPS– NURSE CALL PULL STATIONDS– DIMMER SWITCHS– SWITCH	4002 Vista Way Oceanside, California 92056
	DS – DIMMER SWITCH S – SWITCH E – DUPLEX ELECT. OUTLET T – TELEPHONE F – FAX MACHINE TL – TASK LIGHT IC – INTERCOM TV – TELEVISION	OWNER: TRI-CITY MEDICAL CENTER
	J – JUNCTION BOX J – JUNCTION BOX GENERAL NOTES: V – VACUUM VC – VOLUME CONTROL VS – VACUUM SLIDE VS – VACUUM	4002 VISTA WAY OCEANSIDE, CALIFORNIA 92056
	OPINEICAL INDIES. VS VACCOM SLIDE 1. ALL CASEWORK SHALL BE "CUSTOM" GRADE AS DEFINED BY THE WOODWORK A INSTITUTE OF CALIFORNIA.	ARCHITECT: SFEIR ARCHITECTS 5151 SHOREHAM PLACE, SUITE 100 SAM DIECO, CALIEORNIA 02122
E RT	6 2. PRIME AND PAINT ALL STEEL ANGLES & CEMENTITIOUS BD. UNDER COUNTERTOPS.	SAN DIEGO, CALIFORNIA 92122 TEL(619)299-3917 FAX(619)299-5084 MEP: P2S ENGINEERING, INC.
ASE	3. BASES ON CASEWORK SHALL BE 4" UNLESS OTHERWISE NOTED. PROVIDE SAME FINISH BASE MATERIAL AS ADJACENT WALLS. EXTEND BASE TO WALL AT ALL	MEP: P2S ENGINEERING, INC. 9665 CHESAPEAKE DRIVE, SUITE 230 SAN DIEGO, CA 92123 TEL(619)618-2347
	CABINET RETURNS AND END PANELS. 4. IN CASES OF CABINET INSTALLATIONS BETWEEN WALLS, VERIFY DIMENSIONS IN	STRUCTURAL: SUN STRUCTURAL ENGINEERING 2091 LAS PALMAS DRIVE, SUITE D
	FIELD AND PROVIDE FILLER PANEL STRIPS AT ENDS OR REDUCE END CABINETS WIDTH AS REQUIRED TO FIT SPACE AS INDICATED.	CARLSBAD, CA 92011 TEL(760)438–1188
	5. ALL CABINET DOORS AND DRAWERS SHALL HAVE PULLS, U.N.O. UPPER AND LOWER CABINET DOORS AND FULL HEIGHT CABINETS SHALL HAVE PULLS MOUNTED VERTICALLY. DRAWERS SHALL HAVE HORIZONTAL PULLS, U.N.O.	
	6. ALL FILE DRAWERS SHALL BE SIZED FOR 8 1/2"x 11" FORMS. PROVIDE FILE RODS EXTENDING FRONT TO BACK OF DRAWER UNIT. TYPICAL	Stand Michael
	7. COORDINATE HEIGHT AND LOCATION OF BACKING PLATES FOR CASEWORK WITH STUD FRAMING CONTRACTOR. REFER TO STRUCTURAL DRAWINGS FOR BACKING DETAILS.	★ S No. C 28543 7 ★
	8. REFER TO STRUCTURAL DRAWINGS FOR WALL CABINET ANCHORAGE/BACKING TRACK CONNECTION.	OF CALFOR
	9. GENERAL CONTRACTOR SHALL VERIFY ALL DIMENSIONS OF ROUGH OPENINGS AND	$\frac{1}{1} \underbrace{1}_{\text{OSHPD COMMENTS}} 0$
	SHOP DRAWING'S AND FABRICATION.	$\frac{2}{3} + \frac{2}{3} + \frac{2}$
ζ.		$\begin{array}{c c} \hline 4 \\ \hline 5 \\ \hline 5$
Δ		6 DESIGN CHANGES 6-05-18 6 0 0
		REV: DESCRIPTION: DATE:
		CONSULTANT
		oshpd approval stamp: OSHPD #: S171641—37—00
ND		
)		
0		SHEET TITLE:
/EN :.		MILLWORK
3"		DETAILS
õ		PROJECT TITLE: TCMC USP 800
۹T		PROJECT #: 01667.00 SHEET NUMBER:
		SCALE: AS SHOWN A5-80
ectronic, or	mechanical, including photocopying, recording, taping, or information and retrieval systems without written permission of the ARCHITECT.	NSTRUCTION DOCUMENT

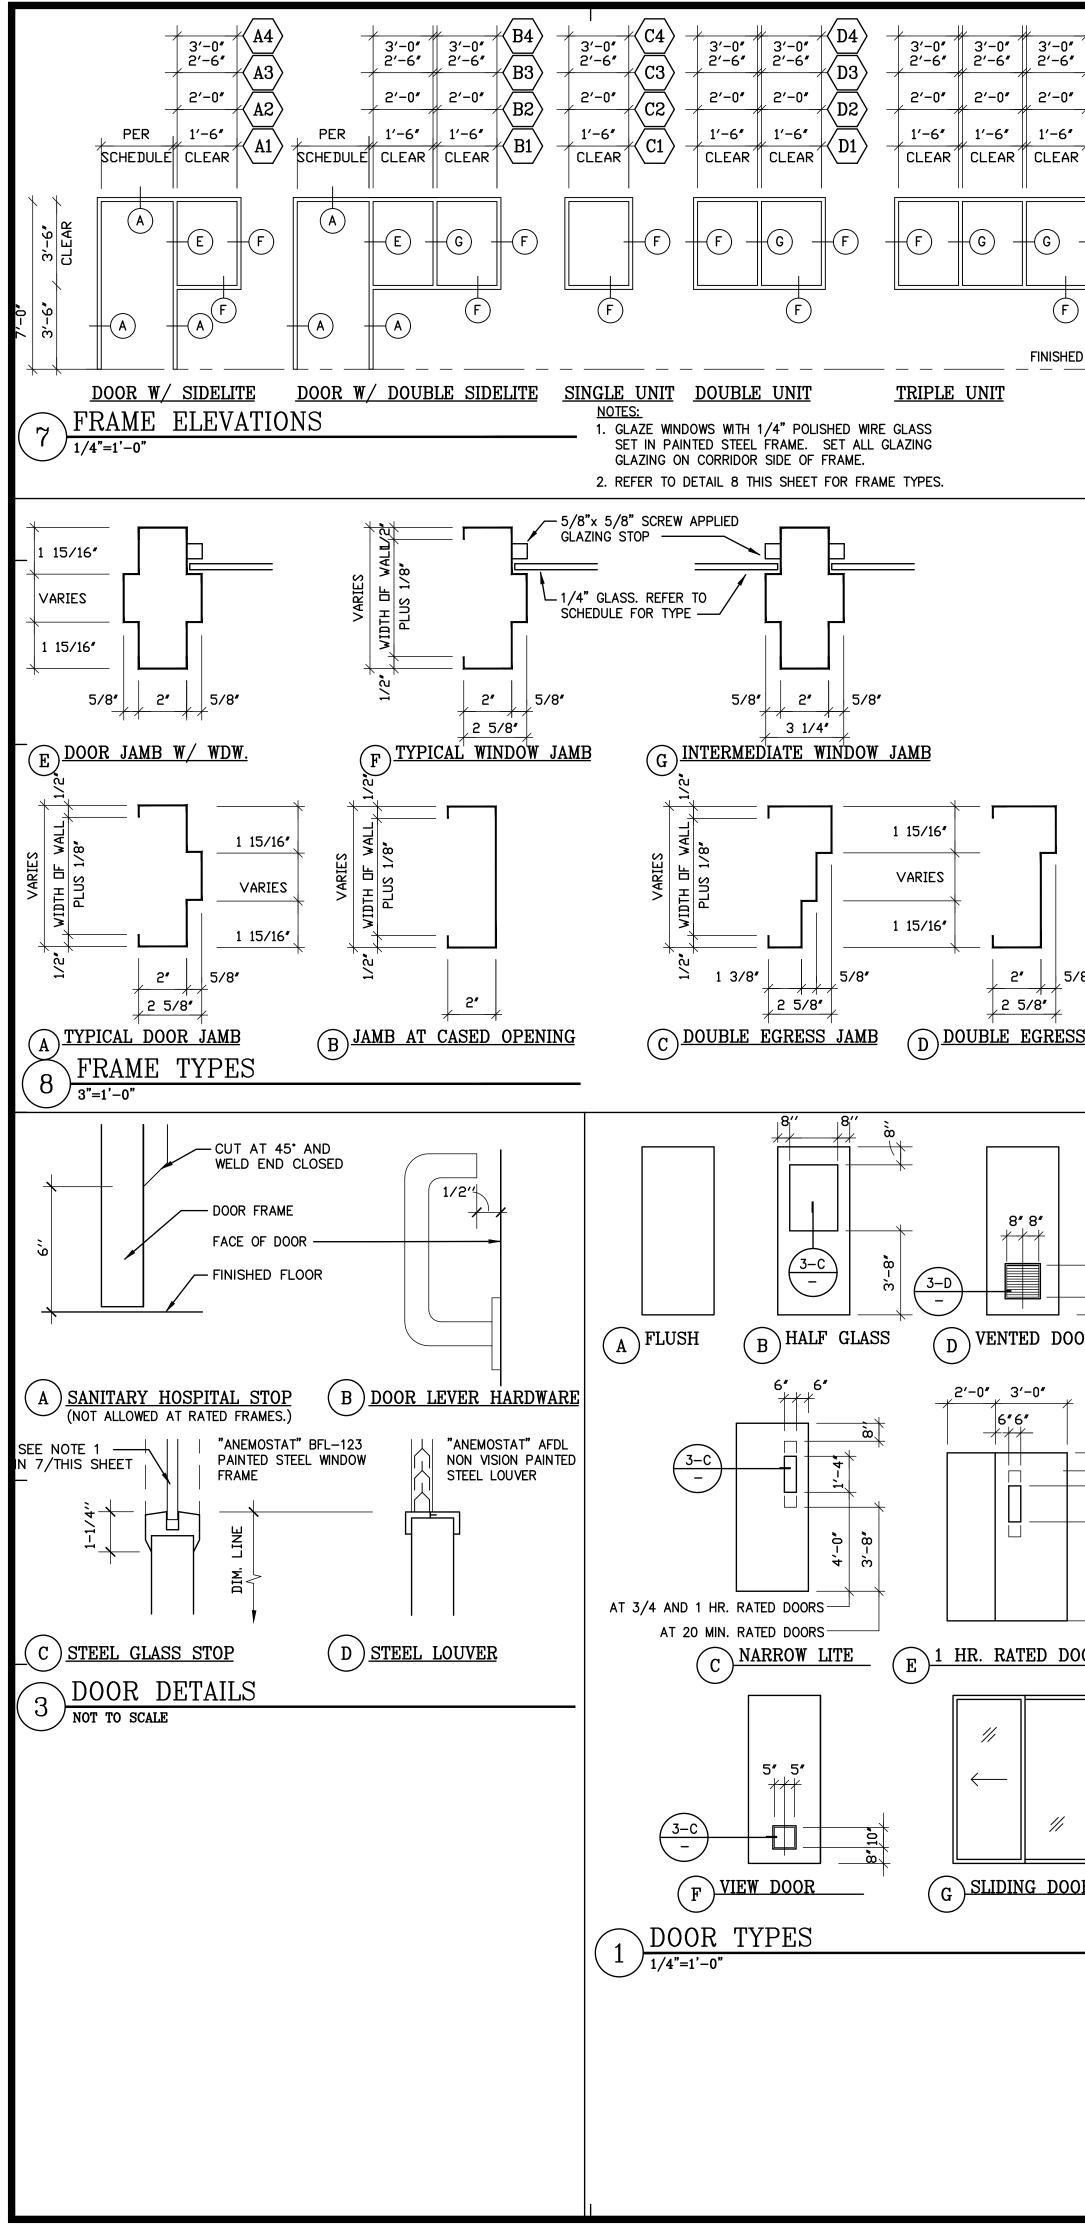

OPNG.	DOC	OR						FRA	ME		DETAILS	5		LABEI
NO.	TYPE	OP	ENIN	NG SIZ	E	MATERIAL	FINISH	TYPE	MATERIAL	FINISH	HEAD	JAMB	THRESHOLD	
030A	B,D	3'-	-6"x	7'-0"	,	STEEL	PTD	A	STEEL	PTD	9	10		NR
031A	В	3'-	-6"x	7'-0"	,	STEEL	PTD	A	STEEL	PTD	9	10		NR
032A	В	3'-	-6"x	7'-0"	,	STEEL	PTD	A	STEEL	PTD	9	10		NR
						NOTE: REFER TO TYPE AND		N FOR REG	REI DO REI NIW #7 (PF HEJ WE QUIRED PARTITIO	FER TO DETAI UBLE STUD B FER TO DETAI NTED HOLLOW OVIDE MIN. 3 ROVIDE 2 ADD AD SECTION C LD ANCHORS	(TOP & BOTTOM) L 3/SD2 A BOX HEADER, L 3/SD2 A NOTIONAL ANCHORS DF PAIRS OF DOO TO DOOR FRAME	RAME. JAMB. S AT DRS.		3/-
			(PICAL	DOOR	E HEA	DER					(10

A R C H I T E C A R C H I T E C B B B B B B B B B B B B B	Cente
An office and the second set of the sec	Cente
02 1 3 4 03 1 3 4 5 03 1 3 4 5 6 The DE-298-2017 Weak distribution colspan="2">The DE-298-2017 Weak distributi	Cente
	Cente
PARTED HOLLOW METAL DOOR FRAME HOUSE MILLS STRUCTURE TO STORE HOUSE MILLS STRUCTURE TO STORE HOUSE MILLS STRUCTURE TO STORE HOUSE MILL DOOR FRAME HOUSE STRUCTURE TO STORE HOUSE STRUCTURE TO STORE HOUSE STRUCTURE TO STORE HOUSE STRUCTURE TO STORE HOUSE STRUCTURE TO STRUCTURE HOUSE	Cente
PAYTED HOLLOW METAL DOOR FRAME. FROME MILL SACTION OF PARS OF DOOR. WED ANCHORS TO DOOR FRAME. FROME MILL ACCOUNT NETALS TO STUDE WITH 2 of 2 DOOR FRAME. POOR SCHEDULE GENERAL NOTES: 1. PROVE SANTARY HOSPITAL STOPS' AT ALL NOT-RATED INTERIOR DOOR FRAME. 2. ALL DOOR SANTARY HOSPITAL STOPS' AT ALL NOT-RATED INTERIOR DOOR FRAME. 1. PROVE SANTARY HOSPITAL STOPS' AT ALL NOT-RATED INTERIOR DOOR FRAME. 2. ALL DOORS SANL RECEIPT LEAR TYPE HARDWARE WITH A PROFILE EQUAL. 1. PROVE SANTARY HOSPITAL STOPS' AT ALL NOT-RATED INTERIOR DOOR FRAME. 2. ALL DOORS SANL RECEIPT LEAR TYPE HARDWARE WITH A PROFILE EQUAL. 1. PROVE SANTARY HOSPITAL STOPS' AT ALL NOT-RATED INTERIOR DOOR FRAME. 2. ALL DOORS SANL RECEIPT LEAR TYPE HARDWARE WITH A PROFILE EQUAL. 1. DOORS SANL RECEIPT LEAR TYPE HARDWARE WITH A PROFILE EQUAL. 3. ALL DOORS SANL RECEIPT LEAR TYPE HARDWARE WITH A PROFILE EQUAL. 4. GUARD OPENINGS IN 6 DAVE ON WITH ASSEMBLES SHALL NOT EXCEED 1296 SD. INCHES AND SHALL BE OAND ON 04 9 MINIT ASSEMBLES SHALL NOT EXCEED 1296 SD. INCHES AND SHALL BE OAND ON 04 9 MINIT ASSEMBLES SHALL NOT EXCEED 1296 SD. INCHES AND SHALL BE OAND ON 04 9 MINIT ASSEMBLES SHALL NOT EXCEED 1296 SD. INCHES AND SHALL BE OAND ON 04 9 MINIT ASSEMBLES SHALL NOT EXCEED 1296 SD. INCHES AND SHALL BE OAND 040 90 MINITY AND SHALL NOT EXCEED 1296 SD. INCHES AND SHALL BE OAND 040 90 MINITY ASSEMBLES SHALL NOT EXCEED 1296 SD. INCHES AND SHALL BE OAND 040 90 MINITY ASSEMBLES SHALL NOT EXCEED 1296 SD. INCHES AND SHALL BE OAND 040 90 MINITY ASSEMBLES SHALL NOT EXCEED 1296 SD. INCHES AND SHALL BE OAND 040 90 MINITY ASSEMBLES SHALL NOT EXCEED 1296 SD. INCHES AND SHALL BE OAND 040 90 MINITY ASSEMBLES SHALL NOT EXCEED 1296 SD. INCHES AND SHALL BE OAND 040 90 MINITY ASSEMBLES SHALL NOT EXCEED 1296 SD. INCHES AND SHALL BE OAND 040 90 MINITY ASSEMBLES SHALL NOT EXCEED 1296 SD. INCHES AND SHALL BE OAND 040 90 MINITY ASSEMBLES SHALL NOT EXCEED 1296 SD. INCHES AND SHALL BE OAND 040 90 MINITY ASSEMBLES SHALL NOT EXCEED 1296 SD. INCHES AND SHALL BE OA	Cente
PANTED HOLLOW METAL DOOR FRAME. PROVIDE MIL 2 AUCHORS AND PER AME. PROVIDE MIL 2 AUCHORS AND PER AME. PROVIDE MIL 2 AUCHORS TO DOOR FRAME PROVIDE MIL 2 AUCHORS TO DOOR FRAME TO STRUCT DETAIL 3/SZL A MULL LOCATION AT SMILLAR CONDITION PROVIDE SANTARY THOSPITAL STOPS' AT ALL NON-FRATED INTERIOR DOOR FRAMES. 2 AUL DOORS FAMIL RECEIVE TYPE HARDWARE WITH A PROFILE EQUAL TO DETAIL 3-D THIS SHELT 3. GLAZED OPENNOSIN TO ADD 45 MINUTE ASSEMBLIES SHALL NOT EXCEED TO SD. 4. GLAZED OPENNOSIN TO ADD 45 MINUTE ASSEMBLIES SHALL NOT EXCEED TO SD. 4. GLAZED OPENNOSIN TO ADD 45 MINUTE ASSEMBLIES SHALL NOT EXCEED TO SD. 4. GLAZED OPENNOSIN TO ADD 45 MINUTE ASSEMBLIES SHALL NOT EXCEED TO SD. 4. GLAZED OPENNOSIN TO ADD 45 MINUTE ASSEMBLIES SHALL NOT EXCEED TO SD. 4. GLAZED OPENNOSIN TO ADD 45 MINUTE ASSEMBLIES SHALL NOT EXCEED TO SD. 4. GLAZED OPENNOSIN TO ADD 45 MINUTE ASSEMBLIES SHALL NOT EXCEED TO SD. 4. GLAZED OPENNOSIN TO ADD 45 MINUTE ASSEMBLIES SHALL NOT EXCEED TO SD. 4. GLAZED OPENNOSIN TO ADD 45 MINUTE ASSEMBLIES SHALL NOT EXCEED TO SD. 4. GLAZED OPENNOSIN TO ADD 45 MINUTE ASSEMBLIES SHALL NOT EXCEED TO SD. 4. GLAZED OPENNOSIN TO ADD 45 MINUTE ASSEMBLIES SHALL NOT EXCEED TO SD. 4. GLAZED OPENNOSIN TO ADD 45 MINUTE ASSEMBLIES SHALL NOT EXCEED TO SD. 4. GLAZED OPENNOSIN TO ADD 45 MINUTE ASSEMBLIES TO CONCED TO SD. 4. GLAZED OPENNOSIN TO ADD 45 MINUTE ASSEMBLIES TO CONCED TO SD. 4. GLAZED OPENNOSIN TO ADD 45 MINUTE ASSEMBLIES TO DOOR FRAMES. 4. GLAZE	
PANTED HOLLOW METAL DOOR FRAME PROVIDE 2 AUGTOMAL ANCHORS AT HED SCHOOL WILL 3 AUGUST OF DOOR HED ANABORS TO DOOR FRAME PROVIDE 2 AUGTOMAL ANCHORS AT HED SCHOOL OF TAME PROVIDE 2 AUGTOMAL ANCHORS AT HED SCHOOL OF TAME PASTEM FRAME TO STUDS WITH 2 #12 SMS FRE AUCHOR POOR JAMEDS TO DOOR FRAME POOR JAMEDS TO STUDS WITH 2 #12 SMS FRE AUCHOR POOR JAMED REFER 2/SD2 4" WILL LOCATION AT SIMULAR CONDITION. TE: TO FLOOR FLAM FOR REQUIRED PARTITION PER TO FLOOR JAMEB 1-0" THE CONDITION. PROVIDE SANTARY "HOSPITAL STOPS" AT ALL NON-FRAME 1. PROVIDE SANTARY "HOSPITAL STOPS" AT ALL NON-FRAME 1. PROVIDE SANTARY "HOSPITAL STOPS" AT ALL NON-FRAME 1. DOOR SCHEDULE GENERAL NOTES: 1. RROWDE SANTARY "HOSPITAL STOPS" AT ALL NON-FRAME INTERIOR DOOR FRAMES. 2. ALL DOORS SHALL RECOVE LEVER TYPE HARDWARE WITH A PROFILE EQUAL 1. CONSTRUCT USER SHALL NOT EXCEED 1296 SO. INCRES AND SHALL BE GLAZED WITH 1/4" WIRE GLASS SET IN PAINTED STELL FRAME. 4. GLAZED OPENINGS IN 20 AND 45 MINUTE ASSEMBLIES SHALL NOT EXCEED 1296 SO. INCRES AND SHALL BE GLAZED WITH 1/4" WIRE GLASS SET IN PAINTED STELL FRAME. 4. GLAZED OPENINGS IN 20 AND 45 MINUTE ASSEMBLIES SHALL NOT EXCEED 1296 SO. INCRES AND SHALL BE GLAZED WITH 1/4" WIRE GLASS SET IN PAINTED STELL FRAME. 4. GLAZED OPENINGS IN 20 AND 45 MINUTE ASSEMBLIES SHALL NOT EXCEED 1296 SO. HERE STOP ILLOOPENINGS IN 20 AND 45 MINUTE ASSEMBLIES SHALL NOT EXCEED 1296 SO. HERE STOP ILLOOPENINGS IN 20 AND 45 MINUTE ASSEMBLIES SHALL NOT EXCEED 1296 SO. HERE STOP ILLOOPENING IN 20 AND 45 MINUTE ASSEMBLIES SHALL NOT EXCEED 1296 SO. HERE STOP ILLOOPENING IN 20 AND 45 MINUTE ASSEMBLIES SHALL NOT EXCEED 1296 SO. HERE STOP ILLOOPENING IN 20 AND 45 MINUTE ASSEMBLIES SHALL NOT EXCEED 1296 SO. HERE STOP ILLOOPENING IN 20 AND 45 MINUTE ASSEMBLIES SHALL NOT EXCEED 1296 SO. HERE STOP ILLOOPENING IN 20 AND 45 MINUTE ASSEMBLIES SHALL NOT EXCEED 1296 SO. HERE STOP ILLOOPENING IN 20 AND 45 MINUTE ASSEMBLIES SHALL NOT EXCEED 1296 SO. HERE STOP ILLOOPENING IN 20 AND 45 MINUTE ASSEMBLIES SHALL	
PROVIDE MAIL 3 ANCHORS PER JAMB. PROVIDE MAIL 3 ANCHORS AT HEAD SECTION OF FRAME PROVIDE JAMB, REFER SITUATION TO BOOR FRAME PSTEIN FRAME TO STUDD WITH 2 #12 SMS PER ANCHOR DOOR JAMB, REFER TO STUDD WITH 2 #12 SMS PER ANCHOR DOOR JAMB, REFER TO FLOOR PLAN FOR REQUIRED PARTITION *** WALL LOCATION AT SIMLAR CONDITION. TEET TO FLOOR PLAN FOR REQUIRED PARTITION *** PROVIDE SANITARY "HOSPITAL STOPS" AT ALL NON-RATED INTERIOR DOOR FRAMES. 1. PROVIDE SANITARY "HOSPITAL STOPS" AT ALL NON-RATED INTERIOR DOOR FRAMES. 2. ALL DOORS SHALL RECEIVE LEVER TYPE HARDWARE WITH A PROFILE EQUAL 10 GOAR SCHEDDULE GENERAL NOTESS: 1. PROVIDE SANITARY "HOSPITAL STOPS" AT ALL NON-RATED INTERIOR DOOR FRAMES. 2. ALL DOORS SHALL RECEIVE LEVER TYPE HARDWARE WITH A PROFILE EQUAL 13 GLAZED OPENNOS IN 20 AND 45 MINUTE ASSEMULES SHALL NOT EXCEED 1026 SO. INCHES AND SHALL BE GLAZED WITH 1/4" WIRE CLASS SET IN PAINED STELEL FRAME. 4. GLAZED OPENNOS IN 20 AND 45 MINUTE ASSEMULES SHALL NOT EXCEED 1026 SO. INCHES AND SHALL BE GLAZED WITH 1/4" WIRE CLASS SET IN PAINED STELE LE FRAME. 4. GLAZED OPENNOS IN 20 AND 45 MINUTE ASSEMULES SHALL NOT EXCEED 1026 SO. INCHES AND SHALL BE GLAZED WITH 1/4" WIRE CLASS SET IN PAINED STELE LE FRAME. 4. GLAZED OPENNOS IN 20 AND 45 MINUTE ASSEMULES SHALL NOT EXCEED 1026 SO. INCHES AND SHALL BE GLAZED WITH 1/4" WIRE CLASS SET IN PAINED STELE LE FRAME. 4. GLAZED OPENNOS IN 20 AND 45 MINUTE ASSEMULES SHALL NOT EXCEED 1026 SO. INCHES AND SHALL BE GLAZED WITH 1/4" WIRE CLASS SET IN PAINED STELE FRAME. 4. GLAZED OPENNOS IN 60 AND 90 MINUTE ASSEMULES SHALL NOT EXCEED 1026 SO. INCHES AND SHALL BE GLAZED WITH 1/4" WIRE CLASS SET IN PAINED STELE FRAME. 4. GLAZED OPENNOS IN 60 AND 90 MINUTE ASSEMULES SHALL NOT EXCEED 1026 SO. INCHES AND SHALL BE GLAZED WITH IN AN OF EXCEED 1026 SO. INCHES AND SHALL BE GLAZED WINTH AND AND AND INTO ASSEMULES SHALL NOT EXCEED 1026 SO. INCHES AND SHALL BE GLAZED WITH IN AN OF EXCEED 1026 SO. INCHES AND SHALL BE GLAZED WITH IN AN OF EXCEED 1026 SO. INCHES AND S	
PROVIDE MIN. 3 ANCHORS PER JAMB. (CPROVIDE 2 ADDITIONAL ANCHORS AT HEAD SECTION OF PARKS OF BOOKS. WELD ANCHORS TO DOOR FRAME PATEN FRAME TO DOOR FRAME PATEN FRAME TO DOOR FRAME PATEN FRAME TO STUDE WITH 2 #12 SMS PER ANCHOR 4002 VISTA WAY Oceanside, California 92056 WELD ANCHORS TO DOOR FRAME PATEN FRAME TO STUDE WITH 2 #12 SMS PER ANCHOR 0000 HAMBA 2 #12 SMS PER ANCHOR 0000 HAMBA 2 #12 SMS PER ANCHOR DOOR JAMB, PEFER TO COURTING PLANT 0000 HAMBA 3/SD2. 0000 HAMBA 2 #12 SMS PER ANCHOR 0000 HAMBA 2 #12 SMS PER ANCHOR PE DOOR JAMB, PEFER TO FLOOR PLAN FOR REDURED PARTITION E AND NUMEER OF GTP. BOARD LAYERS. 00000 HAMBA 2 #100000 HAMBA 2 #1000000 HAMBA 2 #1000000 HAMBA 2 #1000000 HAMBA 2 #1000000 HAMBA 2 #1000000 HAMBA 2 #100000000 HAMBA 2 #1000000000000000000000000000000000000	3
HEAD SECTION OF PARES OF DOORS. WELD ANCHORS TO DOOR FRAME WELD ANCHORS TO DOOR FRAME PASTEN FRAME TO STUDS WITH 2 \$12 SMS PER ANCHOR OWNER: TRI-CITY MEDICAL CENTER 4002 MSTA WAY COCRAINSIDE, CALIFORNIA \$200 ARCHITECTS SISTING, CALIFORNIA \$200 A* WALL LOCATION AT SIMLAR CONDITION CONDITION TEC I. PROVIDE SANITARY "HOSPITAL STOPS" AT ALL NON-EATED INTERIOR DOOR FRAMES. 1. PROVIDE SANITARY "HOSPITAL STOPS" AT ALL NON-EATED INTERIOR DOOR FRAMES. 2. ALL DOORS SHALL RECEIP ULER TYPE HARDWARE WITH A PROFILE EQUAL TO DEBRING OMMERS 3. GLAZED OPENINGS IN 20 AND 45 MINUTE ASSEMBLIES SHALL NOT EXCED 1296 SQ. MICHES AND SHALL BE GLAZED WITH 1/4" WIRE GLASS SET IN PAINTED STEEL FRAME. 4. GLAZED OPENINGS IN 60 AND 90 MINUTE ASSEMBLIES SHALL NOT EXCED 1205 SQ.	5
PASTEN FRAME TO STUDS WITH 2 #12 SMS PER ANCHOR OWNER: TRI-CITY MEDICAL CENTER OOQ2 WSTA WAY OO22 WSTA STRUCTURAL SUICE SPER ARCHITECTS SFER ARCHITECT SFER AR	5
ARCHITECT: SFER ARCHITECTS SIST SHOREHAM PLACE, SUIT SAN DECO, CALIFORNIA 9212 TEL(619)299-3917 FAX(619) MEP: P2S ENGINEERING, INC. 9665 CHESAFEAKE DRIVE, SU SAN DECO, CA 92123 TEL(619)1618-2347 STRUCTURAL: SUN STRUCTURAL ENGINEERING 2091 LAS PALMAS DRIVE, SU CONDITION. TEL TO FLOOR PLAN FOR REQUIRED PARTITION FE AND NUMBER OF GYP. BOARD LAYERS. <u>CONDITION.</u> TEL (760)438-1188 TEL (760)438-1188 <u>CONDITION.</u> TEL (760)438-1188 <u>CONDITION.</u> TEL (760)438-1188 <u>CONDITION.</u> <u>CONDITION.</u> TEL (760)438-1188 <u>CONDITION.</u> <u>CONDITION.</u> <u>CONDITI</u>	
TO STRUCT DETAIL 3/SD2. TO STRUCT DETAIL 3/SD2. TO STRUCT DETAIL 3/SD2. TO STRUCT DETAIL 3/SD2. TO STRUCT DETAIL 3/SD2. MEP: P2S ENGINEERING, INC. 9665 CHESAPEAKE DRIVE, SU SAN DIEGO, CA 92123 TEL(619)618-2347 STRUCTURAL ENGINEERING, INC. 9665 CHESAPEAKE DRIVE, SU CARLSPAD, CA 92011 TEL(76)438-1188 TEL(76)438-	2
4" WALL LOCATION AT SIMILAR CONDITION. TEL(619)618-2347 4" WALL LOCATION AT SIMILAR CONDITION. STRUCTURAL: SUN STRUCTURAL ENGINEERIN 2091 LAS PALMAS DRIVE, SU CARLISBAD, CA 29201 TEL(760)438-1188 (PICAL DOOR JAMB 1'-0" DOOR SCHEDULE GENERAL NOTES: 1. PROVIDE SANITARY "HOSPITAL STOPS" AT ALL NON-RATED INTERIOR DOOR FRAMES. 2. ALL DOORS SHALL RECEIVE LEVER TYPE HARDWARE WITH A PROFILE EQUAL TO DETAIL 3-B THIS SHEET OHPD COMMENTS 3. GLAZED OPENINGS IN 20 AND 45 MINUTE ASSEMBLIES SHALL NOT EXCEED 1296 SQ. INCHES AND SHALL BE GLAZED WITH 1/4" WIRE GLASS SET IN PAINTED STELE FRAME. OHPD COMMENTS 4. GLAZED OPENINGS IN 60 AND 90 MINUTE ASSEMBLIES SHALL NOT EXCEED 100 SQ. OHPD COMMENTS	
TE: TE: TO FLOOR PLAN FOR REQUIRED PARTITION TE AND NUMBER OF GYP. BOARD LAYERS. <u>TO PICAL DOOR JAMB</u> 1'-0" <u>DOOR SCHEDULE GENERAL NOTES:</u> 1. PROVIDE SANITARY "HOSPITAL STOPS" AT ALL NON-RATED INTERIOR DOOR FRAMES. 2. ALL DOORS SHALL RECEIVE LEVER TYPE HARDWARE WITH A PROFILE EQUAL TO DETAIL 3-B THIS SHEET 3. GLAZED OPENINGS IN 20 AND 45 MINUTE ASSEMBLIES SHALL NOT EXCEED 1296 SQ. INCHES AND SHALL BE GLAZED WITH 1/4" WIRE GLASS SET IN PAINTED STEEL FRAME. 4. GLAZED OPENINGS IN 60 AND 90 MINUTE ASSEMBLIES SHALL NOT EXCEED 100 SQ.	
PE AND NUMBER OF GYP. BOARD LAYERS. PICAL DOOR JAMB 1'-0" No. C28543 = 1 No. C28543 = 1 No. C28543 = 1 OFF CALFORMENTS 1. PROVIDE SANITARY "HOSPITAL STOPS" AT ALL NON-RATED INTERIOR DOOR FRAMES. 2. ALL DOORS SHALL RECEIVE LEVER TYPE HARDWARE WITH A PROFILE EQUAL TO DETAIL 3-B THIS SHEET 3. GLAZED OPENINGS IN 20 AND 45 MINUTE ASSEMBLIES SHALL NOT EXCEED 1296 SQ. INCHES AND SHALL BE GLAZED WITH 1/4" WIRE GLASS SET IN PAINTED STEEL FRAME. 4. GLAZED OPENINGS IN 60 AND 90 MINUTE ASSEMBLIES SHALL NOT EXCEED 100 SQ.	
Image: Pical door jame Joor jame 1'-0" No. C28543 DOOR SCHEDULE GENERAL NOTES: No. C28543 1. PROVIDE SANITARY "HOSPITAL STOPS" AT ALL NON-RATED INTERIOR DOOR FRAMES. Image: Pical door jame 2. ALL DOORS SHALL RECEIVE LEVER TYPE HARDWARE WITH A PROFILE EQUAL TO DETAIL 3-B THIS SHEET Image: Pical door jame 3. GLAZED OPENINGS IN 20 AND 45 MINUTE ASSEMBLIES SHALL NOT EXCEED 1296 SQ. INCHES AND SHALL BE GLAZED WITH 1/4" WIRE GLASS SET IN PAINTED STEEL FRAME. Image: Pical door jame 4. GLAZED OPENINGS IN 60 AND 90 MINUTE ASSEMBLIES SHALL NOT EXCEED 100 SQ. Image: Pical door jame Image: Pical door jame	•••••
DOOR SCHEDULE GENERAL NOTES: 1. PROVIDE SANITARY "HOSPITAL STOPS" AT ALL NON-RATED INTERIOR DOOR FRAMES. 2. ALL DOORS SHALL RECEIVE LEVER TYPE HARDWARE WITH A PROFILE EQUAL TO DETAIL 3-B THIS SHEET 3. GLAZED OPENINGS IN 20 AND 45 MINUTE ASSEMBLIES SHALL NOT EXCEED 1296 SQ. INCHES AND SHALL BE GLAZED WITH 1/4" WIRE GLASS SET IN PAINTED STEEL FRAME. 4. GLAZED OPENINGS IN 60 AND 90 MINUTE ASSEMBLIES SHALL NOT EXCEED 100 SQ.	· · ·
DOOR SCHEDULE GENERAL NOTES: 1. PROVIDE SANITARY "HOSPITAL STOPS" AT ALL NON-RATED INTERIOR DOOR FRAMES. 2. ALL DOORS SHALL RECEIVE LEVER TYPE HARDWARE WITH A PROFILE EQUAL TO DETAIL 3-B THIS SHEET 3. GLAZED OPENINGS IN 20 AND 45 MINUTE ASSEMBLIES SHALL NOT EXCEED 1296 SQ. INCHES AND SHALL BE GLAZED WITH 1/4" WIRE GLASS SET IN PAINTED STEEL FRAME. 4. GLAZED OPENINGS IN 60 AND 90 MINUTE ASSEMBLIES SHALL NOT EXCEED 100 SQ.	
 1. PROVIDE SANITARY "HOSPITAL STOPS" AT ALL NON-RATED INTERIOR DOOR FRAMES. 2. ALL DOORS SHALL RECEIVE LEVER TYPE HARDWARE WITH A PROFILE EQUAL TO DETAIL 3-B THIS SHEET 3. GLAZED OPENINGS IN 20 AND 45 MINUTE ASSEMBLIES SHALL NOT EXCEED 1296 SQ. INCHES AND SHALL BE GLAZED WITH 1/4" WIRE GLASS SET IN PAINTED STEEL FRAME. 4. GLAZED OPENINGS IN 60 AND 90 MINUTE ASSEMBLIES SHALL NOT EXCEED 100 SQ. 	
 2. ALL DOORS SHALL RECEIVE LEVER TYPE HARDWARE WITH A PROFILE EQUAL TO DETAIL 3-B THIS SHEET 3. GLAZED OPENINGS IN 20 AND 45 MINUTE ASSEMBLIES SHALL NOT EXCEED 1296 SQ. INCHES AND SHALL BE GLAZED WITH 1/4" WIRE GLASS SET IN PAINTED STEEL FRAME. 4. GLAZED OPENINGS IN 60 AND 90 MINUTE ASSEMBLIES SHALL NOT EXCEED 100 SQ. 	10-09-17 10-09-17
INCHES AND SHALL BE GLAZED WITH 1/4" WIRE GLASS SET IN PAINTED STEEL FRAME. 4. GLAZED OPENINGS IN 60 AND 90 MINUTE ASSEMBLIES SHALL NOT EXCEED 100 SQ.	12-11-17
	5–15–18 5–05–18
5. FRAMES OF GLAZED OPENINGS IN DOORS SHALL BE PRIMED AND PAINTED TO MATCH	
DOOR FRAMES. 6. CENTER OF DOOR HINGE PIVOT SHALL BE LOCATED AT 4" FROM ADJACENT PARTITION	
UON.	
DOOR SCHEDULE KEYNOTES:	DATE:
1 PROVIDE STAINLESS STEEL KICKPLATE, 30" HIGH ON PUSH SIDE OF DOOR.	
2 NOT USED. 3 TEMPERED GLASS.	
(4) FLOOR MOUNTED DOOR STOP. OSHPD #: S171641-37-00	
5 EXISTING AUTOMATIC DOOR OPENER TO BE REINSTALLED, AND IT IS EQUIPPED $\sqrt{1}$ WITH SELF CLOSING DEVICE PER ITEM 6C IN A2 CHECKLIST.	
6 REUSE EXISTING DOOR FRAME.	
DOOR SCHEDULE FINISH LEGEND:	
SCWD SOLID CORE WOOD DOOR ST STAINED, MATCH EXISTING PL PLASTIC LAMINATE NR NOT RATED PTD PAINTED BAST BALISTIC STEEL DOOR AND INTERIO)R
AC ACROVYN MAR MARBLE OPENINGS SCHED	- · · ·
PROJECT TITLE:	
TCMC USP 800	

07/31/17 , electronic, or mechanical, including photocopying, recording, taping, or information and retrieval systems without written permission of the ARCHITECT. 100% CONSTRUCTION DOCUMENT

AS SHOWN

IN


A6-00

DRAWN BY:

CHECKED BY:

SCALE:


DATE:

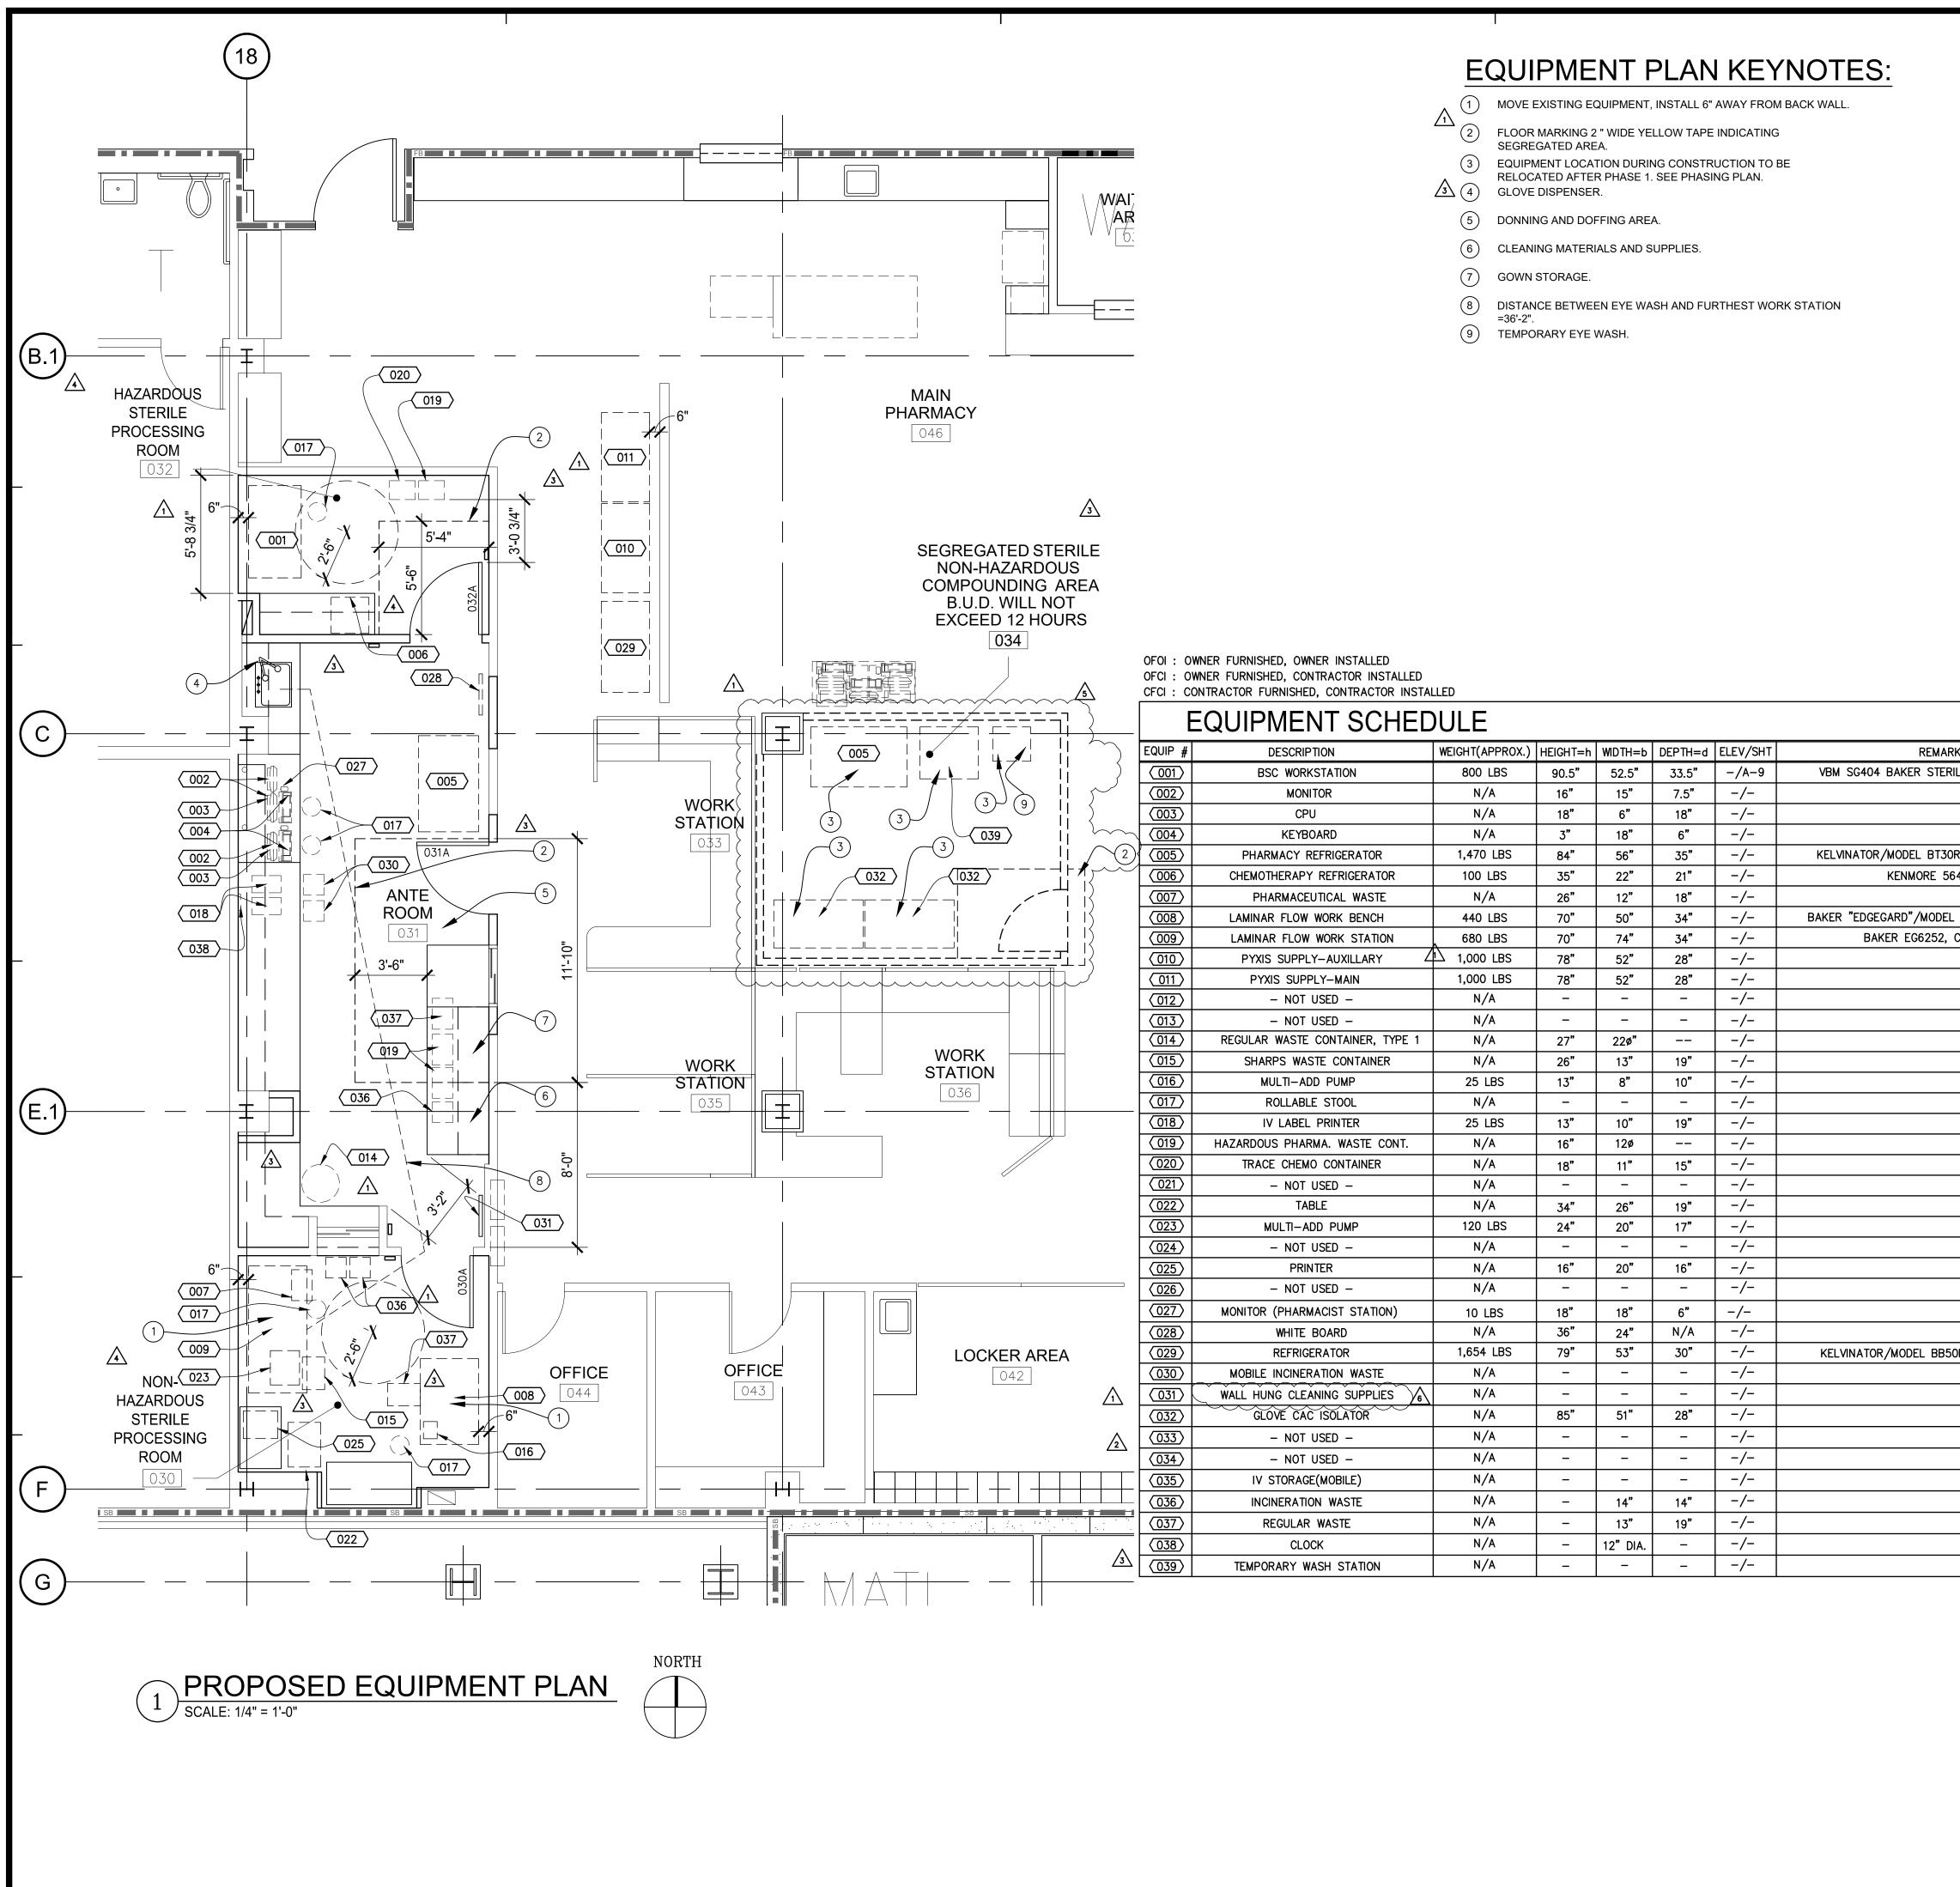



- THE GENERAL CONTRACTOR SHALL VERIFY ALL EXISTING CONDITIONS AND MEASUREMENTS IN THE FIELD PRIOR TO STARTING CONSTRUCTION.
- REFER TO GENERAL NOTES ON SHEET A0-00 FOR INFORMATION NOT 2 INDICATED ON THIS SHEET.

PARTITION LEGEND:

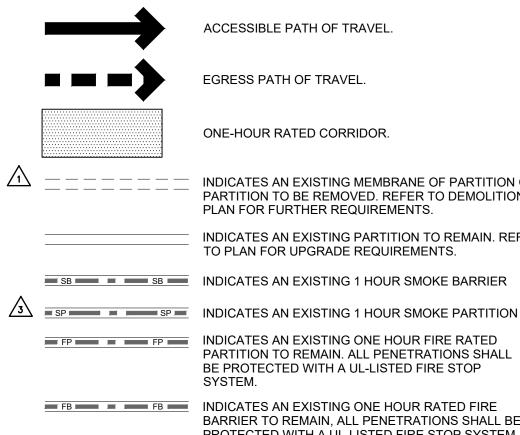

ACCESSIBLE PATH OF TRAVEL.

EGRESS PATH OF TRAVEL.

ONE-HOUR RATED CORRIDOR.

INDICATES AN EXISTING MEMBRANE OF PARTITION OR PARTITION TO BE REMOVED. REFER TO DEMOLITION PLAN FOR FURTHER REQUIREMENTS.

INDICATES AN EXISTING PARTITION TO REMAIN. REFER TO PLAN FOR UPGRADE REQUIREMENTS.

SB SB SB SB SB INDICATES AN EXISTING 1 HOUR SMOKE BARRIER

FP FP FP FP FP INDICATES AN EXISTING ONE HOUR FIRE RATED PARTITION TO REMAIN. ALL PENETRATIONS SHALL BE PROTECTED WITH A UL-LISTED FIRE STOP

SYSTEM. BARRIER TO REMAIN, ALL PENETRATIONS SHALL BE PROTECTED WITH A UL-LISTED FIRE STOP SYSTEM. FB FB FB FB FB INDICATES AN EXISTING TWO HOUR RATED FIRE BARRIER TO REMAIN, ALL PENETRATIONS SHALL BE PROTECTED WITH A UL-LISTED FIRE STOP SYSTEM.

ARKS	EXIS.	NEW	OFOI	OFCI	CFCI	QNTY	HVAC	ELECT	DATA	SEISMIC
ERILGARD, CALCS BY SSE		Х		Х		1	Х	Х	N/A	Х
	X		Х			4	N/A	N/A	N/A	N/A
	X		Х			2	N/A	N/A	х	N/A
	X		Х			4	N/A	N/A	N/A	N/A
30RG-4.1, CALCS BY SSE	X			Х		1	Х	Х	N/A	Х
564.9149510	X			Х		1	N/A	N/A	N/A	N/A
	X			Х		1	N/A	N/A	N/A	N/A
EL EG4252, CALCS BY SSE	X			Х		1	Х	Х	N/A	Х
2, CALCS BY SSE	X			Х		1	Х	Х	N/A	Х
	X			Х		1	х	Х	Х	Х
	X			Х		1	х	Х	Х	X
								-		
	X		Х			1	N/A	N/A	N/A	N/A
	X		Х			1	N/A	N/A	N/A	N/A
	X		Х			2	Х	Х	N/A	N/A
	X		Х			9	N/A	N/A	N/A	N/A
	X		Х			1	N/A	Х	Х	N/A
	X		Х			1	N/A	N/A	N/A	N/A
	X		Х			1	N/A	N/A	N/A	N/A
	X									
	X		Х			1	N/A	Х	N/A	N/A
	X		Х			2	N/A	Х	Х	N/A
	X		х			2	N/A	N/A	N/A	N/A
	X		Х			1	N/A			N/A
350RG-3, CALCS BY SSE	X			Х						
	X									
	X									
		x ⁴	<u> </u>	х		2				
	x									
	x									
	X									
	X									
	<u> </u>									
		X								

All rights reserved. No part of this work may be reproduced or copied in any form or by any means, graphic, electronic, or mechanical, including photocopying, recording, taping, or

S F R HITECTS ARC

5151 Shoreham Place, Suite 100 San Diego, Ca 92122

P: 619-299-3917 F: 619-299-5084 www.sfeirarch.com

TCMC PHARMACY **USP 800** UPGRADE

Tri-City Medical Center

4002 Vista Way Oceanside, California 92056			
OWNER:	TRI-CITY MEDICAL CENTER 4002 VISTA WAY OCEANSIDE, CALIFORNIA 92056		
ARCHITECT:	SFEIR ARCHITECTS 5151 SHOREHAM PLACE, SUITE 100 SAN DIEGO, CALIFORNIA 92122 TEL(619)299–3917 FAX(619)299–508		
MEP:	P2S ENGINEERING, INC. 9665 CHESAPEAKE DRIVE, SUITE 230 SAN DIEGO, CA 92123 TEL(619)618–2347		
STRUCTURAL:	SUN STRUCTURAL ENGINEERING 2091 LAS PALMAS DRIVE, SUITE D CARLSBAD, CA 92011 TEL(760)438–1188		
CENSED CENSED NIC CON MIC	AP		

	THE OF CALLOR	· · · · · · · · · · · · · · · · · · ·
	OSHPD COMMENTS	10-09-17
	DESIGN CHANGES	10-09-17
$\overline{3}$	OSHPD COMMENTS	12–11–17
	DESIGN CHANGES	12–11–17
\sum	OSHPD COMMENTS	5-15-18
$\overline{6}$	DESIGN CHANGES	~~~~~ ~~~~~~~~~~~~~~~~~~~~~~~~~~~~~~~
REV:	DESCRIPTION:	DATE:


OSHPD APPROVAL STAMP:

OSHPD #: S171641-37-00

SHEET TITLE: PROPOSED EQUIPMENT **FLOOR PLAN**

PROJECT TITLE: TCMC USP 800

PROJECT # 01667.00 DRAWN BY: JAR CHECKED B SCALE: 1/4" = 1'-0"07/31/17

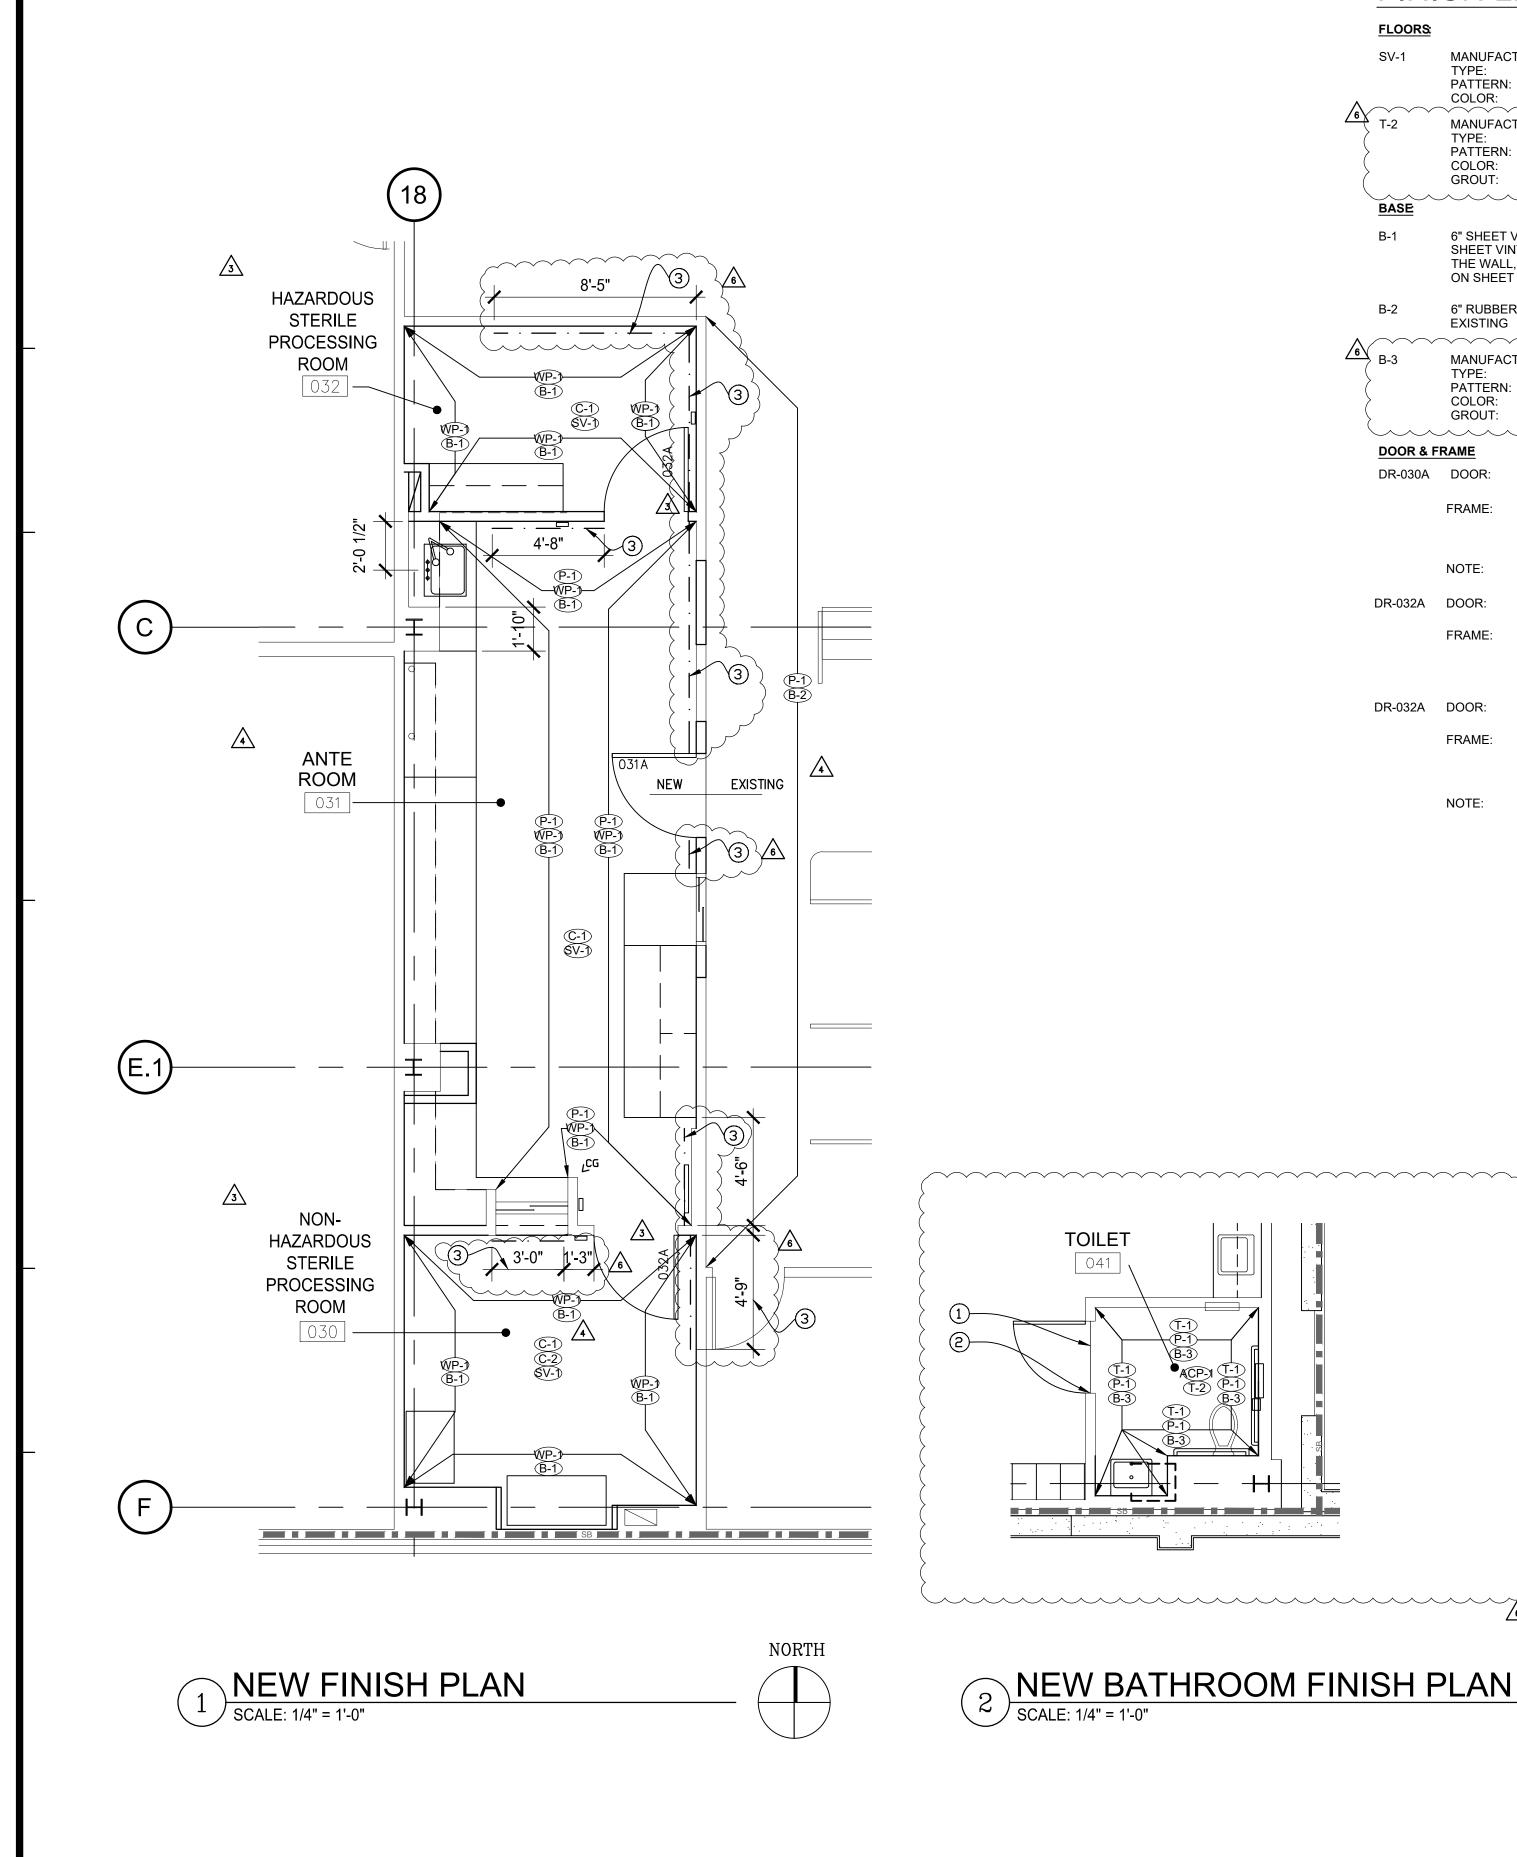

I.D. KEYNOTES:

REUSE EXISTING THRESHOLD. (1

(2) PRIME AND PAINT DOOR FRAME.

 $\sqrt{3}$


∕3∖

<u>/6</u>

3

\sim	$\sim\!\!\sim\!\!\sim\!\!\sim\!\!\sim\!\!\sim\!\!\sim\!\!\sim\!\!\sim\!\!\sim\!\!\sim\!\!\sim\!\!\sim\!\!$
3)	CRASH RAILS PER DETAIL 4/ID-2.
	\M/P_2

FLOORS:			WALL PR	OTECTION:	
SV-1	MANUFACTURE TYPE: PATTERN: COLOR:	R: MANNINGTON 6' WIDE ROLL BIOSPEC #15366 "GRASSLAND"	 WP-1	MANUFACTUREF TYPE: PATTERN: COLOR:	PEBBELETTE SUEDE TEXTURE #101 "FRENCH CREAM"
T-2	MANUFACTURE TYPE: PATTERN:	'KEYSTONES' PORCELAIN MOSAI 1"x1"	C WP-2		SEE ELEVATIONS FOR FULL HEIGHT APPLICATION R: ACROVYN
	COLOR: GROUT:	UPTOWN TAUPE D132 MAPEI 'CACAO'		TYPE: PATTERN: COLOR:	CRASH RAIL SUEDE TEXTURE #101 "FRENCH CREAM"
BASE B-1	6" SHEET VINYL SHEET VINYL AI			NOTE:	SEE PLAN AND ELEVATION FOR LOCATION. SEE DETAIL 4/ID-2.
	ON SHEET ID-2	ER TO DETAIL #1	T-1	MANUFACTUREF TYPE: PATTERN:	R: DALTILE 'SEMI-GLOSS' GLAZED CERA 4.25"x4.25", TO 48" A.F.F. MIN
B-2	6" RUBBER BAS EXISTING			COLOR: GROUT:	BULLNOSE TOP COURSE URBAN PUTTY 0161 MAPEI 'NAVAJO BROWN'
B-3	MANUFACTURE TYPE: PATTERN:	BUILD-UP BASE MB-4C / 1"x1", COVED BASE)	CEILINGS	<u>2</u>	
	COLOR: GROUT:	UPTOWN TAUPE D132 MAPEI 'CACAO'	C-1	GYPSUM BOARD SHERWIN WILLIA "ANTIQUE WHITE	MS SW 6119
DOOR & F	RAME	$\sqrt{3}$		GLOSS FINISH	-
DR-030A	DOOR:	PRIME AND PAINT MATCH FRAME	C-2	EXISTING GYPSL CEILING - REPAIR	NT
	FRAME:	PRIME AND PAINT SHERWIN WILLIAMS SW 7032 "WARM STRONG BEIGE"		SHERWIN WILLIA "ANTIQUE WHITE GLOSS FINISH	-
	NOTE:	REUSE EXISTING FRAME	ACP-1	MANUF: MATERIAL: STYLE:	USG ACOUSTICAL CEILING PANEL MATCH EXISTING
DR-032A	DOOR: FRAME:	PRIME AND PAINT MATCH FRAME PRIME AND PAINT		SIZE: GRID COLOR:	24"x24" WHITE
		SHERWIN WILLIAMS SW 7032 "WARM STRONG BEIGE"	CASEWO ALL EXPO	RK & OSED SURFACES:	
DR-032A	DOOR:	PRIME AND PAINT MATCH FRAME	ST STL	MANUFACTUREF COLOR:	R: STANLEY N/A
	FRAME:	PRIME AND PAINT SHERWIN WILLIAMS SW 7032 "WARM			
	NOTE	STRONG BEIGE"	COUNTER	RTOPS	
	NOTE:	REUSE EXISTING FRAME	ST STL	MANUFACTUREF COLOR:	R: STANLEY N/A
			WALLS:		
			P-1	MANUFACTUREF TYPE: COLOR:	R: ICI SEMI-GLOSS #8211 "SANDY LANE" 2
		PARTITIC	ON LEG	BEND:	
			ACCESSIE	BLE PATH OF TRAVE	EL.

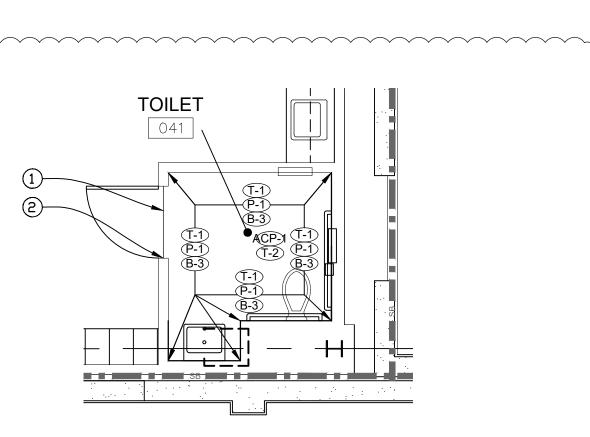

 $\sqrt{3}$

NEW BATHROOM FINISH PLAN

ONE-HOUR RATED CORRIDOR.

L	
	INDICATES AN EXISTING MEMBRANE OF PARTITION OR PARTITION TO BE REMOVED. REFER TO DEMOLITION PLAN FOR FURTHER REQUIREMENTS.
	INDICATES AN EXISTING PARTITION TO REMAIN. REFER TO PLAN FOR UPGRADE REQUIREMENTS.
SB SB SB SB	INDICATES AN EXISTING 1 HOUR SMOKE BARRIER
3 SP SP SP SP	INDICATES AN EXISTING 1 HOUR SMOKE PARTITION
FP FP FFF FFF FFF	INDICATES AN EXISTING ONE HOUR FIRE RATED PARTITION TO REMAIN. ALL PENETRATIONS SHALL BE PROTECTED WITH A UL-LISTED FIRE STOP SYSTEM.
FB FB FB FB FB	INDICATES AN EXISTING ONE HOUR RATED FIRE BARRIER TO REMAIN, ALL PENETRATIONS SHALL BE PROTECTED WITH A UL-LISTED FIRE STOP SYSTEM.
FB FB FB	INDICATES AN EXISTING TWO HOUR RATED FIRE BARRIER TO REMAIN, ALL PENETRATIONS SHALL BE PROTECTED WITH A UL-LISTED FIRE STOP SYSTEM.
SB SB SB SB SB	INDICATES A NEW 1 HOUR SMOKE BARRIER
SP SP SP SP SP SP	INDICATES A NEW 1 HOUR SMOKE PARTITION
	INDICATES A NEW ONE HOUR RATED FIRE PARTITION EXTENDING TO THE UNDERSIDE OF THE STRUCTURE ABOVE. ALL PENETRATIONS SHALL BE PROTECTED WITH A UL-LISTED FIRE STOP SYSTEM.
FB FB FF FF FF FF FF	INDICATES A NEW ONE HOUR RATED FIRE BARRIER EXTENDING TO THE UNDERSIDE OF THE STRUCTURE ABOVE. ALL PENETRATIONS SHALL BE PROTECTED WITH A UL-LISTED FIRE STOP SYSTEM.
	THICK LINE INDICATES NEW SURFACE FINISH.
	INDICATES AN EXISTING STRUCTURAL CONCRETE WALL TO REMAIN. LOCATE REINFORCING STEEL AND OBTAIN APPROVAL FROM STRUCTURAL ENGINEER PRIOR TO CORING AND/ OR CUTTING.
X WALL TY	PE REFERENCE REFER TO SHEET A5-10.
PARTITION NOTES:	

ALL DIMENSIONS SHOWN ARE TO FINISHED FACE OF GYP. BOARD, TYPICAL U.O.N. REFER TO SHEET A5-10 FOR GENERAL NOTES AND **REQUIREMENTS FOR PARTITIONS.**

EXISTING WALLS WERE CONSTRUCTED WITH MANY PERMITS AND/OR 2. CONTRACTS. FIELD VERIFY CONSTRUCTION AND WIDTH PRIOR TO FABRICATION OF DOOR FRAMES OR COMPONENTS WHICH REQUIRE THE WIDTH OF WALL TO BE SET.

GENERAL NOTES:

THE GENERAL CONTRACTOR SHALL VERIFY ALL EXISTING CONDITIONS AND MEASUREMENTS IN THE FIELD PRIOR TO STARTING CONSTRUCTION. REFER TO GENERAL NOTES ON SHEET A0-00 FOR INFORMATION NOT INDICATED ON THIS SHEET.

FINISH PLAN GENERAL NOTES:

- PATCH AND REPAIR FINISHES IN LIKE KIND WHERE AFFECTED BY NEW CONSTRUCTION ON EXISTING BUILDING FINISHES.
- 2. ALL WINDOW COVERING TO BE CENTERED ON STOREFRONT AND INTALL PER MANUFACTURER'S REQUIREMENTS. REFER TO ENLARGE FLOOR PLANS FOR CORNER GUARDS, 3.
- CRASH RAIL AND CHAIRD RAIL LOCATONS.
- 4. REFER TO INTERIOR ELEVATIONS AND SHEET A5-80 FOR ALL CASEWORK FINISHES.
- 5. CONTRACTOR SHALL SUBMIT SIX (6) COPIES OF MANUFACTURER'S SPECIFICATIONS AND INSTALLATION INSTRUCTIONS FOR ALL FLOORING, CEMENT LEVELING AND PATCHING MATERIALS. PERFORM STRICTLY IN ACCORDANCE WITH MANUFACTURER'S SPECIFICATIONS. PROVIDE MAINTENANCE INFORMATION TO THE FACILITIES MAINTENANCE DEPARTMENT.
- PATCH AND REPAIR EXISTING SUB FLOOR SLAB AS REQUIRED 6. TO PROVIDE A SMOOTH SURFACE FOR NEW FLOORING PER MANUFACTURER'S INSTALLATION REQUIREMENTS. PROVIDE SELF-LEVELING UNDERLAYMENT CONCRETE.
- 7. FLOORING PREPARATION SHALL BE PERFORMED AS REQUIRED BY THE FLOOR FINISH MANUFACTURER IN A MANNER SUCH THAT THE MANUFACTURER'S PRODUCT WARRANTY WILL REMAIN IN EFFECT. IF FIELD CONDITIONS REQURIE VARIATIONS FROM MANUFACTURER'S REQUIREMENTS. THE CONTRACTOR SHALL NOTIFY THE FACILITIES MANAGER IN WRITING TO RECEIVE INSTRUCTIONS ON HOW TO PROCEED.
- 8. ALL ADHESIVES FOR FINISH MATERIALS SHALL HAVE LOW VOC EMISSIONS. CONTRACTOR SHALL PROVIDE DIRECT VENTILATION TO PREVENT VOC'S OUT GASSING FROM ADHESIVES FROM ENTERING THE BUILDING HVAC SYSTEM AND AFFECTING THE OCCUPANTS OF THE BUILDING.
- CONTRACTOR TO PROVIDE TRANSITIONS BETWEEN FLOORING MATERIALS PER DETAILS ON SHEET ID-2. ALL TRANSITIONS LOCATED UNDER DOORS, TO BE CENTERED UNDER DOOR.
- DOOR SWING: CONTRACTOR SHALL INSTALL ALL NEW FLOORING SUCH THAT IT DOES NOT INTERFERE WITH EXISTING DOORS AND SUCH A WAY THAT EXISTING DOORS DO NOT TOUCH THE SURFACE OF NEW FLOORING. ANY PROBLEMATIC DOORS SHALL BE BROUGHT TO THE ATTENTION FO THE FACILITIES CONSTRUCTION REPRESENTATIVE PRIOR TO FLOORING PREPARATION.
- 10. PERFORM CALCIUM CHLORIDE TEST FOR ALL SLAB SUBFLOORS WHERE SLAB IS NEW, OR ALL EXISTING SLAB ON GRADE LOCATIONS. WHERE EXISTING SLAB IS ABOVE GRADE, CONTRACTOR MAY LIMIT TESTING TO AREAS NEAR A SOURCE OF WATER SUCH AS AROUND PLUMBING LINES, SHOWER STALLS, ROOF DRAINS, ETC. WHERE MOISTURE IN THE SLAB EXCEEDS FINISH MATERIAL'S MANUFACTURER'S RECOMMENDATIONS, REFER TO NOTES ABOVE FOR MANUFACTURER'S WARRANTY 11.
- REQUIREMENTS. 12. CONTRACTOR TO INCLUDE ALLOWANCE FOR CONCRETE SLAB SEALER TO BE FURNISHED AND APPLIED UNDER ALL FLOOR
- FINISHES ON SLAB ON GRADE. 13. CONTRACTOR SHALL VERIFY LEAD TIMES FOR ALL FINISH MATERIALS AND SHALL BE RESPONSIBLE TO HAVE ALL MATERIALS ON THE JOB SITE ON TIME. NO SUBSTITUTIONS
- SHALL BE MADE DUE TO LATE ORDERING OF MATERIALS. 14. CONTINUE ALL FLOOR FINISHES UNDER ALL APPLIANCES AND REMOVABLE CABINETS AND EQUIPMENT.

PAINT AND WALL FINISHES:

- 15. PAINT FINISHES (SHEEN) AS FOLLOWS: WALLS: EGGSHELL SHEEN EXCEPTIONS SIMI GLOSS SHEEN AT: TOILETS PUBLIC AND LABS, FOOD SERVICE AREAS, TRASH AND UTILITY ROOMS. PAINTED DOORS & FRAMES: SEMI GLOSS CEILING AND SOFFITS: FLAT
 - NOTE: REFER TO INTERIOR ELEVATIONS WHERE FOR LOCATIONS WHERE EPOXY PAINT IS REQUIRED.
- 16. SUBMIT ALL FINISH SAMPLES TO ARCHITECT FOR APPROVAL, INCLUDING DRAW DOWNS OF ALL PAINT COLORS IN ALL FINISH TYPES AS USED.
- 17. PAINT ALL ACCESS PANELS TO MATCH ADJ. WALL SURFACE.
- 18. PLASTER FINISH SHALL BE LEVEL FOR WHERE A PAINTED FINISH SURFACE IS SHOWN.

RESILIENT FLOORING:

- 19. ALL RESILIENT FLOORING INSTALLATIONS SHALL BE COMPLETED TO THE POINT READY FOR THE FIRST DAY OF USE AND IN AS NEW CONDITION, CLEAN CONSTRUCTION DUST AND DERBY, DAMP MOP AND APPLY A SEALER OR WAXED PER MANUFACTURER'S RECOMMENDATIONS FOR THE PRODUCT. FLOORING CONTRACTOR TO PROVIDE THE PRODUCT SPECIFICATION AND A RECOMMENDED REAPPLICATION TIME FOR THE SEALER OR WAX TO THE FACILITIES MAINTENANCE OFFICE.
- 20. ALL SHEET GOODS OF RESILIENT FLOORING SHALL BE INSTALLED USING HEAT WELD SEAMS, WELDING RODS SHALL MATCH THE COLOR OF THE FLOORING MATERIAL UNLESS OTHERWISE NOTED ON THE FINISH PLAN OR LEGEND.

CASEWORK AND MILL WORK:

- 21. ALL CASEWORK AND MILL WORK TO CONFORM TO THE REQUIREMENTS OF THE LATEST EDITION OF W.I.C. FOR CUSTOM GRADE.
- 22. NOT USED.

23. SHOP DRAWINGS SHALL BE SUBMITTED FOR ALL CASEWORK AND MILL WORK.

FLAME SPREAD:

All rights reserved. No part of this work may be reproduced or copied in any form or by any means, graphic, electronic, or mechanical, including photocopying, recording, taping, or information and retrieval systems without written permission of the ARCH

24. FLAME SPREAD OF FINISH MATERIALS: WALL, FLOOR AND CEILING SHALL NOT EXCEED THE FLAME SPREAD CLASSIFICATIONS IN CBC TABLE 803.5

S R A R C H I T E C T S

5151 Shoreham Place, Suite 100 San Diego, Ca 92122

P: 619-299-3917 F: 619-299-5084 www.sfeirarch.com

TCMC PHARMACY USP 800 UPGRADE

Tri-City Medical Center

	e, California 92056	
OWNER:	TRI-CITY MEDICAL CENTER 4002 VISTA WAY OCEANSIDE, CALIFORNIA 920)56
ARCHITECT:	SFEIR ARCHITECTS 5151 SHOREHAM PLACE, SU SAN DIEGO, CALIFORNIA 921 TEL(619)299–3917 FAX(619	22
MEP:	P2S ENGINEERING, INC. 9665 CHESAPEAKE DRIVE, S SAN DIEGO, CA 92123 TEL(619)618–2347	SUITE 230
STRUCTURAL:	SUN STRUCTURAL ENGINEER 2091 LAS PALMAS DRIVE, S CARLSBAD, CA 92011 TEL(760)438–1188	
No. C	28543 7	
No. C	CALFORNIT	
No. C	CALFORNIT CALFORNIT COMMENTS	<u>10–09–17</u> <u>10–09–17</u> 10–09–17
No. C No. C No. C No. C C No. C OF OF OF OF OF	CALFORNIT	
No. C No. C No. C No. C C No. C OF OF OF OSHPD DESIGN OSHPD	CALFORNER CALFORNER CHANGES	10-09-17 12-11-17 12-11-17
No. C No. C No. C No. C No. C No. C OF OF OF OF OF OF OF OF OF OF	CALIFORMENTS CHANGES COMMENTS CHANGES COMMENTS CHANGES	10-09-1 12-11-17 12-11-17 5-15-18
No. C No. C No. C No. C C No. C OF OF OF OF OF OF OF OF OF OF	CALIFORMENTS CHANGES COMMENTS CHANGES COMMENTS CHANGES	10-09-11 12-11-17 12-11-17 5-15-18
No. C No. C No. C No. C No. C OF OF OF OF OF OF OF OF OSHPD OSHPD OSHPD OSHPD OSHPD OSHPD OSHPD OSHPD	CALLOTIT CALLOTIT CALLOTIT CHANGES COMMENTS CHANGES COMMENTS	10-09-1 12-11-17 12-11-17 5-15-18

CONSULTANT

OSHPD APPROVAL STAMP: OSHPD #: S171641-37-00

SHEET TITLE:

4

NEW FINISHES PLAN

PROJECT TITLE: TCMC USP 800

CHECKED

DATE:


PROJECT #: 01667.00

DRAWN BY:



100% CONSTRUCTION DOCUMENT

07/31/17

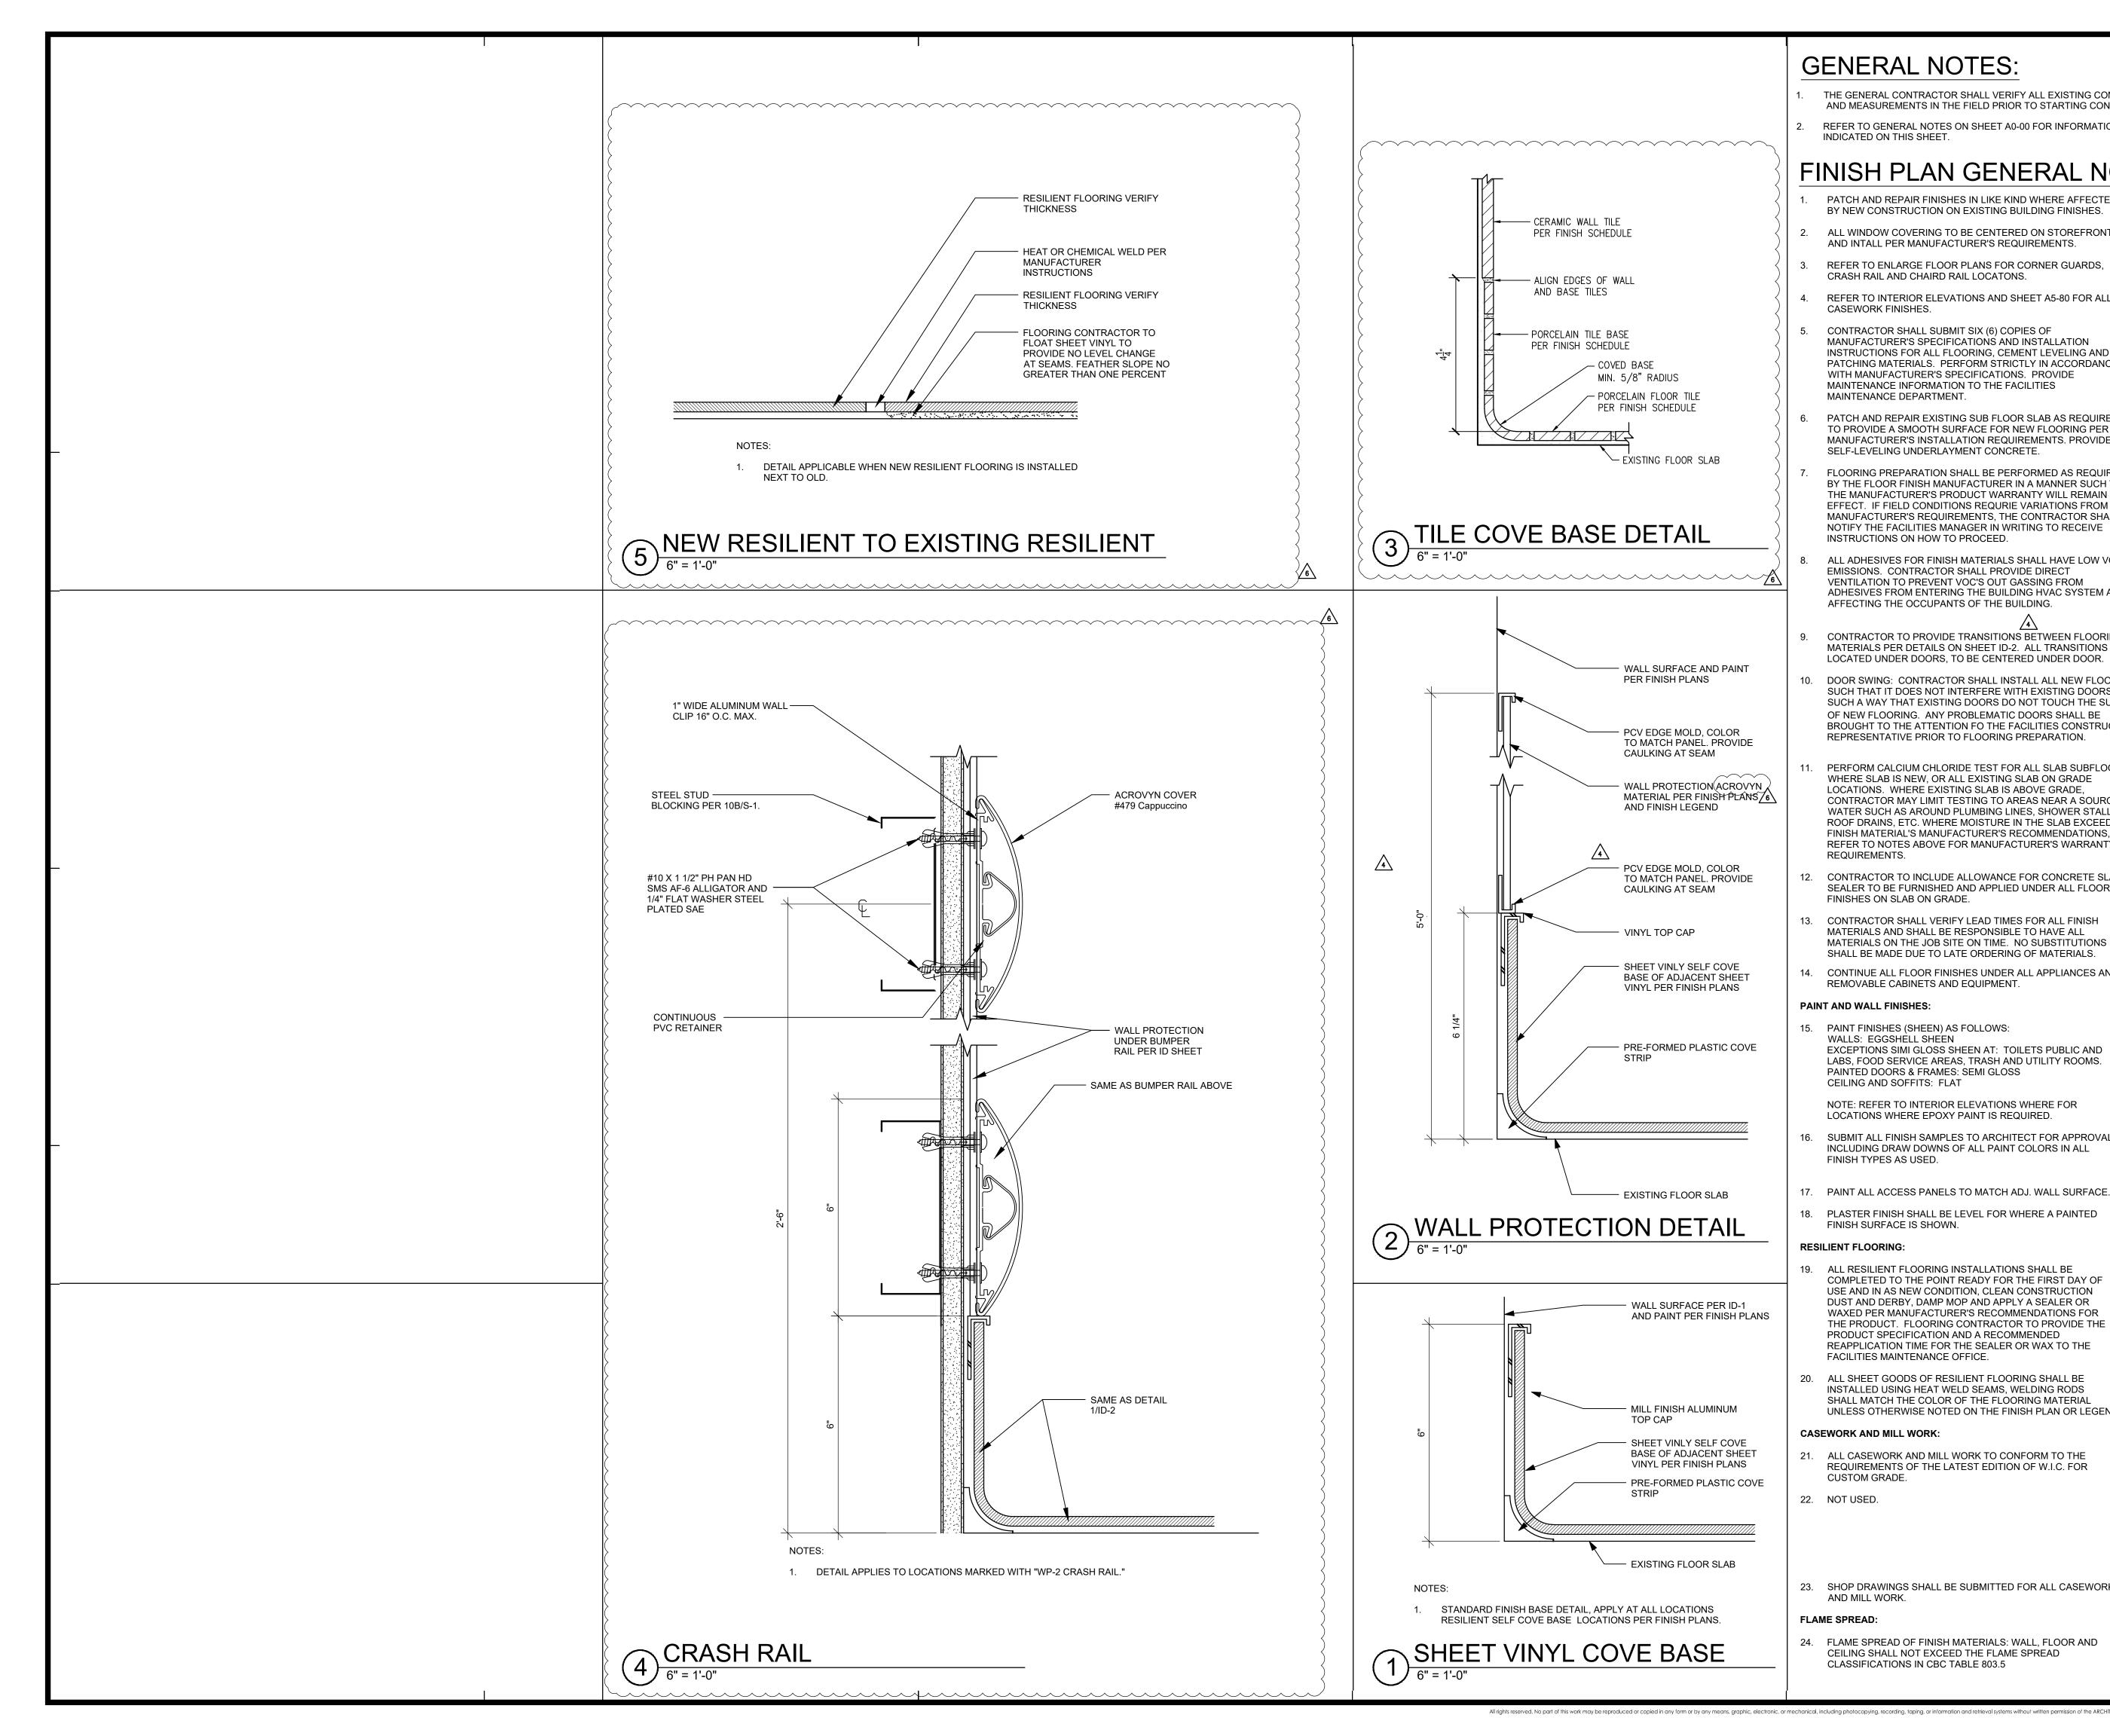

GENERAL NOTES:

THE GENERAL CONTRACTOR SHALL VERIFY ALL EXISTING CONDITIONS AND MEASUREMENTS IN THE FIELD PRIOR TO STARTING CONSTRUCTION. REFER TO GENERAL NOTES ON SHEET A0-00 FOR INFORMATION NOT INDICATED ON THIS SHEET.

FINISH PLAN GENERAL NOTES:

- PATCH AND REPAIR FINISHES IN LIKE KIND WHERE AFFECTED BY NEW CONSTRUCTION ON EXISTING BUILDING FINISHES.
- 2. ALL WINDOW COVERING TO BE CENTERED ON STOREFRONT AND INTALL PER MANUFACTURER'S REQUIREMENTS.
- REFER TO ENLARGE FLOOR PLANS FOR CORNER GUARDS, CRASH RAIL AND CHAIRD RAIL LOCATONS.
- 4. REFER TO INTERIOR ELEVATIONS AND SHEET A5-80 FOR ALL CASEWORK FINISHES.
- CONTRACTOR SHALL SUBMIT SIX (6) COPIES OF MANUFACTURER'S SPECIFICATIONS AND INSTALLATION INSTRUCTIONS FOR ALL FLOORING, CEMENT LEVELING AND PATCHING MATERIALS. PERFORM STRICTLY IN ACCORDANCE WITH MANUFACTURER'S SPECIFICATIONS. PROVIDE MAINTENANCE INFORMATION TO THE FACILITIES MAINTENANCE DEPARTMENT.
- PATCH AND REPAIR EXISTING SUB FLOOR SLAB AS REQUIRED TO PROVIDE A SMOOTH SURFACE FOR NEW FLOORING PER MANUFACTURER'S INSTALLATION REQUIREMENTS. PROVIDE SELF-LEVELING UNDERLAYMENT CONCRETE.
- FLOORING PREPARATION SHALL BE PERFORMED AS REQUIRED BY THE FLOOR FINISH MANUFACTURER IN A MANNER SUCH THAT THE MANUFACTURER'S PRODUCT WARRANTY WILL REMAIN IN EFFECT. IF FIELD CONDITIONS REQURIE VARIATIONS FROM MANUFACTURER'S REQUIREMENTS, THE CONTRACTOR SHALL NOTIFY THE FACILITIES MANAGER IN WRITING TO RECEIVE INSTRUCTIONS ON HOW TO PROCEED.
- ALL ADHESIVES FOR FINISH MATERIALS SHALL HAVE LOW VOC EMISSIONS. CONTRACTOR SHALL PROVIDE DIRECT VENTILATION TO PREVENT VOC'S OUT GASSING FROM ADHESIVES FROM ENTERING THE BUILDING HVAC SYSTEM AND AFFECTING THE OCCUPANTS OF THE BUILDING.
- 9. CONTRACTOR TO PROVIDE TRANSITIONS BETWEEN FLOORING MATERIALS PER DETAILS ON SHEET ID-2. ALL TRANSITIONS LOCATED UNDER DOORS, TO BE CENTERED UNDER DOOR.
- 10. DOOR SWING: CONTRACTOR SHALL INSTALL ALL NEW FLOORING SUCH THAT IT DOES NOT INTERFERE WITH EXISTING DOORS AND SUCH A WAY THAT EXISTING DOORS DO NOT TOUCH THE SURFACE OF NEW FLOORING. ANY PROBLEMATIC DOORS SHALL BE BROUGHT TO THE ATTENTION FO THE FACILITIES CONSTRUCTION REPRESENTATIVE PRIOR TO FLOORING PREPARATION.
- 11. PERFORM CALCIUM CHLORIDE TEST FOR ALL SLAB SUBFLOORS WHERE SLAB IS NEW. OR ALL EXISTING SLAB ON GRADE LOCATIONS. WHERE EXISTING SLAB IS ABOVE GRADE, CONTRACTOR MAY LIMIT TESTING TO AREAS NEAR A SOURCE OF WATER SUCH AS AROUND PLUMBING LINES. SHOWER STALLS. ROOF DRAINS, ETC. WHERE MOISTURE IN THE SLAB EXCEEDS FINISH MATERIAL'S MANUFACTURER'S RECOMMENDATIONS. REFER TO NOTES ABOVE FOR MANUFACTURER'S WARRANTY REQUIREMENTS.
- 12. CONTRACTOR TO INCLUDE ALLOWANCE FOR CONCRETE SLAB SEALER TO BE FURNISHED AND APPLIED UNDER ALL FLOOR FINISHES ON SLAB ON GRADE.
- 13. CONTRACTOR SHALL VERIFY LEAD TIMES FOR ALL FINISH MATERIALS AND SHALL BE RESPONSIBLE TO HAVE ALL MATERIALS ON THE JOB SITE ON TIME. NO SUBSTITUTIONS SHALL BE MADE DUE TO LATE ORDERING OF MATERIALS.
- 14. CONTINUE ALL FLOOR FINISHES UNDER ALL APPLIANCES AND REMOVABLE CABINETS AND EQUIPMENT.

PAINT AND WALL FINISHES:

- 15. PAINT FINISHES (SHEEN) AS FOLLOWS: WALLS: EGGSHELL SHEEN EXCEPTIONS SIMI GLOSS SHEEN AT: TOILETS PUBLIC AND LABS, FOOD SERVICE AREAS, TRASH AND UTILITY ROOMS. PAINTED DOORS & FRAMES: SEMI GLOSS CEILING AND SOFFITS: FLAT
- NOTE: REFER TO INTERIOR ELEVATIONS WHERE FOR LOCATIONS WHERE EPOXY PAINT IS REQUIRED.
- 16. SUBMIT ALL FINISH SAMPLES TO ARCHITECT FOR APPROVAL, INCLUDING DRAW DOWNS OF ALL PAINT COLORS IN ALL FINISH TYPES AS USED.
- 17. PAINT ALL ACCESS PANELS TO MATCH ADJ. WALL SURFACE.
- 18. PLASTER FINISH SHALL BE LEVEL FOR WHERE A PAINTED FINISH SURFACE IS SHOWN.

RESILIENT FLOORING:

- 19. ALL RESILIENT FLOORING INSTALLATIONS SHALL BE COMPLETED TO THE POINT READY FOR THE FIRST DAY OF USE AND IN AS NEW CONDITION, CLEAN CONSTRUCTION DUST AND DERBY, DAMP MOP AND APPLY A SEALER OR WAXED PER MANUFACTURER'S RECOMMENDATIONS FOR THE PRODUCT. FLOORING CONTRACTOR TO PROVIDE THE PRODUCT SPECIFICATION AND A RECOMMENDED REAPPLICATION TIME FOR THE SEALER OR WAX TO THE FACILITIES MAINTENANCE OFFICE.
- 20. ALL SHEET GOODS OF RESILIENT FLOORING SHALL BE INSTALLED USING HEAT WELD SEAMS, WELDING RODS SHALL MATCH THE COLOR OF THE FLOORING MATERIAL UNLESS OTHERWISE NOTED ON THE FINISH PLAN OR LEGEND.

CASEWORK AND MILL WORK:

- 21. ALL CASEWORK AND MILL WORK TO CONFORM TO THE REQUIREMENTS OF THE LATEST EDITION OF W.I.C. FOR CUSTOM GRADE.
- 22. NOT USED.
- 23. SHOP DRAWINGS SHALL BE SUBMITTED FOR ALL CASEWORK AND MILL WORK.

FLAME SPREAD:

24. FLAME SPREAD OF FINISH MATERIALS: WALL, FLOOR AND CEILING SHALL NOT EXCEED THE FLAME SPREAD CLASSIFICATIONS IN CBC TABLE 803.5

S ARCHITECTS

5151 Shoreham Place, Suite 100 San Diego, Ca 92122

P: 619-299-3917 F: 619-299-5084 www.sfeirarch.com

TCMC PHARMACY USP 800 UPGRADE

Tri-City Medical Center

OWNER:	TRI-CITY MEDICAL CEN 4002 VISTA WAY OCEANSIDE, CALIFORNIA	
ARCHITEC	T: SFEIR ARCHITECTS 5151 SHOREHAM PLACE SAN DIEGO, CALIFORNIA TEL(619)299–3917 FA	92122
MEP:	P2S ENGINEERING, INC. 9665 CHESAPEAKE DRI SAN DIEGO, CA 92123 TEL(619)618–2347	VE, SUITE 230
STRUCTUF	RAL: SUN STRUCTURAL ENGI 2091 LAS PALMAS DRI ^N CARLSBAD, CA 92011 TEL(760)438–1188	
TO N	o. C 28543 元 ★	
S. A.	o. C 28543 ₹	· · · · · ·
SAVE	N. 1-31-19	<u>10–09–</u> 1
	N. 1-31-19 OF CALIFORNIE	10-09-1 10-09-1
	OF CALIFORNIES	
	OF CALIFORNIA OF CALIFORNIA SHPD COMMENTS ESIGN CHANGES	10-09-1
	OF CALIFORNITS SHPD COMMENTS ESIGN CHANGES SHPD COMMENTS	10-09- 12-11-1 12-11-1 5-15-11
	OF CALIFORNIA OF CALIFORNIA SHPD COMMENTS SIGN CHANGES SHPD COMMENTS SIGN CHANGES SHPD COMMENTS	10-09- 12-11-1 12-11-1 5-15-11
	OF CALIFORNIA OF CALIFORNIA SHPD COMMENTS SIGN CHANGES SHPD COMMENTS SIGN CHANGES SHPD COMMENTS	10-09- 12-11-1 12-11-1 5-15-11
	OF CALIFORNIA OF CALIFORNIA SHPD COMMENTS SIGN CHANGES SHPD COMMENTS SIGN CHANGES SHPD COMMENTS	10-09-

CONSULTANT

OSHPD APPROVAL STAMP: OSHPD #: S171641-37-00

SHEET TITLE: FINISHES, NOTES & DETAILS

PROJECT TITLE: TCMC USP 800

4

PROJECT #: 01667.00 DRAWN BY: CHECKED BY: SCALE: 1/4" = 1DATE: 07/31

.00		
AR		_
JS '-0"	ID-	-2
/17		OF

GENERAL NOTES

- 1. THE CONTRACTOR SHALL VERIFY ALL DIMENSIONS, ELEVATIONS, SITE CONDITIONS PRIOR TO STARTING CONSTRUCTION. THE ARCHITECT AND STRUCTURAL ENGINEER SHALL BE NOTIFIED OF ANY DISCREPANCIES OR INCONSISTENCIES.
- 2. THE ARCHITECT AND STRUCTURAL ENGINEER SHALL BE NOTIFIED OF ANY CONFLICTS OR OMISSIONS BETWEEN THE WORKING DRAWINGS OR SPECIFICATIONS BEFORE PROCEEDING ANY WORK SO AFFECTED. A CLARFICATION SHALL BE ISSUED FOR SUCH CONFLICTS. ANY WORK PERFORMED IN CONFLICT WITH THE CONTRACT DOCUMENTS OR ANY CODE REQUIREMENTS SHALL BE CORRECTED BY THE ARCHITECT AND STRUCTURAL ENGINEER
- 3. THE STRUCTURAL DRAWINGS AND SPECIFICATIONS FOR CONSTRUCTION REPRESENT THE FINISHED STRUCTURE. THEY DO NOT INDICATE THE METHOD OF CONSTRUCTION. THE CONTRACTOR SHALL PROVIDE ALL MEASURES NECESSARY TO PROTECT THE STRUCTURE DURING CONSTRUCTION. SUCH MEASURES INCLUDE, BUT NOT LIMITED TO, BRACING, SHORING, TO INSURE THE VERTICAL AND LATERAL STABILITY OF THE STRUCTURE. OBSERVATION VISITS TO THE SITE BY THE ARCHITECT AND STRUCTURAL ENGINEER SHAL NOT INCLUDE INSPECTION OF THE ABOVE ITEMS AND DOES NOT RELIEVE THE CONTRACTOR'S RESPONSIBILITIES.
- 4. THE CONTRACTOR SHALL BE SOLELY RESPONSIBLE FOR CONFORMING TO ALL LOCAL, STATE AND FEDERAL SAFETY AND HEALTH STANDARDS, LAWS AND REGULATIONS. THE ARCHITECT AND STRUCTURAL ENGINEER WILL NOT ENFORCE SAFETY MEASURES OR REGULATIONS.
- 5. NOTES AND DETAILS ON THE DRAWINGS SHALL TAKE PRECEDENCE OVER THE GENERAL NOTES AND TYPICAL DETAILS. DIMENSIONS SHALL TAKE PRECEDENCE OVER SCALES SHOWN ON THE DRAWINGS IN CASE OF CONFLICT.
- ALL WORKS SHALL CONFORM TO THE STANDARDS OF THE 2016 CALIFORNIA BUILDING CODE. 7. A.S.T.M. SPECIFICATIONS NOTED ON THE DRAWINGS SHALL BE OF THE LATEST
- 8. NO STRUCTURAL SUBSTITUTIONS OR CHANGES SHALL BE MADE IN THE FIELD. WRITTEN APPROVAL MUST BE OBTAINED FROM THE STRUCTURAL ENGINEER AND OSHPD FOR ANY SUBSTITUTIONS OR CHANGES FROM THE APPROVED CONSTRUCTION DOCUMENTS.
- 9. CONTRACTOR SHALL PROVIDE AND BE RESPONSIBLE FOR THE PROTECTION AND REPAIR OF ADJACENT EXISTING SURFACES AND AREAS WHICH MAY BE DAMAGED AS A RESULT OF NEW WORK.

EXPANSION ANCHOR BOLTS

3/8"ø HILTI KB TZ

EPOXY ANCHOR

1. ALL FIELD INSTALLED CONCRETE EXPANSION ANCHORS SHALL BE HILTI KB-TZ ANCHORS. ANCHOR TYPE ICC-ES ESR#

2. ALL ANCHORS SHALL BE TESTED BASED ON THE FOLLOWING CRITERIA:

ANCHOR TYPE TORQUE ICC-ES ESR# 3/8"Ø HILTI KB TZ ANCHOR 25 FT-LBS 1917

MINIMUM ANCHOR EMBEDMENT SHALL BE 2" FOR 3/8"Ø, (INSTALLED IN NORMAL WT. CONCRETE WITH fc' = 3000 PSI)

WHEN INSTALLING DRILLED-IN ANCHORS AND/OR POWDER DRIVEN PINS IN EXISTING NON-PRESTRESSED REINFORCED CONCRETE, USE CARE AND CAUTION TO AVOID CUTTING OR DAMAGING THE EXISTING REINFORCING BARS OR EMBEDED PIPES AND CONDUITS IN THE SLAB BY USING A NON DESTRUCTIVE METHOD PRIOR TO INSTALLATION WHEN INSTALLING THEM INTO PRESTRESSED CONCRETE (PRE OR POST TENSIONED) LOCATED THE PRESTRESSED TENDONS BY USING A NON DESTRUCTIVE METHOD PRIOR O INSTALLATION. EXERCISE EXTREME CARE AND CAUTION TO AVOID CUTTING OR DAMAGING THE TENDONS DURING INSTALLATION. MAINTAIN 1" MINIMUM CLEARANCE BETWEEN EXISTING REINFORCEMENT AND THE

1917

APPLY PROOF TEST LOADS TO EPOXY ANCHORS WITHOUT REMOVING THE NUT IF POSSIBLE. OTHERWISE, REMOVE THE NUT AND INSTALL A THREADED COUPLER UP TO THE SAME TIGHTNESS OF THE ORIGINAL NUT USING A TORQUE WRENCH AND APPLY THE LOAD.

TESTING SHOULD OCCUR A MINIMUM 24 HOURS AFTER INSTALLATION OF THE SUBJECTED ANCHORS. IF THE MANUFACTURER'S RECOMMENDED INSTALLATION TORQUE IS LESS THAN THE TEST TORQUE, THE MANUFACTURER'S RECOMMANDED INSTALLATION TORQUE SHOULD BE USED IN LIEU OF THE TEST TORQUE. ANCHOR DIAMETER REFERS TO THE THREAD SIZE.

REACTION LOADS FROM TEST FIXTURES MAY BE APPLIED CLOSE TO THE ANCHOR BEING TESTED. PROVIDE THE ANCHOR IS NOT RESTRAINED FROM WITHDRAWING BY THE FIXTURE.

TEST EQUIPMENT INCLUDING TORQUE WRENCHES SHALL BE CALIBRATED BY AN APPROVED TESTING LABORATORY IN ACCORDANCE WITH STANDARD RECOGNIZED PROCEDURES. TEST METHODS; THE FOLLOWING CRITERIA APPLY FOR THE ACCEPTANCE OF

INSTALLED ANCHORS: A). HYDRAULIC RAM METHOD: ANCHORS TESTED WITH A HYDRAULIC JACK OR SPRING LOADED DEVICES SHALL MAINTAN THE TEST LOAD FOR MINIMUM OF 15 SECONDS AND SHALL EXHIBIT NO DISCERNABLE MOVEMENT DURING THE TENSION TEST, e.g., AS EVIDENCED BY LOOSENING OF THE WASHER UNDER NUT.

B). TORQUE WRENCH METHOD: ANCHORS TESTED WITH A CALIBRATED TORQUE WRENCH MUST ATTAIN THE SPECIFIED TORQUE WITHIN $\frac{1}{2}$ TURN OF THE NUT. EXCEPTIONS:

1. WEDGDE OR SLEEVE TYPE: ONE-QUARTER (1) TURN OF THE NUT FOR A 3 IN. SLEEVE ANCHOR ONLY. 2. THREADED TYPE: ONE QUARTER (\ddagger) TURN OF THE SCREW AFTER INITIAL SEATING OF THE SCREW HEAD.

TESTING SHOULD OCCUR 24 HOURS MINIMUM AFTER INSTALLATION OF THE EPOXY ANCHOR.

MINIMUM OF 50% OF THE INSTALLED ANCHOR SHALL BE TESTED. (ALTERNATE ANCHORS IN ANY GROUP ARRANGEMENT) IF ANY ANCHOR FAILS TESTING, TEST ALL ANCHORS OF THE SAME TYPE, INSTALLED BY THE SAME TRADE, NOT PREVIOUSLY TESTED UNTIL TWENTY (20) CONSECUTIVE ANCHORS PASS, THEN RESUME THE INITIAL TEST FREQUENCY. TESTS SHALL BE PERFORMED PER CBC 2016, 1910A.5.

ALL TESTS SHALL BE PERFORMED IN THE PRESENCE OF THE INSPECTOR OF

COLD-FORMED STEEL FRAMING

- DESIGN, MANUFACTURE AND INSTALLATION OF LIGHT GAGE, COLD-FORMED STEEL JOISTS, PURLINS AND STUDS SHALL CONFORM WITH THE LATEST EDITION OF THE LIGHT GAGE, COLD-FORMED STEEL DESIGN MANUAL ISSUED BY THE AISI.
- STRUCTURAL LIGHT GAUGE STUDS, TRACK, BRIDGING, AND ACCESSORIES SHALL COMPLY WITH STEEL STUD MANUFACTURERS ASSOCIATION ICC ES ESR# 3064P STRUCTURAL LIGHT GAUGE CH STUDS, J RUNNER TRACK, AND ACCESSORIES SHALL COMPLY WITH DIETRICH
- METAL FRAMING ICC-ESR# 1166P ALL WELDING SHALL BE IN CONFORMANCE WITH AWS D1.3 "STRUCTURAL WELDING CODE – SHEET STEEL". QUALIFICATION OF WELDERS SHALL BE IN ACCORDANCE WITH AWS D1.1, CHAPTER 5, PART C, "WELDER QUALIFICATION". SEE LATEST EDITION OF THE AISI SPECIFICATIONS FOR THE "DESIGN OF COLD-FORMED STEEL STRUCTURAL MEMBERS" FOR ALLOWABLE WELD WALLES
- VALUES.
- FRAMING SHALL BE ERECTED PLUMB, LEVEL AND SQUARE. BRIDGING AND DIAGONAL TENSION STRAPS SHALL BE USED.
- TEMPORARY BRACING SHALL BE PROVIDED AS REQUIRED UNTIL ERECTION IS COMPLETE AND SAFELY SECURED TO STRUCTURE.
- 6. COLD-FORMED STEEL YIELD STRENGTH (fy) IS 33 KSI. IDENTIFICATION OF SSMA PRODUCTS

MEMBER DEPTH: $3.62'' = 362 \times 1/100$ INCHES ALL MEMBER DEPTHS ARE TAKEN IN 1/100 INCHES FOR ALL "T" SECTIONS MEMBER DEPTH IS THE

FLANGE WIDTH: $2" = 200 \times 1/100$ INCHES ALL FLANGE WIDTH ARE TAKEN IN 1/100 INCHES

MIN. BASE METAL THICKNESS

4

REPRESENTS 95% OF THE

DESIGN THICKNESS

INSIDE TO INSIDE DIMENTION

(362)(\$)(162) -(54) MATERIAL THICKNESS: 0.054" = 54 MILS (16 GA.) STYLE: MATERIAL THICKNESS IS THE

S = STUD OR JOIST SECTIONST = TRACK SECTIONS<u>EXAMPLE</u>

COLD-FORMED STEEL STUDS PROPERTIES

IDENTIFICATION	MEMBER DEPTH	FLANGE WIDTH	MATERIAL THICKNESS
362S162-43	3.62"	1.625"	18 GA.
362S162-54	3.62"	1.625"	16 GA.
362T125-43	3.62"	1.25"	18 GA.
400S162-43	4"	1.625"	18 GA.
600T125-54	6"	1.25"	16 GA.
250S125-54	2.5"	1.25"	16 GA.
250T125-54	2.5"	1.25"	16 GA.

STRUCTURAL STEEL:

STRUCTURAL STEEL SHALL COMPLY WITH THE FOLLOWING U.N.O.: STEEL CHANNELS AND ANGLES ASTM A36 STRUCTURAL TUBES A500, GRADE B STEEL PLATE ASTM A36 STEEL BOLT ASTM A307 ALL STEEL MEMBERS TO BE PRIME PAINTED.


SEISMIC LOAD


SITE LOCATION:

LONGITUDE: 117.29178° WEST, LATITUDE: 33.18425° NORTH DESIGN SPECTRAL RESPONSE ACCLERATION:

SEISMIC IMPORTANCE FACTOR, Ip = 1.5SEISMIC FORCE COEFFICIENTS: $a_p = 1.0, R_P = 2.5$ SEISMIC DESIGN CATEGORY "D"

S_{DS}= 0.760, S_{D1}= 0.435

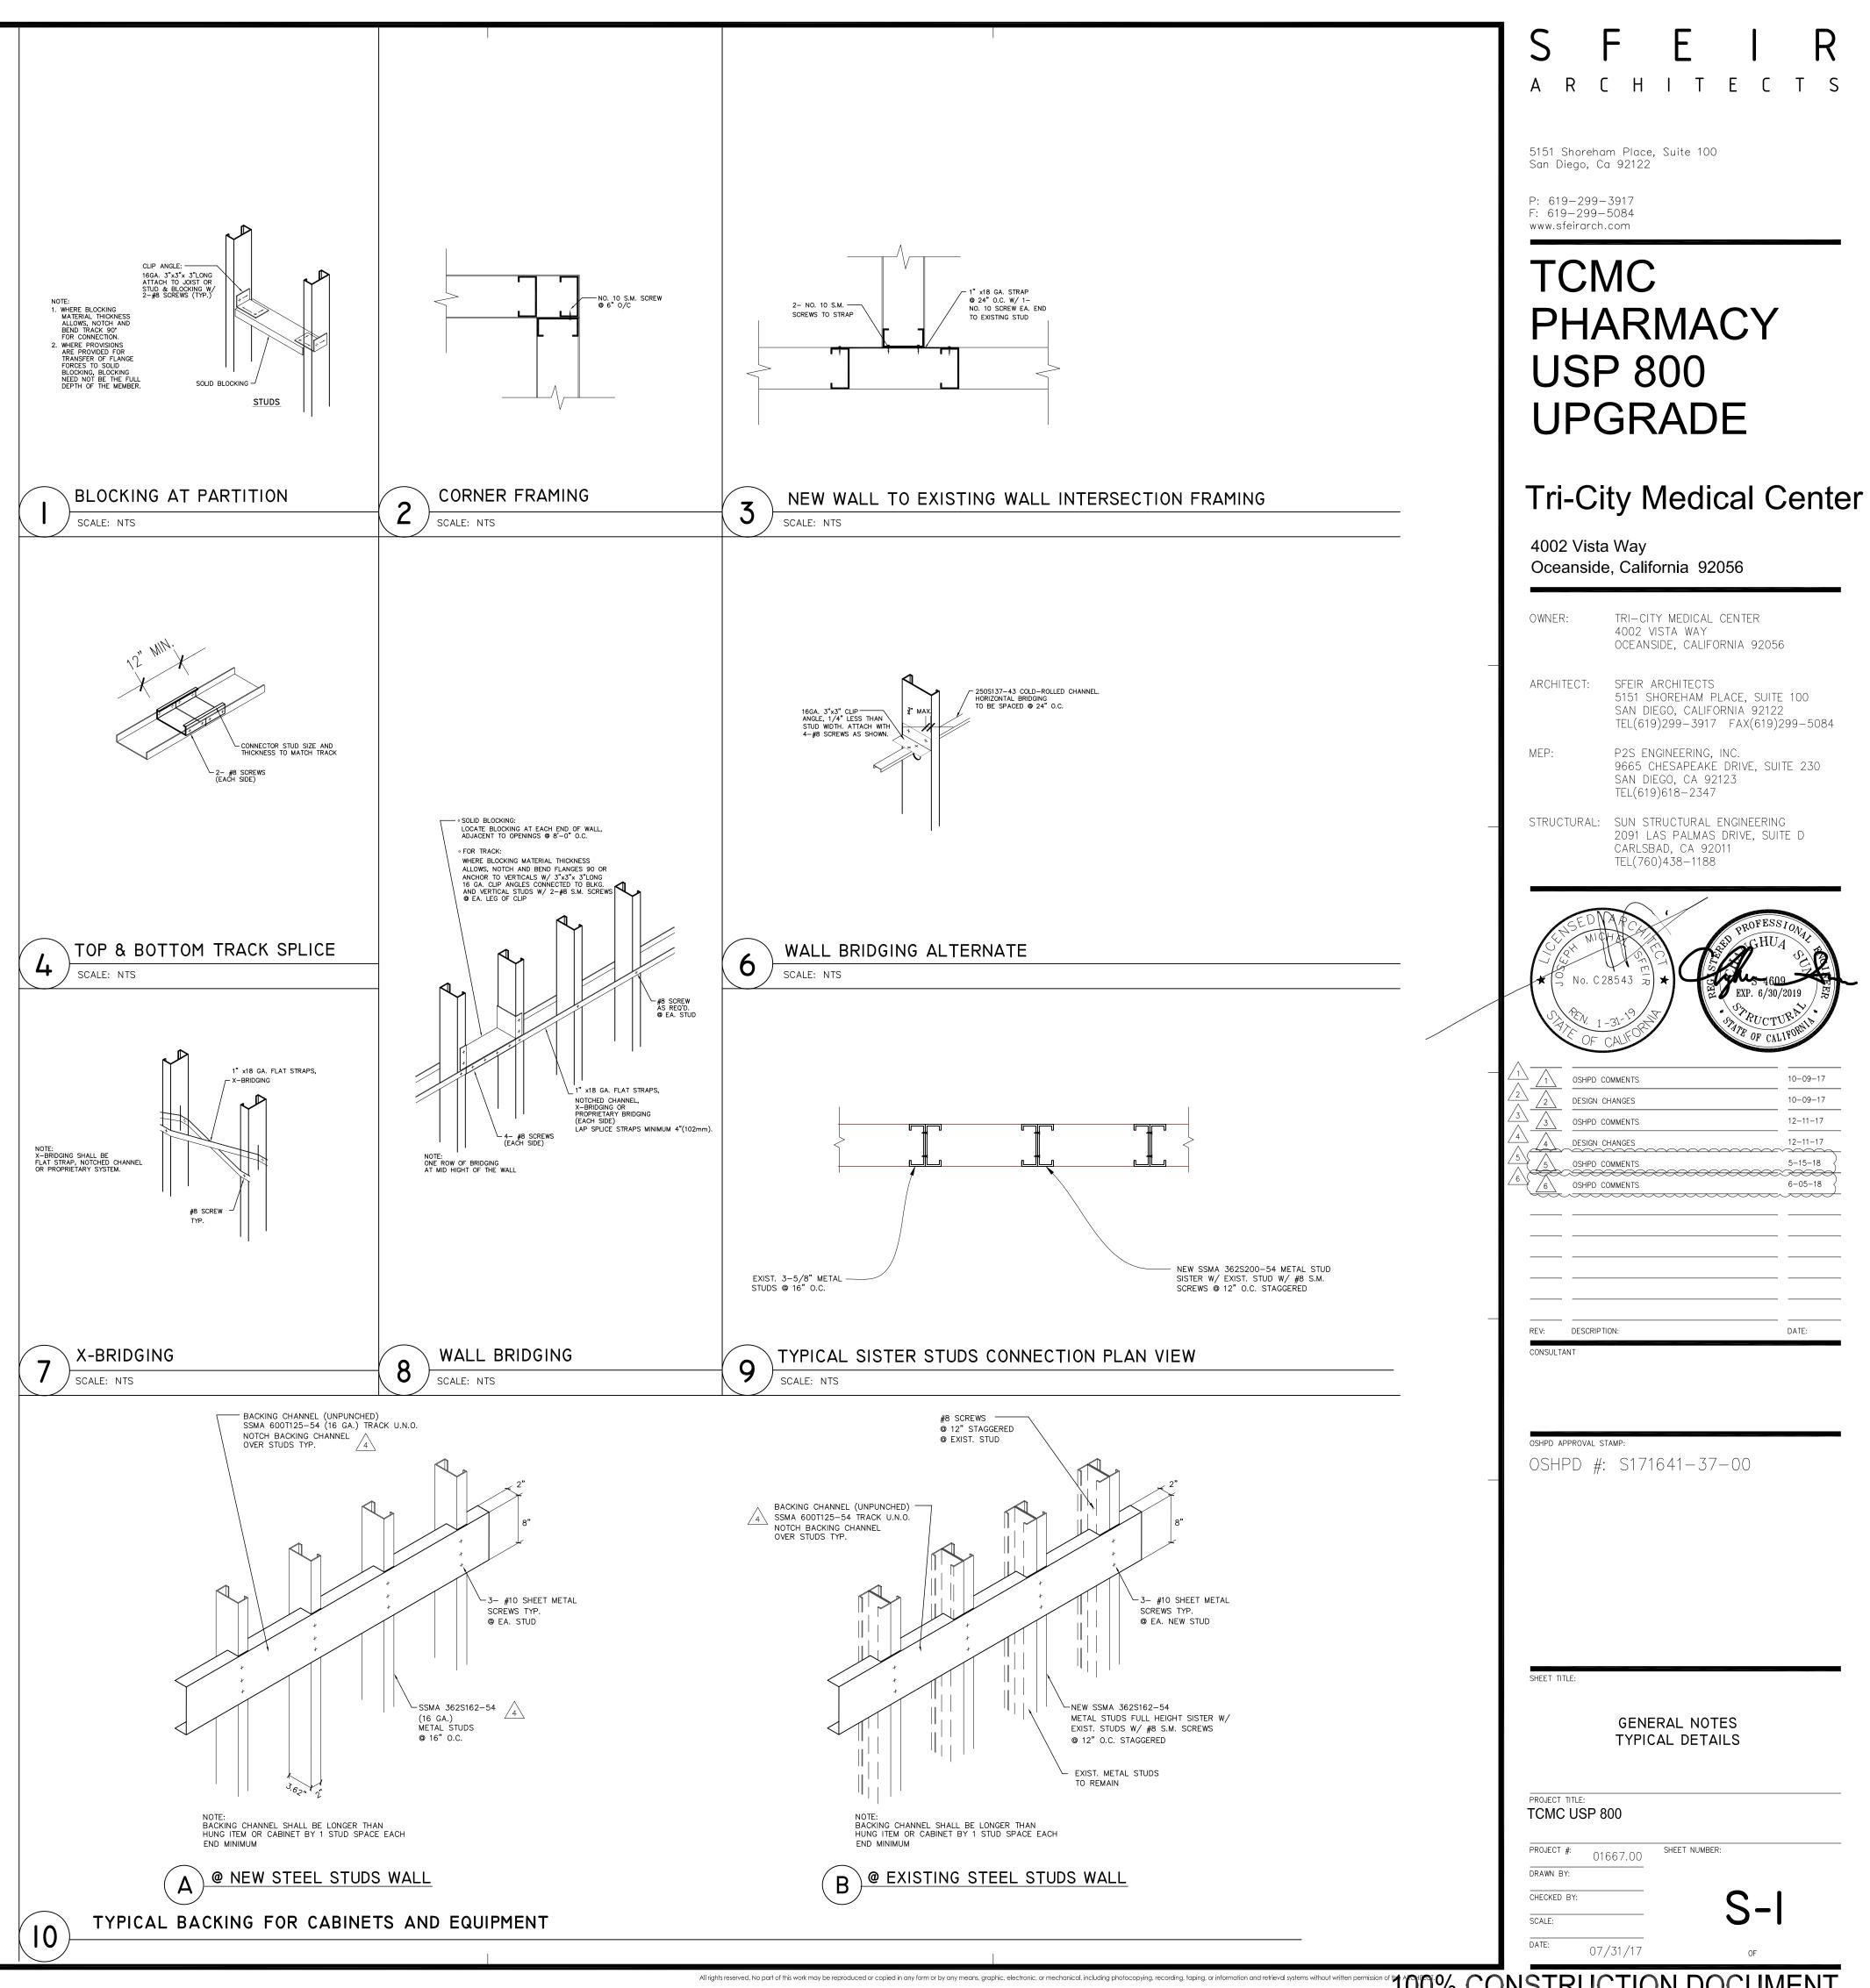

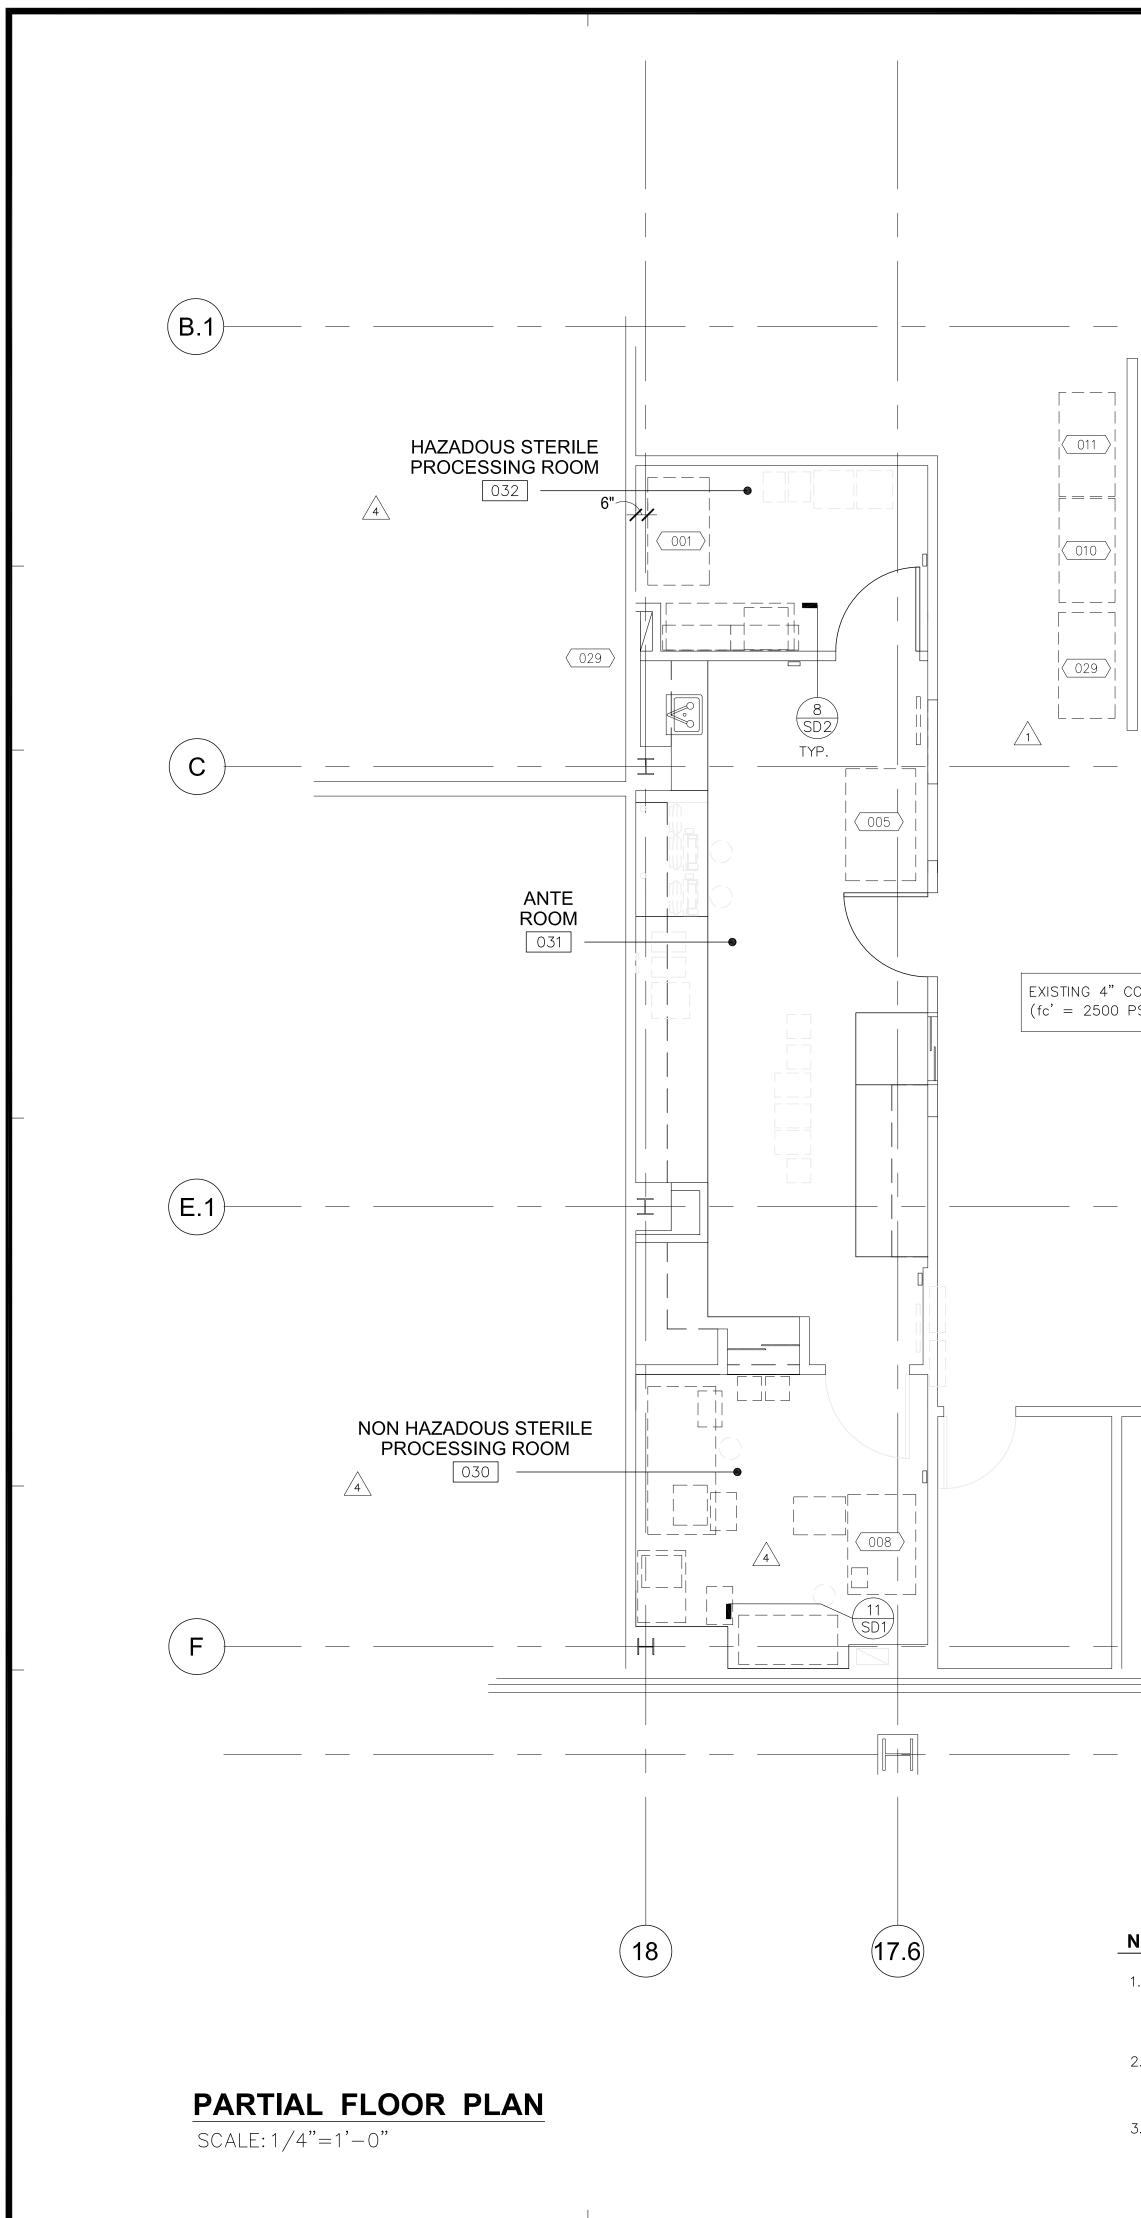

EQUIPMENT SCHEDULE

EQUIP #	DESCRIPTION	WEIGHT(APPROX.)	DETAIL
(001)	BSC WORKSTATION	800 LBS	1 2 SD1 2 SD1
(005)	PHARMACY REFRIGERATOR	1470 LBS	5 SD1
(008)	LAMINAR FLOW WORK BENCH	440 LBS	7 SD1 8 SD1
(009)	LAMINAR FLOW WORK STATION	680 LBS	9 SD1 (10 SD1
(010)	PYXIS SUPPLY-AUXILLARY	1000 LBS	11 SD3 (12 SD3
(011)	PYXIS SUPPLY-MAIN	1000 LBS	11 SD3 (12 SD3
	STAINLESS STEEL CABINET	1000 LBS	11 SD1 12 SD1
(029)	REFRIGERATOR	1654 LBS	3 SD1 4 SD1


EXISTING 4" CONC. SLAB ON GRADE (fc' = 2500 PSI) W/ #4 @ 16" O.C. EA. WAY


PARTIA

NOTES


- 1. DO NOT SCALE THESE DRAWINGS. PRIOR TO START OF CONSTRUCTION, ALL DIMENSIONS AND ELEVATIONS MUST BE VERIFIED WITH THE APPRD. SET OF ARCHITECHURAL DRAWINGS. IN CASE OF DISCREPENCIES, STRUCTURAL ENGINEER OF RECORD MUST BE NOTIFIED IN WRITING.
- 2. ALL EXISTING MEMBER SIZES, SPACING, & DIMENSIONS MUST BE FIELD VERIFIED. IN CASE OF DISCREPANCIES STRUCTURAL ENGINEER MUST BE NOTIFIED IN WRITING.
- 3. THE EXISTING FLOOR FRAMING PLAN IS BASED ON THE STATE DEPT. OF HEALTH FACH CONSTR. SECT. APPROVED STRUCTURAL DRAWING, APPROVAL# H0161


	SFEIR ARCHITECTS
	5151 Shoreham Place, Suite 100 San Diego, Ca 92122
	P: 619-299-3917 F: 619-299-5084 www.sfeirarch.com
	TCMC
	PHARMACY
	USP 800 UPGRADE
	Tri-City Medical Center
	Oceanside, California 92056
	OWNER: TRI-CITY MEDICAL CENTER 4002 VISTA WAY OCEANSIDE, CALIFORNIA 92056 —
	ARCHITECT: SFEIR ARCHITECTS 5151 SHOREHAM PLACE, SUITE 100 SAN DIEGO, CALIFORNIA 92122 TEL(619)299-3917 FAX(619)299-5084
	MEP: P2S ENGINEERING, INC. 9665 CHESAPEAKE DRIVE, SUITE 230 SAN DIEGO, CA 92123 TEL(619)618-2347
	STRUCTURAL: SUN STRUCTURAL ENGINEERING 2091 LAS PALMAS DRIVE, SUITE D CARLSBAD, CA 92011 TEL(760)438–1188
	No. C 28543 TO + CONTENDED
	No. C 28543 \overline{a} * \overline{b} EXP. 6/30/2019 \overline{b} \overline{b}
	$- \underbrace{\bigwedge_{2}}_{2} \underbrace{\bigwedge_{2}}_{2} \underbrace{\xrightarrow{1}}_{2} \underbrace{\xrightarrow{0 \text{SHPD COMMENTS}}}_{\text{DESIGN CHANGES}} \frac{10-09-17}{10-09-17}$
	$\begin{array}{c ccccccccccccccccccccccccccccccccccc$
8 SD3	6 0SHPD COMMENTS 6-05-18
	REV: DESCRIPTION: DATE:
	oshpd approval stamp: OSHPD #: S171641-37-00
AL PENTHOUSE ROOF PLAN	
SCALE: 1/4"=1'-0"	
	SHEET TITLE:
	PARTIAL FLOOR PLAN PARTIAL PENTHOUSE ROOF PLAN
	PROJECT TITLE: TCMC USP 800
	PROJECT #: 01667.00 SHEET NUMBER:
	CHECKED BY: SCALE: DATE: 07/31/17 OF

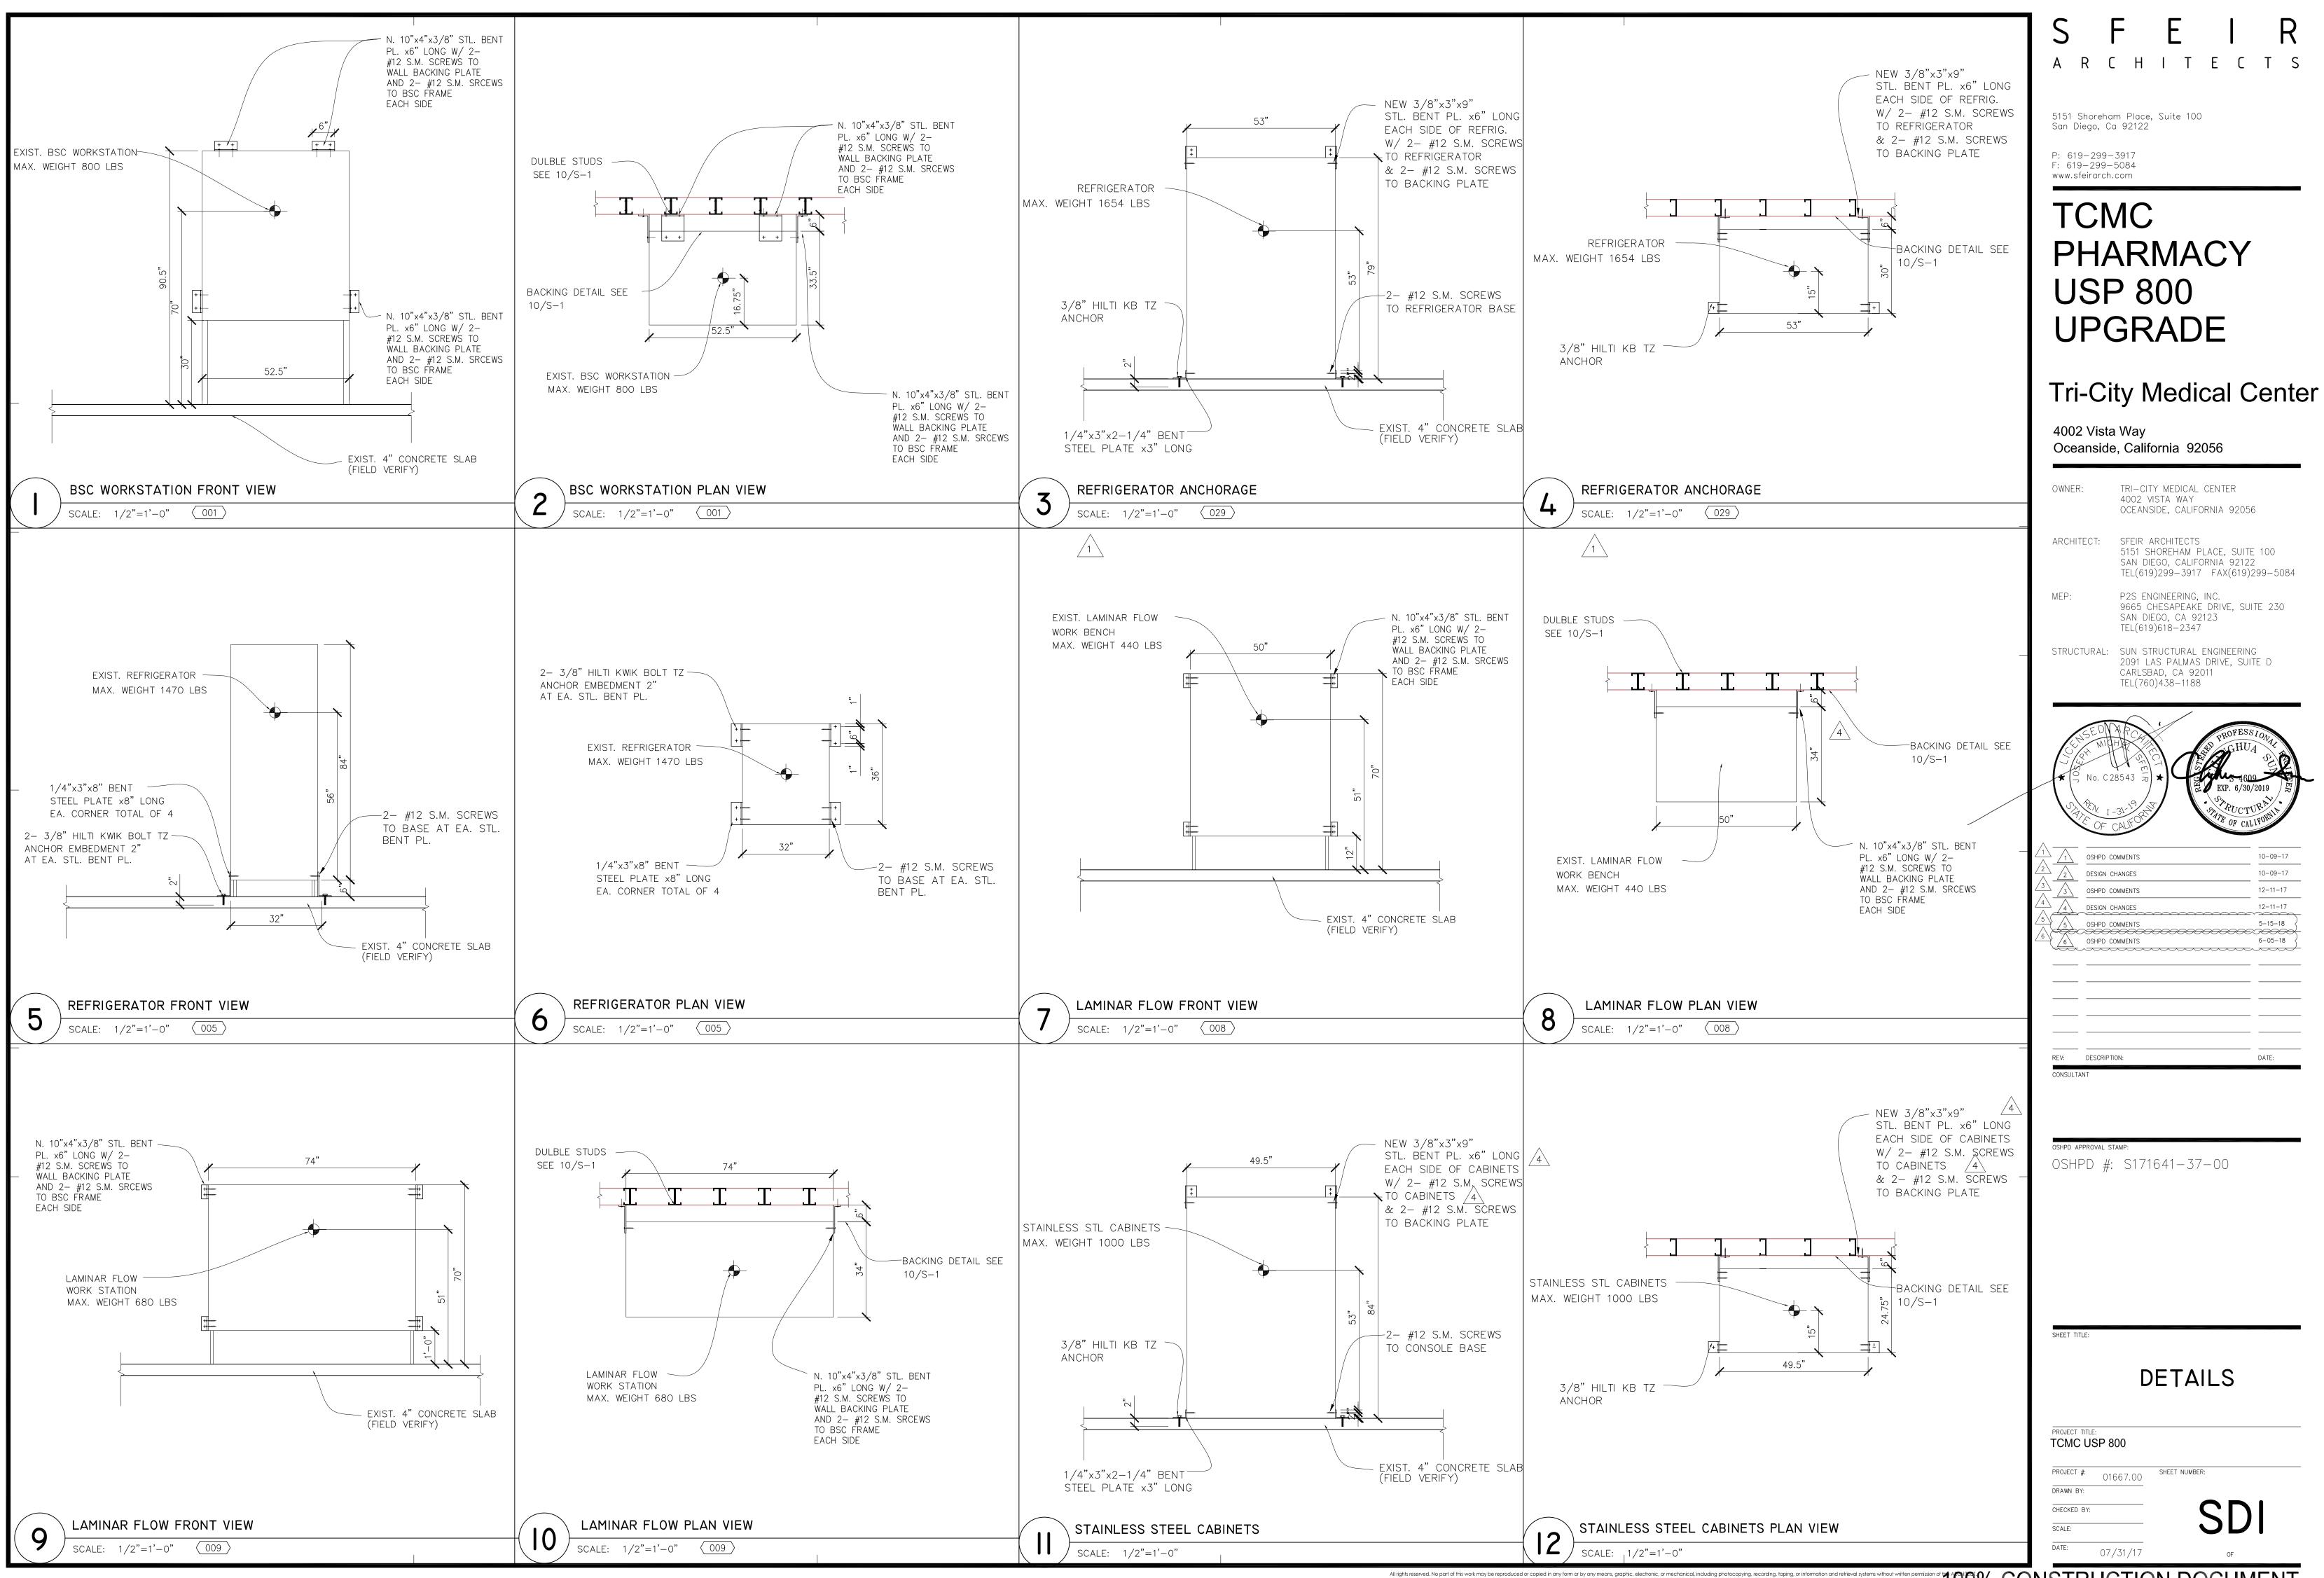

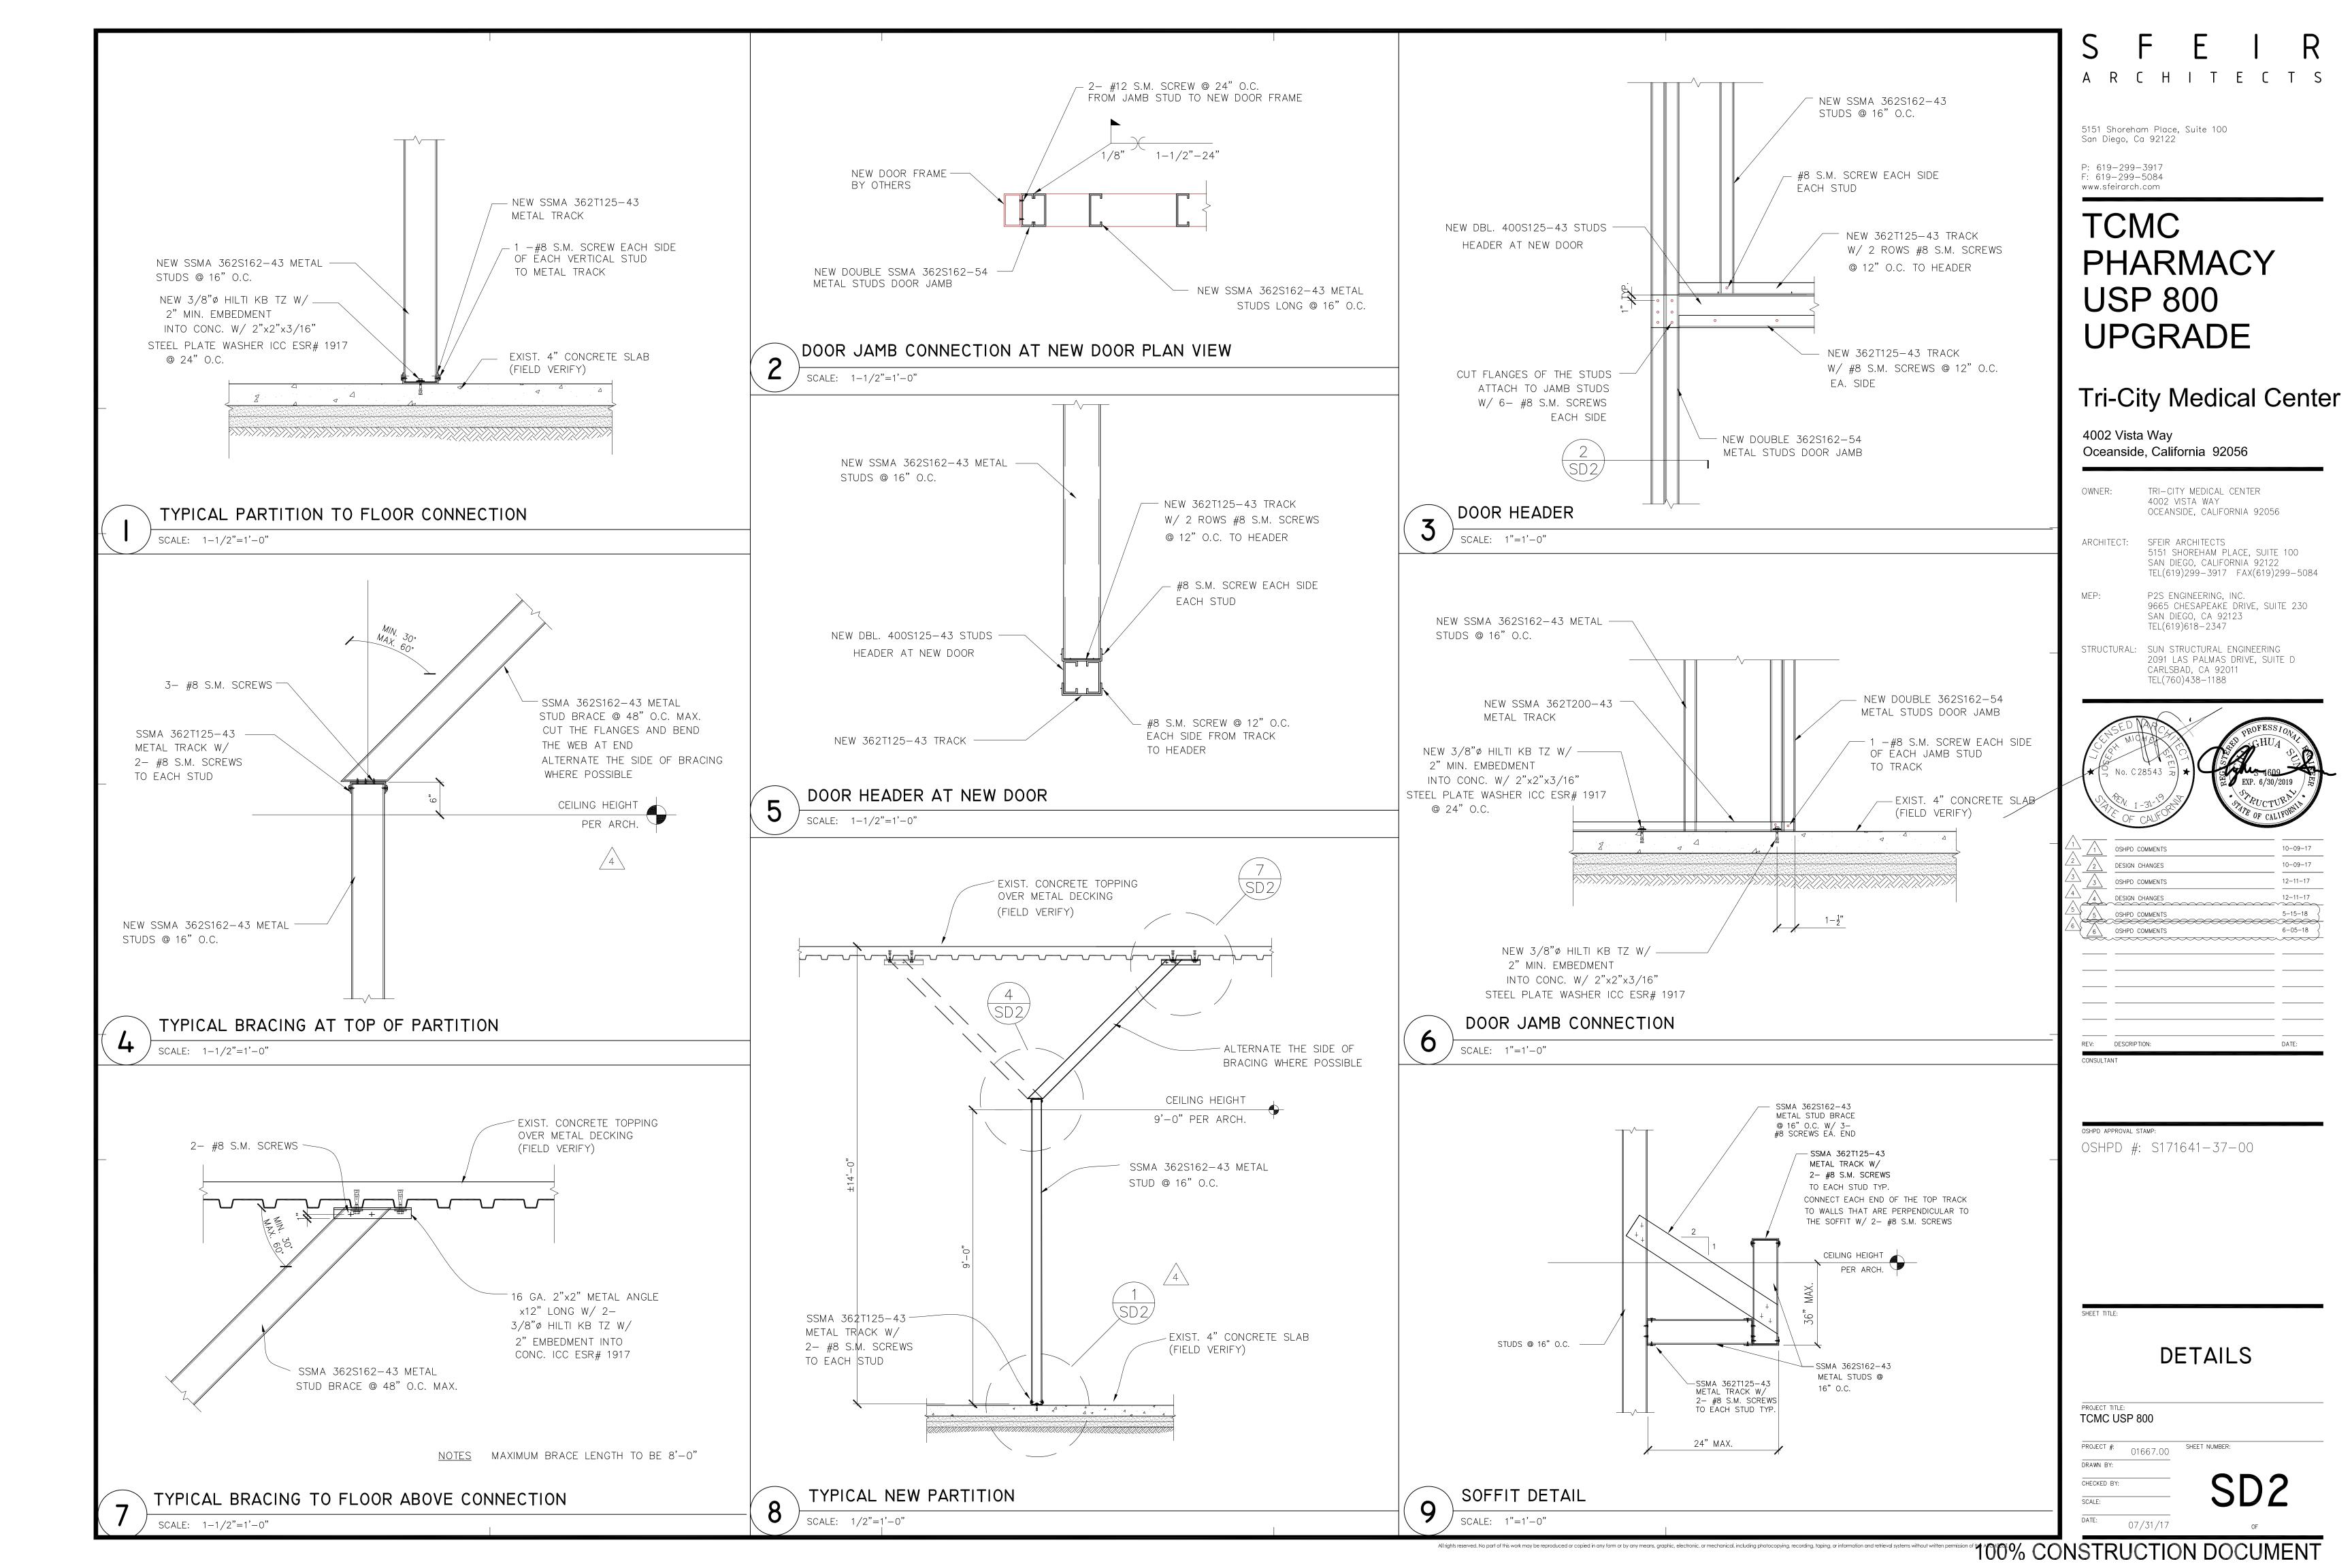

_			
_			
-			
_			

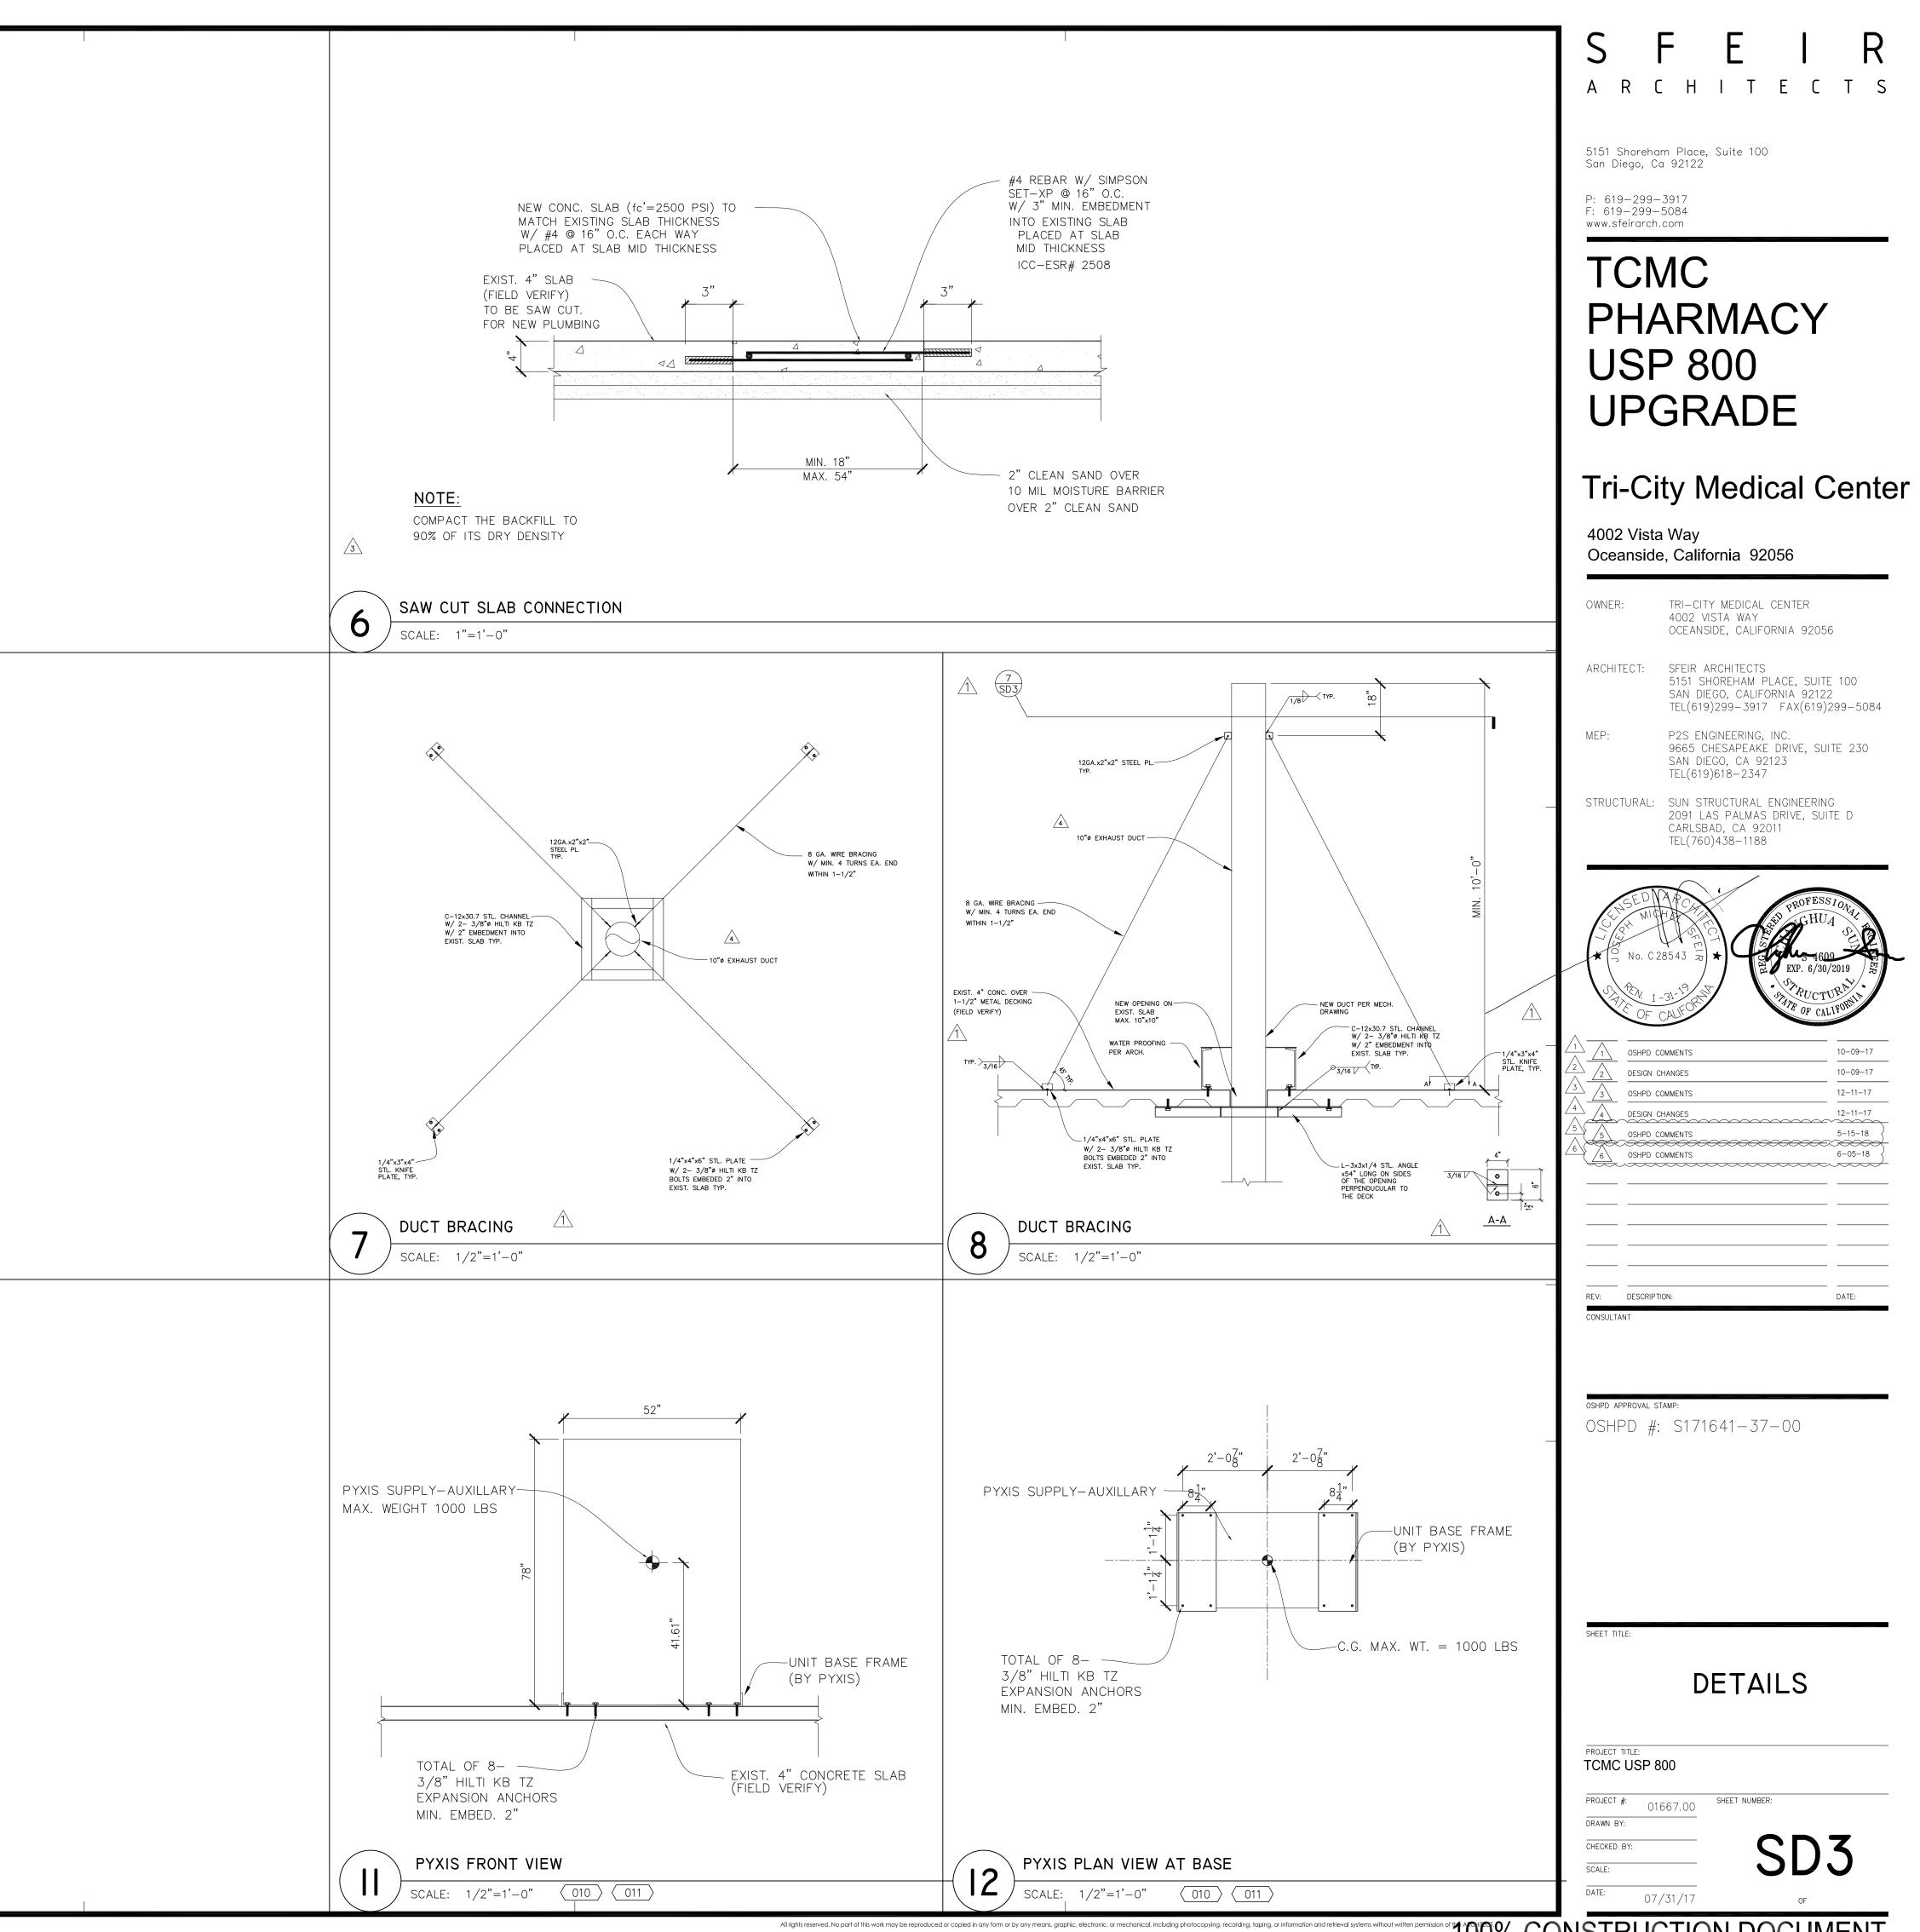

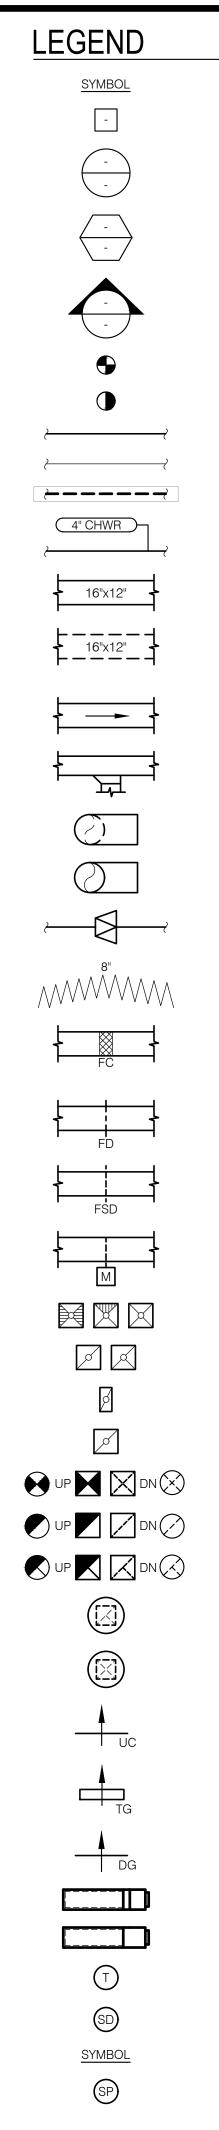

			ABBR	EVIATIONS		
DESCRIPTION	SYMBOL	DESCRIPTION		ON DESCRIPTION		
NOTE CALLOUT	\langle		ABV AC	ABOVE AIR CONDITIONING UNIT	IN KW	INCHES KILOWATTS
	<	DAMPER, OPPOSED BLADE	AC	ABOVE FINISHED FLOOR	LAT	
DETAIL CALLOUT	>		AFF	ABOVE FINISHED FLOOR	LBS	POUNDS
- NUMBER ON TOP DENOTES DETAIL NUMBER						
- NUMBER ON BOTTOM DENOTES SHEET DETAIL IS SHOWN	· · · · · · · · · · · · · · · · · · ·		AP	ACCESS PANEL	LD	
		DAMPER, PARALLEL BLADE	BDD	BACK DRAFT DAMPER	LWT	LEAVING WATER TEMPERATURE
	1.		BHP	BRAKE HORSEPOWER	MAX	MAXIMUM
MECHANICAL EQUIPMENT CALLOUT, SEE MECHANICAL PLANS FOR			BLDG	BUILDING	MBH	THOUSAND BTU PER HOUR
EXACT LOCATION AND REQUIREMENTS	NI		BMS	BUILDING MANAGEMENT SYSTEM	MCA	MINIMUM CIRCUIT AMPS
			BTU	BRITISH THERMAL UNIT	MIN	MINIMUM
	KI		CAV	CONSTANT AIR VOLUME	MOCP	MAXIMUM OVERLOAD CIRCUIT PROTECTION
SECTION CALLOUT		FILTER	CD	CEILING DIFFUSER	NIC	NOT IN CONTRACT
	K		CFM	CUBIC FEET PER MINUTE	OAT	OUTSIDE AIR TEMPERATURE
			CV	CONSTANT VOLUME BOX	OBD	OPPOSED BLADE DAMPER
			D	DRAIN	OSA	OUTSIDE AIR
POINT OF CONNECTION	//////	LOUVER	DB	DRY BULB	PD	PRESSURE DROP
			DEG	DEGREES	PERF	PERFORATED
POINT OF DISCONNECTION	AD	ACCESS DOOR OR ACCESS PANEL (AP) IN DUCTWORK	DIA	DIAMETER	PH	PHASE
IEW LINEWORK	I		DN		POD	
		TURNING VANES (RECTANGULAR)	DX	DIRECT EXPANSION	PR	PRESSURE RELIEF
XISTING LINEWORK			(E)	EXISTING	PRV	PRESSURE REDUCING VALVE
EMOLITION LINEWORK	- L- &-L-		EA	EXHAUST AIR	PSID	POUNDS PER SQUARE INCH DIFFERENTIAL
	~ /		EAT	ENTERING AIR TEMPERATURE	PSIG	POUNDS PER SQUARE INCH GAUGE
	Ť	DRAIN, FUNNEL	EF	EXHAUST FAN	RA	RETURN AIR
IEW PIPING (SIZE-SERVICE)	I		EFF	EFFICIENCY	RAR	RETURN AIR REGISTER
			EL	ELEVATION	RF	RETURN FAN
	\bigcirc	PUMP	EQ	EQUAL	RG	RETURN GRILLE
HEET METAL DUCT			ER	EXHAUST REGISTER	RHC	REHEAT COIL
			ESP	EXTERNAL STATIC PRESSURE	RLA	RATED LOAD AMPS
		CENTRIFUGAL FAN	EWT	ENTERING WATER TEMPERATURE	RPM	REVOLUTIONS PER MINUTE
	\mathbf{U}		°F	DEGREES FAHRENHEIT	SA	SUPPLY AIR
DDEN SHEET METAL DUCT						SUPPLY AIR REGISTER
			FC	FAN COOL UNIT	SAR	
		ELECTRONIC 2-WAY VALVE	FD	FIRE DAMPER	SD	SMOKE DAMPER
			FF	FAN FILTER	SF	SUPPLY FAN
RECTION OF FLOW	\square		FLA	FULL LOAD AMPS	SMBH	SENSIBLE MBH
		DDC INPUT	FLR	FLOOR	STD	STANDARD
			FOB	FLAT ON BOTTOM	TAD	TRANSFER AIR DUCT
FANDARD BRANCH FOR SUPPLY AND RETURN			FOT	FLAT ON TOP	TEMP	TEMPERATURE
		DDC OUTPUT	FP	FIRE PUMP	TG	TRANSFER GRILLE
			FPI	FINS PER INCH	TMBH	TOTAL MBH
			FPM	FEET PER MINUTE	TSP	TOTAL STATIC PRESSURE
OUND ELBOW DOWN	()	LOCALLY MOUNTED INSTRUMENT	FT	FEET OR FOOT	TYP	TYPICAL
	\smile					UNDERCUT
	_		FX	FLEXIBLE CONNECTION	UC	
OUND ELBOW UP	<u>C02</u>	CARBON DIOXIDE SENSOR	GA	GAUGE	UON	UNLESS OTHERWISE NOTED
)		GALV	GALVANIZED	V	VOLTS
	DPS	DIFFERENTIAL PRESSURE SENSOR	GC	GENERAL CONTRACTOR	VAV	VARIABLE AIR VOLUME UNIT
ECTANGULAR TO ROUND TRANSITION			GPH	GALLONS PER HOUR	VD	VOLUME DAMPER
	FM	FLOW METER	GPM	GALLONS PER MINUTE	VFD	VARIABLE FREQUENCY DRIVE
			HB	HOSE BIBB	W/	WITH
LEXIBLE DUCT	FS	AIRFLOW SENSOR	HD	HEAD	W/O	WITHOUT
			HHWS&R	HEARTING HOT WATER SUPPLY AND	WB	WET BULB
			ΠΠΝΟαΠ	RETURN	010	
	HS	RELATIVE HUMIDITY SENSOR	HP	HEAT PUMP	WC	WATER COLUMN
EX CONNECTION			HP	HORSEPOWER	WG	WATER GAUGE
	TS	TEMPERATURE SENSOR	HT	HEIGHT	WT	WEIGHT
			HZ	HERTZ		
	(TS)-MM	AVERAGING TEMPERATURE SENSOR				INT ABBREVIATIONS NOT MENTIONED HEREIN
E DAMPER				ABBREVIATIONS, AND OTHER STANDARD IND		
	<i>⊱───</i> ///	ANALOG SIGNAL				· - · · - ·
			PROJ	ECT NOTES		
	, 	DIGITAL SIGNAL				
OMBINATION FIRE AND SMOKE DAMPER						EILINGS PLANS WITH ALL DISCIPLINES TO VERIFY ES, ELECTRICAL DATA CONDUITS, PLUMBING
				, FIRE PROTECTION LINES, STRUCTURAL MEI	,	
				, FIRE PROTECTION LINES, STRUCTURAL MEI TH OF MAIN MECHANICAL SUPPLY AND RETU		
		BREVIATIONS		AGE OR ROUTING OF UTILITIES.		
ORIZED DAMPER						
			2. THE S	PACE FOR DUCT WORK & MECHANICAL FOU	INMENTE()B THIS	SPROJECTISTIMULED COORDINATION WITH

ABBREVIATION DESCRIPTION

ABBREVIATION

ΖO

DESCRIPTION

STATUS

SETPOINT

START/STOP

TEMPERATURE

PRESSURE TRANMITTER

TEMPERATURE INDICATOR

DAMPER/VALVE ACTUATOR

VELOCITY PRESSURE

CLOSED END SWITCH

POSITION INDICATOR

OPEN END SWITCH

VIBRATION SWITCH

RELATIVE HUMIDITY

SPEED CONTROL

SPEED INDICATOR

A	ALARM
Al	ANALOG INPUT
AO	ANALOG OUTPUT
DI	DIGITAL INPUT
DO	DIGITAL OUTPUT
DP	DIFFERENTIAL PRESSURE
FS	FLOW SWITCH
FM	FLOW METER
HOA	HANDS OFF AUTO
KW	KILOWATTS
LA	LEVEL ALARM
MOD	MOTOR OPERATED DAMPER
NC	NORMALLY CLOSED
NO	NORMALLY OPEN
PS	PRESSURE SWITCH

REFERENCE WILL BE MADE TO ANSI Y1.1, MILITARY STANDARD IN THE EVENT ABBREVIATIONS NOT MENTIONED HEREIN ARE USED, ABBREVIATIONS, AND OTHER STANDARD INDUSTRY CONVENTIONS.

TRANSFER GRILLE OR LOUVER

UNDERCUT DOOR

SUPPLY DIFFUSER: 2-WAY/3-WAY/4-WAY

GRILLE: RETURN/EXHAUST

1'x2' RETURN AIR GRILLE

2'x2' RETURN AIR GRILLE

SUPPLY AIR DUCT SECTION

RETURN AIR DUCT SECTION

EXHAUST AIR DUCT SECTION

POWER OR GRAVITY ROOF VENTILATOR - EXHAUST

POWER OR GRAVITY ROOF VENTILATOR - SUPPLY

DOOR GRILLE OR LOUVER

SINGLE DUCT VAV BOX WITH REHEAT COIL

SINGLE DUCT VAV BOX WITHOUT REHEAT COIL

SPACE TEMPERATURE SENSOR

SMOKE DETECTOR

DESCRIPTION

STATIC PRESSURE SENSOR

- THE SPACE FOR DUCT WORK & MECHANICAL EQUIPMENT FOR THIS PROJECT IS LIMITED. COORDINATION WITH OTHER TRADES IS CRITICAL. PROCEED WITH PREPARATION OF SHOP DRAWINGS IMMEDIATELY UPON RECEIVING AN AUTHORIZATION TO PROCEED FOR THE PROJECT. COMPLETE SHOP DRAWINGS PRIOR TO MATERIAL FABRICATION AND INSTALLATION. SHOP DRAWINGS SHALL BE REVIEWED BY COMMISSIONING AGENT, MEOR AND OWNER'S REPRESENTITIVE PRIOR TO SUBMITTAL.
- PROVIDE ORIGINALLY PREPARED CONTRACTOR'S SHOP DRAWINGS IN ELECTRONIC FORMAT. IN ADDITION TO THE REQUIREMENTS SPECIFIED ELSEWHERE, THE SHOP DRAWINGS SHALL INCLUDE THE FOLLOWING:
- A. DUCT, PIPE AND PLUMBING ELEVATIONS.
- B. DOUBLE LINE DUCTWORK AND PIPING (6" AND LARGER).
- C. ACTUAL SIZE OF PURCHASED EQUIPMENT. PER APPROVED CONTRACTOR'S SHOP DRAWINGS.
- D. ACCESS PANELS INCLUDING CEILING PANELS.
- E. ACCESS CLEARANCES FOR EQUIPMENT.
- F. ACTUAL LOCATIONS OF CEILING DIFFUSERS, REGISTERS, AND RETURN REGISTERS.
- G. LOCATIONS OF STRUCTURAL MEMBERS SUCH AS BEAMS.
- H. ACTUAL LOCATIONS OF CONTROL PANELS AND POWER CONNECTIONS TO EQUIPMENT.
- I. COLOR CODED DUCT AND PIPING BASED ON MATERIAL USED.
- J. MINIMUM 1/4"=1'0" SCALE DRAWINGS.
- K. LABEL AND TAG SCHEDULE FOR EQUIPMENT.
- L. DUCT TRANSITIONS TO CLEAR BEAMS OR TIGHT AREAS.
- M. ROOM TEMPERATURE SENSOR LOCATIONS.
- N. POINT OF CONNECTION TO UTILITIES OUTSIDE THE BUILDING.
- O. SECTIONS OR 3-D DRAWINGS OF CONGESTED AREAS.
- P. GRID LINES.
- Q. UTILITY PROFILES FOR UNDERGROUND PIPING.
- 4. DO NOT COMMENCE WITH ANY INSTALLATION, ORDERING OF ANY EQUIPMENT OR MATERIAL FABRICATION WITHOUT AN APPROVED SHOP DRAWING SUBMITTAL.
- FOR EACH SUBMITTAL, THE CONTRACTOR SHALL PROVIDE A LETTER (ON COMPANY LETTERHEAD) AND SIGNED BY THE PROJECT MANAGER INDICATING THE SUBMITTAL HAS BEEN FULLY IN HOUSE REVIEWED TO ENSURE FULL COMPLIANCE WITH THE CONTRACT DOCUMENTS AND COORDINATION WITH OTHER TRADES. ANY EXCEPTIONS TO THE CONTRACT DOCUMENTS SHALL BE CLEARLY INDICATED ON THIS LETTER. ANY DISCREPANCIES/EXCEPTIONS NOT IDENTIFIED IN WRITING SHALL BE CORRECTED AT THE SOLE EXPENSE OF THE CONTRACTOR AND AT NO EXPENSE TO THE OWNER AND ENGINEER.

GENERAL NOTES

- 1. ALL WORK SHALL COMPLY WITH THE 2013 EDITIONS OF THE CALIFORNIA BUILDING, MECHANICAL, PLUMBING, AND OTHER APPLICABLE FEDERAL, STATE, OR LOCAL CODES AS ADOPTED AND ENFORCED BY THE LOCAL JURISDICTION. IN CASE THE PLANS SHOW MORE STRINGENT REQUIREMENTS, THE PLANS SHALL GOVERN THE DESIGN, YET NOTHING ON THE DESIGN DOCUMENTS SHALL BE INTERPRETED AS AUTHORITY TO VIOLATE CODE(S) OR REGULATION(S).
- 2. SUBMISSION OF BID IN CONNECTION WITH THIS WORK SHALL IMPLY THAT THE BIDDER HAS EXAMINED THE JOB SITE UNDER WHICH THE CONTRACTOR WILL BE OBLIGATED TO OPERATE UNDER THIS CONTRACT. NO EXTRA CHARGE WILL BE ALLOWED FOR FAILURE OF ANY BIDDER TO EXAMINE THE SITE PRIOR TO BID.
- 3. WHERE USED, THE TERM "PROVIDE" SHALL MEAN "FURNISH AND INSTALL"

- CMC-602.2.
- CHAPTER 13.

THE ATTACHMENT OF THE FOLLOWING MECHANICAL AND ELECTRICAL COMPONENT SHALL BE POSITIVELY ATTACHED TO THE STRUCTURE, BUT NEED NOT BE DETAILED ON THE PLANS. THESE COMPONENTS SHALL HAVE FLEXIBLE CONNECTIONS PROVIDED BETWEEN THE COMPONENT AND ASSOCIATED DUCTWORK, PIPING, AND CONDUIT.

A. COMPONENTS WEIGHING LESS THAN 400 POUNDS AND HAVE A CENTER OF MASS LOCATED 4 FEET OR LESS ABOVE THE ADJACENT FLOOR OR ROOF LEVEL THAT DIRECTLY SUPPORTS THE COMPONENT.

B. COMPONENTS WEIGHING LESS THAN 20 POUNDS, OR IN THE CASE OF DISTRIBUTED SYSTEMS, LESS THAN 5 POUNDS PER FOOT, WHICH ARE SUSPENDED FROM A ROOF OR FLOOR OR HUNG FROM A WALL

FOR THOSE ELEMENTS THAT DO NOT REQUIRE DETAILS ON THE APPROVED DRAWINGS, THE INSTALLATION SHALL BE SUBJECT TO THE APPROVAL OF THE STRUCTURAL ENGINEER OF RECORD. THE PROJECT INSPECTOR WILL VERIFY THAT ALL COMPONENTS AND EQUIPMENT HAVE BEEN ANCHORED IN ACCORDANCE WITH ABOVE REQUIREMENTS.

25. PIPING, DUCTWORK, AND ELECTRICAL DISTRIBUTION SYSTEM BRACING NOTES:

PIPING, DUCTWORK, AND ELECTRICAL DISTRIBUTION SYSTEMS SHALL BE BRACED TO COMPLY WITH THE FORCES AND DISPLACEMENTS PRESCRIBED IN ASCE 7-05 SECTION 13.3 AS DEFINED IN ASCE 7-10 13.6.1 TO 13.6.8 AND 2016 CBC SECTIONS 1616A.1.23, 1616A.1.24, 1616A.1.25 AND 1616A.1.26.

COPIES OF THE MANUAL SHALL BE AVAILABLE ON THE JOBSITE PRIOR TO THE START OF HANGING AND BRACING OF THE PIPE, DUCTWORK, AND ELECTRICAL DISTRIBUTION SYSTEMS.

GENERAL NOTES CONTINUED

NT OF A CONFLICT OR INCONSISTENCY BETWEEN ITEMS INDICATED ON DESIGN PLANS / TIONS WITH CODE REQUIREMENTS, THE MORE STRINGENT STANDARD SHALL PREVAIL.

RACTOR SHALL FURNISH LABOR, MATERIALS, EQUIPMENT, AND TRANSPORTATION AS REQUIRED TO INSTALL ALL NEW HVAC SYSTEMS OR RELATED COMPONENTS AS INDICATED ON PLANS AND HEREIN.

QUIPMENT AND MATERIAL TO BE INSTALLED AS PART OF THIS PROJECT SHALL BEAR AN TERS' LABORATORIES LABEL (UL), AND INSTALLED IN SUCH A MANNER FOR WHICH THEY ARE AND APPROVED.

RACTOR SHALL DOCUMENT AND RELAY ANY MAJOR DEVIATIONS FROM THE DESIGN DOCUMENTS, N APPROVAL FROM THE MECHANICAL ENGINEER BEFORE PROCEEDING. AS-BUILT COPIES SHALL BE INDICATING ALL CHANGES / DEVIATIONS MADE DURING CONSTRUCTION.

SHALL BE PERFORMED IN A CLEAN AND WORKMANLIKE MANNER. CARE SHALL BE EXERCISED TO NY INCONVENIENCE OR DISTURBANCE TO OTHER AREAS OF THE BUILDING WHICH ARE TO REMAIN ION. ISOLATE WORK AREAS BY MEANS TO KEEP DUST AND DIRT WITHIN THE CONSTRUCTION AREA.

EQUIPMENT, ETC. SHALL BE REMOVED, DISCONNECTED OR SHUT DOWN WITHOUT PRIOR REVIEW DWNER TO CONFIRM THAT AREAS TO REMAIN IN OPERATION WILL NOT BE AFFECTED. IF ANY AREAS N THE SCOPE OF WORK ARE AFFECTED BY ANY SHUTDOWN, REMOVAL OR DISCONNECTION, T ADVANCE NOTICE MUST BE GIVEN TO THE OWNER INDICATING WHICH AREAS WILL BE AFFECTED, PROPOSED SHUTDOWN WILL OCCUR, AND FOR HOW LONG A PERIOD OF TIME.

IGEMENT OF EQUIPMENT AND PIPING SHOWN ON THE DRAWINGS IS BASED UPON INFORMATION TO THE ENGINEER AT THE TIME OF DESIGN AND IS NOT INTENDED TO SHOW EXACT DIMENSIONS TO A SPECIFIC MANUFACTURER. THE DRAWINGS ARE, IN PART, DIAGRAMMATIC AND SOME OF THE ILLUSTRATED EQUIPMENT INSTALLATION MAY REQUIRE REVISION TO MEET ACTUAL T INSTALLATION REQUIREMENTS. STRUCTURAL SUPPORTS, FOUNDATIONS, CONNECTED PIPING, D ELECTRICAL CONDUIT SPECIFIED MAY HAVE TO BE ALTERED TO ACCOMMODATE THE EQUIPMENT NO ADDITIONAL PAYMENT WILL BE MADE FOR SUCH REVISIONS AND ALTERATIONS.

RACTOR SHALL VERIFY ALL DIMENSIONS AT THE SITE MAKING FIELD MEASUREMENTS AND SHOP NECESSARY FOR FABRICATION OR ERECTION OF HVAC SYSTEMS. MAKE ALLOWANCE FOR BEAMS, OTHER OBSTRUCTIONS IN BUILDING CONSTRUCTION. CHECK DRAWINGS SHOWING WORK OF ADES AND CONSULT WITH THE OWNER'S REPRESENTATIVE IN THE EVENT OF POTENTIAL NCE. SHOP DRAWINGS SHALL BE MINIMUM 1/4"=1'-0" SCALE, INDICATING FITTINGS, SIZES, WELDS IGURATIONS AND SUBMITTED TO ENGINEER FOR REVIEW.

RACTOR SHALL COORDINATE HIS WORK WITH ALL OTHER TRADES PRIOR TO FABRICATION, AND/OR INSTALLATION OF ALL WORK.

DMMENCEMENT OF WORK, THIS CONTRACTOR SHALL VERIFY THE EXACT LOCATIONS, ELEVATIONS, ACTERISTICS OF ALL UTILITIES.

OR SHALL SECURE AND PAY ALL FEES AND PERMITS PERTAINING TO THE CONTRACT.

IATERIALS THAT ARE REMOVED SHALL NOT BE REUSED IN NEW SYSTEMS, EXCEPT WHERE AS BEING RELOCATED.

MENT SHALL BE INSTALLED IN STRICT COMPLIANCE WITH THE MANUFACTURER'S WRITTEN ONS.

D SHEET METAL SHALL BE PROVIDED FOR ALL HVAC DUCT SYSTEMS, AND CONSTRUCTED / D / INSTALLED IN ACCORDANCE WITH THE 2016 CALIFORNIA MECHANICAL CODE AND THE LATEST TANDARDS.

SHALL BE INSTALLED AS INDICATED ON THE DRAWINGS IN A NEAT WORKMANSHIP-LIKE MANNER IPPORTED AS REQUIRED BY CODES. PIPING SHALL BE SET UP AND DOWN AND OFFSET AS REQUIRED ELD CONDITIONS. DIELECTRIC COUPLINGS SHALL BE USED WHERE DISSIMILAR METALS ARE JOINED.

RACTOR SHALL PROVIDE ALL NECESSARY SUPPORTS FOR FIXTURES, DUCTWORK, PIPING, AND AL EQUIPMENT, IN ORDER TO COMPLY WITH CALIFORNIA BUILDING CODE, SMACNA INSTALLATIÓN S, AND ALL RELATED LOCAL ORDINANCES.

RACTOR SHALL NOT BORE, NOTCH, CUT, OR PENETRATE INTO A STRUCTURAL MEMBER WITHOUT PPROVAL FROM A DESIGNATED STRUCTURAL ENGINEER AND THE OWNER.

BOWS SHALL BE LONG RADIUS UNLESS OTHERWISE SPECIFICALLY NOTED ON THE DRAWINGS.

22. ISOLATE AND DRAIN EXISTING PIPING SYSTEM AS REQUIRED TO ACCOMMODATE INSTALLATION OF THE WORK.

23. ALL MATERIAL EXPOSED WITHIN RA PLENUMS SHALL BE NON-COMBUSTIBLE OR SHALL HAVE A FLAME SPREAD INDEX NOT GREATER THAN 25 AND SMOKE DEVELOPED INDEX NOT GREATER THAN 50. COMPLY WITH

24. 2016 CBC MECHANICAL, ELECTRICAL AND PLUMBING EQUIPMENT ANCHORAGE NOTES:

ALL MECHANICAL, PLUMBING, AND ELECTRICAL COMPONENTS SHALL BE ANCHORED AND INSTALLED PER THE DETAILS ON THE OSHPD APPROVED CONSTRUCTION DOCUMENTS. WHERE NO DETAIL IS INDICATED, THE FOLLOWING COMPONENTS SHALL BE ANCHORED OR BRACED TO MEET THE FORCES AND DISPLACEMENT REQUIREMENTS PRESCRIBED IN THE 2016 CBC SECTIONS 1615A.1.17 THROUGH 1616A.1.27 AND ASCE 7-10

1) ALL PERMANENT EQUIPMENT AND COMPONENTS.

2) TEMPORARY OR MOVABLE EQUIPMENT THAT IS PERMANENTLY ATTACHED (E.G. HARD WIRED) TO THE BUILDING UTILITY SERVICES SUCH AS ELECTRICITY, GAS OR WATER.

3) MOVABLE EQUIPMENT WHICH IS STATIONED IN ONE PLACE FOR MORE THAN 8 HOURS AND HEAVIER THAN 400 POUNDS ARE REQUIRED TO BE ANCHORED WITH TEMPORARY ATTACHMENTS.

THE STRUCTURAL ENGINEER OF RECORD SHALL VERIFY THE ADEQUACY OF THE STRUCTURE TO SUPPORT THE HANGER AND BRACE LOADS.

5 ARCHITECTS

5151 Shoreham Place, Suite 100 San Diego, Ca 92122

P: 619-299-3917 F: 619-299-5084 www.sfeirarch.com

TCMC PHARMACY **USP 800** UPGRADE

Tri-City Medical Center

4002 Vista Way Oceanside, California 92056										
OWNER:	TRI—CITY MEDICAL CENTER 4002 VISTA WAY OCEANSIDE, CALIFORNIA 92056 TEL (760) 940—7709									
ARCHITECT:	SFEIR ARCHITECTS 5151 SHOREHAM PLACE, SUITE 10 SAN DIEGO, CALIFORNIA 92122									


MEP: P2S ENGINEERING, INC.

SAN DIEGO, CA 92123 TEL(619)618-2347 STRUCTURAL: SUN STRUCTURAL ENGINEERING

9665 CHESAPEAKE DRIVE, SUITE 230

TEL(619)299-3917 FAX(619)299-5084

2091 LAS PALMAS DRIVE, SUITE D CARLSBAD, CA 92011 TEL(760)438-1188

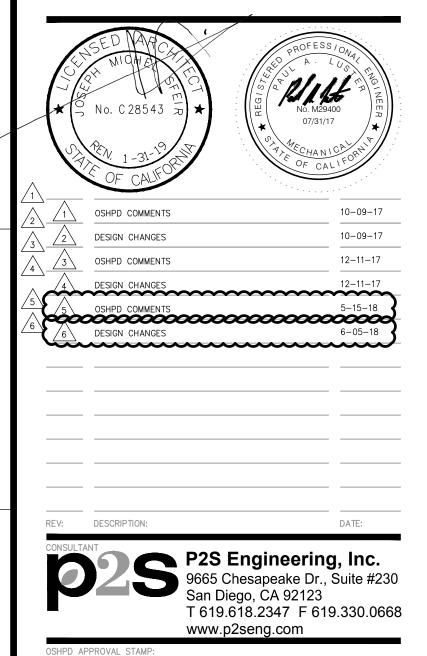

OSHPD #: S171641-37-00

GENERAL NOTES, LEGEND, SYMBOLS AND SHEET INDEX

PROJECT TITLI TCMC USP 800

PROJECT #: 01667.00 DRAWN BY: CHECKED BY



SHEET NUMBER

	AIR BALA	NCE SCH		4 5 6						Δ											
							CODE REQUIRE	EMENTS PER CMC	C TABLE 4-A (USF	? 797 & USP 800)					PROPO	DSED DESIGN			1		
	ROOM NUMBER	ROOM NAME	ROOM AREA (SF)	CEILING HEIGHT	ROOM SUPPLY (CFM)	ROOM EXHAUST (CFM)	ROOM RETURN (CFM)	ROOM OUTSIDE (CFM)	ROOM TOTAL AIR CHANGES (AC/HR)	ROOM OUTSIDE AIR (AC/HR)	AIR BALANCE RELATIONSHIP TO ADJACENT AREAS 8	ROOM EXHAUST (YES/NO)	ROOM SUPPLY (CFM)	ROOM EXHAUST (CFM)	ROOM RETURN (CFM)	ROOM TOTAL AIR CHANGES (AC/HR)	ROOM OUTSIDE AIR (AC/HR)	ROOM EXHAUST (AC/HR)	AIR BALANCE AND STATIC PRESSURE RELATIONSHIP TO ADJACENT 9 AREAS	ROOM SUPPLY (CFM)	ROOM EXHAUST (CFM)
	032	BSC	100	8'	300	400	-	-	30	-	N	YES	300	450 2		33.75 1	-	33.75			
	031	ANTE ROOM	370	8'	1480	-	-	100	30	2	Р	NO 🔏	1480		3 1305	30	2	-			
	030	IV PREP ROOM	160	8'	640	-	-	45	30 1	2	Р	NO	600 /	-	525	28 7	2	-			
<u>``</u>	041	TOILET	48	8'-1"	-	65	-	-	10	-	Ν	YES	-	65	-	10	-	10			

(E) SPACES AIR BALANCE TABLE VALUES FROM OSHPD APPROVED DRAWINGS FOR TRI-CITY MEDICAL CENTER PHARMACY 797 USP UPGRADE APPROVED JAN. 18, 2007.

2 15 AC/HR IS RECIRCULATED AIR THROUGH THE FINAL FILTERS.

3 EXISTING AH-3 SERVES THE SPACES SHOW IN TABLE. EXISTING AIR HANDLING UNIT HAS 33% OSA AS PROVIDED BY OSHPD APPROVED DRAWINGS FOR TRI-CITY MEDICAL CENTER PHARMACY 797 USP UPGRADE APPROVED JAN. 18, 2007.

4 EXISTING AH-3 SERVING THE AREA OF WORK IS EQUIPPED WITH MERV 8 FILTER UPSTREAM OF THE COIL IN THE AHU (TABLE 4B, POSITION 1) AND MERV 15 AIR FILTER DOWNSTREAM OF THE COIL IN THE AHU (TABLE 4B, POSITION 2), WHICH IS CODE COMPLIANT.

5 EXISTING AIR HANDLING UNIT SERVING THE AREA IS EQUIPPED WITH SMOKE DETECTOR.

6 EXISTING AIR HANDLING UNIT SERVING THE AREA IS EQUIPPED WITH EMERGENCY POWER.

(E) SA OF 600 CFM AND THE (2) PRIMARY ENGINEERING CONTROL (PEC) UNITS THAT ARE HEPA FILTERED PROVIDE IN EXCESS OF 30 AC/HR.

8 N - NEGATIVE, P - POSITIVE, NR - NO REQUIREMENT FOR CONTINUOUS DIRECTIONAL CONTROL.

9 CONTRACTOR TO STATE AIR BALANCE RELATIONSHIP & MEASURE STATIC PRESSURE TO ADJACENT SPACE. SEE AIRFLOW DIAGRAM 4/M6-10 FOR REQUIREMENTS.

10 CONTRACTOR TO COMPLETE WITH ACTUAL TESTED VALUES.

SHEET INDEX

SHEET	DESCRIPTION
M0-01	GENERAL NOTES, LEGEND, SYMBOLS & SHEET INDEX

- M0-02 SCHEDULES M1-10
- ZONING PLAN PARTIAL RENOVATION FIRST FLOOR AND ROOF PLAN M2-10
- PARTIAL RENOVATION HEATING HOT WATER FLOOR PLAN M2-11 M5-10 DIAGRAMS
- M6-10 DETAILS

MD2-10 PARTIAL DEMOLITION FLOOR PLAN MD2-11 PARTIAL DEMOLITION HEATING HOT WATER FLOOR PLAN

MECHANICAL PIPE AND DUCT SYSTEM SEISMIC SUPPORT NOTES

MECHANICAL & PLUMBING:

1. SUPPORT AND BRACING FOR NEW PIPING, EXCEPT FIRE SPRINKLER PIPING, AND FOR NEW DUCTWORK SHALL BE PROVIDED PER OPM-0043-13 MASON SEISMIC RESTRAINT COMPONENTS FOR SUSPENDED UTILITIES OR OTHER APPROVED OSHPD OPM.

2. LAYOUT DRAWINGS, SHOWING THE BRACING/SUPPORT LOCATIONS AND REFERENCES TO DETAILS FROM THE RELEVANT OSHPD PRE-APPROVALS NEED TO BE SUBMITTED FOR USE BY THE INSPECTOR OF RECORD AND OSHPD FIELD STAFF. THE LAYOUT DRAWINGS, PREPARED PER ASCE 7 CHAPTER 13 AS MODIFIED BY CBC SECTIONS 1613A/1616A, SHALL BE PREPARED BY THE SUBCONTRACTOR AND SIGNED BY A STRUCTURAL ENGINEER LICENSED IN THE STATE OF CALIFORNIA. REFERENCES TO DETAILS FROM THE OSHPD PRE-APPROVAL SHALL BE FOR AN ENTIRE DETAIL AS SUBMITTED OR REFERENCE SHALL BE FOR EACH ASPECT OF A SUBMITTED DETAIL. CUSTOM DETAILS SHALL BE PROVIDED FOR SITUATIONS WHERE OSHPD PRE-APPROVALS DO NOT APPLY. AT LEAST FOUR WEEKS PRIOR TO BEGINNING INSTALLATION, FOUR COPIES OF THE PLANS SHALL BE SUBMITTED TO THE ARCHITECT OF RECORD WHO WILL SUBMIT THEM TO THE STRUCTURAL ENGINEER OF RECORD FOR REVIEW AND APPROVAL. AFTER THIS APPROVAL, THE DRAWINGS WILL BE SUBMITTED TO THE OSHPD DISTRICT STRUCTURAL ENGINEER FOR REVIEW AND APPROVAL. THE PLANS SHALL BE COORDINATED WITH THE PLANS OF OTHER TRADES. A COPY OF THE CHOSEN BRACING SYSTEM INSTALLATION GUIDE/MANUAL SHALL BE ON THE JOBSITE PRIOR TO STARTING THE INSTALLATION.

3. THE STRUCTURAL ENGINEER FOR THE CONTRACTOR SHALL DETERMINE THE APPROPRIATE SEISMIC FORCES BASED ON THE DESIGN CRITERIA SHOWN ON THE STRUCTURAL DRAWINGS.

4. ONCE THE EXACT LOCATIONS OF ALL PIPING AND DUCTWORK HAVE BEEN ESTABLISHED, THE STRUCTURAL ENGINEER MUST CHECK THE ADEQUACY OF THE SUPPORTING STRUCTURE TO ENSURE THAT THE ORIGINAL DESIGN IS STILL ADEQUATE. THE INSPECTOR OF RECORD SHALL INSURE THAT ALL WORK IS PROPERLY INSTALLED PER THE APPLICABLE OSHPD PRE-APPROVAL.

 Λ


																			S A R	F E	I R ECTS
AIR BALANC	E			PROP	OSED DESI	GN			AIR BAL				ACT	TUAL 10				_	5151 Sh	oreham Place, Suite 100 go, Ca 92122	0
RELATIONSH TO ADJACEN AREAS 8	IIP		ROOM EXHAUST (CFM)	DOM RETURN (CFM)	N ROOM T AIR CHA (AC/H	NGES OL	ROOM JTSIDE AIR (AC/HR)	ROOM EXHAUST (AC/HR)	AIN BAL AND ST PRESS RELATIO TO ADJA	TATIC SURE RO NSHIP ACENT	OOM SUPPLY (CFM)	ROOM EXHAUST (CFM)			OOM TOTAL R CHANGES (AC/HR)	ROOM OUTSIDE AIR (AC/HR)	ROOM EXHAUST (AC/HR)	REMARKS	P: 619- F: 619-	-299–3917 -299–5084 rarch.com	
N	YES	300	450 1	_	33.7	75 1	-	33.75										1 2			
Ρ	NO A	1480	3	1305	30)	2	-										123		CMC	
Ρ	NO	600 1	-	525	28	3 7	2	-												IARMA	NCY
N	YES	-	65	-	10		-	10											- I US	SP 800	
CAV	SCHED	JLE																		PGRAD	
	MANUFACTURER		, INLET SIZ	E DCV		AIRFLOW			AIR	SIDE		HEATING CO	L	WATERSI	DE						
MARK	& MODEL	LOCATION	DIA	Y/N	MAX CFM	MIN CFM	MAX HTG. CFM	HTG. MBH	EAT °F	LAT °F	MAX PD IN	GPM	EWT °F	LWT °F	MAX PD FT	ROWS		REMARKS	Tri-	City Medi	cal Center
CAV-1	PRICE SDV	BSC ROON	M 7"	N	300	300	300	11,340	55	90	0.18	1.1	180	160	0.05	2 -	-			Vista Way	
CAV-2	PRICE SDV	ANTE ROO	M 10"	N	750	750	750	28,350	55	90	0.33	2.2	180	160	0.09	2 -	-		Ocear	nside, California 92	2056
								Δ				Λ							OWNER:	TRI—CITY MEDICAL 4002 VISTA WAY	
FXIS	STING CA	V SCH																	ARCHITE		709
						AIRFLOW						HEATING CO	L						_	5151 SHOREHAM I SAN DIEGO, CALIF TEL(619)299–391	
MARK	MANUFACTURER & MODEL	LOCATION	N INLET SIZE DIA	DCV Y/N	MAX	MIN	MAX HTG.	HTG.	AIR: EAT	SIDE LAT	MAX PD		EWT	WATERSII	DE MAX PD			REMARKS	MEP:	P2S ENGINEERING, 9665 CHESAPEAK	, INC. E DRIVE, SUITE 230
					CFM	CFM	CFM	MBH	°F	°F	IN	GPIN	°F	°F	FT	ROWS			_	SAN DIEGO, CA 9 TEL(619)618–234	2123
(E) CAV-3	KRUGER LMHS	IV PREP	8"	N	600	600	600	24.6	55	90	0.8	2.5	180	160	0.8	1 -	-		STRUCTU	IRAL: SUN STRUCTURAL 2091 LAS PALMAS	S DRIVE, SUITE D
					Γ	FANF	FILTEF												_ _	CARLSBAD, CA 92 TEL(760)438–1188	3
					ŀ									ELECTRICA		WEIGHT				ED MICHE	ROFESSIONAL BOALLUST
						MARK	MANUFAC & MODE		LOCATIC	DN	SIZE	CFM	HP	VOLT	РН	LBS	-	REMARKS	× 17	No. C 28543 7	и с с с с с с с с с с с с с с с с с с с
					-	FF-2	ENVIRCO, N		BSC ROC	DM	2"x2"	300	1/3	120	1	54	2			N. 1-31-19	OF CHANICAL T
					-	FF-3	LEDC - F ENVIRCO, N LEDC - F	ИАС-10	ANTE ROO		2"x2"		1/3	120	1	54	1 2			OF CALTO DSHPD COMMENTS	10-09-17
						FF-4	ENVIRCO, N LEDC - F	MAC-10 ISRE	ANTE ROO	ОМ	2"x2"	365	1/3	120	1	54	1 2			DESIGN CHANGES	10-09-17
						FF-5	ENVIRCO, M LEDC - F	ISRE	ANTE ROO	МС	2"x2"	250	1/3	120	1	54	2				12-11-17
					-	FF-6	ENVIRCO, N LEDC - F ENVIRCO, N	SRE			2"x2"	250	1/3	120	1	54	2			DESIGN CHANGES	
							LEDC - F	ISRE			2"x2"	250	1/3	120		54	2				
							TING F														
													EU	ECTRICAL		WEIGHT			-		
						MARK	MANUFACTU & MODEL		OCATION	S	SIZE C	CFM						REMARKS		DESCRIPTION:	DATE:
					_								-IP	VOLT	PH	LBS			CONSULTANT	P2S Eng	gineering, Inc. apeake Dr., Suite #230
						(E) FF-1	ENVIRCO - L	EDC IV F	PREP ROOM	1 2'	"x4" 6	500	1/3	120	1	71 -				San Diego	apeake Dr., Suite #230 , CA 92123 .2347 F 619.330.0668
					Γ				rede			DC							OSHPD APP	www.p2se	
					-		LES, R												OSHP	D #: S171641-37	7-00
					_	MARK	DESCRIF		MATERIAL		STYLE	FRONT BLA		DAMPER	FINI	ISH		REMARKS	_		
						EG-1 EG-2	PRICE P		STEEL		SIDEWALL	HORIZON	TAL	N/A N/A		-			_		
					-	RG-1	PRICE		STEEL			HORIZON	ΓAL	N/A		-			_		
							INATE WITH AF	CHITECT.													
																			SHEET TITLE	:	
																			SCH	EDULES	
																			PROJECT TIT	LE:	
																				JSP 800	
																			PROJECT #: DRAWN BY:	01667.00 SHEET NUMBE ED	ER:
																			CHECKED BY		0-02
																			SCALE: 	07/31/17	


																							F E		
						SED DESIG	2NI								ACTUAL		<u>^</u>						_		1 3
AIR BALANCE RELATIONSHIP		DOOM						20014		AIR BA	ALANCE STATIC											5151 Shoreho San Diego, C	ım Place, Suit a 92122	e 100	
TO ADJACENT	ROOM EXHAUST (YES/NO)	ROOM SUPPLY (CFM)	ROOM EXHAUS (CFM)	ST RO	OM RETURN (CFM)	AIR CHAN (AC/H	NGES O	ROOM UTSIDE AIR (AC/HR)	ROOM EXHAUS ⁻ (AC/HR)	r PRES RELATI	SSURE ONSHIP JACENT	ROOM SUPP (CFM)	EXH	DOM IAUST CFM)	ROOM RETU (CFM)	AIR	OM TOTAL CHANGES (AC/HR)	ROOM OUTSIDE AIR (AC/HR)	ROOM EXHAUST (AC/HR)			P: 619—299- F: 619—299- www.sfeirarch	-3917 -5084 .com		
N	YES	300	450	<u></u>	-	33.75	5 1	-	33.75											1 2		TC			
P	NO 3	1480	-		1305	30		2	-																/
P N	NO YES	600 <u>/</u> 1 -	65		-	10	7	2	- 10																
				1		1				L			I									USF			
CAV	SCHED	JLE											HEATIN	IG COII								UP	GRA	DE	
MARK	MANUFACTURER & MODEL	LOCAT		NLET SIZE DIA	E DCV	MAX	AIRFLOW		HTG.	AI	RSIDE	MAX F	חפ		I	ATERSIDE LWT				REMARKS		Tri-Ci	tv Me	dical	Center
CAV-1	PRICE SDV	BSC RC		7"	N	CFM 300	CFM 300	CFM 300	MBH 11,340	°F	°F	IN			°F	°F	0.05	ROWS				4002 Vista			
CAV-2	PRICE SDV	ANTE RO	ООМ	10"	N	750	750	750	28,350	55	90	0.33	3 2.	.2	180	160	0.09	2 -					e, California	92056	
																						OWNER:	4002 VISTA	DICAL CENTER Nay California 920	56
EXIS.	TING CA		HEDI																		_	ARCHITECT:	TEL (760) 94 SFEIR ARCHIT	-0-7709 ECTS	
	MANUFACTURER						AIRFLOW	,					HEATIN	IG COIL									SAN DIEGO, (AM PLACE, SU California 921 -3917 Fax(61	22
MARK	MANOFACTOREN & MODEL	LOCAT	ION	INLET SIZE DIA	DCV Y/N	MAX CFM	MIN CFM	MAX HTG. CFM	HTG. MBH	EAT °F	RSIDE LAT °F	MAX F	PD GF			ATERSIDE LWT °F	MAX PD FT	ROWS		REMARKS		MEP:	SAN DIEGO, (PEAKE DRIVE, S CA 92123	UITE 230
(E) CAV-3	KRUGER LMHS	IV PRE	EP	8"	N	600	600	600	24.6	55	90	0.8	2.	.5	180	160	0.8	1 -			_	STRUCTURAL:	TEL(619)618-	JRAL ENGINEER	
						Γ_																	CARLSBAD, C TEL(760)438-	LMAS DRIVE, S A 92011 -1188	JIIE D
						F	-AN		R BO	X												ENSED		2 PROFE	SSIONA
							MARK	MANUFA & MOE		LOCAT	ION	SIZE	CFM		ELE	CTRICAL		WEIGHT	-	REMARKS		→ No. C	28543 77 *	No.	ALL REAL
							FF-2	ENVIRCO,	MAC-10	BSC RC		2"x2"	300	H 1/		VOLT	PH	LBS 54	2			No Pere 1	-31-19	V 07/3 V ATECHA PF OF OF	NICA R ^N
							FF-3	LEDC - ENVIRCO, LEDC -	MAC-10	ANTE R		2 x2 2"x2"	365	1/		120	1	54	1 2				CALIFO		10-09-17
							FF-4	ENVIRCO, LEDC - ENVIRCO,	RSRE	ANTE RO		2"x2"	365	1/		120	1	54	1 2			DESIGN	CHANGES COMMENTS		10-09-17 12-11-17
							FF-5 FF-6	ENVIRCO, LEDC -	RSRE MAC-10	ANTE RO		2"x2" 2"x2"	250 250	1/		120 120	1	54	2				CHANGES	~~~~~	12-11-17 5-15-18
							FF-7	ENVIRCO, LEDC -	MAC-10	ANTE RO	DOM	2"x2"	250	1/	/3	120	1	54	2		2	T 6 DESIGN	CHANGES		0-03-10
													RFACE.	<u> </u>											
							2812	TING F				/X													
							MARK	MANUFACT & MODE		LOCATION		SIZE	CFM		ELECTR			WEIGHT		REMARKS	_	REV: DESCRIP	10N:		DATE:
							(E) FF-1	ENVIRCO -	LEDC I	V PREP ROO	M	2"x4"	600	HP 1/3	120		PH 1	LBS					S P2S 9665	Engineeri Chesapeake Dr	ng, Inc. ., Suite #230
											I	I											San D T 619	iego, CA 92123 .618.2347 F 6 p2seng.com	
						(GRIL	LES, F	REGIS	STER	S, DI	FFUS	ERS									oshpd approval s	tamp: : S171641	-37-00	
							MARK	DESCR	PTION	MATERIAL	-	STYLE	FRON	NT BLADES	DAN	MPER	FINI	зн		REMARKS					
							EG-1 EG-2	PRICE		STEEL		SIDEWALL	HOF	RIZONTAL		N/A N/A	1	-							
							RG-1	PRICE		STEEL		SIDEWALL	HOF	- RIZONTAL		N/A		-							
						1		NATE WITH A	RCHITECT.								•								
																						SHEET TITLE:	ULES		
																						PROJECT TITLE:			
																						DRAWN BY:	FD	NUMBER:	
																						CHECKED BY:		/0-(JZ
						I									I							DATE: 07	/31/17	OF	

												SFEI
SIGN						AC	TUAL 10	1				ARCHITECT
1 TOTAL HANGES C/HR)	ROOM OUTSIDE AIR (AC/HR)	ROOM EXHAUST (AC/HR)	AIR BALANC AND STATIC PRESSURE RELATIONSH TO ADJACEN	C E ROOM SUPI HP (CFM)	PLY ROOM EXHAU (CFM	M ROOM		DOM TOTAL R CHANGES (AC/HR)	ROOM OUTSIDE AIR (AC/HR)	ROOM EXHAUST (AC/HR)	REMARKS	5151 Shoreham Place, Suite 100 San Diego, Ca 92122 P: 619-299-3917 F: 619-299-5084 www.sfeirarch.com
3.75 1		33.75	9 AREAS								1 2	ТСМС
30 28 7 10	2 2 -	- - 10									$\begin{array}{c c} 1 & 2 & 3 \\ \hline 1 & 7 & 1 \\ \hline \end{array}$	PHARMACY USP 800
												UPGRADE
AIRF	LOW		AIRSIDE		HEATING	COIL	WATERSID	E			REMARKS	Tri City Madiaal Car
M CF 30	M CFM	HTG. MBH	EAT °F 55	LAT MAX °F IN 90 0.1	GPM	EWT °F 180	LWT °F 160	MAX PD FT 0.05	ROWS			Tri-City Medical Cer
75		28,350	55	90 0.3		180	160	0.03	2 -			Oceanside, California 92056
												OWNER: TRI-CITY MEDICAL CENTER 4002 VISTA WAY
												OCEANSIDE, CALIFORNIA 92056 TEL (760) 940-7709 ARCHITECT: SFEIR ARCHITECTS
AIRF	LOW				HEATING (COIL						5151 SHOREHAM PLACE, SUITE 100 SAN DIEGO, CALIFORNIA 92122 TEL(619)299-3917 FAX(619)299-50
M		HTG. MBH	AIRSIDE EAT °F	LAT MAX °F IN		EWT °F	WATERSID	MAX PD FT	ROWS		REMARKS	MEP: P2S ENGINEERING, INC. 9665 CHESAPEAKE DRIVE, SUITE 230 SAN DIEGO, CA 92123
60		24.6	55	90 0.8		180	160	0.8	1 -			TEL(619)618–2347 STRUCTURAL: SUN STRUCTURAL ENGINEERING 2091 LAS PALMAS DRIVE, SUITE D
1	ENVIRCO LEDC - ENVIRCO LEDC - ENVIRCO	MAC-10 RSRE MAC-10 RSRE MAC-10 RSRE MAC-10 RSRE MAC-10 RSRE MAC-10 RSRE MAC-10 RSRE MAC-10 RSRE MAC-10 RSRE MAC-10 RSRE MAC-10 RSRE	LOCATION BSC ROOM ANTE ROOM ANTE ROOM ANTE ROOM ANTE ROOM DE WITH BACNET LOCATION PREP ROOM		CFM 300 365 250 250 250 CFM 600		ELECTRICA VOLT 120 120 120 120 120 120 120 LECTRICAL VOLT 120 120	L PH 1 1 1 1 1 1 1 1 1 1 1 1 1 PH 1	WEIGHT LBS 54 55 55 55 55 55 55 55 55 55 55 55 55 55 55 55		REMARKS	Image: Second state of the second s
GR	ILLES, I	REGIS	TERS, I	DIFFUS	ERS							www.p2seng.com
MAF			MATERIAL	STYLE	FRONT E	BLADES	DAMPER	FI	NISH		REMARKS	OSHPD #: S171641-37-00
EG		E 530	STEEL	SIDEWALL	HORIZO	DNTAL	N/A	1	-			
EG- RG-		PDDR E 530	STEEL	LAY-IN SIDEWALL	- HORIZO		N/A N/A		-			
] co	ORDINATE WITH	ARCHITECT.										SHEET TITLE: SCHEDULES PROJECT TITLE: TCMC USP 800 PROJECT #: O16687.00 DRAWN BY: ED CHECKED BY: SJ SCALE:

													SFEIR ARCHITECTS
DESIC	GN						<i>F</i>	ACTUAL 10					5151 Shoreham Place, Suite 100
OOM T R CHA (AC/H	NGES	ROOM OUTSIDE AIR (AC/HR)	ROOM EXHAUST (AC/HR)	AIR BALANCE AND STATIC PRESSURE RELATIONSHI TO ADJACEN 9 AREAS	ROOM SUPP P (CFM)	-Y ROC EXHA (CFI	UST		ROOM TOTAL AIR CHANGES (AC/HR)	ROOM OUTSIDE AIF (AC/HR)	ROOM EXHAUST (AC/HR)	REMARKS	San Diego, Ca 92122 P: 619-299-3917 F: 619-299-5084 www.sfeirarch.com
33.7	5 1	-	33.75									1 2	ТСМС
30	7	2	-										PHARMACY
10		-	- 10										
													USP 800
													UPGRADE
	AIRFLC			AIRSIDE		HEATING		WATERS				REMARKS	Tri City Modical Contor
X M	MIN CFM		. HTG. MBH		LAT MAX F °F IN	'D GPN	Λ EW1 °F	r LWT °F	MAX PD FT	ROWS			Tri-City Medical Center
0	300 750		28,350		90 0.18 90 0.33				0.05	2	-		4002 Vista Way Oceanside, California 92056
													OWNER: TRI-CITY MEDICAL CENTER
						·							4002 VISTA WAY OCEANSIDE, CALIFORNIA 92056 TEL (760) 940-7709
													ARCHITECT: SFEIR ARCHITECTS 5151 SHOREHAM PLACE, SUITE 100 SAN DIEGO, CALIFORNIA 92122
	AIRFLC) W		AIRSIDE		HEATING	i COIL	WATERS	IDE			REMARKS	TEL(619)299-3917 FAX(619)299-5084 MEP: P2S ENGINEERING, INC.
X M	MIN CFM		. HTG. MBH		LAT MAX F °F IN	'D GPN	и EWT °F		MAX PD FT	ROWS		HEMANKS	9665 CHESAPEAKE DRIVE, SUITE 230 SAN DIEGO, CA 92123 TEL(619)618–2347
0	600	600	24.6	55	90 0.8	2.5	180	160	0.8	1	-		STRUCTURAL: SUN STRUCTURAL ENGINEERING 2091 LAS PALMAS DRIVE, SUITE D
F	FAN MARK	ENVIRCO	CTURER DEL	LOCATION BSC ROOM	SIZE	CFM 300	HP 1/3	ELECTRIC VOLT 120	PH	WEIGHT LBS 54	2	REMARKS	CLUSED ARCHIER CHANTCHIER TO THE CHANTCHIER TO THE OF CALLFORNING
	FF-3	ENVIRCO LEDC -	, MAC-10 · RSRE	ANTE ROOM	2"x2"	365	1/3	120	1	54	1 2		OF CAL Of CAL Image: Complex state 10-09-17
	FF-4 FF-5	ENVIRCO LEDC - ENVIRCO	RSRE	ANTE ROOM	2"x2"	365	1/3	120	1	54	1 2		Image: Design changes 10-09-17 Image: Design changes 0shpd comments 12-11-17
	FF-6	LEDC - ENVIRCO LEDC -	, MAC-10	ANTE ROOM	2"x2" 2"x2"	250 250	1/3	120	1	54	2		4 DESIGN CHANGES 12-11-17 5 OSHPD COMMENTS 5-15-18 5 OSHPD COMMENTS 5-15-18
	FF-7	ENVIRCO LEDC -	, MAC-10	ANTE ROOM	2"x2"	250	1/3	120	1	54	2		design changes 6-05-18
1		RCULATED AIR.		IDE WITH BACNET		RFACE.	1						
E	EXIS	STING I	FAN F	ILTER B	OX								
	MARK	MANUFAC & MODE		LOCATION	SIZE	CFM _		ELECTRICAL		WEIGHT		REMARKS	REV: DESCRIPTION: DATE:
	(E) FF-1	ENVIRCO -		/ PREP ROOM		600	HP	VOLT	PH	LBS			P2S Engineering, Inc. 9665 Chesapeake Dr., Suite #230
	(∟) + 1 - 1	ENVIRCO -		PREP ROOM	2"x4"	600	1/3	120		71 -	-		San Diego, CA 92123 T 619.618.2347 F 619.330.0668
	GRI	LLES. I	REGIS	TERS, D	DIFFUS	ERS							www.p2seng.com
	MARK			MATERIAL	STYLE		BLADES	DAMPER	FI	INISH		REMARKS	_ OSHPD #: S171641-37-00
	EG-1	PRICI	E 530	STEEL	SIDEWALL	HORIZ	ZONTAL	N/A	1	-			
	EG-2	PRICE	PDDR	STEEL	LAY-IN		-	N/A	1	-			
	RG-1	PRIC	E 530	STEEL	SIDEWALL	HORIZ	ZONTAL	N/A	1	-			
1		RDINATE WITH /	ARCHITECT.										
													SHEET TITLE: SCHEDULES
													PROJECT TITLE:
													TCMC USP 800
													PROJECT #: 01667.00 SHEET NUMBER: DRAWN BY: ED
													CHECKED BY: SJ SCALE: NO-02
I								I					DATE: 07/31/17 OF

														SFEIR
														ARCHITECTS
	AIR CH	ANGES	OUTSIDE AIR	EXHAUS (AC/HR)	T PRESSURE RELATIONSHIF TO ADJACENT	ROOM SUPPLY (CFM)	EXHAL	JST	RETURN	AIR CHANGES	OUTSIDE AIF	R EXHAUST	REMARKS	F: 619-299-5084
	33	.75 1	-	33.75										TCMC
	2	8 7	2	-										PHARMACY
Abs-A Tri-City Medical Cer 00				1										UPGRADE
		1											REMARKS	Tri-City Medical Cente
Physical biology Physical biology <th< td=""><td>CFM</td><td>CFM</td><td>1 CFM</td><td>MBH</td><td>°F</td><td>°F IN</td><td>GPM</td><td>°F</td><td>°F</td><td>FT</td><td>ROWS</td><td></td><td></td><td></td></th<>	CFM	CFM	1 CFM	MBH	°F	°F IN	GPM	°F	°F	FT	ROWS			
												-		-
														OCEANSIDE, CALIFORNIA 92056
VILION VILIANT				_										5151 SHOREHAM PLACE, SUITE 100
		AIRFLO) W		AIRSIDE		HEATING	COIL	WATER	SIDE			REMARKS	TEL(619)299-3917 FAX(619)299-5084
vict vict <th< td=""><td></td><td></td><td></td><td></td><td></td><td></td><td>GPM</td><td></td><td></td><td></td><td>ROWS</td><td></td><td></td><td>9665 CHESAPEAKE DRIVE, SUITE 230 San Diego, ca 92123</td></th<>							GPM				ROWS			9665 CHESAPEAKE DRIVE, SUITE 230 San Diego, ca 92123
	600	600	600	24.6	55	90 0.8	2.5	180	160	0.8	1	-		STRUCTURAL: SUN STRUCTURAL ENGINEERING
		FAN	FILTE	R BO	X									CARLSBAD, CA 92011 TEL(760)438–1188
									ELECTRI	CAL	WEIGHT			A LUG A A LUG A A A A A A A A A A A A A A A A A A A
Image: Non-out of the state from the state of the st		MARK			LOCATION	SIZE	CFM	НР	VOLT	- PH	LBS		REMARKS	★ No. C 28543 7 ★ No. C 28543 7 ★ No. M29400 07/31/17 ★
IT 0 1000000000000000000000000000000000000	_	FF-2	LEDC -	RSRE	BSC ROOM	2"x2"	300	1/3	120	1	54	2		
wide Line wide	-		LEDC -	RSRE		+ +								Image: Comments 10-09-17
	-		LEDC - ENVIRCO	- RSRE , MAC-10		+ +								$\begin{array}{c c} \hline & \hline \\ \hline \\$
		FF-6	ENVIRCO	, MAC-10	ANTE ROOM	2"x2"	250	1/3	120	1	54			
		FF-7			ANTE ROOM	2"x2"	250	1/3	120	1	54	2		6-05-18
							ACE. Z	<u>17</u>						
	-	EXI	STING											
		MARK	&		LOCATION	SIZE	CFM	El	ECTRICAL		WEIGHT		REMARKS	
	_		MODE					HP	VOLT	PH	LBS			CONSULTANT
		(E) FF-1	ENVIRCO -	LEDC	V PREP ROOM	2"x4"	600	1/3	120	1	71 -			San Diego, CA 92123
MARK DESCRIPTION MATERIAL STYLE FRONT BLADES DAMPER FRNSH REMARKS LEG1 PRICE BODR STEEL SIDEWALL HORIZONTAL NA 1 - I COORDINATE WITH ARCHITEGT. STEEL SIDEWALL HORIZONTAL NA 1 - - I COORDINATE WITH ARCHITEGT. STEEL SIDEWALL HORIZONTAL NA 1 - - SCHEDULES PROCE 700R STEEL SIDEWALL HORIZONTAL NA 1 -	Г	CDI					DC							www.p2seng.com
▲ Image: Composition of the composition of	-													OSHPD #: S171641-37-00
	-													
COORDINATE WITH ARCHITECT.											-			
SHET TILE SCHEDULES PROJECT TILE: TCMC USP 800 PROJECT # 01667.00 PROJECT # 01667.00 PROJ		RG-1	PRIC	E 530	STEEL	SIDEWALL	HORIZ	ONTAL	N/A	1	-			
SCHEDULES PROJECT TITLE: TCMC USP 800 PROJECT # 01667.00 DRAINI BT: ED OHECKED BY: SJ SOLE: SMEET MUMBER: MOD-O2		1 COO	RDINATE WITH /	ARCHITECT.										
PROJECT TILE: TCMC USP 800 PROJECT #: 01667.00 DRAWN BY: ED CHECKED BY: SJ SCALE:														
TCMC USP 800														SCHEDOLLS
TCMC USP 800														
DRAWN BY: ED CHECKED BY: SJ SCALE: MOD-02														
DRAWN BY: ED CHECKED BY: SJ SCALE: SJ														PROJECT #: 01667.00 SHEET NUMBER:
														ED
07/31/17 OF														DATE:

 

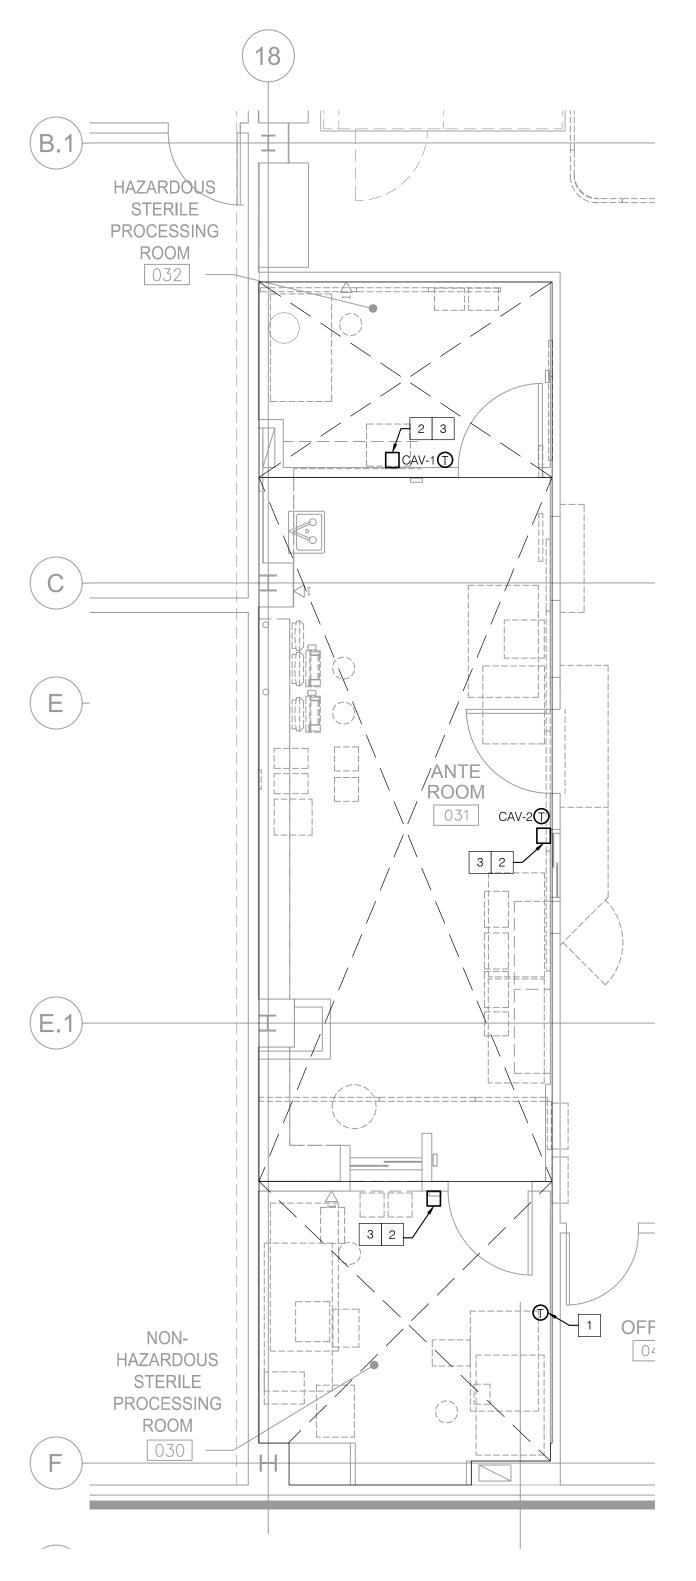

NOTES

- 1 THERMOSTAT FOR (E) CAV-3.
- 2 ANALOG TYPE PRESSURE MONITOR TO MEASURE PRESSURE BETWEEN 0.01 IN. OF W.C. TO 0.05 IN. OF W.C. WITH PLUS OR MINUS 2% ACCURACY. PRESSURE MONITOR TO BE MOUNTED ON WALL.

3 HUMIDITY LEVEL MONITORS.

KEY PLAN

SCALE: 1/4" = 1'-0"



5151 Shoreham Place, Suite 100 San Diego, Ca 92122

P: 619-299-3917 F: 619-299-5084 www.sfeirarch.com

TCMC PHARMACY USP 800 UPGRADE

Tri-City Medical Center





100% CONSTRUCTION DOCUMENT

07/31/17


SCALE:

DATE:

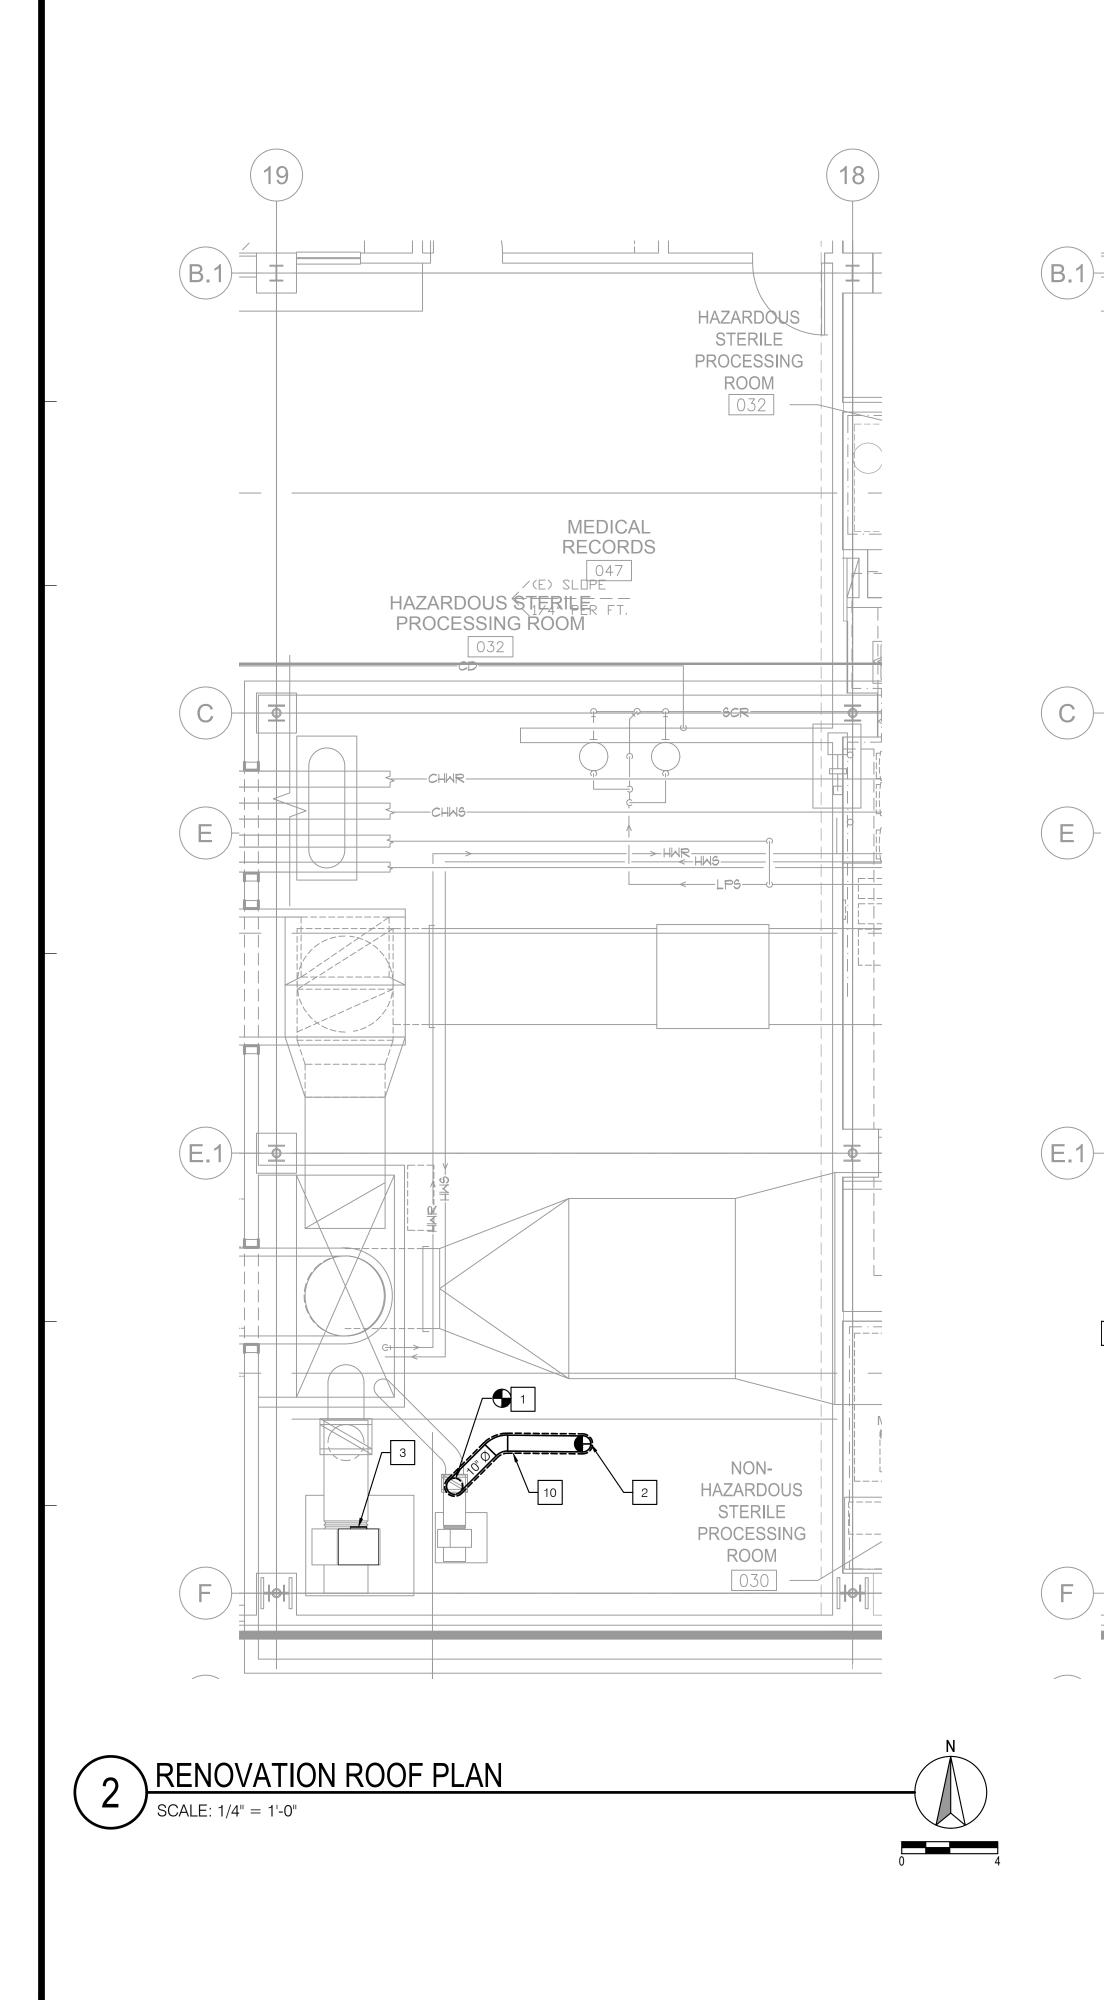


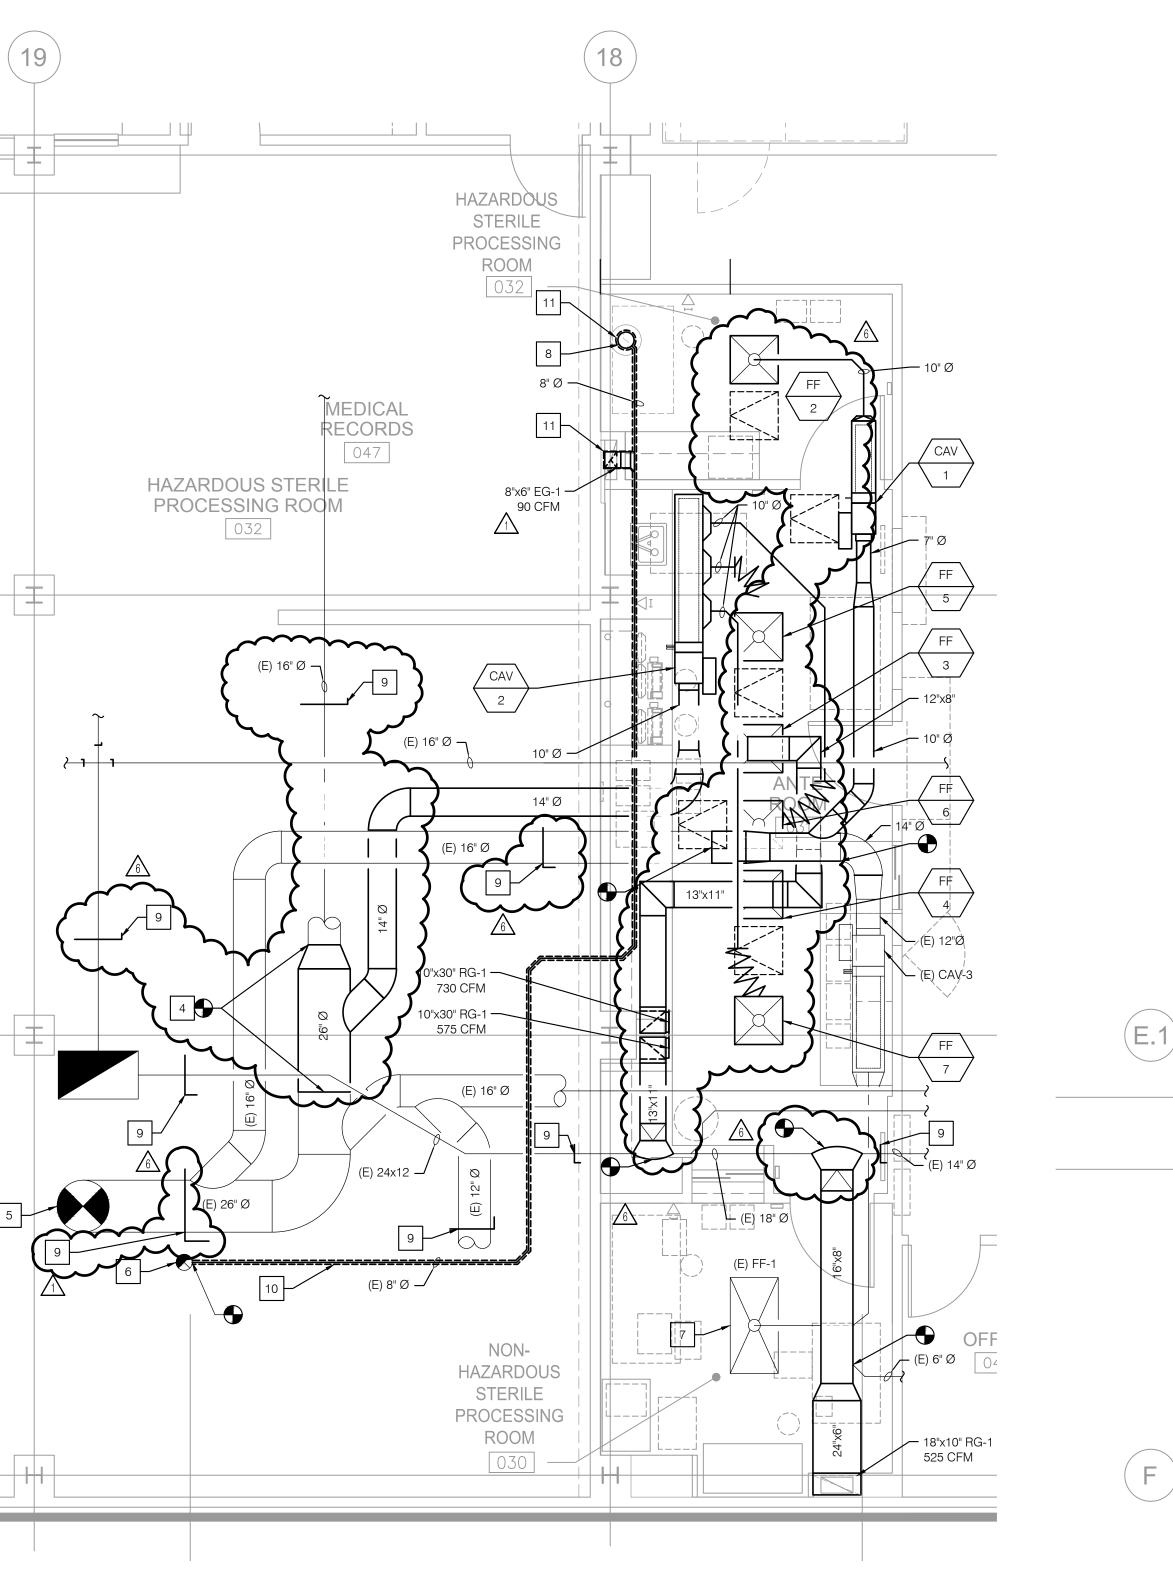

RENOVATION FIRST FLOOR PLAN SCALE: 1/4" = 1'-0"

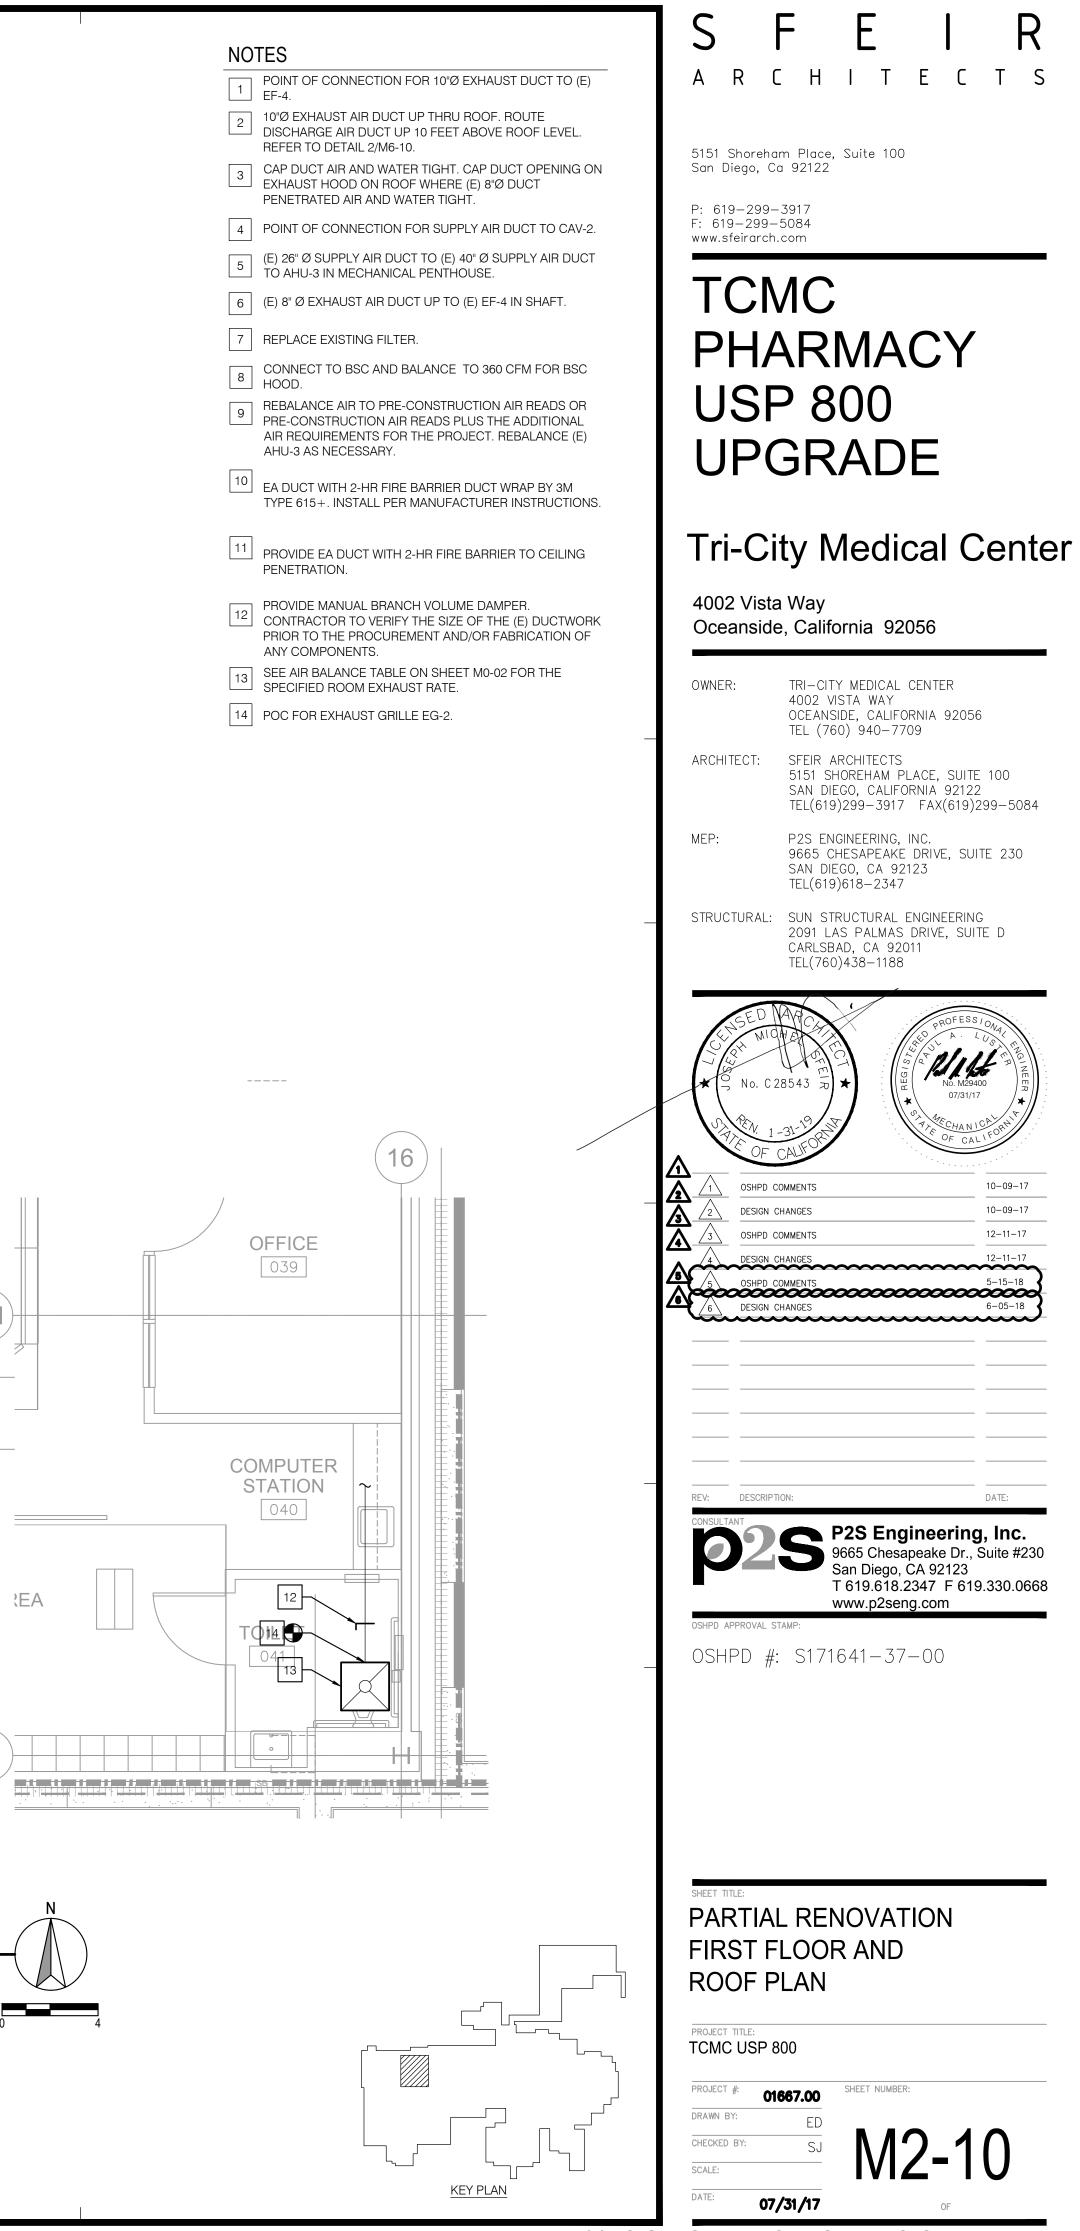

REA

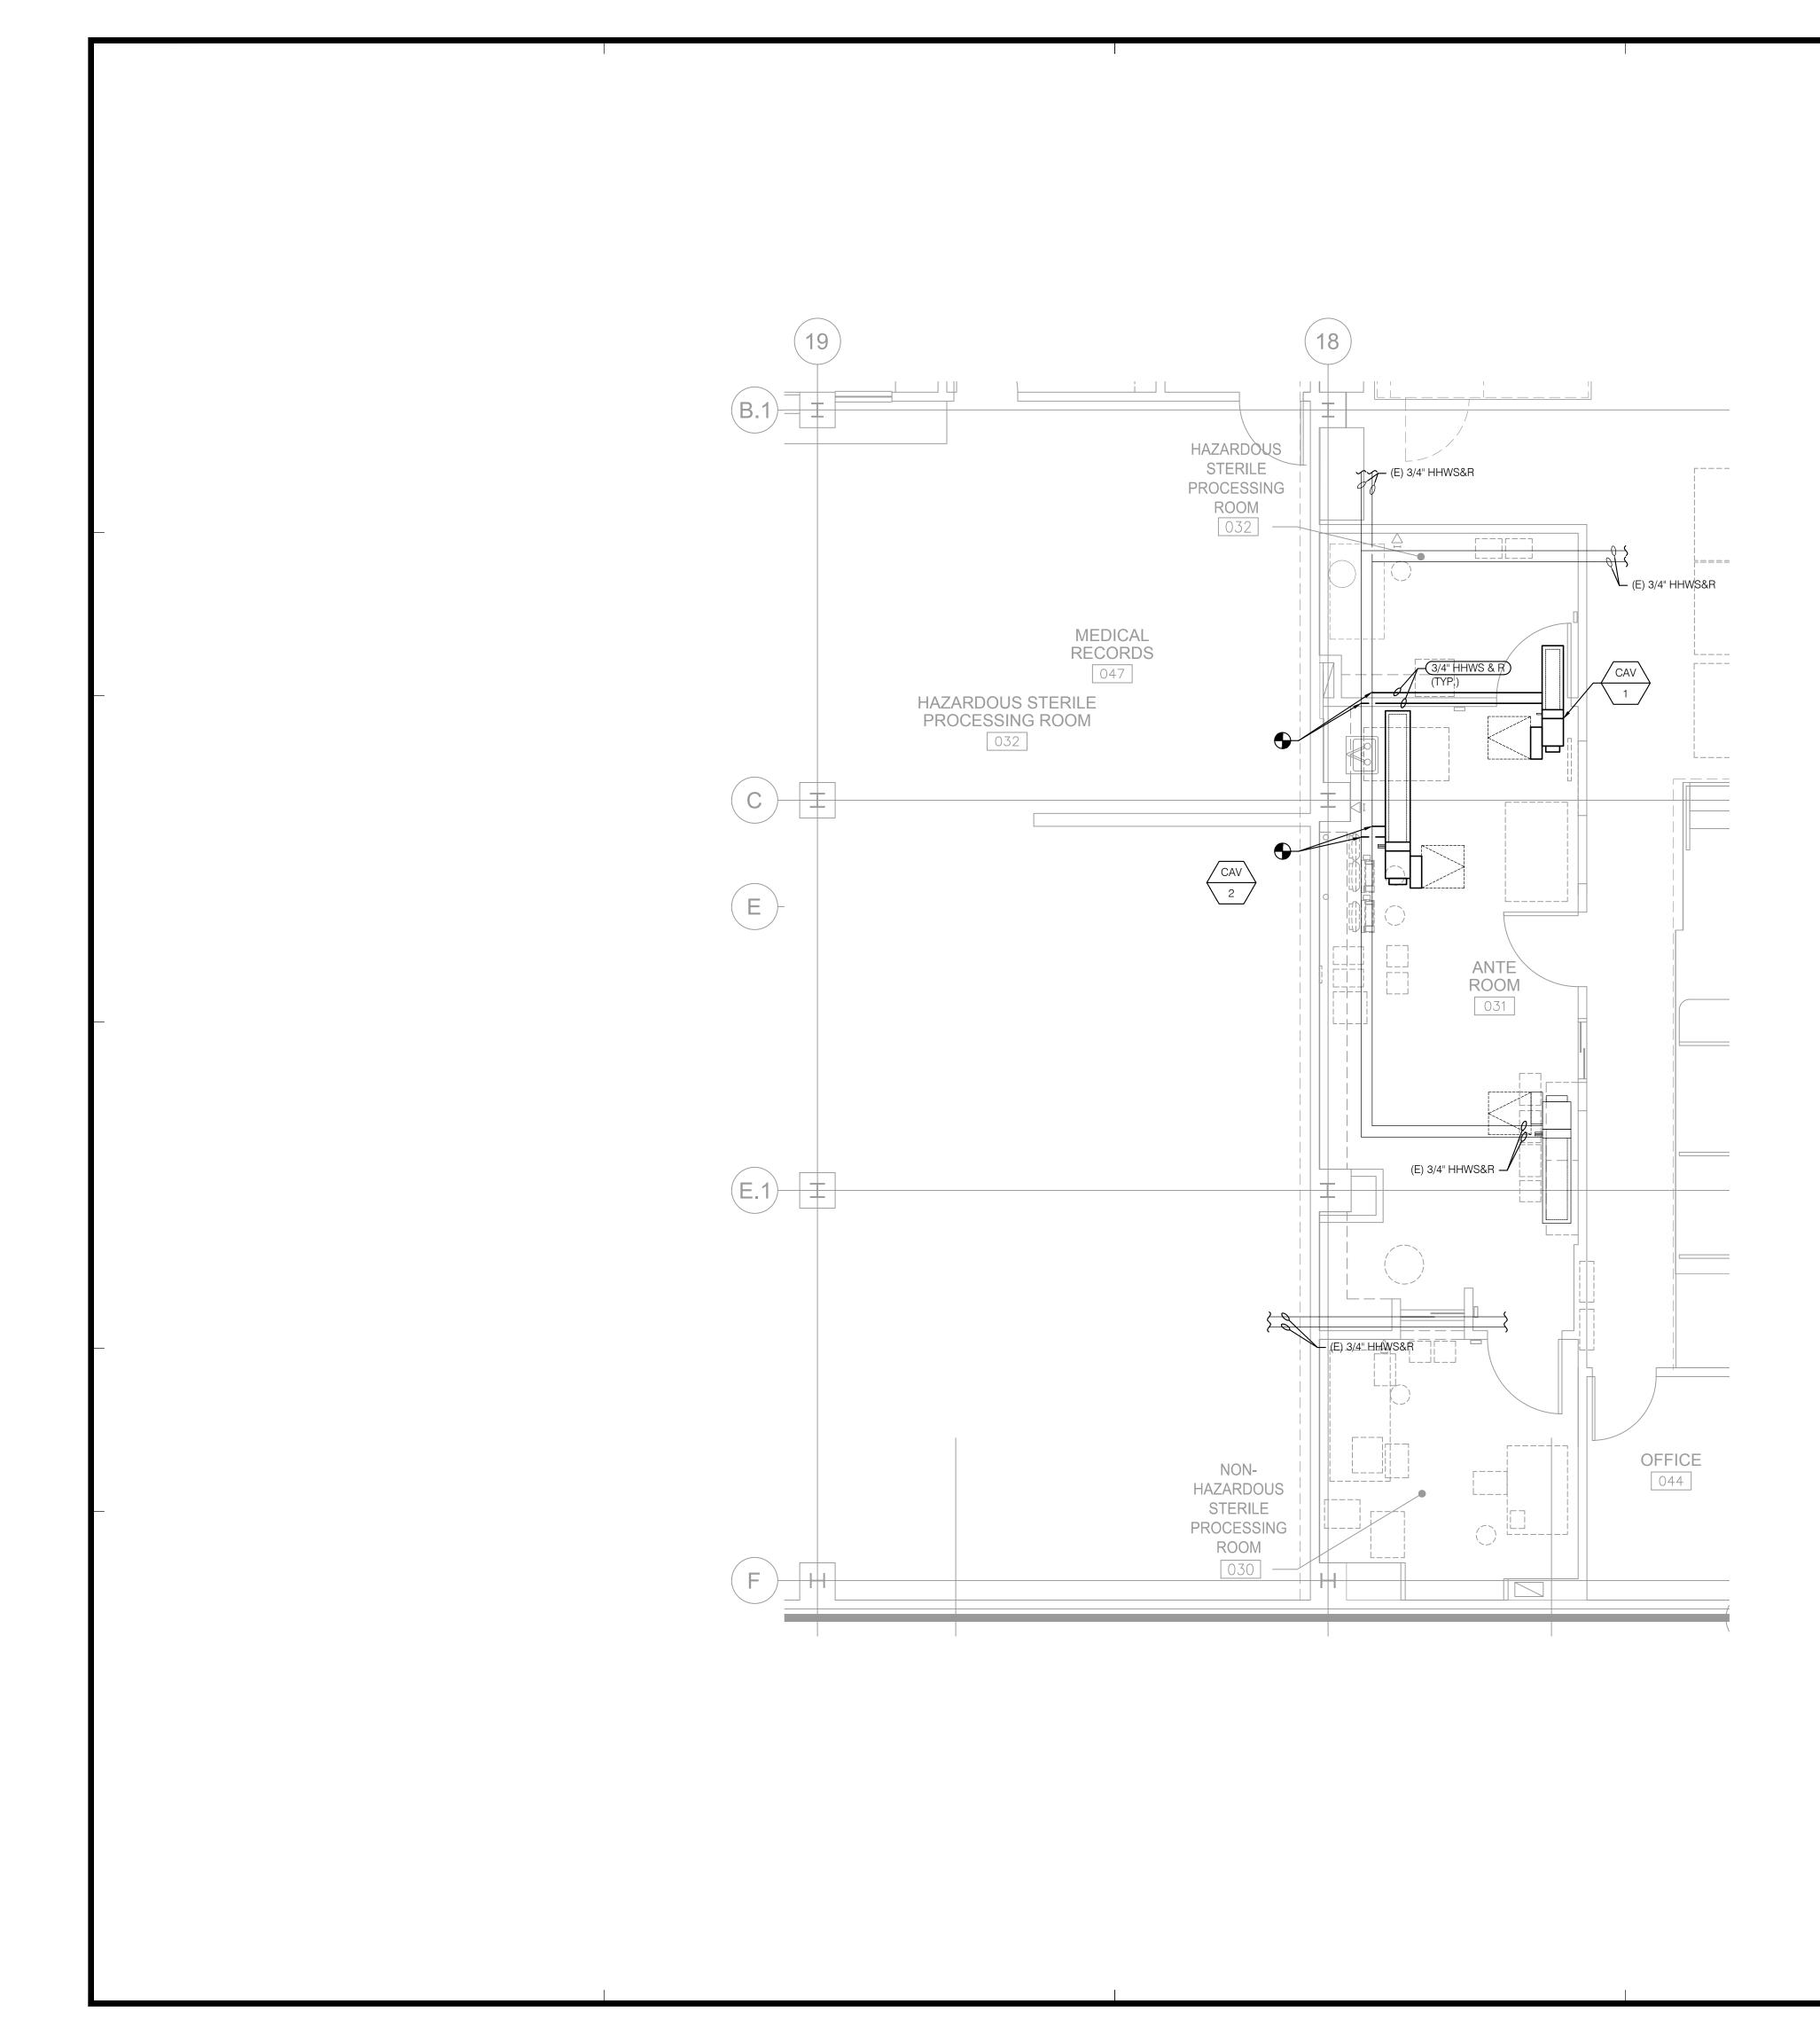

All rights reserved. No part of this work may be reproduced or copied in any form a

	SFEIR ARCHITECTS
	5151 Shoreham Place, Suite 100 San Diego, Ca 92122 D: 610 200 3017
	P: 619-299-3917 F: 619-299-5084 www.sfeirarch.com TCNC
	PHARMACY
	USP 800 UPGRADE
	Tri-City Medical Center
	4002 Vista Way Oceanside, California 92056
	OWNER: TRI-CITY MEDICAL CENTER 4002 VISTA WAY OCEANSIDE, CALIFORNIA 92056 TEL (760) 940-7709
	ARCHITECT: SFEIR ARCHITECTS 5151 SHOREHAM PLACE, SUITE 100 SAN DIEGO, CALIFORNIA 92122 TEL(619)299–3917 FAX(619)299–5084 MEP: P2S ENGINEERING, INC.
_	9665 CHESAPEAKE DRIVE, SUITE 230 SAN DIEGO, CA 92123 TEL(619)618–2347 STRUCTURAL: SUN STRUCTURAL ENGINEERING 2091 LAS PALMAS DRIVE, SUITE D
	CARLSBAD, CA 92011 TEL(760)438-1188
	K No. C 28543 ₹ K K K K K K K K K K K K K K K K K K
_	$\begin{array}{c} & & & \\ \hline & & & \\ \hline & & & \\ \hline \\ \hline$
	$\begin{array}{c ccccccccccccccccccccccccccccccccccc$
_	
	CONSULTANT P2S Engineering, Inc. 9665 Chesapeake Dr., Suite #230 San Diego, CA 92123 T 619.618.2347 F 619.330.0668
_	www.p2seng.com oshpd approval stamp: OSHPD #: S171641-37-00
	SHEET TITLE: PARTIAL RENOVATION HEATING HOT WATER
	FLOOR PLAN PROJECT TITLE: TCMC USP 800
	PROJECT #: 01667.00 SHEET NUMBER: DRAWN BY: ED CHECKED BY: SJ SCALE: SLATE
$\frac{\text{KEY PLAN}}{0}$ $0 \qquad 4$ $\text{SCALE: 1/4" = 1'-0"}$	SCALE: DATE: 07/31/17 OF



GENERAL NOTES

1. CONNECT TO (E) BMS. 2. PROVIDE WITH FAN AND FILTER ALARM.

Ś

SS





FAN FILTER UNIT


P


DPS

HS

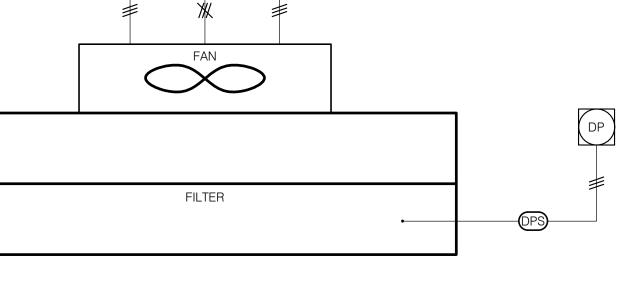

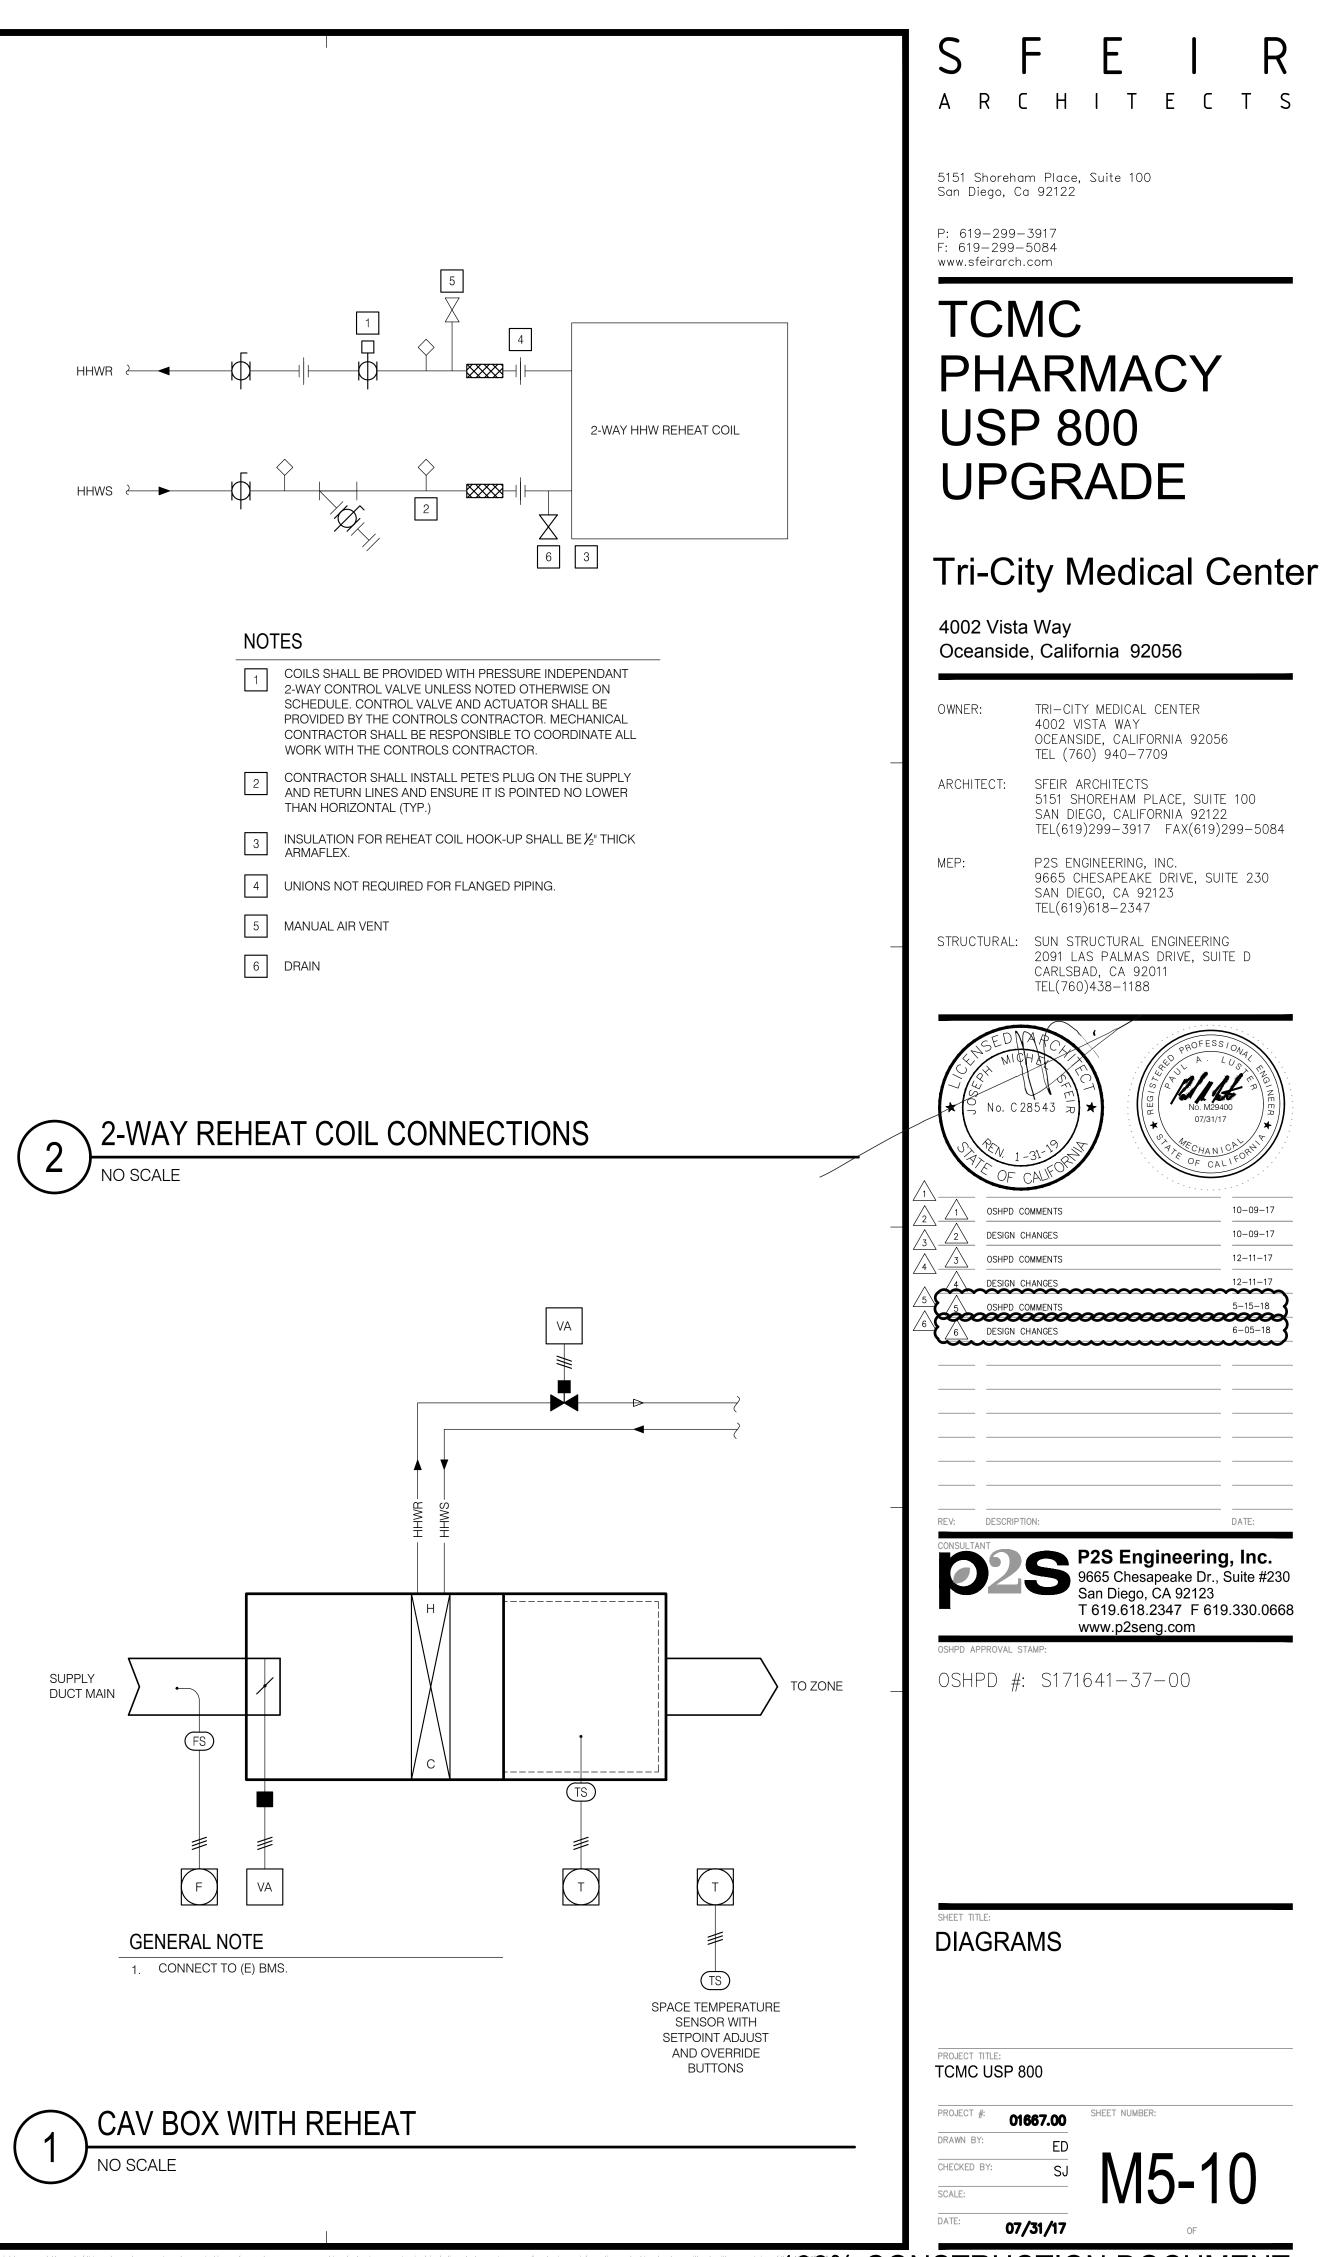


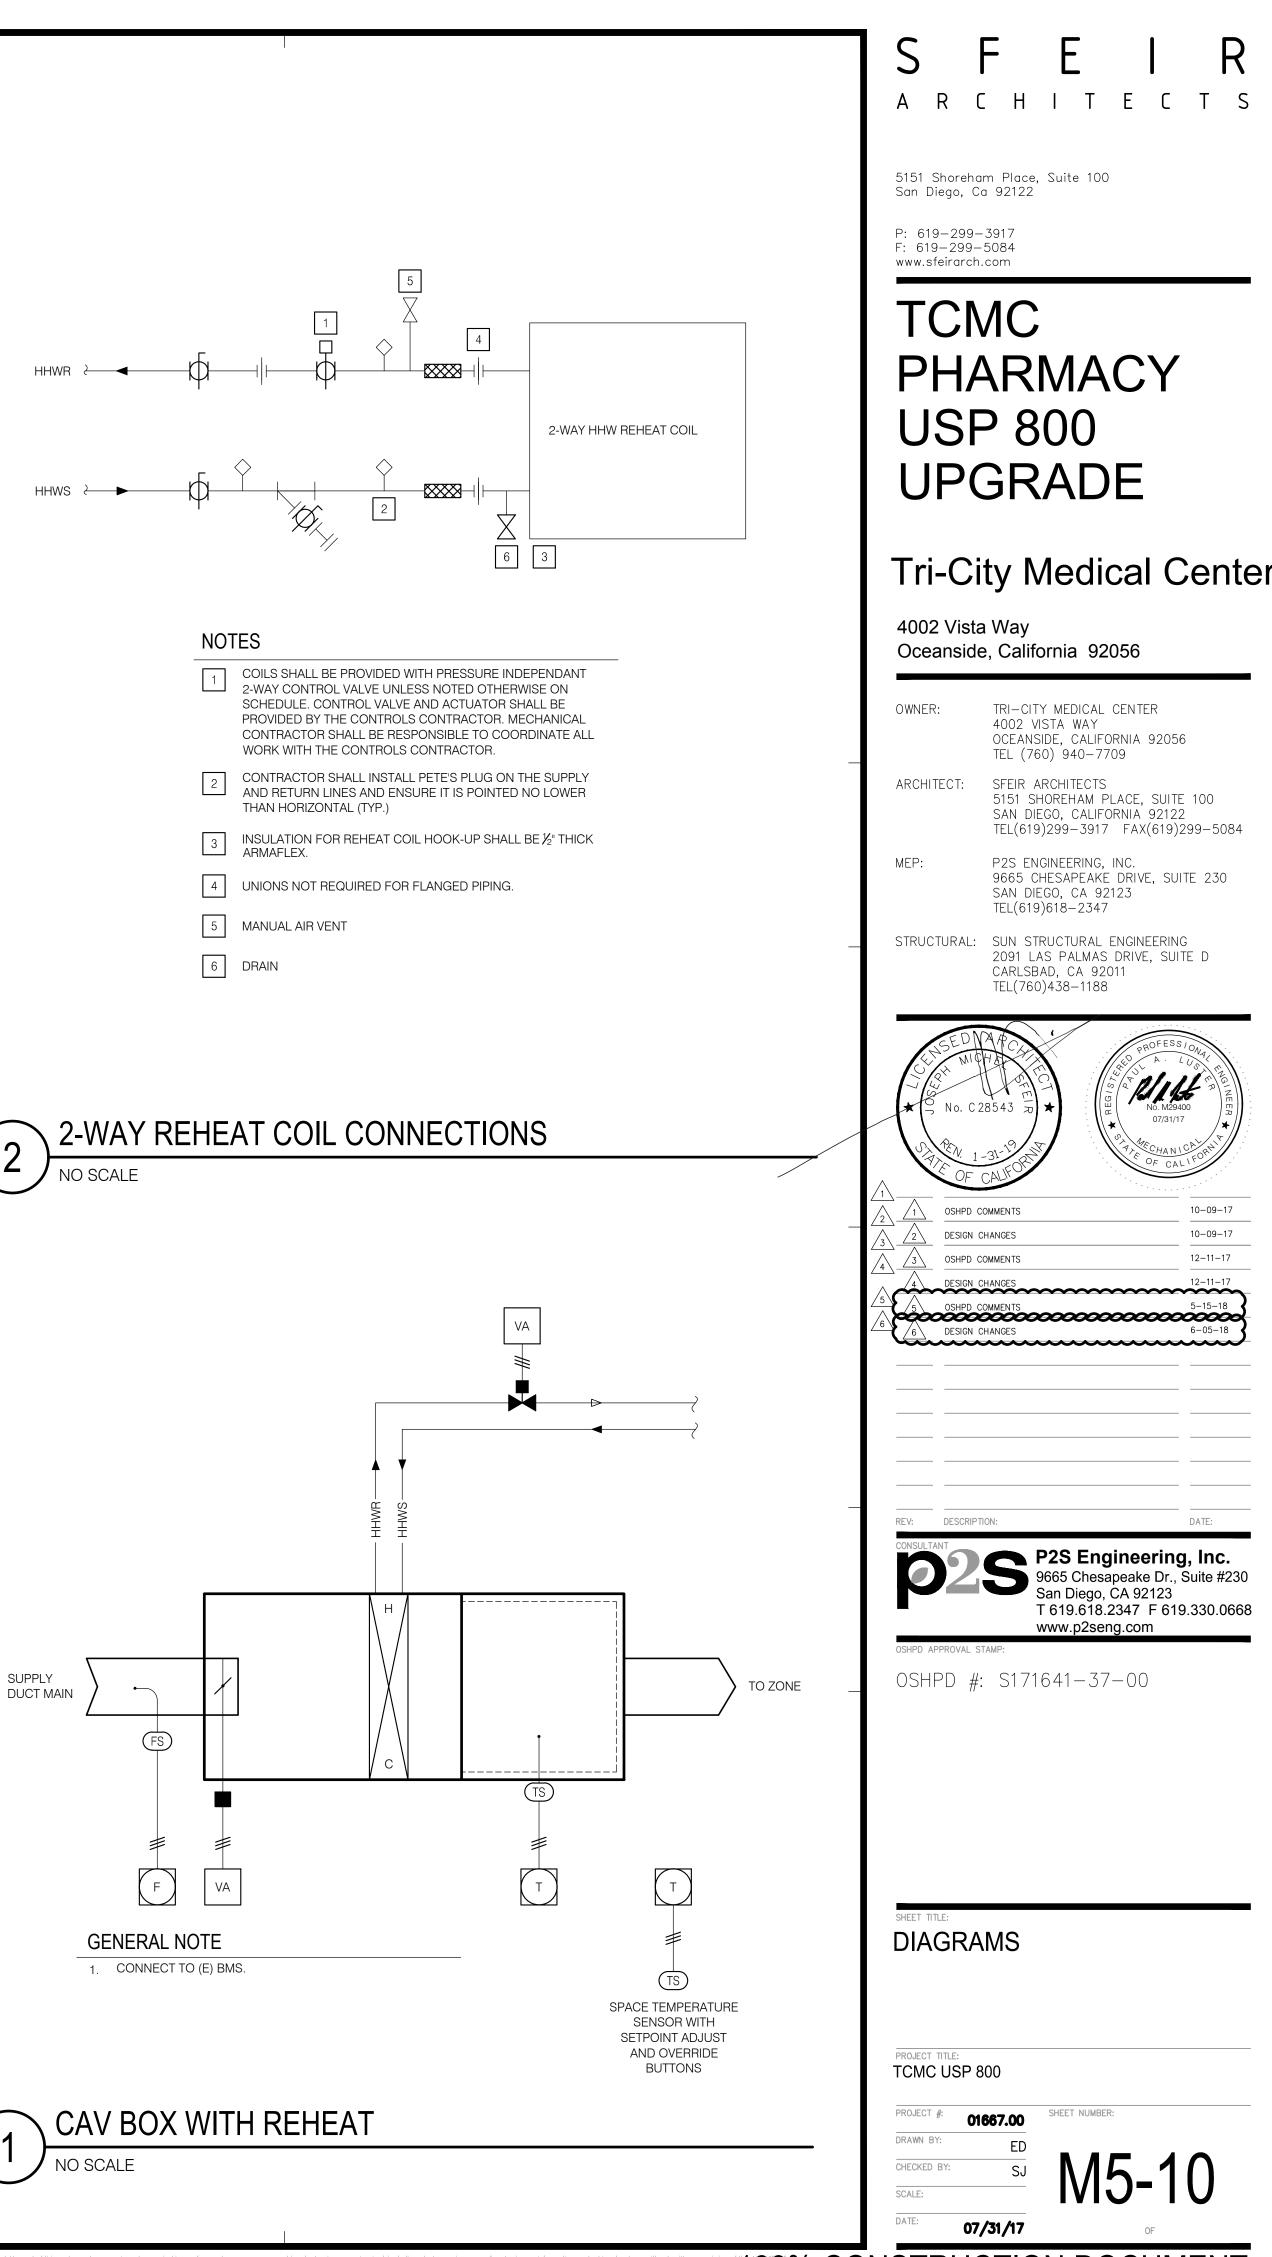


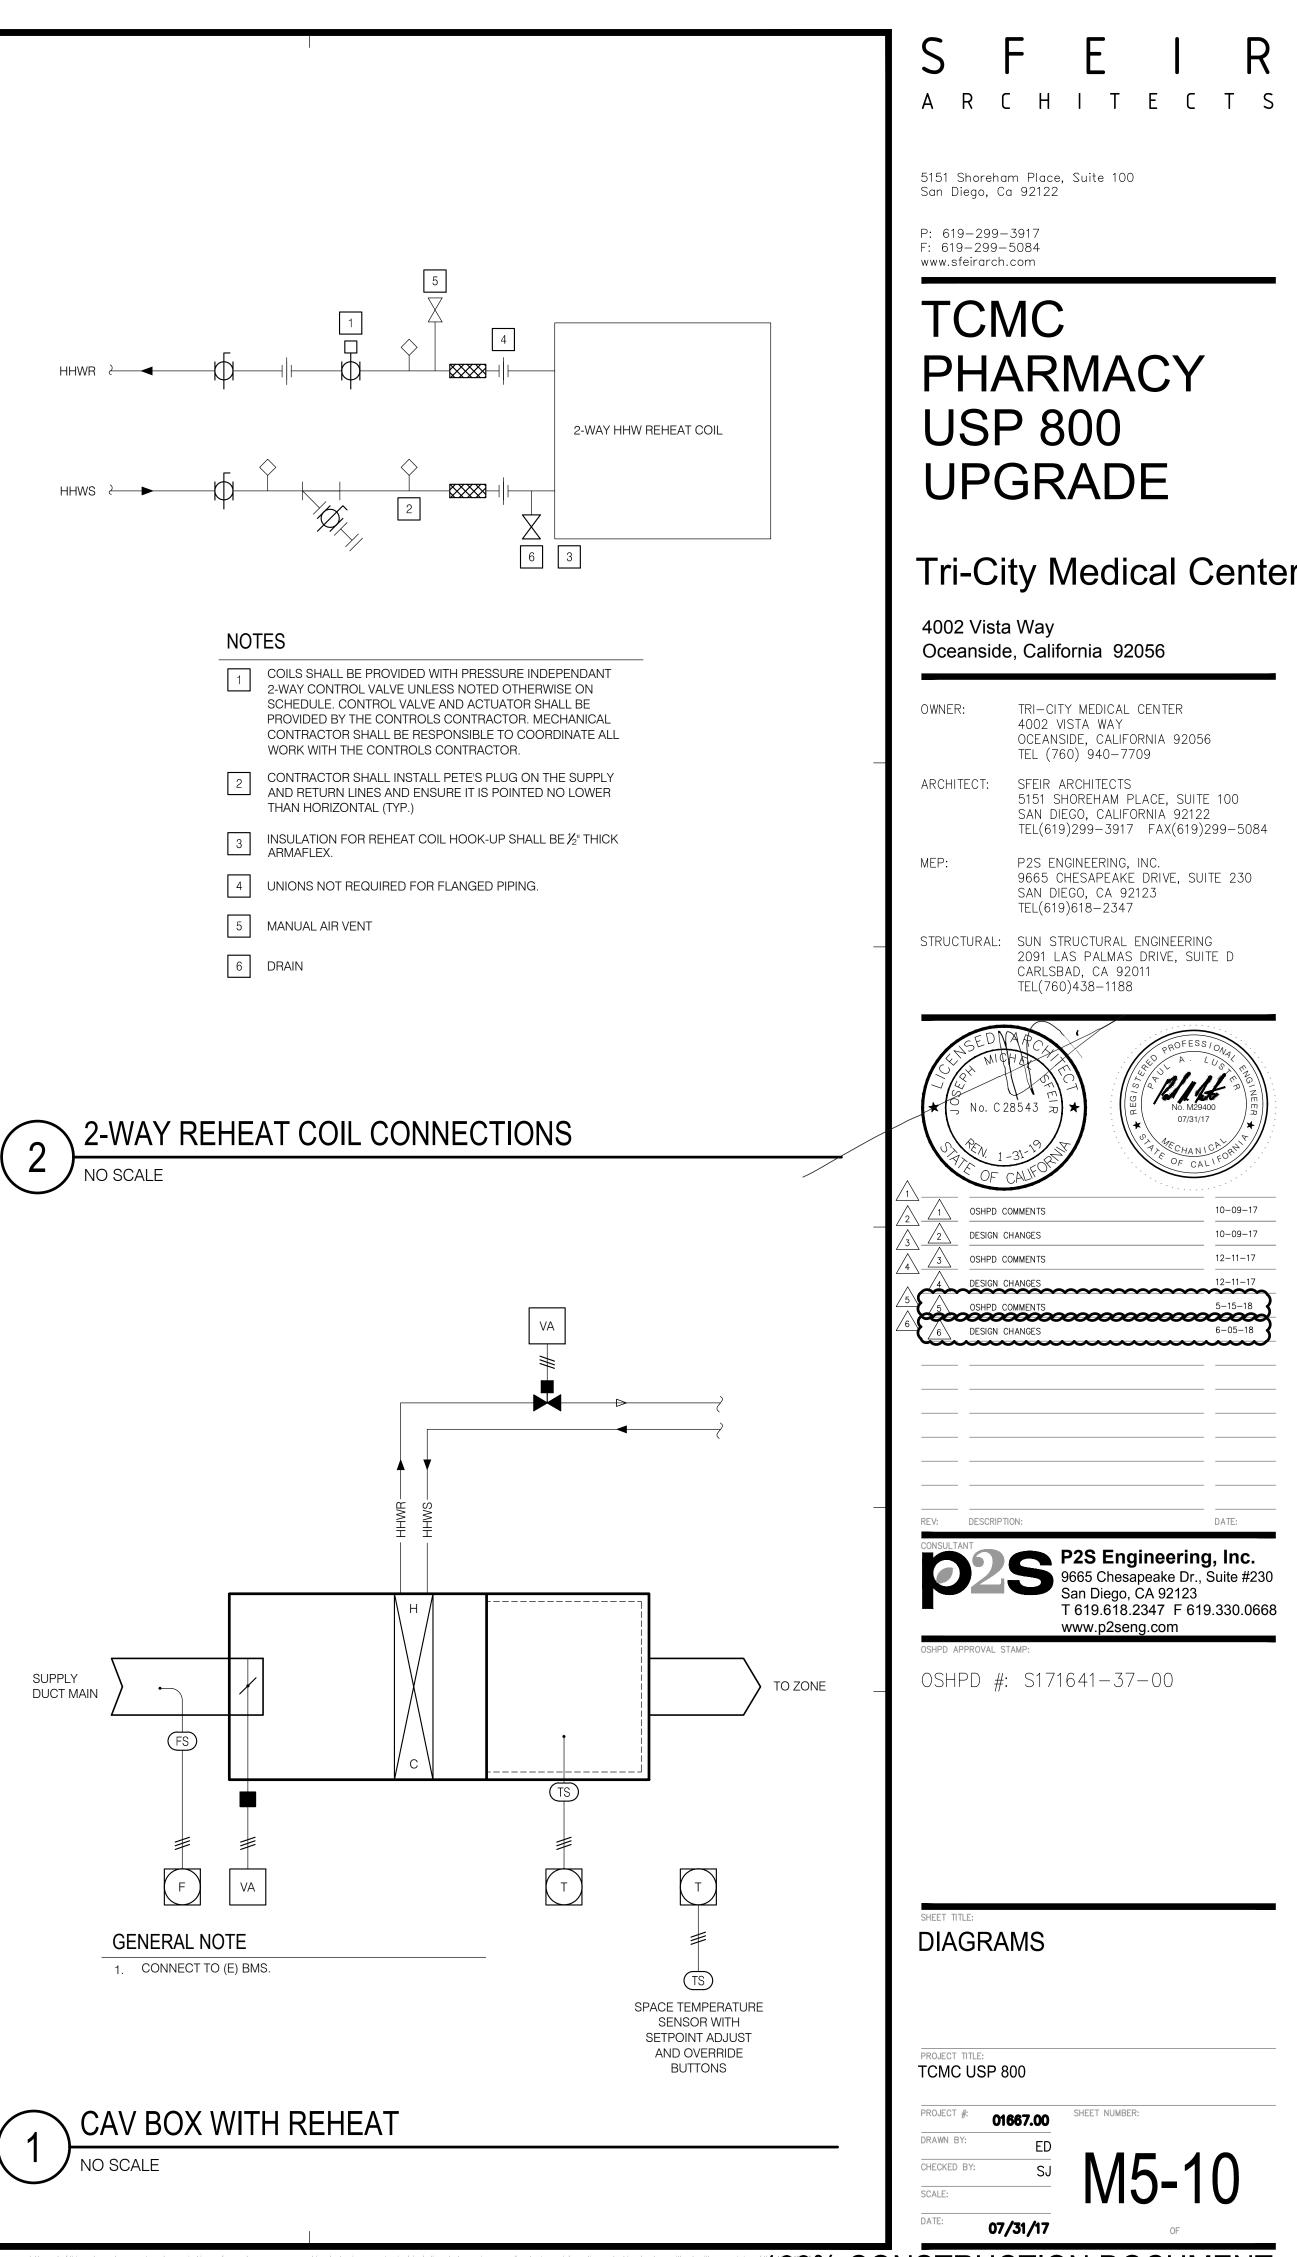



	NOT
	1
	2
	3
	5

HHWR	2	•	-ф-
			_

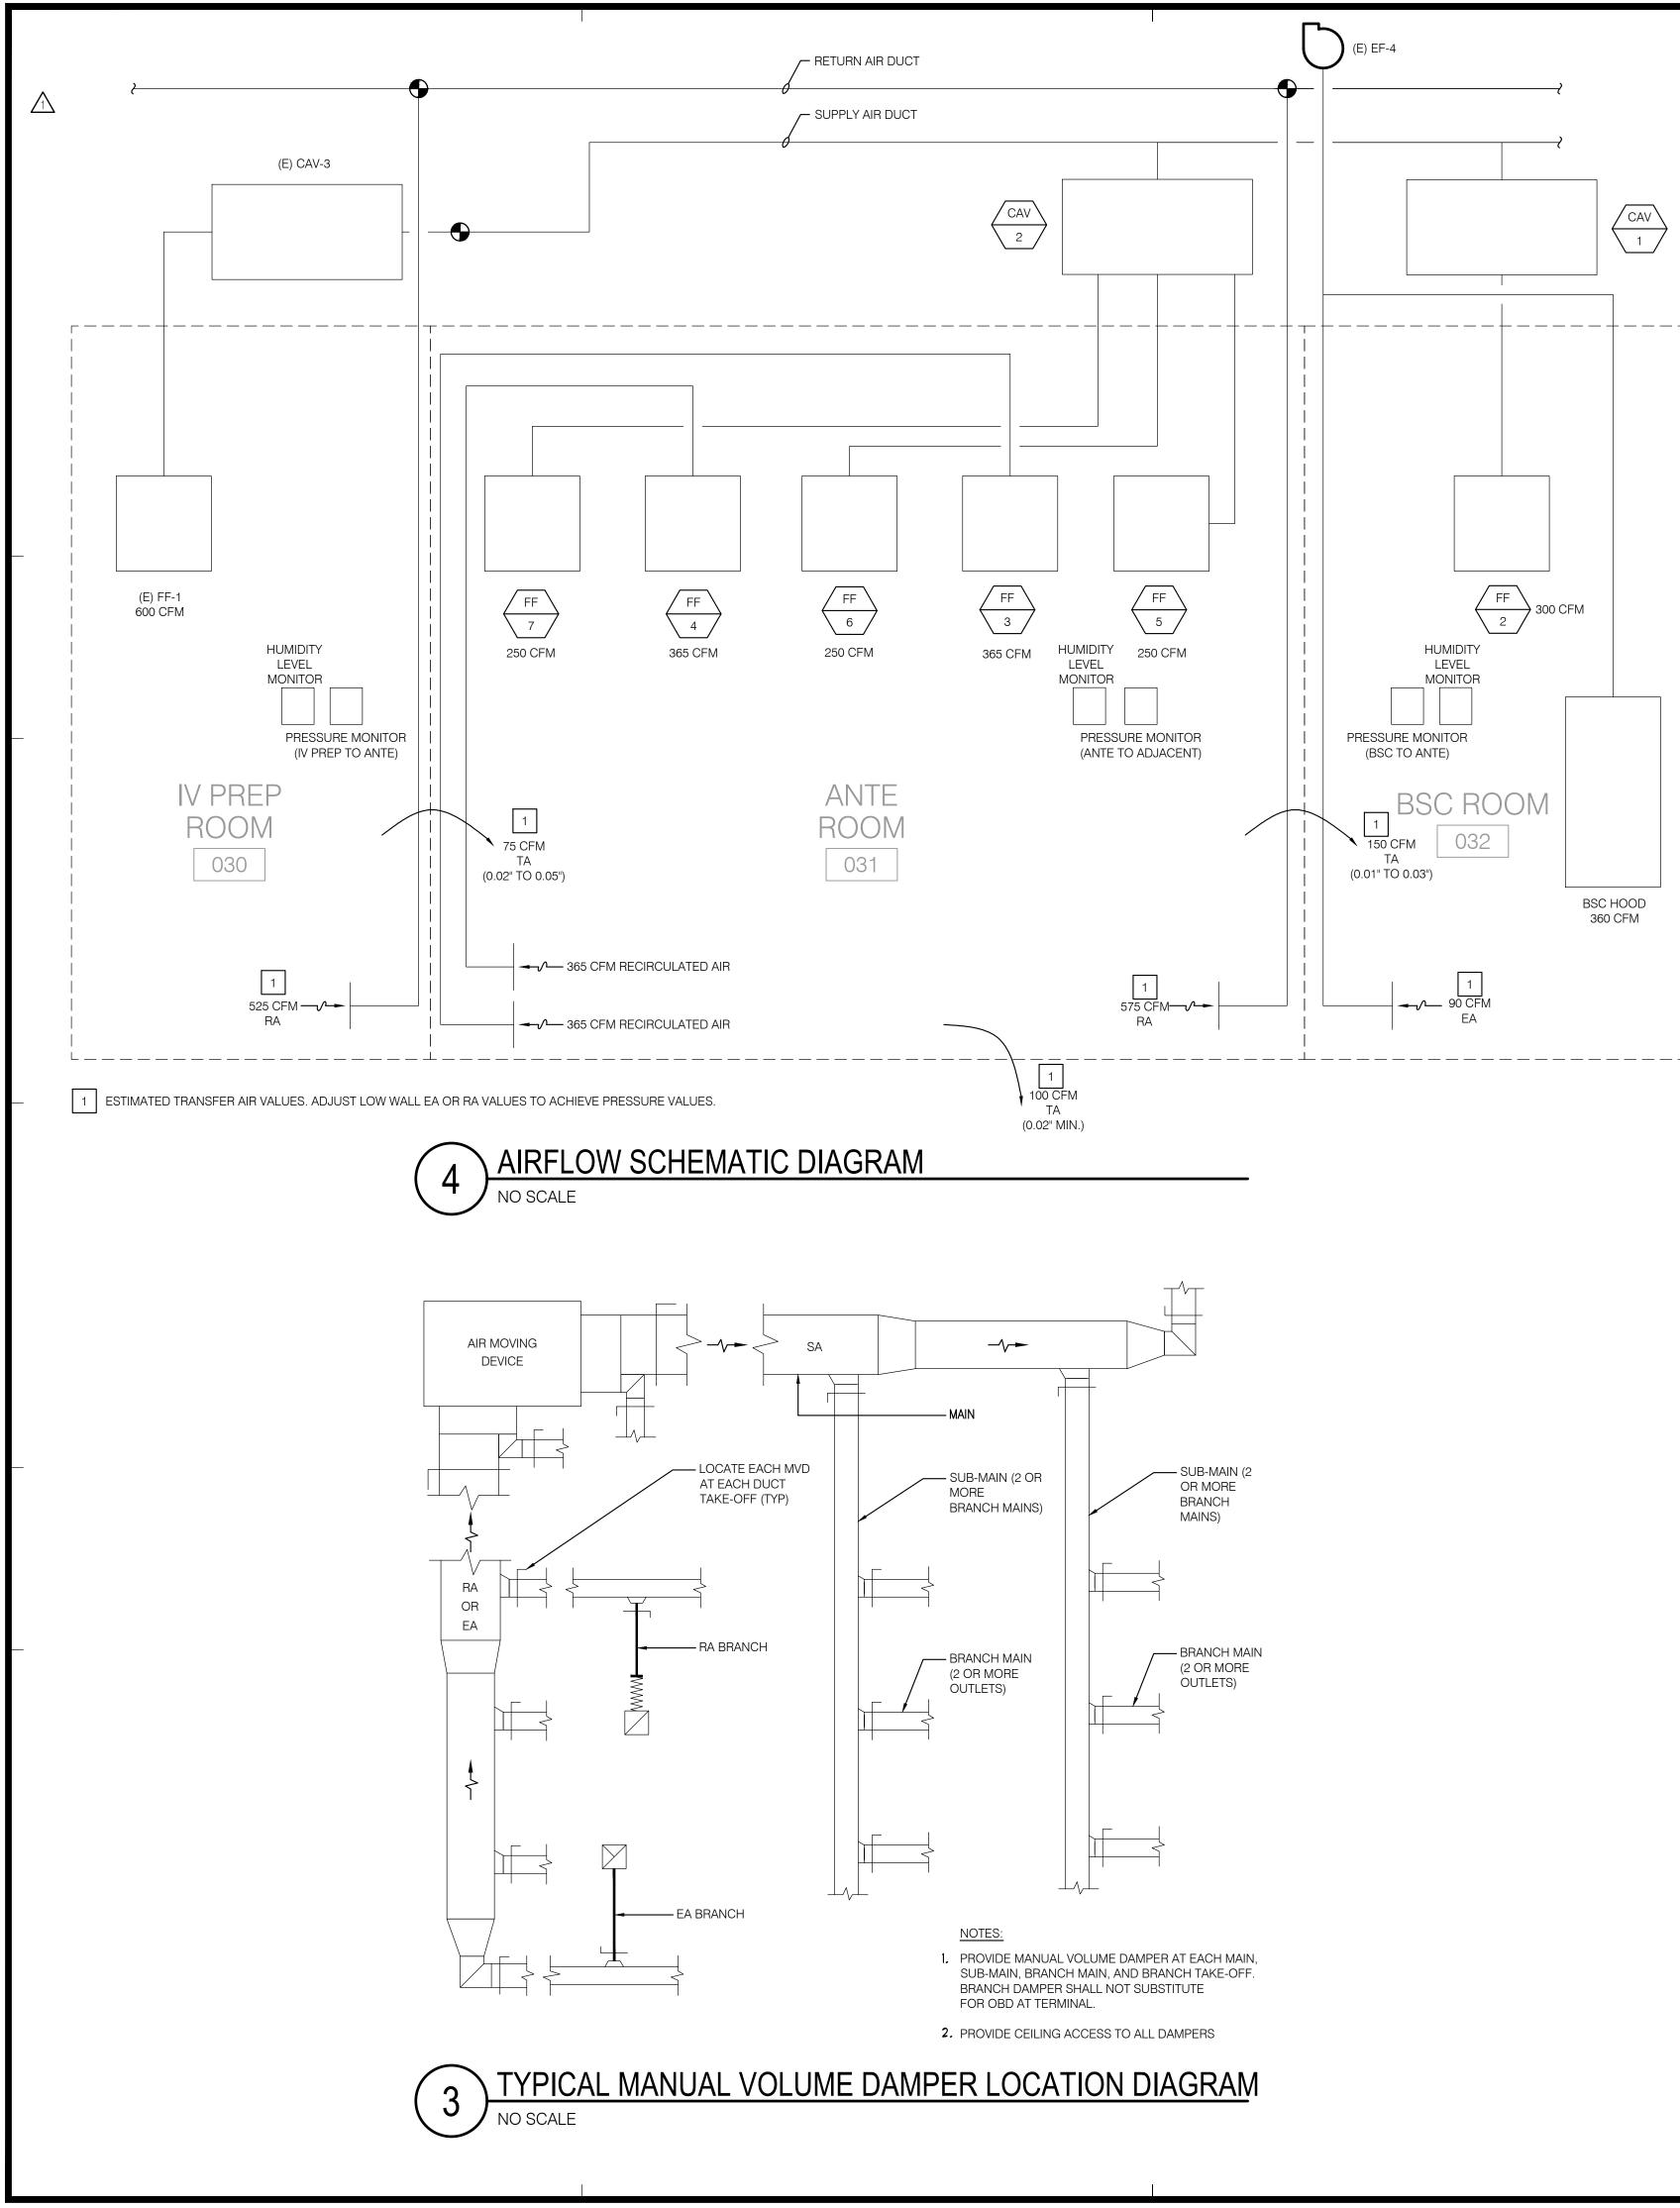

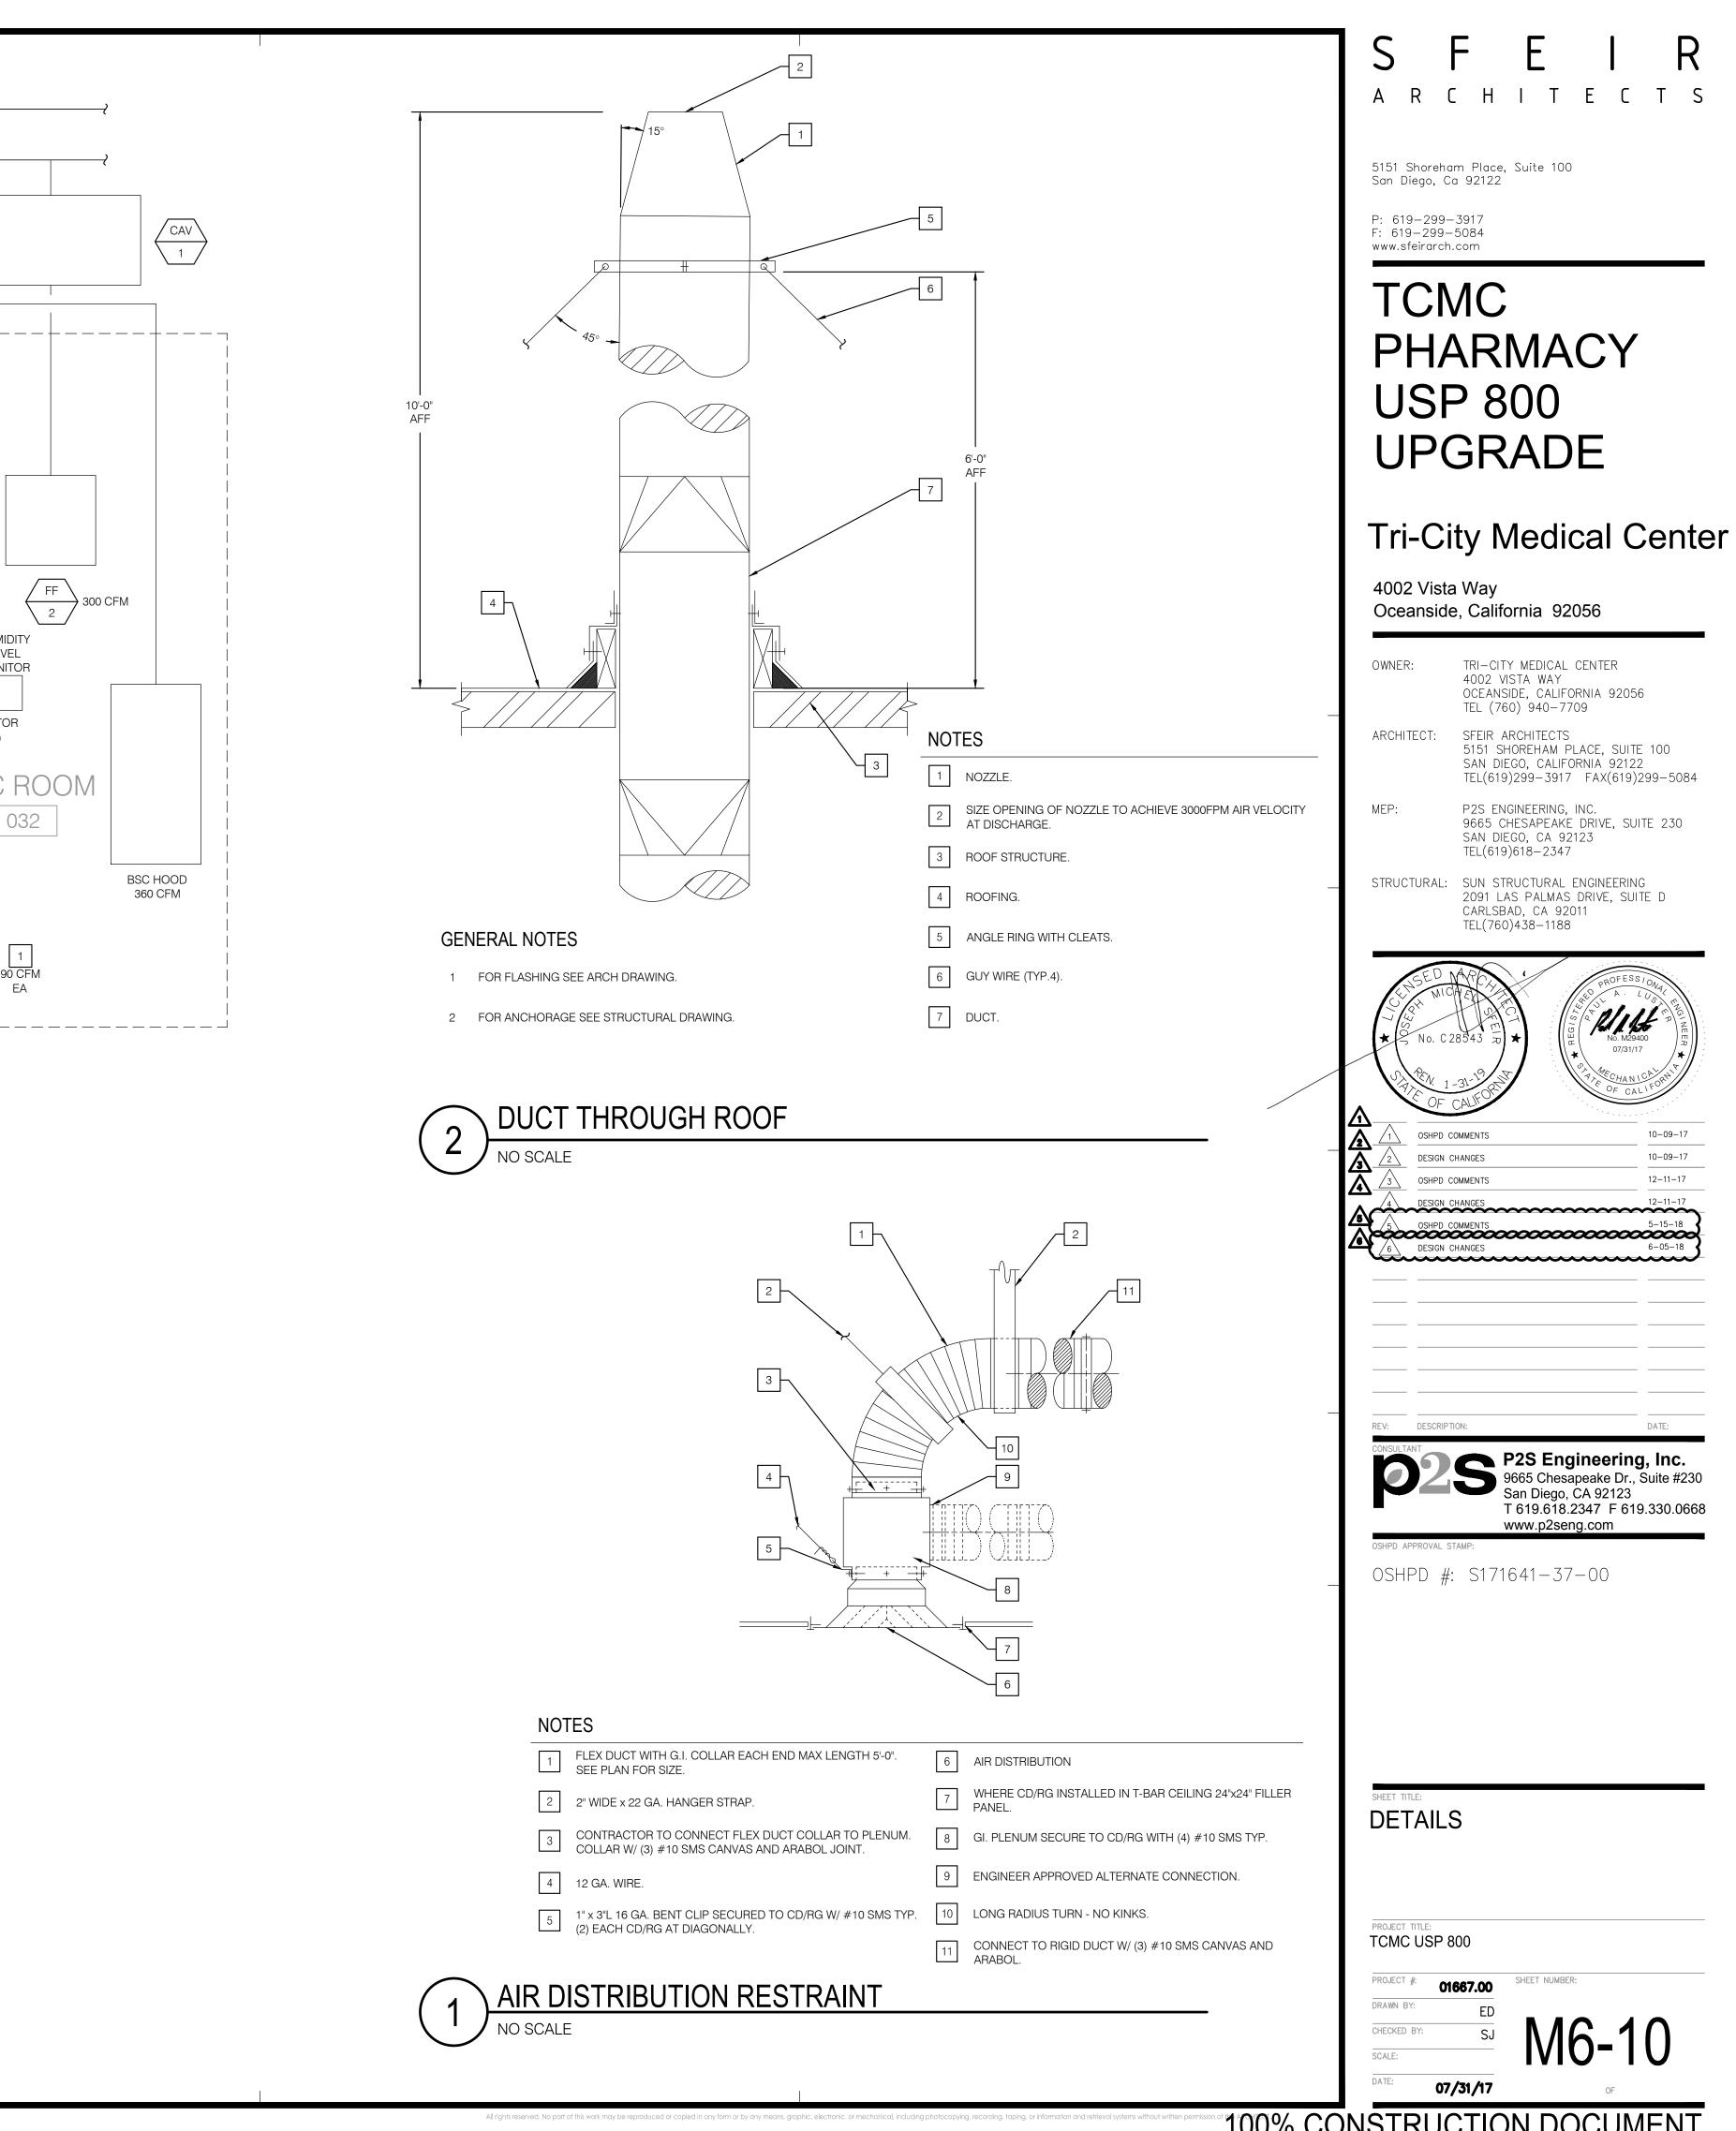


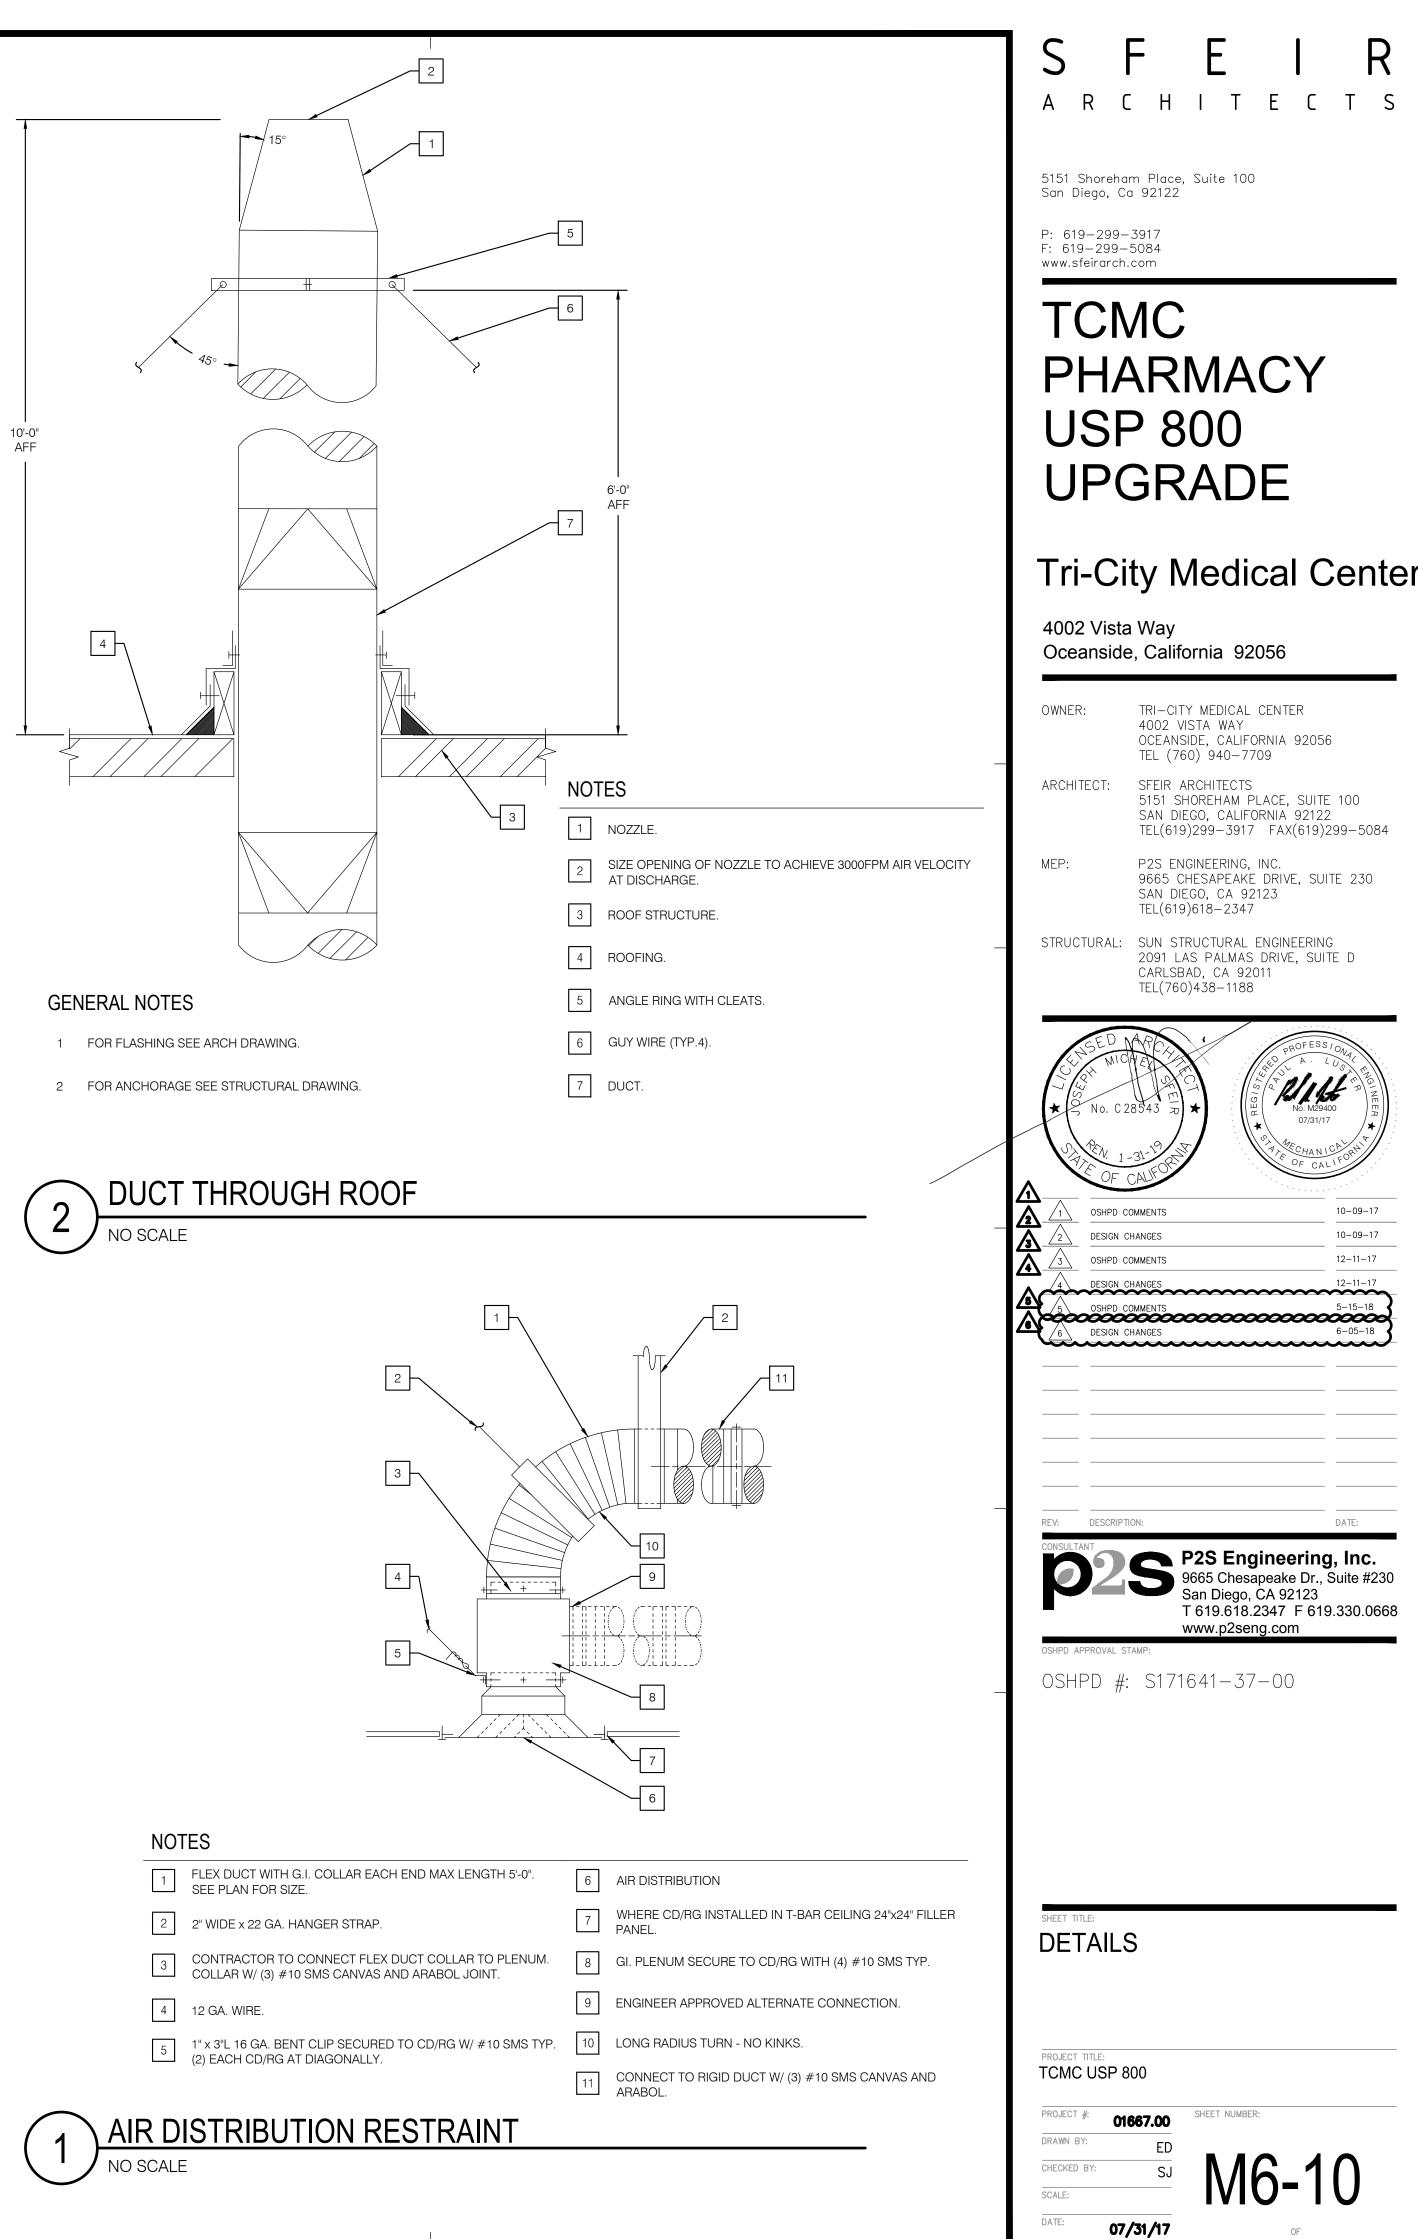


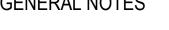





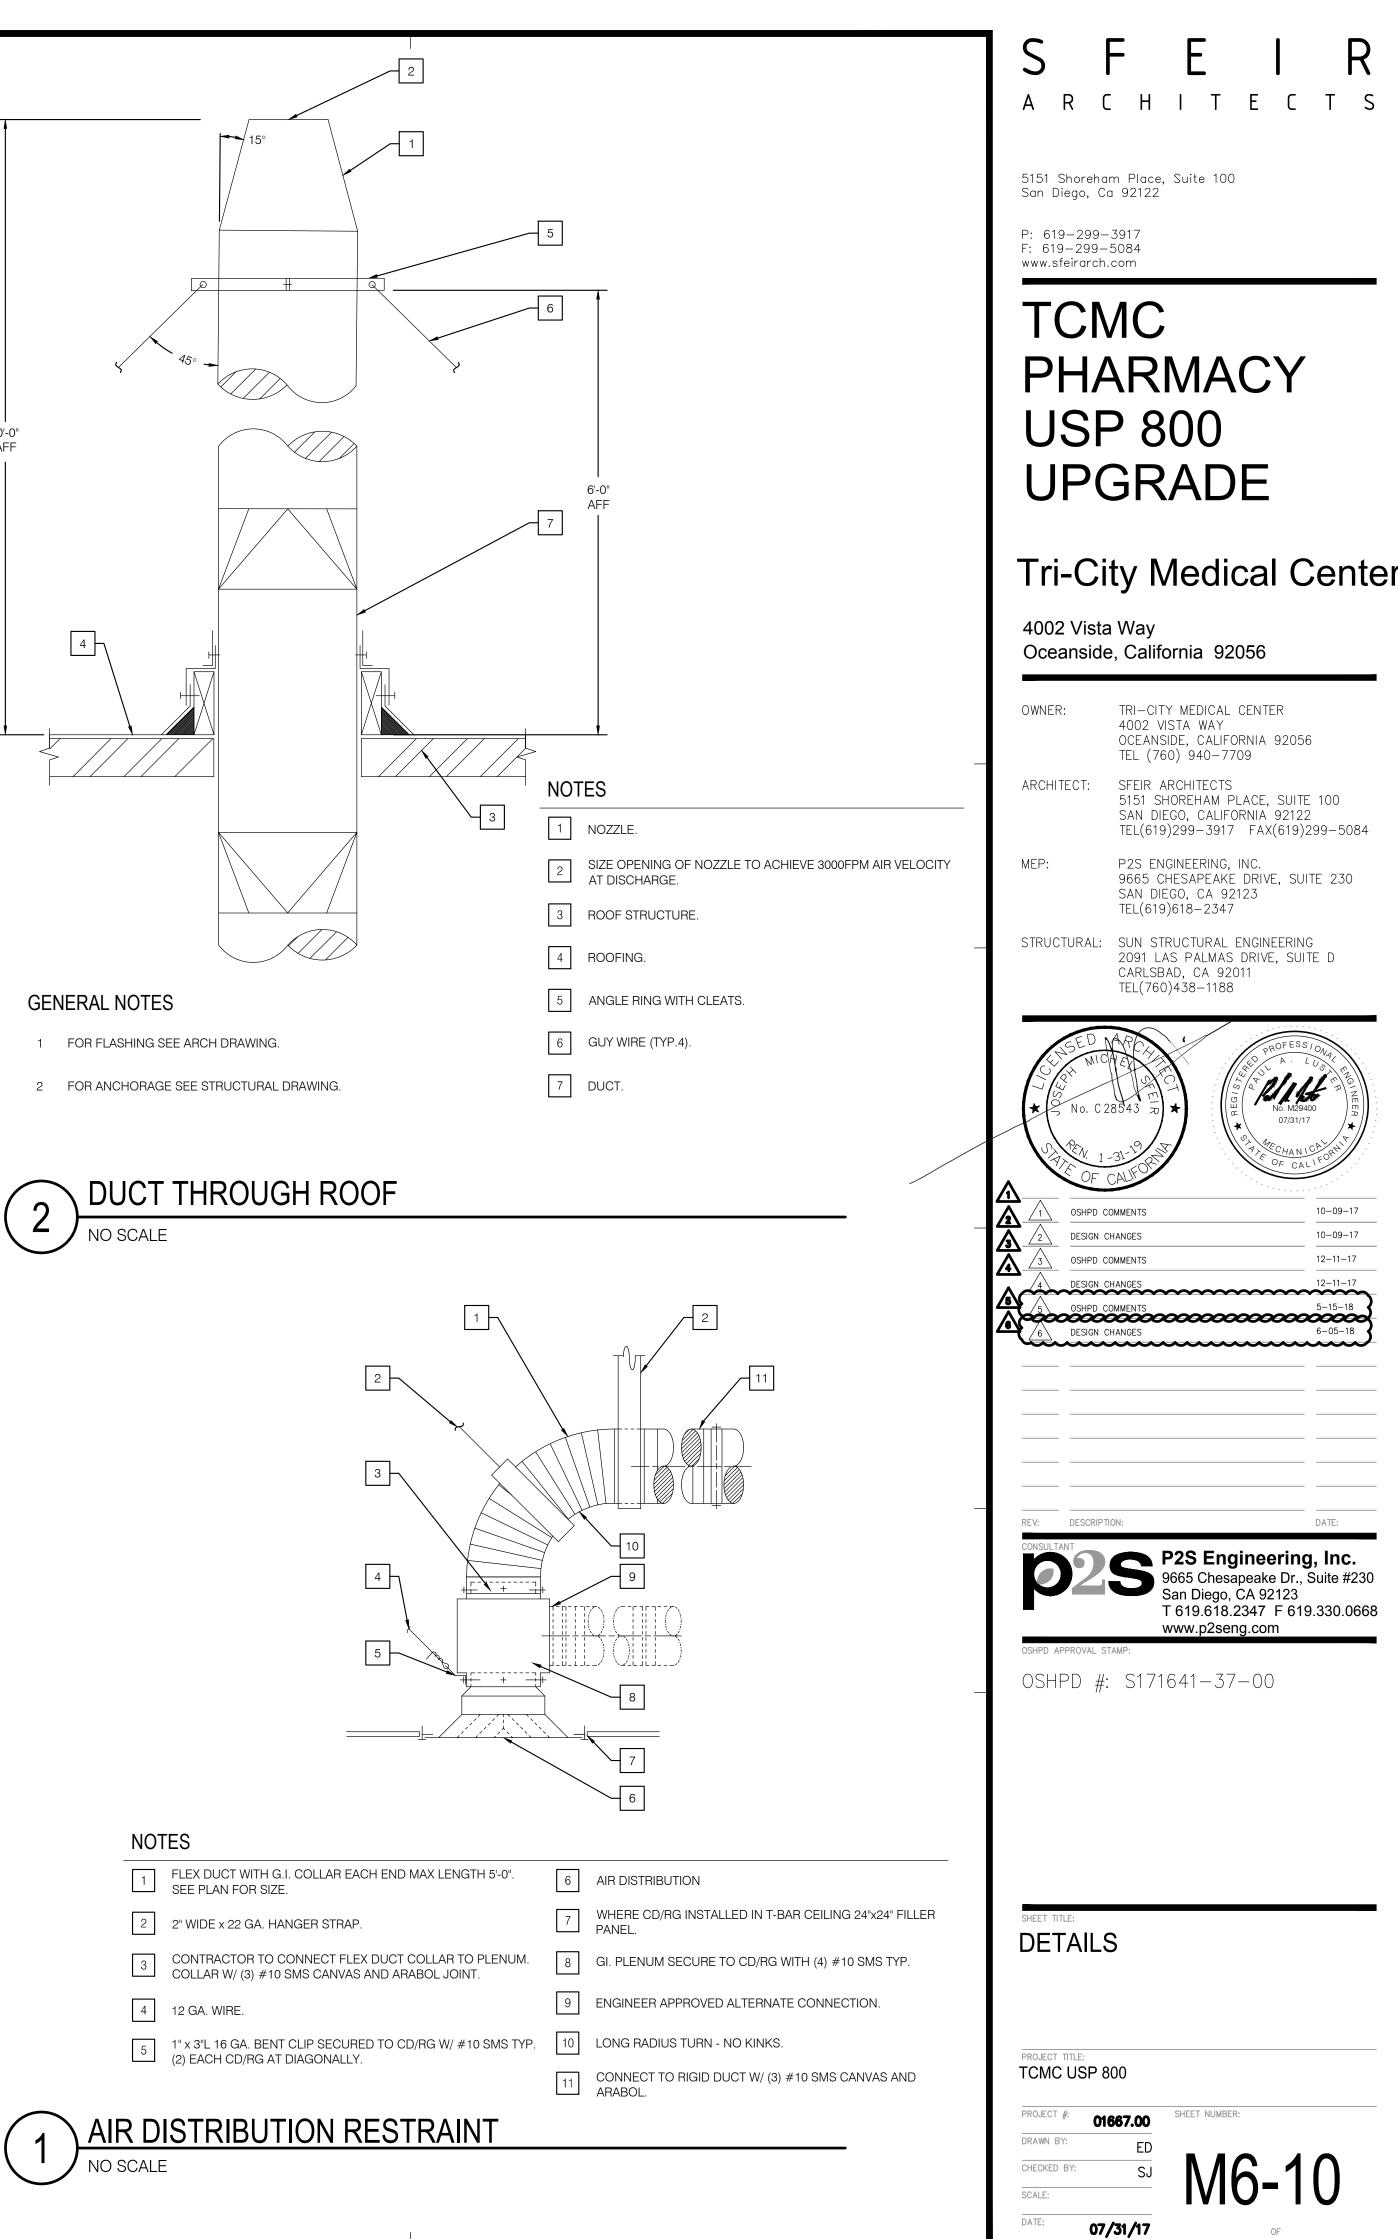

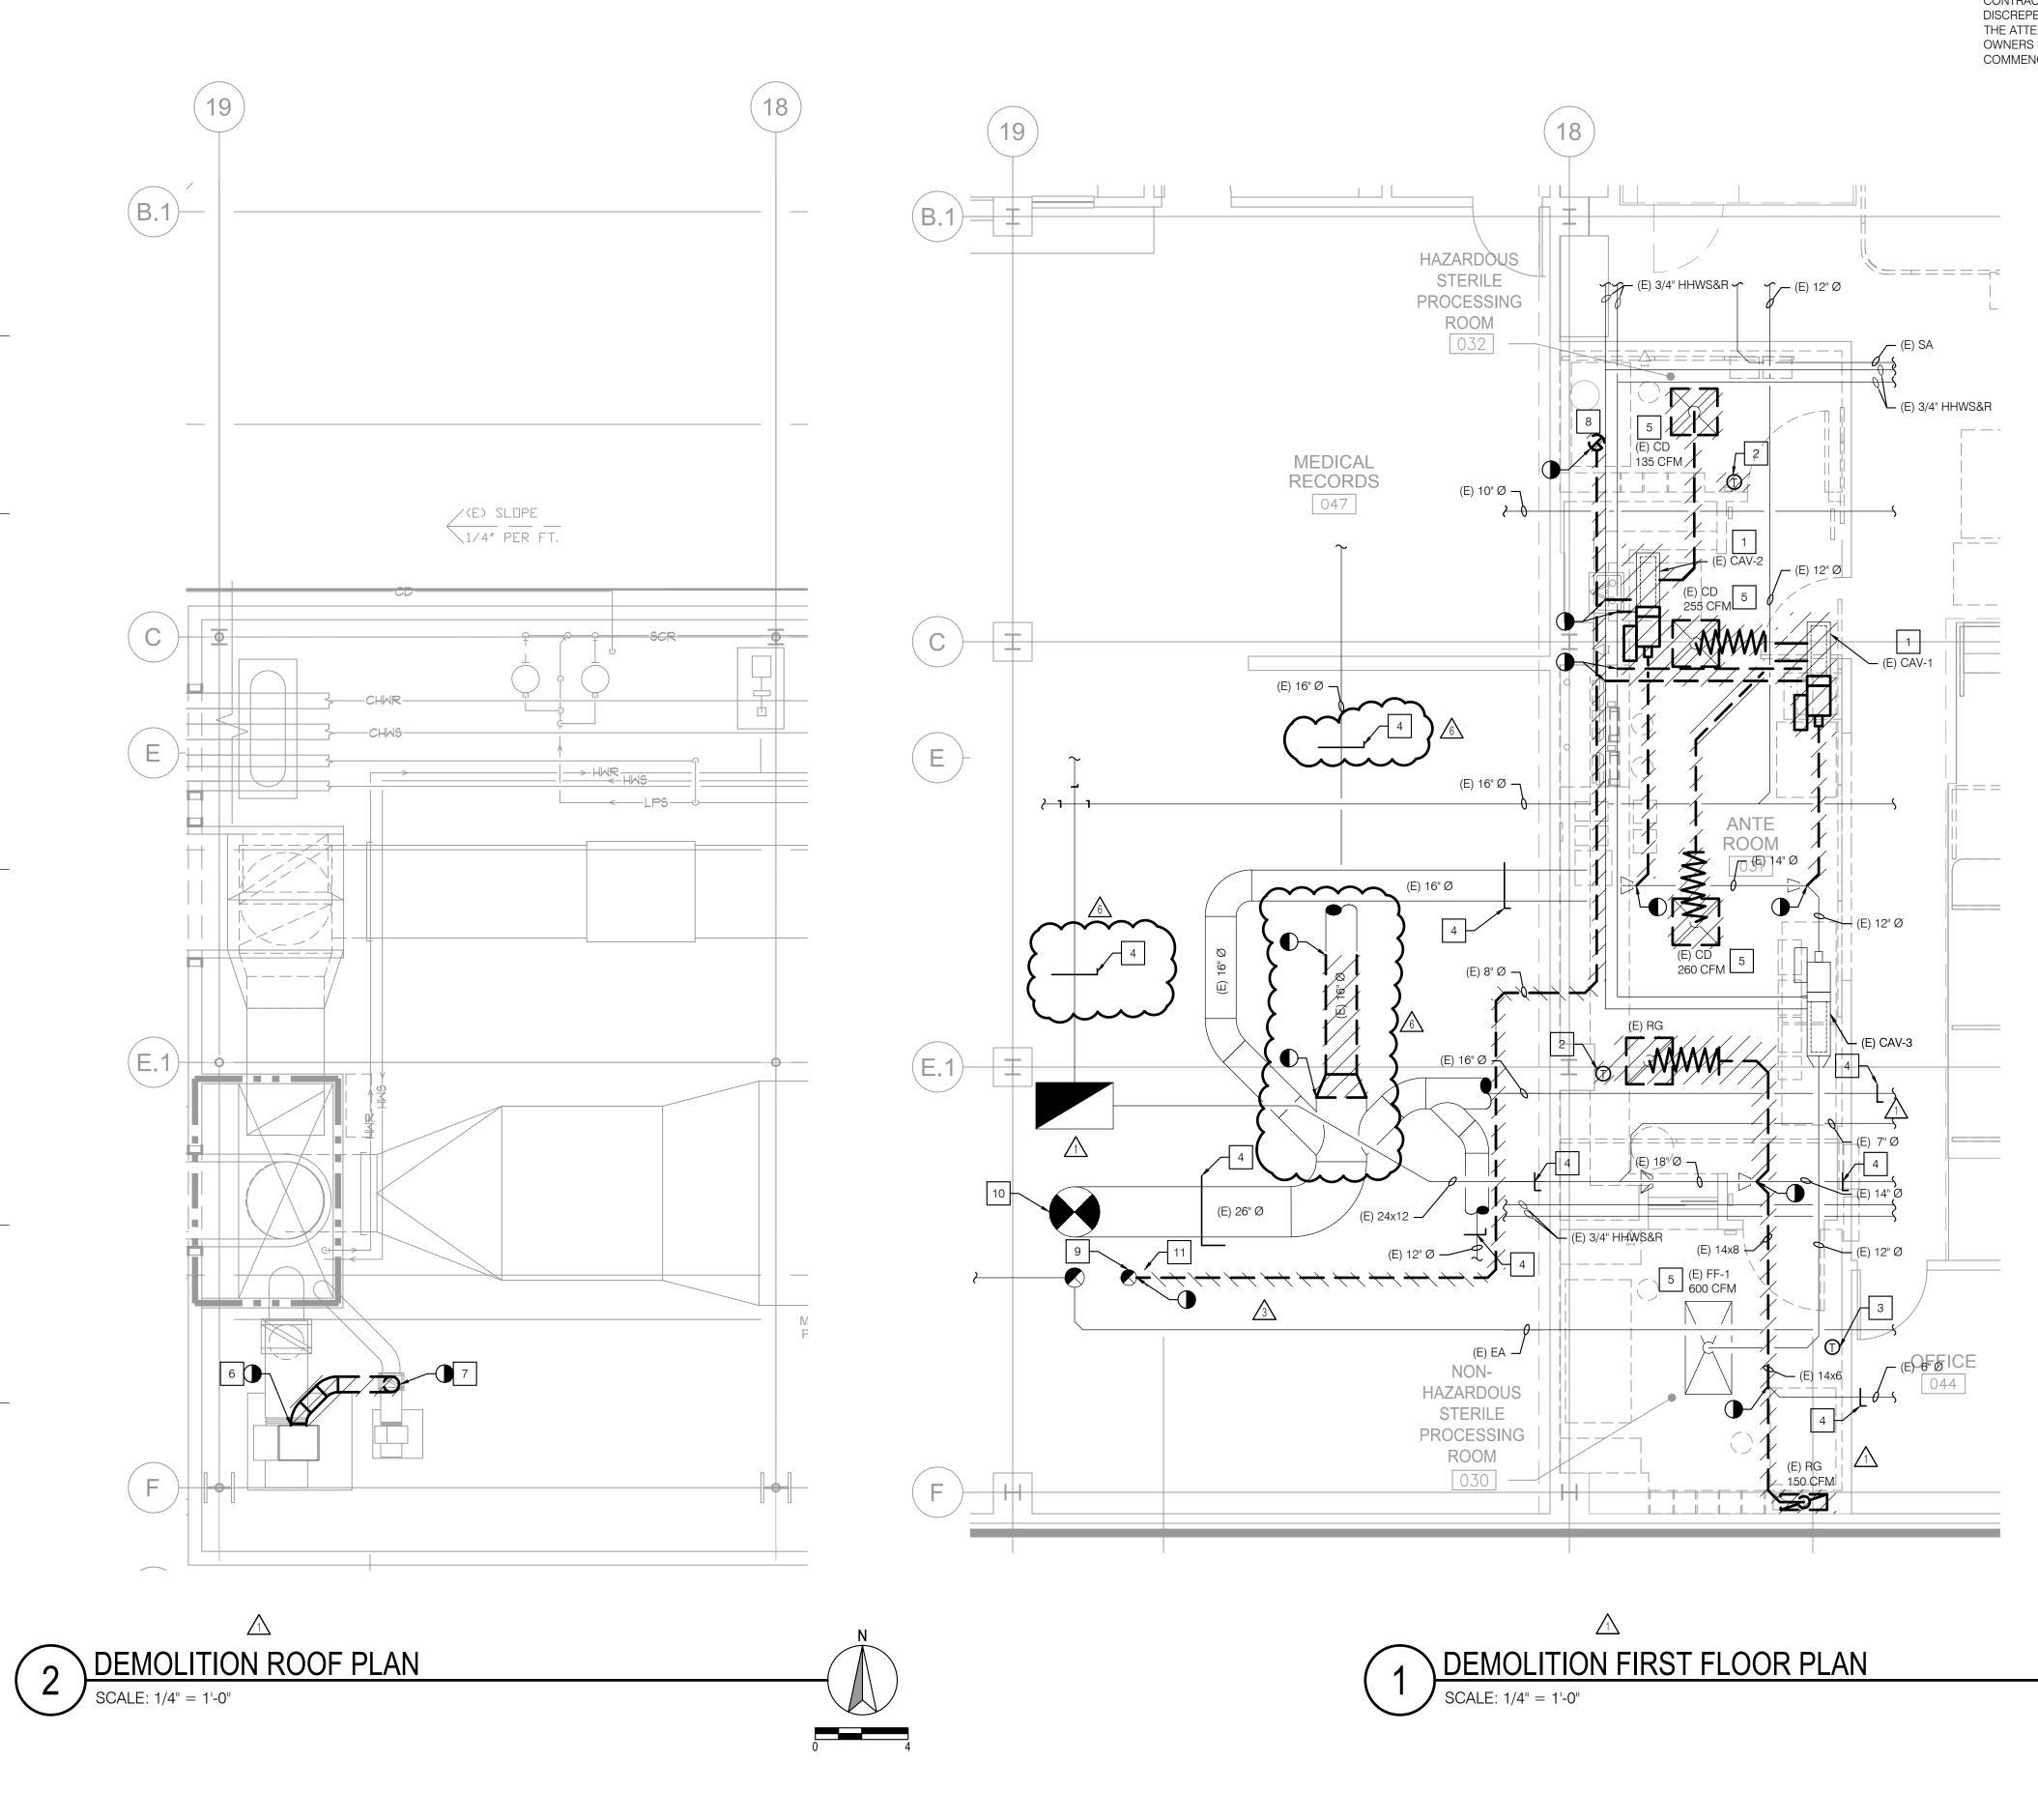

GENERAL NOTES:

- 1. DUCT TRAVERSES SHALL BE TAKEN PRIOR TO THE COMMENCEMENT OF ANY WORK. RESULTS SHALL BE TURNED OVER TO MECHANICAL ENGINEER FOR EVALUATION PRIOR TO ANY WORK.
- 2 CONDITIONS SHOWN ON DRAWINGS ARE BASED ON REVIEW OF AVAILABLE AS-BUILT DRAWINGS AND FIELD INVESTIGATIONS TO THE EXTENT POSSIBLE. CONTRACTOR SHALL VERIFY EXISTING CONDITIONS. ANY DISCREPENCIES DISCOVERED SHALL BE BROUGHT TO THE ATTENTION OF THE ARCHITECT, ENGINEER AND OWNERS REPRESENTATIVE PRIOR TO THE COMMENCEMENT OF ANY WORK.

(E.1)

!EA

SCALE: 1/4" = 1'-0"

NOTES

1 REMOVE (E) CAV AND ITS ASSOCIATED APPURTENANCES.

- 2 REMOVE (E) THERMOSTAT.
- 3 (E) THERMOSTAT TO REMAIN.
- 4 PRIOR TO COMMENCEMENT OF ANY WORK, A DUCT TRAVERSE SHALL BE PERFORMED AT MAIN SUPPLY AND RETURN DUCTS TO DOCUMENT AIRFLOW PRIOR TO CONSTRUCTION. PROVIDE MANUAL BALANCING DAMPER AT TRAVERSE LOCATION TO ALLOW BALANCING TO "PRE-READ" AIR QUANTITY.
- 5 PRE-CONSTRUCTION AIR READS HAVE BEEN TAKEN AS OF 05/04/17.
- 6 POINT OF DISCONNECT FOR (E) 8"Ø EXHAUST AIR DUCT FROM (E) EXHAUST DUCT. REMOVE (E) 8"Ø EXHAUST AIR DUCT THROUGH EXHAUST HOOD ON ROOF.
- 7 POINT OF DISCONNECT FOR (E) 8"Ø EXHAUST AIR DUCT FROM (E) EF-4. (E) BSC HOOD: 310 CFM PER PRE-CONSTRUCTION AIR READS TAKEN AS OF 5/04/17.
- 9 (E) 8" Ø EXHAUST AIR DUCT UP TO (E) EF-4 IN SHAFT TO REMAIN.
- (E) 26" Ø SUPPLY AIR DUCT UP TO (E) 40" Ø SUPPLY AIR DUCT TO (E) AHU-3 IN MECHANICAL PENTHOUSE.
- 11 REMOVE EXISTING FD IN EXISTING EA DUCT AT SHAFT.
- 12 PROVIDE GRILLE AIRFLOW MEASUREMENT PRIOR TO THE COMMENCEMENT OF ANY WORK.

16

OFFICE

039

COMPUTER STATION 040

FOILE



5151 Shoreham Place, Suite 100 San Diego, Ca 92122

P: 619-299-3917 F: 619-299-5084 www.sfeirarch.com

TCMC PHARMACY USP 800 UPGRADE


Tri-City Medical Center


4002 Vista Way Oceanside, California 92056


TRI-CITY MEDICAL CENTER OWNER: 4002 VISTA WAY OCEANSIDE, CALIFORNIA 92056 TEL (760) 940-7709 ARCHITECT: SFEIR ARCHITECTS 5151 SHOREHAM PLACE, SUITE 100 SAN DIEGO, CALIFORNIA 92122 TEL(619)299-3917 FAX(619)299-5084 MEP: P2S ENGINEERING, INC. 9665 CHESAPEAKE DRIVE, SUITE 230 SAN DIEGO, CA 92123 TEL(619)618-2347 STRUCTURAL: SUN STRUCTURAL ENGINEERING

> CARLSBAD, CA 92011 TEL(760)438-1188

2091 LAS PALMAS DRIVE, SUITE D

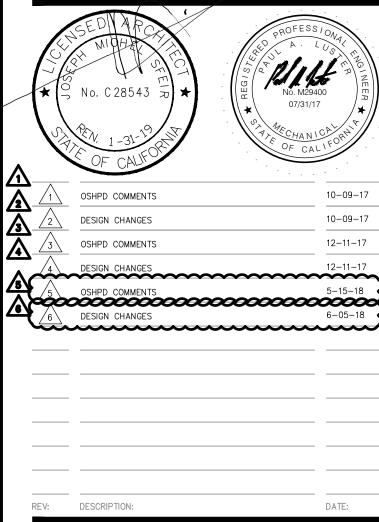

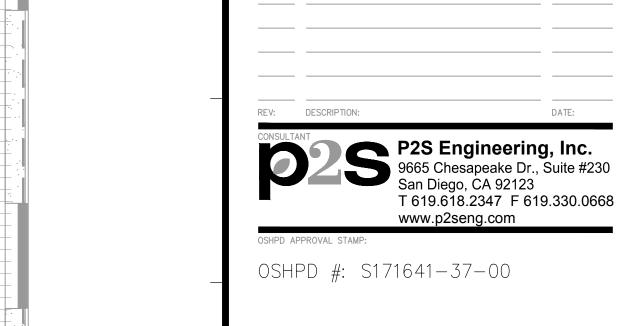

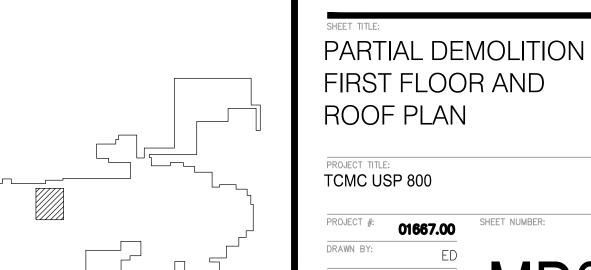

KEY PLAN

FIRST FLOOR AND ROOF PLAN

 
TCMC USP 800


01667.00 CHECKED BY:

SCALE

DATE:





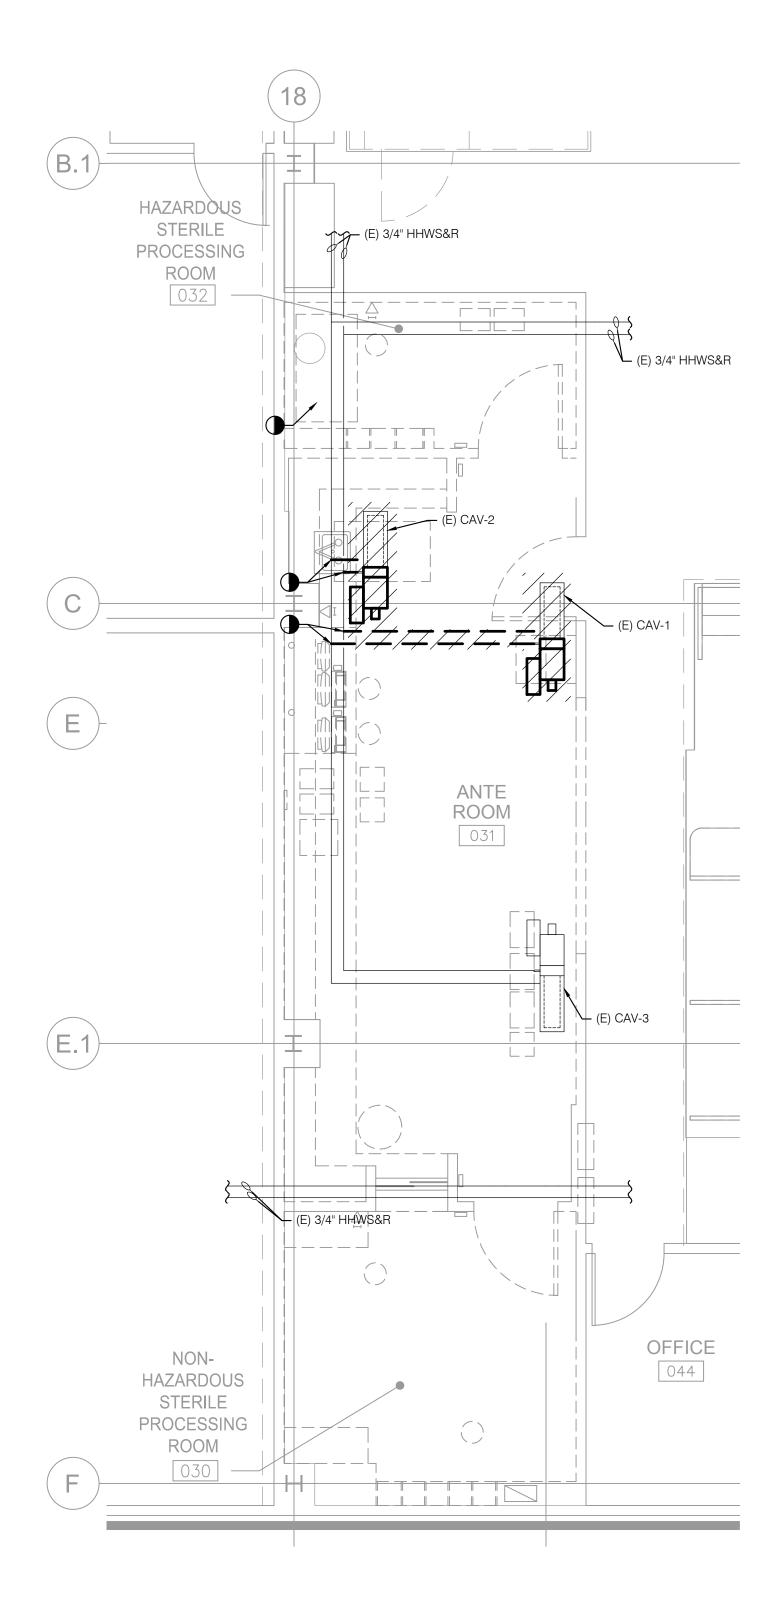

All rights re:

	SFEIRARCHITECTS151 Shoreham Place, Suite 100 Sn Diego, Ca 92122P: 619-299-391? F: 619-299-5084 www.sfeirarch.comTCMC PHARMACY USP 800 USP 800 UPGRADE
	<section-header><section-header><form></form></section-header></section-header>
-	

LEGEND DESCRIPTION SYMBOL NOTE CALLOUT DETAIL CALLOUT - NUMBER ON TOP DENOTES DETAIL NUMBER - NUMBER ON BOTTOM DENOTES SHEET DETAIL IS SHOWN MECHANICAL EQUIPMENT CALLOUT, SEE MECHANICAL PLANS FOR EXACT LOCATION AND REQUIREMENTS \bigcirc POINT OF CONNECTION POINT OF DISCONNECTION EXISTING PIPE/EQUIPMENT INDIRECT WASTE SANITARY SEWER/WASTE UNDERGROUND SANITARY SEWER/WASTE ABOVEGROUND DOMESTIC HOT WATER RETURN DOMESTIC HOT WATER SUPPLY · _ _ _ _ _ _ _ _ _ _ DOMESTIC COLD WATER STORM DRAIN PIPING SOFT COLD WATER CONDENSATE DRAIN

ELBOW DOWN O→→→ PIPE TEE UP & DOWN OR ELBOW UP PIPE TEE DOWN PIPE TEE UP DESCRIPTION GATE VALVE BALL VALVE HOSE BIBB FLOOR DRAIN FLOOR SINK, 1/2 GRATE FLOOR CLEANOUT CLEANOUT TO GRADE WALL CLEANOUT WATER HAMMER ARRESTOR

_____~

_____<u>_</u>____

SYMBOL

Φ

TRAP PRIMER

ABBREVIATIONS

RRKF	VIATIONS
BBREVIATION	DESCRIPTION
)	AT
BV	ABOVE
/C C	ABOVE CEILING ACETYLENE
	AREA DRAIN
	ABOVE FINISHED FLOOR
FG FSR	ABOVE FINISHED GRADE AUTOMATIC FIRE SPRINKLER RISER
R	ARGON GAS
V	ACID VENT
W	ACID WASTE
EL FP	BELOW BACKFLOW PREVENTER
/G	BELOW GRADE
/F	BELOW FLOOR
TM V	BOTTOM BALL VALVE
l	CAST IRON
IP	CAST IRON PIPE
lg otg	CEILING CLEAN-OUT TO GRADE
U	CUBIC
W	COLD WATER
EPT	
F IA	DRINKING FOUNTAIN DIAMETER
N	DOWN
S	DOWNSPOUT
WG E)	DRAWING(S) EXISTING
EW	EMERGENCY EYEWASH
XIST	EXISTING
QUIP WC	EQUIPMENT ELECTRIC WATER COOLER
WC	FIRE
/A	FROM ABOVE
/B	FROM BELOW
CO D	FLOOR CLEAN-OUT FLOOR DRAIN
F	FINISHED FLOOR
S T	FLOOR SINK FEET
•	NATURAL GAS (LOW PRESSURE)
AL	GALLONS
PM PR	GALLONS PER MINUTE GAS PRESSURE REGULATOR
&CW	HOT AND COLD WATER
/L	HIGH LEVEL
DR T	HEADER HEIGHT
1	INCHES
V	INDIRECT WASTE
or LAV AX	LAVATORY MAXIMUM
IN	MINIMUM
PG	NATURAL MEDIUM PRESSURE GAS
TD	MOUNTED
TS	NOT TO SCALE OXYGEN
D	OVERFLOW DRAIN
S&Y	OPEN SCREW AND YOKE
OC OD	POINT OF CONNECTION POINT OF DISCONNECTION
SI	POUNDS PER SQUARE INCH
D	ROOF DRAIN
1&C	ROUGH-IN AND CONNECT SINK, SEWER, SOIL
D	STORM DRAIN
OV	SHUT-OFF VALVE
Q S	SQUARE SERVICE SINK
/A	TO ABOVE
/B	TO BELOW
P YP	TRAP PRIMER TYPICAL
G	UNDERGROUND
ON	UNLESS OTHERWISE NOTED
R	
OLT	SANITARY VENT VOLTAGE
TR	VENT THRU ROOF
1	WASTE
// /C	WITH WATER CLOSET
/CO	WATER CLOSET WALL CLEAN-OUT
/H	WATER HEATER
/HA	WATER HAMMER ARRESTOR

REFERENCE WILL BE MADE TO ANSI Y1.1, MILITARY STANDARD IN THE EVENT ABBREVIATIONS NOT MENTIONED HEREIN ARE USED, ABBREVIATIONS, AND OTHER STANDARD INDUSTRY CONVENTIONS.

GENERAL NOTES

- PRIOR TO BID.

- AND SPECIFIED HEREIN.
- VERSION OF AUTOCAD.
- WITHIN THE CONSTRUCTION AREA.
- FOR HOW LONG A PERIOD OF TIME.
- ADDITIONS.
- PURCHASE AND/OR INSTALLATION OF ALL WORK.

- INDICATED AS BEING RELOCATED.
- INSTRUCTIONS.
- DISSIMILAR METALS ARE JOINED.
- AIR-GAP AS REQUIRED BY LOCAL CODES.
- DRAWINGS.
- THE WORK.
- EQUIPMENT CONNECTIONS.
- 23. EQUIPMENT ANCHORAGE NOTES:

SHEET INDEX

P0-02

P2-10

PD2-10

GENERAL NOTES, LEGEND, SYMBOLS & SHEET INDEX SCHEDULES AND DETAILS PARTIAL RENOVATION FLOOR PLAN

1. ALL WORK SHALL COMPLY WITH THE 2016 EDITIONS OF THE CALIFORNIA BUILDING, MECHANICAL, PLUMBING, AND OTHER APPLICABLE FEDERAL, STATE, OR LOCAL CODES AS ADOPTED AND ENFORCED BY THE LOCAL JURISDICTION. IN CASE THE PLANS SHOW MORE STRINGENT REQUIREMENTS, THE PLANS SHALL GOVERN THE DESIGN, YET NOTHING ON THE DESIGN DOCUMENTS SHALL BE INTERPRETED AS AUTHORITY TO VIOLATE CODE(S) OR REGULATION(S).

2. SUBMISSION OF BID IN CONNECTION WITH THIS WORK SHALL IMPLY THAT THE BIDDER HAS EXAMINED THE JOB SITE UNDER WHICH THE CONTRACTOR WILL BE OBLIGATED TO OPERATE UNDER THIS CONTRACT. NO EXTRA CHARGE WILL BE ALLOWED FOR FAILURE OF ANY BIDDER TO EXAMINE THE SITE

3. WHERE USED. THE TERM "PROVIDE" SHALL MEAN "FURNISH AND INSTALL"

4. IN THE EVENT OF A CONFLICT OR INCONSISTENCY BETWEEN ITEMS INDICATED ON DESIGN PLANS / SPECIFICATIONS WITH CODE REQUIREMENTS, THE MORE STRINGENT STANDARD SHALL PREVAIL.

5. CONTRACTOR SHALL FURNISH LABOR, MATERIALS, EQUIPMENT, AND TRANSPORTATION AS REQUIRED TO PROPERLY INSTALL ALL PLUMBING SYSTEMS OR RELATED COMPONENTS AS INDICATED ON PLANS

6. ALL NEW EQUIPMENT AND MATERIAL TO BE INSTALLED AS PART OF RENOVATION / NEW CONSTRUCTION SHALL BEAR AN UNDERWRITERS LABORATORIES LABEL (UL), AND INSTALLED IN SUCH A MANNER FOR WHICH THEY ARE DESIGNED AND APPROVED.

7. CONTRACTOR SHALL DOCUMENT AND RELAY ANY MAJOR DEVIATIONS FROM THE DESIGN DOCUMENTS, AND ATTAIN APPROVAL FROM THE MECHANICAL ENGINEER BEFORE PROCEEDING. AS-BUILT COPIES SHALL BE PROVIDED INDICATING ALL CHANGES / DEVIATIONS MADE DURING CONSTRUCTION. CONTRACTOR SHALL PROVIDE COMPLETED AS-BUILT DRAWINGS IN THE LATEST

8. ALL WORK SHALL BE PERFORMED IN A CLEAN AND WORKMANLIKE MANNER. CARE SHALL BE EXERCISED TO MINIMIZE ANY INCONVENIENCE OR DISTURBANCE TO OTHER AREAS OF THE BUILDING WHICH ARE TO REMAIN IN OPERATION. ISOLATE WORK AREAS BY MEANS TO KEEP DUST AND DIRT

9. NO PIPING, EQUIPMENT, ETC. SHALL BE REMOVED, DISCONNECTED OR SHUT DOWN WITHOUT PRIOR REVIEW WITH THE COLLEGE TO CONFIRM THAT AREAS TO REMAIN IN OPERATION WILL NOT BE AFFECTED. IF ANY AREAS NOT WITHIN THE SCOPE OF WORK ARE AFFECTED BY ANY SHUTDOWN, REMOVAL OR DISCONNECTION, SUFFICIENT ADVANCE NOTICE MUST BE GIVEN TO THE COLLEGE INDICATING WHICH AREAS WILL BE AFFECTED, WHEN THE PROPOSED SHUTDOWN WILL OCCUR, AND

10. THE ARRANGEMENT OF EQUIPMENT AND PIPING SHOWN ON THE DRAWINGS IS BASED UPON INFORMATION AVAILABLE TO THE ENGINEER AT THE TIME OF DESIGN AND IS NOT INTENDED TO SHOW EXACT DIMENSIONS PECULIAR TO A SPECIFIC MANUFACTURER. THE DRAWINGS ARE, IN PART, DIAGRAMMATIC AND SOME FEATURES OF THE ILLUSTRATED EQUIPMENT INSTALLATION MAY REQUIRE REVISION TO MEET ACTUAL EQUIPMENT INSTALLATION REQUIREMENTS. STRUCTURAL SUPPORTS, FOUNDATIONS, CONNECTED PIPING, VALVES, PIPE SUPPORTS AND ELECTRICAL CONDUIT SPECIFIED MAY HAVE TO BE ALTERED OR ADDITIONAL ITEMS REQUIRED TO ACCOMMODATE THE EQUIPMENT PROVIDED. NO ADDITIONAL PAYMENT WILL BE MADE FOR SUCH REVISIONS, ALTERATIONS AND / OR

11. CONTRACTOR SHALL VERIFY ALL DIMENSIONS AT THE SITE MAKING FIELD MEASUREMENTS AND PROVIDE SHOP DRAWINGS NECESSARY FOR FABRICATION OR ERECTION OF ALL HVAC AND PIPING SYSTEMS. MAKE ALLOWANCE FOR BEAMS, PIPES AND OTHER OBSTRUCTIONS IN BUILDING CONSTRUCTION. CHECK DRAWINGS SHOWING WORK OF OTHER TRADES AND CONSULT WITH THE UNIVERSITY REPRESENTATIVE IN THE EVENT OF POTENTIAL INTERFERENCE. SHOP DRAWINGS SHALL BE MINIMUM 1/4"=1'-0" SCALE, INDICATING FITTINGS, SIZES, WELDS AND CONFIGURATIONS AND SUBMITTED TO ENGINEER FOR REVIEW. CONTRACTOR SHALL PROVIDE DIMENSIONED SHOP DRAWINGS COMPLETED IN THE LATEST VERSION OF AUTOCAD.

12. CONTRACTOR SHALL COORDINATE HIS WORK WITH ALL OTHER TRADES PRIOR TO FABRICATION,

13. BEFORE COMMENCEMENT OF WORK, CONTRACTOR SHALL VERIFY THE EXACT LOCATIONS, ELEVATIONS, AND CHARACTERISTICS OF ALL UTILITIES.

14. CONTRACTOR SHALL SECURE AND PAY ALL FEES AND PERMITS PERTAINING TO THE CONTRACT.

15. EXISTING MATERIALS THAT ARE REMOVED SHALL NOT BE REUSED IN NEW SYSTEMS, EXCEPT WHERE

16. ALL EQUIPMENT SHALL BE INSTALLED IN STRICT COMPLIANCE WITH THE MANUFACTURER'S WRITTEN

17. ALL PLUMBING FIXTURE VENTS TO TERMINATE MINIMUM 12 INCHES FROM ANY VERTICAL SURFACE AND 10 FEET FROM OR 3 FEET ABOVE ANY OUTSIDE AIR INTAKES. NO FLAGPOLING PERMITTED.

18. ALL PIPING SHALL BE INSTALLED AS INDICATED ON THE DRAWINGS IN A NEAT WORKMANSHIP-LIKE MANNER AND BE SUPPORTED AS REQUIRED BY CODES. PIPING SHALL BE SET UP AND DOWN AND OFFSET AS REQUIRED TO SUIT FIELD CONDITIONS. DIELECTRIC COUPLINGS SHALL BE USED WHERE

19. ALL PIPING DISCHARGING INTO FLOOR-SINKS AND/OR FLOOR DRAINS SHALL MAINTAIN MINIMUM

20. ALL VALVES, UNIONS, ETC. TO BE SAME SIZE AS LINE SIZE UNLESS OTHERWISE INDICATED ON

21. ISOLATE AND DRAIN EXISTING PIPING SYSTEM AS REQUIRED TO ACCOMMODATE INSTALLATION OF

22. UNIONS SHALL BE PROVIDED AND INSTALLED AFTER EACH SCREW-TYPE VALVE AND PRIOR TO

ALL MECHANICAL, PLUMBING, AND ELECTRICAL COMPONENTS SHALL BE ANCHORED AND INSTALLED PER THE DETAILS ON THE OSHPD APPROVED CONSTRUCTION DOCUMENTS. WHERE NO DETAIL IS INDICATED, THE FOLLOWING COMPONENTS SHALL BE ANCHORED OR BRACED TO MEET THE FORCE

PARTIAL DEMOLITION FLOOR PLAN

AND DISPLACEMENT REQUIREMENTS PRESCRIBED IN THE 2016 CBC, SECTION 1616A. AND ASCE 7-10 CHAPTER 6 AND 30.

- A. ALL PERMANENT EQUIPMENT AND COMPONENTS
- B. TEMPORARY OR MOVABLE EQUIPMENT THAT IS PERMANENTLY ATTACHED (E.G. HARD WIRED) TO THE BUILDING UTILITY SERVICES SUCH AS ELECTRICITY, GAS OR WATER.
- C. MOVABLE EQUIPMENT WHICH IS STATIONED IN ONE PLACE FOR MORE THAN 8 HOURS AND HEAVIER THAN 400 POUNDS ARE REQUIRED TO BE ANCHORED WITH TEMPORARY ATTACHMENTS.

THE ATTACHMENT OF THE FOLLOWING MECHANICAL AND ELECTRICAL COMPONENTS SHALL BE POSITIVELY ATTACHED TO THE STRUCTURE, BUT NEED NOT BE DETAILED ON THE PLANS. THESE COMPONENTS SHALL HAVE FLEXIBLE CONNECTIONS PROVIDED BETWEEN THE COMPONENT AND ASSOCIATED DUCTWORK, PIPING, AND CONDUIT:

- A. COMPONENTS WEIGHING LESS THAN 400 POUNDS AND HAVE A CENTER OF MASS LOCATED 4 FEET OR LESS ABOVE THE ADJACENT FLOOR OR ROOF LEVEL THAT DIRECTLY SUPPORT THE COMPONENT.
- B. COMPONENTS WEIGHING LESS THAN 20 POUNDS, OR IN THE CASE OF DISTRIBUTED SYSTEMS, LESS THAN 5 POUNDS PER FOOT, WHICH ARE SUSPENDED FROM A ROOF OR FLOOR OR HUNG FROM A WALL.

FOR THOSE ELEMENTS THAT DO NOT REQUIRE DETAILS ON THE APPROVED DRAWINGS, THE INSTALLATION SHALL BE SUBJECT TO THE APPROVAL OF THE STRUCTURAL ENGINEER OF RECORD AND THE DSA DISTRICT STRUCTURAL ENGINEER. THE PROJECT INSPECTOR WILL VERIFY THAT ALL COMPONENTS AND EQUIPMENT HAVE BEEN ANCHORED IN ACCORDANCE WITH ABOVE REQUIREMENTS.

24. PIPING, DUCTWORK, AND ELECTRICAL DISTRIBUTION SYSTEM BRACING NOTE

PIPING, DUCTWORK, AND ELECTRICAL DISTRIBUTION SYSTEMS SHALL BE BRACED TO COMPLY WITH THE FORCES AND DISPLACEMENTS PRESCRIBED IN ASCE 7-10 SECTION 13.3 AS DEFINED IN ASCE 7-10 SECTION 13.6.8, 13.6.7, 13.6.5.6 ITEM 6, AND 2016 CBC SECTIONS 1616A.

THE BRACING AND ATTACHMENTS TO THE STRUCTURE SHALL BE DETAILED ON THE APPROVED DRAWINGS OR THEY SHALL COMPLY WITH ONE OF THE OSHPD PRE-APPROVALS (OPM #) AS MODIFIED TO SATISFY ANCHORAGE REQUIREMENTS OF ACI 318, APPENDIX D.

COPIES OF THE MANUAL SHALL BE AVAILABLE ON THE JOBSITE PRIOR TO THE START OF HANGING AND BRACING OF THE PIPE, DUCTWORK, AND ELECTRICAL DISTRIBUTION SYSTEM.

THE STRUCTURAL ENGINEER OF RECORD SHALL VERIFY THE ADEQUACY OF THE STRUCTURE TO SUPPORT THE HANGER AND BRACE LOADS.

- 25. PLUMBING FIXTURES AND FAUCETS SHALL BE CERTIFIED BY THE STATE OF CALIFORNIA ENERGY COMMISSION AS REQUIRED BY THE CALIFORNIA ENERGY EFFICIENCY STANDARDS SECTION S-5314 AND TABLE "G".
- 26. ALL SOIL, WASTE, STORM DRAIN AND VENT PIPING SHALL SLOPE AT 2% UNLESS OTHERWISE INDICATED.
- 27. PIPING THROUGH FIRE RATED WALLS SHALL BE PER U.L. FIRE RESISTANCE SYSTEM NO. W1001. SEE ARCHITECTURAL PLANS FOR ALL WALL LOCATIONS.
- 28. REFER TO THE SPECIFICATIONS BOOK FOR ADDITIONAL REQUIREMENTS.
- 29. ALL CLEANOUTS SHALL BE INSTALLED WHERE READILY ACCESSIBLE. THE CONTRACTOR SHALL COORDINATE ALL CLEANOUT LOCATIONS WITH EQUIPMENT, CABINETS, ETC, AND THE ARCHITECT PRIOR TO ANY INSTALLATION.
- 30. KEEP ALL PIPING FROM LOAD BEARING FOOTINGS. IF UNABLE TO CLEAR FOOTINGS OR GRADE BEAMS, INSTALL PIPING THROUGH PIPE SLEEVES.
- 31. BEFORE FABRICATION OR INSTALLATION, THE CONTRACTOR SHALL VERIFY EXACT LOCATIONS OF ALL EQUIPMENT AND FIXTURES. EXACT ROUGH-IN LOCATIONS AND REQUIREMENTS SHALL BE COORDINATED IN FIELD.
- 32. ACCESSIBLE PLUMBING FIXTURES SHALL COMPLY WITH ALL OF THE REQUIREMENTS OF 2016 CBC CHAPTER 11A AND/OR 11B. HEIGHTS AND LOCATION OF ALL FIXTURES SHALL BE ACCORDING TO CBC 2016 SECTION 1138A. FIXTURE CONTROLS SHALL COMPLY WITH CBC 2016 SECTION 1138A.4.
- 33. ALL VALVES, TRAP PRIMERS, WATER HAMMER ARRESTERS OR OTHER EQUIPMENT SHOWN IN WALLS OR ABOVE NON-ACCESSIBLE CEILINGS SHALL BE INSTALLED BEHIND AN ACCESS PANEL.
- 34. ALL VENT THROUGH ROOF SHALL BE MINIMUM OF 3 FEET VERTICALLY AND 10 FEET HORIZONTALLY FROM ANY AIR CONDITIONING EQUIPMENT FRESH AIR INTAKES.
- 35. VERIFY WITH ARCHITECTURAL DRAWINGS FOR EXACT LOCATIONS OF ALL FLOOR DRAINS, ROOF, OVERFLOW DRAINS AND FLOOR SINKS.
- 36. FIXTURES SHALL BE PROTECTED DURING CONSTRUCTION FROM ANY DAMAGES. REFINISHED FIXTURES WILL NOT BE ACCEPTABLE UNDER ANY CONDITIONS.
- 37. HOSE BIB WITH VACUUM BREAKER SHALL BE PROVIDED UNDER LAVATORY IN EACH PUBLIC RESTROOM.
- 38. INSULATE INDIRECT DRAIN LINES FROM REFRIGERATORS, FREEZERS, ICE MAKER AND ICE BINS WITH MANVILLE AERO-TUBE OR EQUAL TO PREVENT CONDENSATE DRIPS.
- 39. INSULATE WASTE PIPE AND P-TRAP FROM FLOOR SINK, FLOOR DRAINS OR FUNNEL DRAINS COLLECTING INDIRECT DRAINS FROM REFRIGERATORS, FREEZERS, ICE MAKER AND ICE BINS TO PREVENT CONDENSATE DRIPS. INSULATE WASTE PIPE UP TO THE NEXT 3" OR 4" MAIN CONNECTION.
- 40. PROVIDE AND INSTALL GAS COCKS AND UNION AT EACH GAS FIRED EQUIPMENT.
- 41. PROVIDE AND INSTALL CHROME ANGLE VALVES ON HOT AND COLD WATER SUPPLY AT EACH PLUMBING FIXTURES.
- 42. ALL WATER FAUCETS SHALL BE PROVIDED WITH CODE APPROVED FLOW RESTRICTORS.

MECHANICAL PIPE AND DUCT SYSTEM SEISMIC SUPPORT NOTES

MECHANICAL & PLUMBING

- COMPONENTS FOR SUSPENDED UTILITIES OR OTHER APPROVED OSHPD OPM.
- INSTALLATION GUIDE/MANUAL SHALL BE ON THE JOBSITE PRIOR TO STARTING THE INSTALLATION.
- TO ENSURE THAT THE ORIGINAL DESIGN IS STILL ADEQUATE. THE INSPECTOR OF RECORD SHALL INSURE THAT ALL WORK IS PROPERLY INSTALLED PER THE APPLICABLE OSHPD PRE-APPROVAL.

- 43. COVER ALL FLOOR DRAINS, FLOOR SINKS, ROOF AND OVERFLOW DRAINS DURING CONSTRUCTIONS TO PREVENT DEBRIS FROM ENTERING PIPE AND PROTECT GRATES FROM DAMAGES.
- 44. COORDINATE WITH ELECTRICAL CONTRACTOR PRIOR TO ORDERING EQUIPMENT FOR AVAILABLE VOLTAGES AT ALL EQUIPMENT LOCATIONS.
- 45. COORDINATE WITH ELECTRICAL CONTRACTOR FOR ALL TAMPER AND FLOW SWITCH LOCATIONS.
- 46. BECAUSE OF THE SMALL SCALE DRAWINGS, IT IS NOT POSSIBLE TO INDICATE ALL OFFSETS, FITTINGS AND ACCESSORIES WHICH MAY BE REQUIRED. THE CONTRACTOR SHALL CAREFULLY INVESTIGATE THE CONDITIONS SUBBOUNDING INSTALLATION OF HIS WORK, FUBNISHING THE NECESSARY PIPING FITTINGS, VALVES, TRAPS, AND OTHER DEVICES WHICH MAY BE REQUIRED TO COMPLETE THE INSTALLATION.
- 47. UNLESS SPECIFIED ON STRUCTURAL DRAWINGS, ANY ALTERATION OR MODIFICATIONS TO STRUCTURAL ELEMENTS BY CUTTING, DRILLING, BORING, BRACING, WELDING ETC. SHALL HAVE WRITTEN APPROVAL STRUCTURAL ENGINEER PRIOR TO START WORK.
- 48. ITEMS NOT SHOWN IN THE DRAWINGS BUT NECESSARY FOR COMPLETE OPERATION OF THE SYSTEM/FIXTURES/EQUIPMENT OR FOR COMPLETE CODE INSTALLATION SHALL BE PROVIDED AT NO ADDED COST TO THE OWNER.
- 49. DIELECTRIC UNION ISOLATOR WITH THREADED CONNECTIONS SHALL BE PROVIDED FOR CONNECTIN INCOMPATIBLE MATERIALS.
- 50. ALL PLUMBING FIXTURES SHALL BE APPROVED BY OWNER PRIOR TO ORDERING.
- 51. CONTRACTOR SHALL FIELD VERIFY EXACT LOCATION OF ALL EXISTING UTILITIES TO WHERE HE IS TO CONNECT PRIOR TO INSTALLATION OF ANY PIPING. EXTEND NEW PIPING IF NECESSARY TO WHERE THE EXISTING IS.
- 52. ALL CONNECTIONS TO EXISTING SERVICES SHALL BE MADE SUCH THAT INTERRUPTION TIME WILL BE AS SHORT AS POSSIBLE. THE CONTRACTOR SHALL GIVE THE OWNER'S REPRESENTATIVE SUFFICIENT NOTICE OF SUCH INTERRUPTION AND THE ACTUAL SHUT DOWN TIME SHALL BE AT A TIME DESIGNATED BY THE OWNER'S REPRESENTATIVE.
- 53. ALL EXISTING PIPING DAMAGED DURING CONSTRUCTION SHALL BE REPAIRED WITH MATERIALS TO MATCH EXISTING BY THE CONTRACTOR.
- 54. PROVIDE AND INSTALL WATER HAMMER ARRESTORS IN THE FOLLOWING LOCATIONS (ONLY NON-FERROUS ARRESTORS MAY BE INSTALLED IN ANY WATER SYSTEM):
 - A. WATER LINES TO LAVATORY HEADERS, WATER CLOSET AND URINAL HEADERS, SERVICE SINKS, KITCHEN SINKS, WASH FOUNTAINS, DRINKING FOUNTAINS, LABORATORIES WITH MEDICAL TYPE FAUCETS AND ON WASH SINKS HAVING 3 OR MORE STATIONS AND ALL OTHER QUICK CLOSING FIXTURE SUCH AS CLOTHES WASHERS, AS CLOSE TO FIXTURE AS POSSIBLE.
 - B. BETWEEN LAST 2 FIXTURES WHEN 3 OR MORE FIXTURES, OTHER THAN THOSE LISTED IN "A" ABOVE, ARE SERVED BY A COMMON HEADER.
 - C. WHEN ARRESTOR SHALL BE INSTALLED IN WALL OR FURRING, FURNISH WITH AN ACCESS PLATE LARGE ENOUGH TO PERMIT REMOVAL OF ARRESTOR. ACCESS PLATE SHALL BE A MINIMUM OF 2 INCHES LARGER IN EACH DIRECTION THAN ARRESTOR.
- 55. ALL PIPING INTO STEM WALLS AND FOOTINGS SHALL BE DOUBLE HALF LAP WRAPPED WITH 1/8" THICK "ARMAFLEX" INSULATION. THE CONTRACTOR SHALL ALSO PROVIDE BLOCKED OUT AREAS IN STEM WALL AND FOOTING. ALL PIPING SHALL AVOID THE LOWER 8" OF THE FOOTING.
- 56. ALL HOT WATER PIPING SHALL BE INSULATED. INSULATION SHALL HAVE A FLAME SPREAD OF NOT MORE THAN 25 AND A SMOKE DENSITY NOT EXCEEDING 50 PER 2016 CMC SEC. 1201.2. SEE SPECIFICATION FOR OTHER REQUIREMENTS.
- 57. ALL CONNECTIONS TO SITE PIPING SHALL BE DONE BY THE PLUMBING CONTRACTOR.
- 58. CLEANOUTS SHALL BE PROVIDED PER 2016 CPC SECTION 707.0 & 719.0 AND TO THE FOLLOWING LOCATIONS:
 - A. AT EACH BASE OF ROOF DRAIN DOWNSPOUTS.
 - B. AT EACH BASE OF WASTE STACK
 - C. AT EVERY 100 FT OF STRAIGHT RUN OF HORIZONTAL PIPING
 - D. AT EACH AGGREGATE HORIZONTAL CHANGE IN DIRECTION EXCEEDING ONE HUNDRED THIRTY-FIVE (135) DEGREES.
 - E. AT EACH HORIZONTAL DRAINAGE PIPE UPPER TERMINAL
 - F. ABOVE EACH URINAL
 - G. BELOW EACH SINK.
- 59. PROVIDE SEDIMENT TRAP AS CLOSE AS POSSIBLE TO ALL GAS APPLIANCES AND GAS FIRED EQUIPMENTS INLET EXCEPT FOR APPLIANCES LISTED PER 2016 CPC SECTION 1210.8. SEE SEDIMENT TRAP INSTALLATION PER 2016 CPC FIGURE 1210.8.
- 60. DOMESTIC WATER PIPING AND COMPONENTS SHALL BE PROVIDED AND INSTALLED IN COMPLIANCE WITH CALIFORNIA AB 1953 LEGISLATION, WHICH LIMITS THE ALLOWABLE LEAD CONTENT IN CERTAIN DOMESTIC WATER SYSTEM COMPONENTS.

1. SUPPORT AND BRACING FOR NEW PIPING, EXCEPT FIRE SPRINKLER PIPING, AND FOR NEW DUCTWORK SHALL BE PROVIDED PER OPM-0043-13 MASON SEISMIC RESTRAINT

2. LAYOUT DRAWINGS, SHOWING THE BRACING/SUPPORT LOCATIONS AND REFERENCES TO DETAILS FROM THE RELEVANT OSHPD PRE-APPROVALS NEED TO BE SUBMITTED FOR USE BY THE INSPECTOR OF RECORD AND OSHPD FIELD STAFF. THE LAYOUT DRAWINGS, PREPARED PER ASCE 7 CHAPTER 13 AS MODIFIED BY CBC SECTIONS 1613A/1616A, SHALL BE PREPARED BY THE SUBCONTRACTOR AND SIGNED BY A STRUCTURAL ENGINEER LICENSED IN THE STATE OF CALIFORNIA. REFERENCES TO DETAILS FROM THE OSHPD PRE-APPROVAL SHALL BE FOR AN ENTIRE DETAIL AS SUBMITTED OR REFERENCE SHALL BE FOR EACH ASPECT OF A SUBMITTED DETAIL. CUSTOM DETAILS SHALL BE PROVIDED FOR SITUATIONS WHERE OSHPD PRE-APPROVALS DO NOT APPLY. AT LEAST FOUR WEEKS PRIOR TO BEGINNING INSTALLATION, FOUR COPIES OF THE PLANS SHALL BE SUBMITTED TO THE ARCHITECT OF RECORD WHO WILL SUBMIT THEM TO THE STRUCTURAL ENGINEER OF RECORD FOR REVIEW AND APPROVAL. AFTER THIS APPROVAL, THE DRAWINGS WILL BE SUBMITTED TO THE OSHPD DISTRICT STRUCTURAL ENGINEER FOR REVIEW AND APPROVAL. THE PLANS SHALL BE COORDINATED WITH THE PLANS OF OTHER TRADES. A COPY OF THE CHOSEN BRACING SYSTEM

3. THE STRUCTURAL ENGINEER FOR THE CONTRACTOR SHALL DETERMINE THE APPROPRIATE SEISMIC FORCES BASED ON THE DESIGN CRITERIA SHOWN ON THE STRUCTURAL DRAWINGS.

4. ONCE THE EXACT LOCATIONS OF ALL PIPING AND DUCTWORK HAVE BEEN ESTABLISHED, THE STRUCTURAL ENGINEER MUST CHECK THE ADEQUACY OF THE SUPPORTING STRUCTURE

S ARCHITECTS

5151 Shoreham Place, Suite 100 San Diego, Ca 92122

P: 619-299-3917 F: 619-299-5084 www.sfeirarch.com

TCMC PHARMACY **USP 800** UPGRADE


Tri-City Medical Center

4002 Vista Way Oceanside, California 92056

OWNER:	TRI-CITY MEDICAL CENTER 4002 VISTA WAY OCEANSIDE, CALIFORNIA 92056 TEL (760) 940-7709
ARCHITECT:	SFEIR ARCHITECTS 5151 SHOREHAM PLACE, SUITE 100 SAN DIEGO, CALIFORNIA 92122 TEL(619)299–3917 FAX(619)299–5084
MEP:	P2S ENGINEERING, INC. 9665 CHESAPEAKE DRIVE, SUITE 230 SAN DIEGO, CA 92123

STRUCTURAL: SUN STRUCTURAL ENGINEERING 2091 LAS PALMAS DRIVE, SUITE D CARLSBAD, CA 92011 TEL(760)438-1188

TEL(619)618-2347

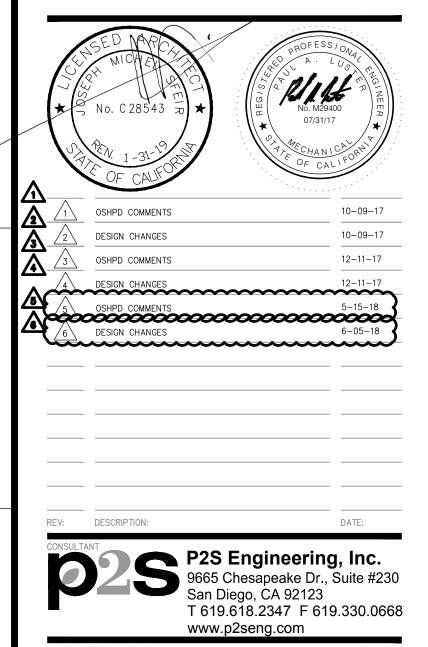



OSHPD #: S171641-37-00

GENERAL NOTES, LEGEND, SYMBOLS, AND SHEET INDEX

TCMC USP 800

 PROJECT #: 01667.00 DRAWN BY: CHECKED BY: SCALE

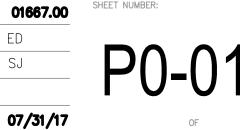





FIXTURE SCHEDULE						
MARK	FIXTURE	CW	HW	S OR W	V	REMARKS
S-1	HAND SINK	1/2"	1/2"	2"	1-1/2"	CUSTOM STAINLESS STEEL HAND SCRUBBING SINK. SEE ARCHITECTURAL DRAWINGS. PROVIDE WITH CHICAGO FAUCET #201-AGN10ASE33-317AB (2.2 GPM), LOOSE KEY STOPS AND RIGID SUPPLIES, AND P-TRAP.
EEW	EMERGENCY EYE / FACE WASH	1"	1/2"	<u>}</u>	-	HAWS "AXION MSR SINK MOUNT EYE/FACE WASH" 7610 WITH THERMOSTATIC MIXING 3 VALVE.
T/EEW-1	TEMPORARY EMERGENCY EYE / FACE WASH			-	-	HAWS 15 GAL PRESSURIZED EMERGENCY EYEWASH 7603.
T/S-1	TEMPORARY HAND SINK	-	-	-	-	POLY PORTABLE TWIN FREE-STANDING HAND WASH STATION-PPST-05 45 GAL FRESH & 45 GAL GRAY HOLDING TANKS

STOPS AND FAUCETS AS REQUIRED.

PIPE SCHEDULE

SERVICE	LOCATION	
DOMESTIC WATER	COLD WATER	T
DOMESTIC WATER	HOT WATER	S/ SI
SANITARY WASTE	ABOVE GRADE	N W
SANITANT WASTE	BELOW GRADE	N W
	CONCEALED	N W
SANITARY VENT	EXPOSED	N W

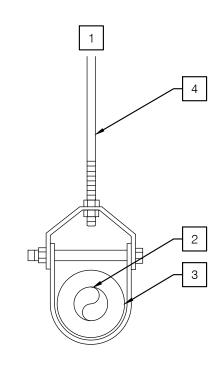


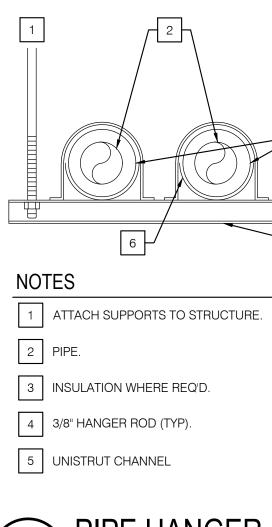




MATERIALS

TYPE "L" COPPER TUBING W/ WROUGHT COPPER SWEAT FITTINGS. SAME AS ABOVE W/ 1" THICK MINERAL FIBER, PREFORMED PIPE INSULATION FOR NPS 1-1/4" AND SMALLER. USE 1-1/2" THICK FOR NPS 1-1/2" AND LARGER. NO-HUB CAST IRON BY "AB&I, TYLER OR CHARLOTTE", LISTED WITH C.I.S.P.I. AND SHALL COMPLY WITH STANDARD 301, HEAVY-DUTY STAINLESS STEEL FOUR BAND COUPLINGS ASTM C 1277. NO-HUB CAST IRON BY "AB&I, TYLER OR CHARLOTTE", LISTED WITH C.I.S.P.I. AND SHALL COMPLY WITH STANDARD 301, HEAVY-DUTY STAINLESS STEEL FOUR BAND COUPLINGS ASTM C 1277. NO-HUB CAST IRON BY "AB&I, TYLER OR CHARLOTTE", LISTED WITH C.I.S.P.I. AND SHALL COMPLY WITH STANDARD 301, HEAVY-DUTY STAINLESS STEEL FOUR BAND COUPLINGS ASTM C 1277. NO-HUB CAST IRON BY "AB&I, TYLER OR CHARLOTTE", LISTED WITH C.I.S.P.I. AND SHALL COMPLY WITH STANDARD 301, HEAVY-DUTY STAINLESS STEEL FOUR BAND COUPLINGS ASTM C 1277.

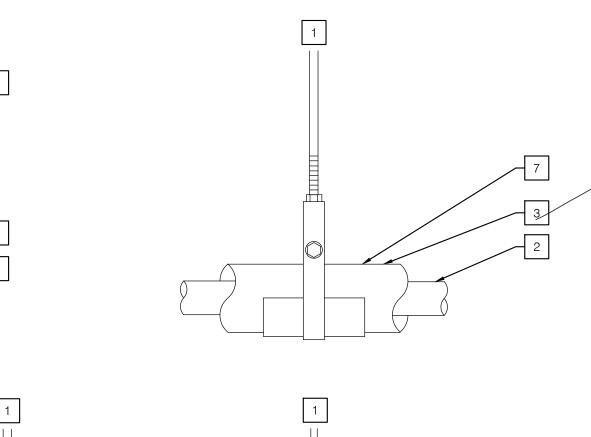

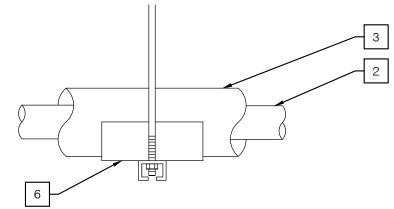

6 20 GA. GALV. IRON SHEET SHIELD (12" LONG).

7 PROVIDE A SECTION OF HIGH COMPRESSION STRENGTH INSULATION AT EACH HANGER POINT. INSULATION MAY BE HALF ROUND OR FULL ROUND & EXTENDED 2" BEYOND GALV. SHIELD EA. WAY.



5151 Shoreham Place, Suite 100 San Diego, Ca 92122

P: 619-299-3917 F: 619-299-5084 www.sfeirarch.com

TCMC PHARMACY USP 800 UPGRADE

Tri-City Medical Center

	de, California 920	56
WNER:	TRI-CITY MEDICAL C 4002 VISTA WAY OCEANSIDE, CALIFOR TEL (760) 940-770	NIA 92056
RCHITECT:	SFEIR ARCHITECTS 5151 SHOREHAM PL/ SAN DIEGO, CALIFOR TEL(619)299–3917	NIA 92122
1EP:	P2S ENGINEERING, IN 9665 CHESAPEAKE I SAN DIEGO, CA 9212 TEL(619)618–2347	DRIVE, SUITE 230
STRUCTURA	L: SUN STRUCTURAL EN 2091 LAS PALMAS E CARLSBAD, CA 9201 TEL(760)438–1188	DRIVE, SUITE D
No.	C 28543 ₹ 1-31-19	PROFESS / ONA PROFESS / ONA No. M29400 07/31/17 PTECHANICA PROFESS / ONA PROFESS / ONA PR
	D COMMENTS	10-09-1
	GN CHANGES	10-09-1
$\overline{\bigwedge}$	D COMMENTS	
	GN CHANGES	
	PD COMMENTS	12-11-17 5-15-18

_____ REV: DESCRIPTION: DATE: P2S Engineering, Inc. 9665 Chesapeake Dr., Suite #230 San Diego, CA 92123 T 619.618.2347 F 619.330.0668 www.p2seng.com

OSHPD #: S171641-37-00

OSHPD APPROVAL STAMP:

SCHEDULES AND DETAILS


PROJECT TITLE: TCMC USP 800


PROJECT #: 01667.00 DRAWN BY: ED CHECKED BY: SJ SCALE:

DATE:


SHEET NUMBER: P().

07/31/17 100% CONSTRUCTION DOCUMENT

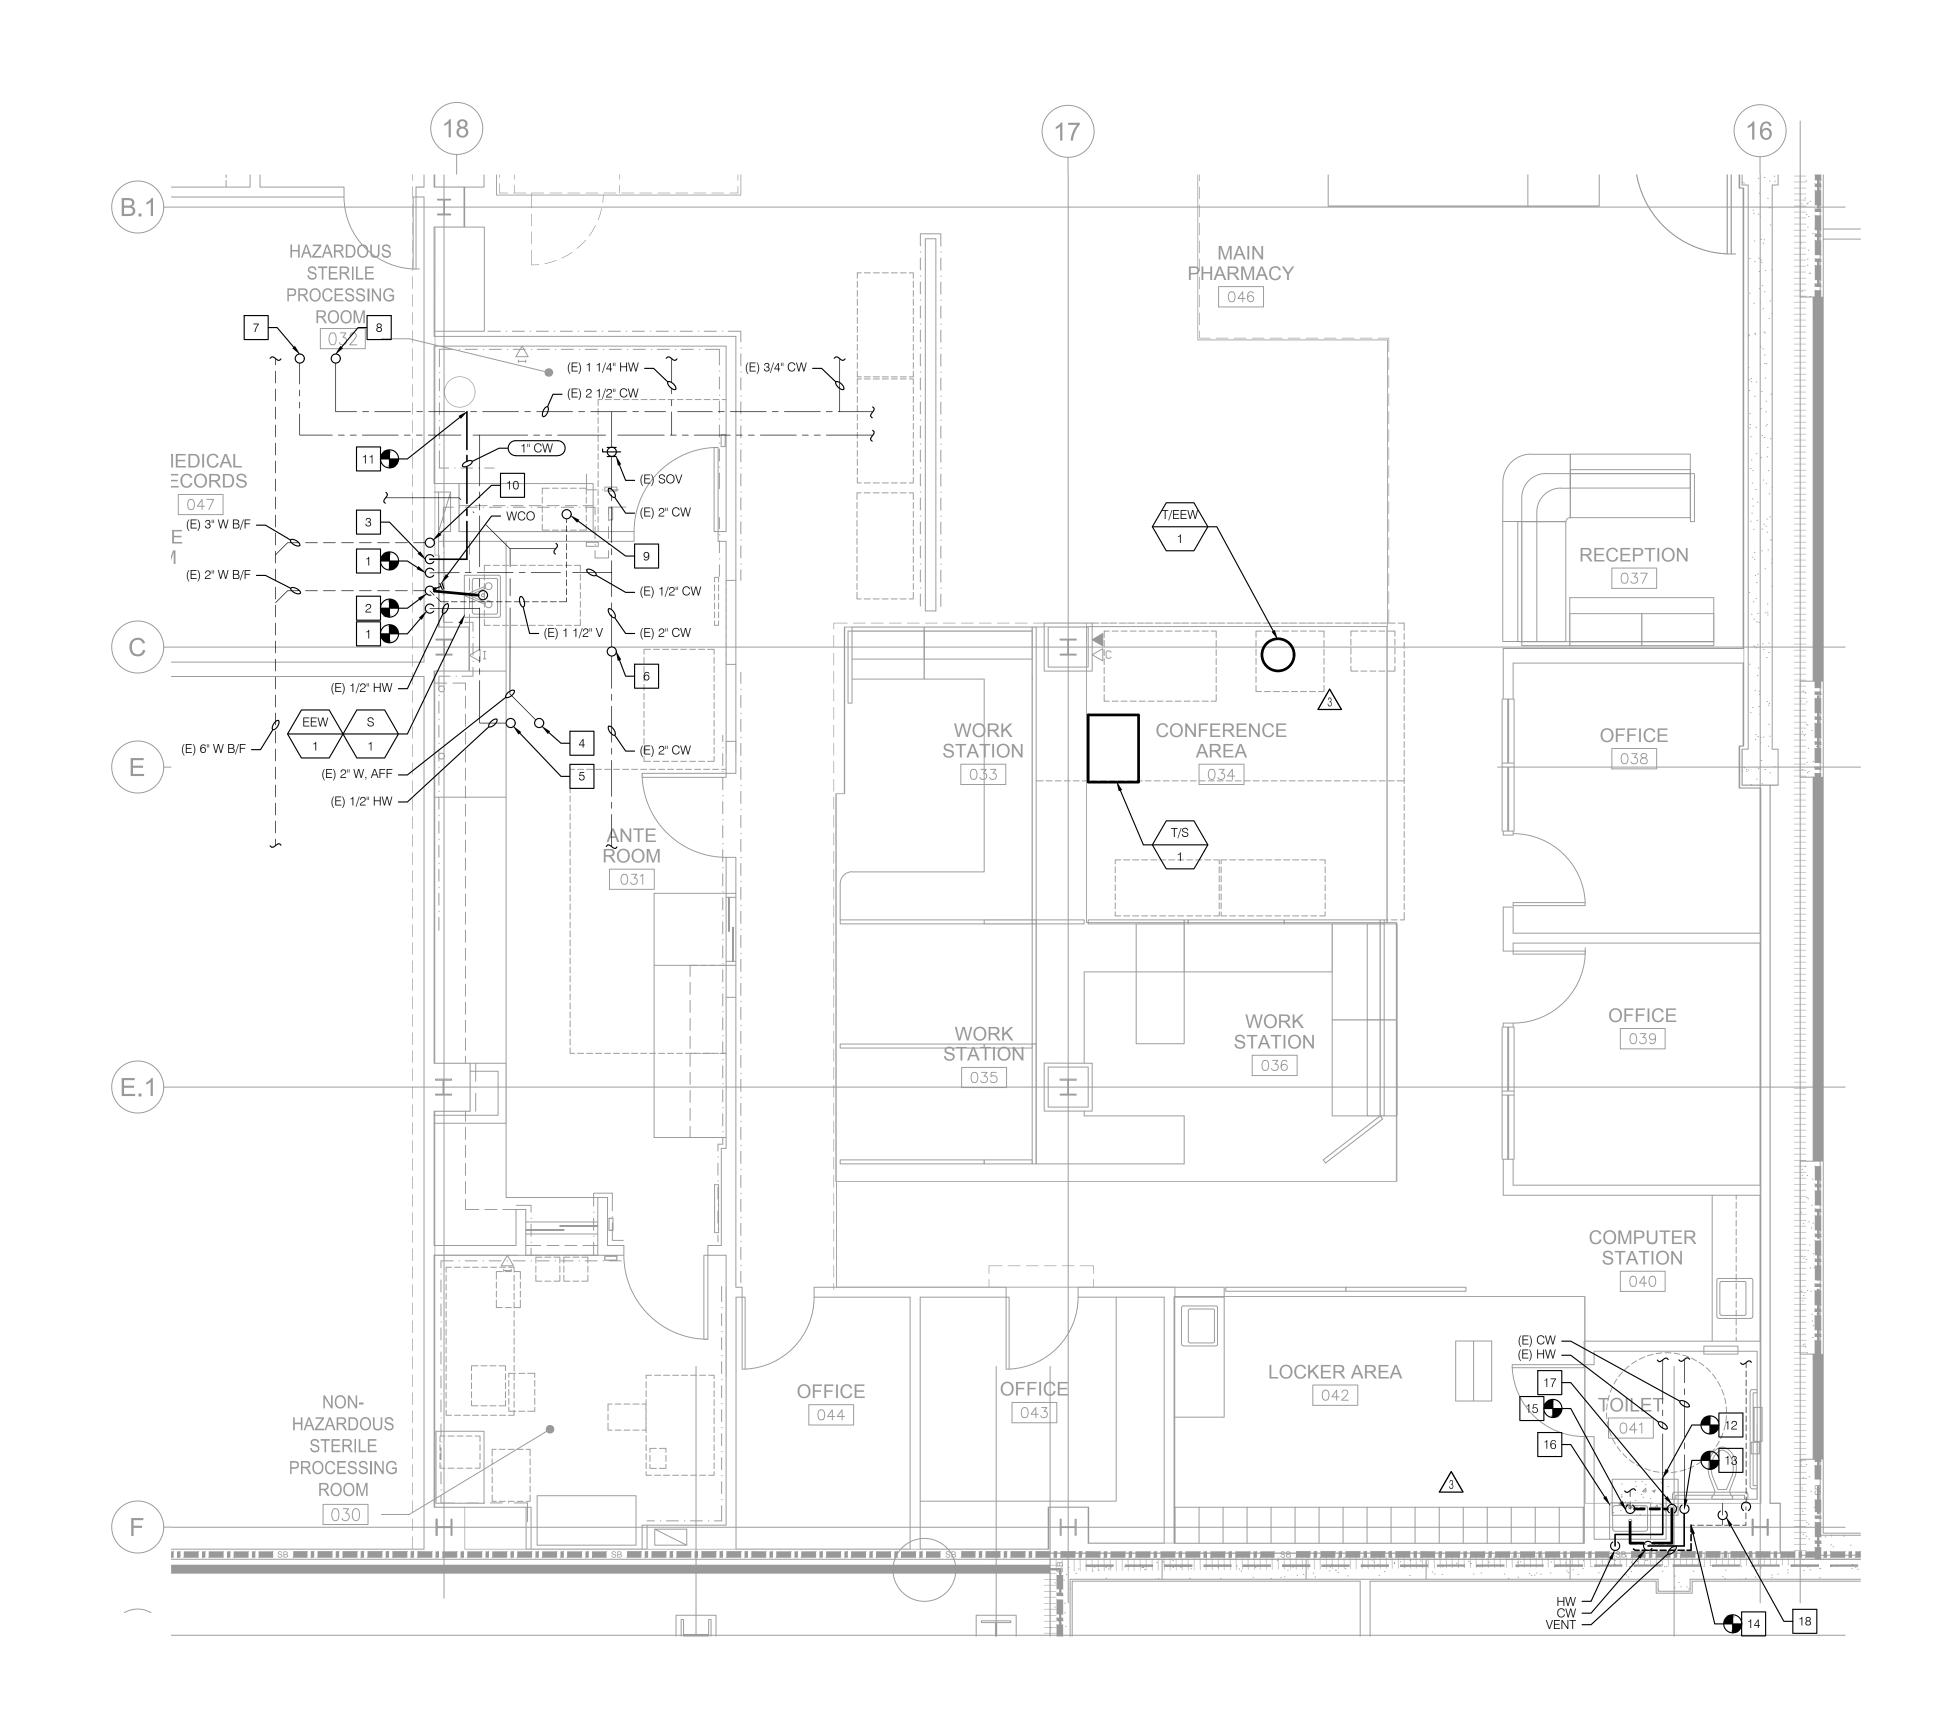

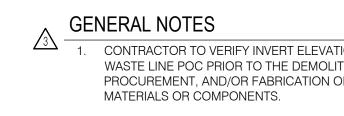

		NO.	TES		S F E I R
VATION OF SINK OLITION,			POC 1/2" CW AND HW TO (E) 1/2" CW AND HW.		ARCHITECTS
OLITION, IN OF ANY		2	POC 2" W TO (E) 2" W.		5151 Shoreham Place, Suite 100
	(3	1" CW DN & 1/2" HW CONNECTION TO THERMOST. MIXING VALVE FOR EMERGENCY EYE WASH.	ATIC	San Diego, Ca 92122
		4	(E) 2" W UP.		P: 619-299-3917 F: 619-299-5084 www.sfeirarch.com
		5	(E) 1/2" HW UP.		
		6	(E) 2" CW UP.(E) 1/2" HW.		TCMC
		8	(E) 1/2" CW UP.		PHARMACY
		9	(E) 1 1/2" V UP.		
		10	(E) 3" W UP.		USP 800
		11	POC 1" CW TO (E) 2 1/2" CW.		UPGRADE
		12	POC AT HW LINE.		
		13	POC AT CW LINE.		Tri-City Medical Cente
		14	POC TO (E) VENT. POC TO (E) WASTE LINE.		
	∕3∖	15 16	EXISTING SINK RELOCATED TO NEW POSITION.		4002 Vista Way Oceanside, California 92056
	<u> </u>	17	1-1/2" WASTE DOWN THROUGH SLAB.		
		18	(E) WATER CLOSET WASTE DOWN THROUGH SLA	В.	OWNER: TRI-CITY MEDICAL CENTER 4002 VISTA WAY OCEANSIDE, CALIFORNIA 92056 TEL (760) 940-7709
				_	ARCHITECT: SFEIR ARCHITECTS
					5151 SHOREHAM PLACE, SUITE 100 SAN DIEGO, CALIFORNIA 92122 TEL(619)299-3917 FAX(619)299-5084
					MEP: P2S ENGINEERING, INC. 9665 CHESAPEAKE DRIVE, SUITE 230
					SAN DIEGO, CA 92123 TEL(619)618–2347
				_	STRUCTURAL: SUN STRUCTURAL ENGINEERING 2091 LAS PALMAS DRIVE, SUITE D CARLSBAD, CA 92011
					TEL(760)438–1188
					KINSED MARCHA
					× No. C 28543 ₽ ★
					07/31/17 + 07/31/17 +
					OF CALIFOR
				_	$\frac{1}{2} \frac{1}{1} \frac{1}$
					$\begin{array}{c c} \hline & \hline \\ \hline \\$
					4 DESIGN CHANGES 12-11-17 5 OSHPD COMMENTS 5-15-18
					6 DESIGN CHANGES 6-05-18
					REV: DESCRIPTION: DATE:
					P2S Engineering, Inc. 9665 Chesapeake Dr., Suite #230
					San Diego, CA 92123 T 619.618.2347 F 619.330.0668 www.p2seng.com
					OSHPD APPROVAL STAMP:
				_	OSHPD #: S171641-37-00
					SHEET TITLE:
					PARTIAL RENOVATION
					FLOOR PLAN
			~ ~ M ~		PROJECT TITLE: TCMC USP 800
		L			DRAWN BY: FD
		Ļ		<i>۲</i>	CHECKED BY: SJ SCALE: P2-10
I			0 SCALE: 1/4	4 ." = 1'-0"	DATE: 07/31/17 OF

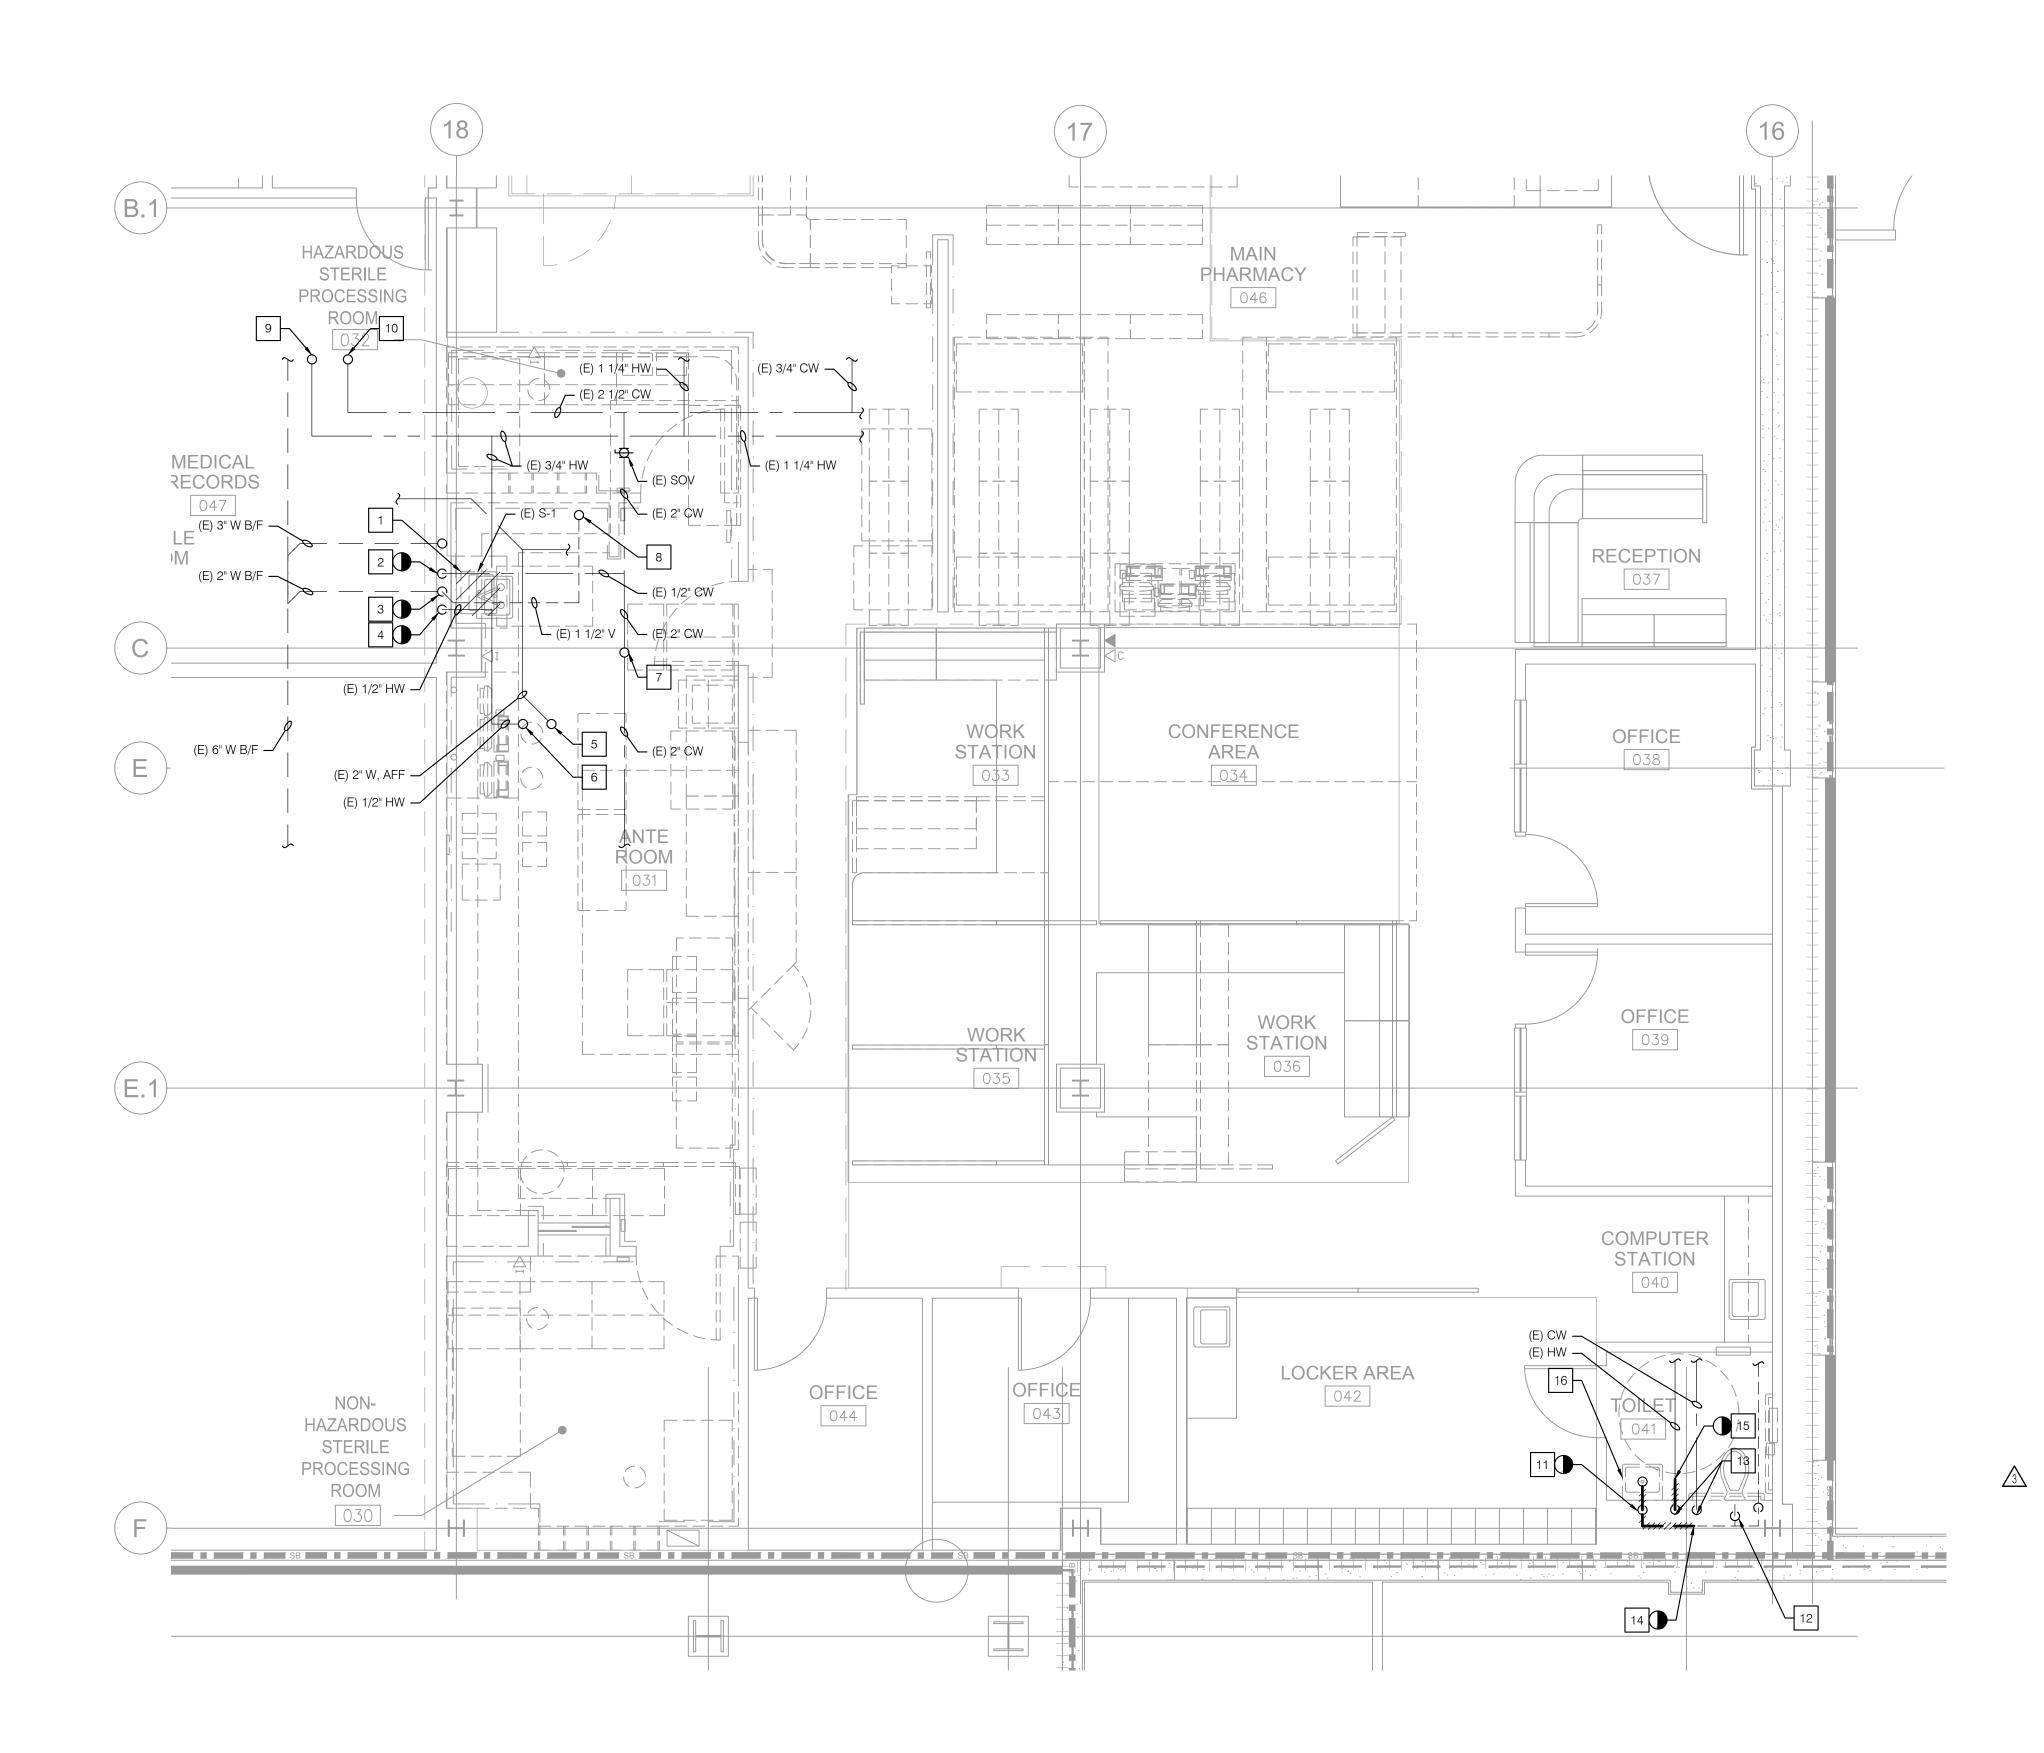

GENERAL NOTES



1. CONDITION SHOWN ON DRAWINGS AF REVIEW OF AVAILABLE AS-BUILT DRAV INVESTIGATIONS TO THE EXTENT POS CONTRACTOR SHALL VERIFY EXISTING DISCREPENCIES DISCOVERED SHALL THE ATTENTION OF THE ARCHITECT, OWNERS REPRESENTATIVE PRIOR TO THE COMMENCEMENT OF ANY WORK.

NOTES

RE BASED ON
WINGS AND FIELD
SIBLE.
G CONDITIONS. ANY
BE BROUGHT TO
ENGINEER AND
THE

1 REMOVE (E) SINK AND ITS ASSOCIATED APPURTENANCES.
2 REMOVE (E) 1/2" CW FROM SINK TO PIPE IN WALL.
3 REMOVE (E) 2" W FROM SINK TO PIPE IN WALL.
4 REMOVE (E) 1/2" HW FROM SINK TO PIPE IN WALL.
5 (E) 2" W UP TO (E) SH.
6 (E) 1/2" HW UP.
7 (E) 2" CW UP.
8 (E) 1 1/2" V UP.

- 9 (E) 1/2" HW UP.
- 10 (E) 1/2" CW UP.

 $\underline{\land}$

(E) SINK WASTE DOWN THROUGH SLAB. CONTRACTOR TO
 11
 VERIFY THE SIZE OF (E) SINK WASTE PRIOR TO THE DEMOLITION OR PROCUREMENT OF ANY MATERIALS OR
 COMPONENTS.

- [12] (E) WATER CLOSET WASTE DOWN THROUGH SLAB. (E) CW DOWN WALL TO LAV AND WATER CLOSET AND HW
- 13
 UTILITIES PRIOR TO THE DEMOLITION, PROCUREMENT AND/OR FABRICATION OF ANY MATERIALS OR

 COMPONENTS.
- POD AT EXISTING VENT. CONTRACTOR TO VERIFY THE14SIZE OF (E) SINK VENT PRIOR TO THE DEMOLITION OR PROCUREMENT OF ANY MATERIALS OR COMPONENTS.
- 15POD AT EXISTING HW LINE. CONTRACTOR TO VERIFY THE
SIZE OF (E) HW LINE PRIOR TO THE DEMOLITION OR
PROCUREMENT OF ANY MATERIALS OR COMPONENTS. (E) FIXTURE TO BE REMOVED DURING DEMOLITION IN
- 16 PREPARATION FOR RE-USE. CONTRACTOR TO STORE AND PROTECT (E) SINK DURING CONSTRUCTION.
- 17 PRESERVE & PROTECT THE (E) WATER CLOSET DURING DEMOLITION.

F S R E A R C H I T E C T S

5151 Shoreham Place, Suite 100 San Diego, Ca 92122

P: 619-299-3917 F: 619-299-5084 www.sfeirarch.com

TCMC PHARMACY USP 800 UPGRADE

Tri-City Medical Center

	Vista Way anside, California 92056	
OWNER	: TRI-CITY MEDICAL CENTER 4002 VISTA WAY OCEANSIDE, CALIFORNIA 920 TEL (760) 940-7709	56
ARCHIT	ECT: SFEIR ARCHITECTS 5151 SHOREHAM PLACE, SUI SAN DIEGO, CALIFORNIA 9212 TEL(619)299–3917 FAX(619	22
MEP:	P2S ENGINEERING, INC. 9665 CHESAPEAKE DRIVE, SI SAN DIEGO, CA 92123 TEL(619)618–2347	JITE 230
STRUCT	TURAL: SUN STRUCTURAL ENGINEERII 2091 LAS PALMAS DRIVE, SU CARLSBAD, CA 92011 TEL(760)438–1188	
	No. C 28543 T No. C 28543 T No. M2 07/31 OF CALFOR OF CALFOR OF COMMENTS	
	DESIGN CHANGES	10-09-17
	OSHPD COMMENTS	12-11-17
	DESIGN CHANGES	12-11-17
	OSHPD COMMENTS	5-15-18 6-05-18
REV:	DESCRIPTION:	DATE:
CONSULTA	P2S Engineerin 9665 Chesapeake Dr. San Diego, CA 92123 T 619.618.2347 F 67 www.p2seng.com	, Suite #230

OSHPD #: S171641-37-00

OSHPD APPROVAL STAMP:


PARTIAL DEMOLITION FLOOR PLAN



DATE:





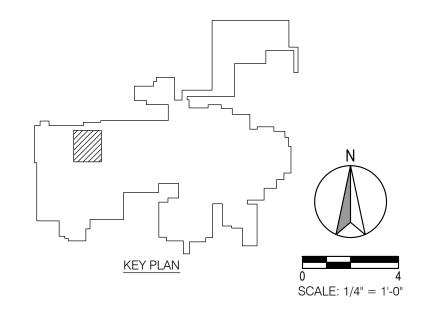

LEGEND

<u>SYMBOL</u> <u>_____ - ____ - ____</u>

 $\widetilde{}$

ГЧ

DESCRIPTION

NOTE CALLOUT
NEW LINEWORK
EXISTING LINEWORK
CONDUIT CONCEALED IN WALL OR ABOVE CEILING
CONDUIT EXPOSED
CONDUIT & WIRE TO BE DEMOLISHED
CONDUIT CAPPED
BRANCH CIRCUIT HOMERUN TO PANELBOARD AND CIRCUITS AS INDICATED
CONDUIT EMERGENCY
3/4" CONDUIT, TICK MARKS INDICATE QUANTITY OF #12 AWG WIRES (UNLESS NOTED OTHERWISE, NO MARKS INDICATES 2#12 & 1#12 GND WIRES) - SMALL MARK DENOTES HOT WIRE - LARGE MARK DENOTES NEUTRAL WIRE - DIAGONAL DENOTES GROUND WIRE
CIRCUIT BREAKER
TRANSFER SWITCH
TRANSFER SWITCH TRANSFORMER
TRANSFORMER
TRANSFORMER GROUND CONNECTION
TRANSFORMER GROUND CONNECTION FUSED DISCONNECT SWITCH SINGLE POLE SWITCH, DEVICE SHALL BE MOUNTED +48" MAX
TRANSFORMER GROUND CONNECTION FUSED DISCONNECT SWITCH SINGLE POLE SWITCH, DEVICE SHALL BE MOUNTED +48" MAX AND +36" MIN FROM THE CENTER OF DEVICE:
TRANSFORMER GROUND CONNECTION FUSED DISCONNECT SWITCH SINGLE POLE SWITCH, DEVICE SHALL BE MOUNTED +48" MAX AND +36" MIN FROM THE CENTER OF DEVICE: JUNCTION BOX
TRANSFORMER GROUND CONNECTION FUSED DISCONNECT SWITCH SINGLE POLE SWITCH, DEVICE SHALL BE MOUNTED +48" MAX AND +36" MIN FROM THE CENTER OF DEVICE: JUNCTION BOX DUPLEX - WALL +18" A.F.F. (CONNECT TO EMERGENCY
TRANSFORMER GROUND CONNECTION FUSED DISCONNECT SWITCH SINGLE POLE SWITCH, DEVICE SHALL BE MOUNTED +48" MAX AND +36" MIN FROM THE CENTER OF DEVICE: JUNCTION BOX DUPLEX - WALL +18" A.F.F. CONNECT TO EMERGENCY GENERATOR)
TRANSFORMER GROUND CONNECTION FUSED DISCONNECT SWITCH SINGLE POLE SWITCH, DEVICE SHALL BE MOUNTED +48" MAX AND +36" MIN FROM THE CENTER OF DEVICE: JUNCTION BOX DUPLEX - WALL +18" A.F.F. (CONNECT TO EMERGENCY GENERATOR) JUNCTION BOX - WALL
TRANSFORMERGROUND CONNECTIONFUSED DISCONNECT SWITCHSINGLE POLE SWITCH, DEVICE SHALL BE MOUNTED + 48" MAX AND + 36" MIN FROM THE CENTER OF DEVICE:JUNCTION BOXDUPLEX - WALL + 18" A.F.F.DUPLEX - WALL + 18" A.F.F. (CONNECT TO EMERGENCY GENERATOR)JUNCTION BOX - WALLPANELBOARD, 120/208V - RECESSED

ABBREVIATIONS

ABBREVIATION	DESCRIPTION	1.	AL AN
A OR AMP ABV	AMPERES ABOVE		CC CC SH
AFF	ABOVE FINISHED FLOOR		011
AIC	AMPERE INTERRUPTING CAPACITY	2.	AP
AL	ALUMINUM		00
ARCH.			20-
ASCC ATS	AVAILABLE SHORT CIRCUIT CURRENT AUTOMATIC TRANSFER SWITCH		(2 20 ⁻
AUX	AUXILIARY		
AWG	AMERICAN WIRE GAUGE		(2 20 ⁻
BKBD	BACKBOARD		20
BKR	BREAKER		20 ⁻
BLDG	BUILDING		(2
C	CONDUIT CIRCUIT BREAKER		(E
CB CKT	CIRCUIT		20 ⁻
CL	CENTER LINE		(2
CLG	CEILING		(-
C.O.	CONDUIT ONLY WITH PULL WIRE	3.	ΤH
CSFD	COMBINATION SMOKE FIRE DAMPER		ΒU
CU			CA
DIAG DWP	DIAGRAM DEPARTMENT OF WATER & POWER		BY
EA	EACH		TH
ELEC.	ELECTRICAL		AN OF
EMT	ELECTRICAL METALLIC TUBING		W
EQUIP	EQUIPMENT		
EXIST/(E)	EXISTING EXISTING TO BE RECONNECTED IN NEW		IN
(ENL)	LOCATION		PL/
(ERR)	EXISTING TO BE REMOVED, RELOCATED AND RECONNECTED		SP JO
FLA	FULL LOAD AMPS		00
FLR	FLOOR	4.	OM
FT	FEET		DE
GFI	GROUND FAULT INTERRUPTER		ΤH
GEC	GROUNDING ELECTRODE CONDUCTOR		NC
GND HP	GROUND HORSEPOWER		DE
HT	HEIGHT		SE
HZ	HERTZ	5.	ΤН
ISC	SHORT CIRCUIT CURRENT		ΤH
JB	JUNCTION BOX		FIG
KCMIL	THOUSAND CIRCULAR MILS		SC
KV KW	KILOVOLT KILOWATT		SC
			FIG WH
LFMC	LIQUIDTIGHT FLEXIBLE METAL CONDUIT		
LOC. LTG	LOCATION LIGHTING	6.	MA
MAX	MAXIMUM		(UL
MFGR	MANUFACTURER		AP
MTD	MOUNTED	7.	ΤН
MTG	MOUNTING		ME
N			ΕN
NIC NO.	NOT IN CONTRACT NUMBER	0	WF
P	POLE	8.	CC
PB	PULL BOX		RE
PF	POWER FACTOR		(PF
PH OR Ø	PHASE		NC
PNL PVC	PANEL POLY-VINYL CHLORIDE		CA
PWR	POWER		MA DR
(R)	REMOVE		DI
REC/RECEPT	RECEPTACLE	9.	CU
REQ'D			СС
RGS RM	RIGID GALVANIZED STEEL ROOM		СС
SPECS	SPECIFICATIONS	10.	СС
SWBD	SWITCHBOARD		(IN
SWGR	SWITCHGEAR		TO
TEL./TELE	TELEPHONE		MC
TRANSF/XFMR	TRANSFORMER		CC
TYP	TYPICAL	11.	FO
UON	UNLESS OTHERWISE NOTED		ES
V VA	VOLTS VOLT-AMPERES		SC
VA W	WATTS		INF
W/	WITH		WF
W/O	WITHOUT	12.	EL
WP	WEATHERPROOF		W
USED, REFERENC	BREVIATIONS NOT MENTIONED HEREIN ARE E WILL BE MADE TO ANSI Y1.1, MILITARY		

IN THE E USED, REFERENCE WILL BE MADE TO ANSI Y1.1, MILITARY STANDARD ABBREVIATIONS, AND OTHER STANDARD INDUSTRY CONVENTIONS.

GENERAL NOTES

1. ALL WORK SHALL COMPLY WITH THE 2016 EDITION OF THE CALIFORNIA ELECTRICAL CODE ND ALL OTHER APPLICABLE FEDERAL, STATE, AND LOCAL CODES. WHERE THE ONSTRUCTION DOCUMENTS INDICATE MORE RESTRICTIVE REQUIREMENTS, THE ONSTRUCTION DOCUMENTS SHALL GOVERN BUT THE CONSTRUCTION DOCUMENTS HALL NOT BE INTERPRETED AS AUTHORITY TO VIOLATE ANY CODE OR REGULATION.

PPLICABLE CODES:

- 015 IBC AND 2016 CALIFORNIA AMENDMENTS
- (2016 CALIFORNIA BUILDING CODE PART 2, TITLE 24, CCR)
- 014 NEC AND 2016 CALIFORNIA AMENDMENTS
- (2016 CALIFORNIA ELECTRICAL CODE PART 3, TITLE 24, CCR)
- 015 UMC AND 2016 CALIFORNIA AMENDMENTS
- (2016 CALIFORNIA MECHANICAL CODE PART 4, TITLE 24, CCR) 015 UPC AND 2016 CALIFORNIA AMENDMENTS
- (2016 CALIFORNIA PLUMBING CODE PART 5, TITLE 24, CCR)-(PUBLISHER:IAPMO)
- 015 IFC AND 2016 CALIFORNIA AMENDMENTS
- (2016 CALIFORNIA FIRE CODE PART 9, TITLE 24, CCR)

HE INTENT OF THE DRAWINGS AND SPECIFICATIONS IS TO RECONSTRUCT THE HOSPITAL UILDING IN ACCORDANCE WITH THE CALIFORNIA BUILDINGS STANDARD CODE, TITLE 24, ALIFORNIA CODE OF REGULATIONS. SHOULD ANY CONDITION DEVELOP NOT COVERED Y THE CONTRACT DOCUMENTS WHEREIN THE FINISHED WORK WILL NOT COMPLY WITH HE SAID TITLE 24, CALIFORNIA CODE OF REGULATIONS, A CHANGE ORDER DETAILING ND SPECIFYING THE REQUIRED WORK SHALL BE SUBMITTED TO AND APPROVED BY FFICE OF STATE WIDE HEALTH PLANNING AND DEVELOPMENT BEFORE PROCEEDING VITH THE WORK.

I THE EVENT OF A CONFLICT OR INCONSISTENCY BETWEEN ITEMS INDICATED ON THE LANS AND/OR SPECIFICATIONS OR WITH CODE REQUIREMENTS, THE NOTE, PECIFICATION OR CODE WHICH PRESCRIBES AND ESTABLISHES THE MORE COMPLETE OB OR THE HIGHER STANDARD SHALL PREVAIL.

MISSIONS FROM THE DRAWINGS OR SPECIFICATIONS OR THE MISDESCRIPTION OF ETAILS OF WORK WHICH ARE MANIFESTLY NECESSARY TO CARRY OUT THE INTENT OF HE DRAWINGS AND SPECIFICATIONS, OR WHICH ARE CUSTOMARILY PERFORMED, SHALL OT RELIEVE THE CONTRACTOR FROM PERFORMING SUCH OMITTED OR MISDESCRIBED ETAILS OF THE WORK BUT THEY SHALL BE PERFORMED AS IF FULLY AND CORRECTLY ET FORTH AND DESCRIBED IN THE DRAWINGS AND SPECIFICATIONS.

HE CONTRACTOR SHALL CHECK ALL DRAWINGS FURNISHED TO HIM IMMEDIATELY UPON HEIR RECEIPT AND SHALL PROMPTLY NOTIFY THE OWNER OF ANY DISCREPANCIES. GURES MARKED ON DRAWINGS SHALL IN GENERAL BE FOLLOWED IN PREFERENCE TO CALE MEASUREMENTS. LARGE SCALE DRAWINGS SHALL IN GENERAL GOVERN SMALL CALE DRAWINGS. THE CONTRACTOR SHALL COMPARE ALL DRAWINGS AND VERIFY THE GURES BEFORE LAYING OUT THE WORK AND WILL BE RESPONSIBLE FOR ANY ERRORS HICH MIGHT HAVE BEEN AVOIDED THEREBY.

ATERIALS AND EQUIPMENT SHALL BE NEW AND SHALL BEAR THE UNDERWRITERS' LABEL JL) AND SHALL BE INSTALLED IN THE MANNER FOR WHICH THEY ARE DESIGNED AND PPROVED.

HE CONTRACTOR SHALL NOT BORE, NOTCH OR IN ANY WAY CUT INTO ANY STRUCTURAL EMBER WITHOUT WRITTEN APPROVAL FROM THE ARCHITECT OR STRUCTURAL NGINEER.

HEN INSTALLING DRILLED-IN ANCHORS IN EXISTING NON-PRESTRESSED REINFORCED ONCRETE, USE CARE AND CAUTION TO AVOID CUTTING OR DAMAGING THE EXISTING EINFORCING BARS. WHEN INSTALLING THEM INTO EXISTING PRESTRESSED CONCRETE PRE- OR POST-TENSIONED), LOCATE THE PRESTRESSED TENDONS BY USING A ON-DESTRUCTIVE METHOD PRIOR TO INSTALLATION. EXERCISE EXTREME CARE AND AUTION TO AVOID CUTTING OR DAMAGING THE TENDONS DURING INSTALLATION. AINTAIN A MINIMUM CLEARANCE OF ONE INCH BETWEEN THE REINFORCEMENT AND THE RILLED-IN ANCHOR.

UT AND PATCH EXISTING CEILING AND WALL CONSTRUCTION AS REQUIRED FOR ONDUIT, OUTLET BOX, SUPPORTS AND EQUIPMENT INSTALLATION. REPAIR OF EXISTING ONSTRUCTION SHALL MATCH EXISTING TO THE ARCHITECTS SATISFACTION.

ONDUIT CONNECTIONS TO MACHINES AND EQUIPMENT SUBJECT TO VIBRATION NCLUDING TRANSFORMERS) SHALL BE MADE WITH LFMC. PROVIDE SUFFICIENT SLACK O ELIMINATE VIBRATION. ARRANGE CONNECTIONS TO PREVENT THE ENTRANCE OF OISTURE. PROVIDE CONTINUOUS GROUND WIRE THROUGH LFMC TO ASSURE GROUND ONTINUITY. REFERENCE CEC 250.64 FOR GEC INSTALLATION.

OR PURPOSES OF CLEARNESS AND LEGIBILITY, THE ELECTRICAL DRAWINGS ARE SSENTIALLY DIAGRAMMATIC. THE SIZE AND LOCATION OF EQUIPMENT IS SHOWN TO CALE WHEREVER POSSIBLE. THE CONTRACTOR SHALL VERIFY ALL CONDITIONS, DATA IFORMATION AS INDICATED ON THE DRAWINGS AND IN THE SPECIFICATION SECTIONS HERE ELECTRICAL WORK INTERFACES WITH OTHER TRADES.

LECTRICAL CONTRACTOR SHALL COMPLY WITH THE CALIFORNIA STATE HANDICAP LAWS /ITH REGARD TO THE FOLLOWING:

- A. MOUNTING HEIGHT OF RECEPTACLES NO OUTLET SHALL BE MOUNTED ON A WALL AT LESS THAN 18" AFF.
- B. MOUNTING HEIGHT OF SWITCHES AND THERMOSTATS DEVICES SHALL BE MOUNTED AT NO HIGHER THAN 48" AFF FROM CENTER OF DEVICE, BUT NOT LESS THAN 36" AFF.

13. THE CONTRACTOR SHALL MAINTAIN AS-BUILT DRAWINGS TO REFLECT ALL CHANGES MADE DURING CONSTRUCTION AND ANY DEVIATIONS FROM THE ELECTRICAL DRAWINGS. THIS INCLUDES DEVIATIONS FROM CIRCUIT NUMBERS AND ANY ADDITION, DELETION OR RELOCATION OF OUTLETS SHOWN ON WORKING DRAWINGS.

14. 2016 CBC MECHANICAL, ELECTRICAL AND PLUMBING EQUIPMENT ANCHORAGE NOTES:

ALL MECHANICAL, PLUMBING, AND ELECTRICAL COMPONENTS SHALL BE ANCHORED AND INSTALLED PER THE DETAILS ON THE OSHPD APPROVED CONSTRUCTION DOCUMENTS. WHERE NO DETAIL IS INDICATED, THE FOLLOWING COMPONENTS SHALL BE ANCHORED OR BRACED TO MEET THE FORCES AND DISPLACEMENT REQUIREMENTS PRESCRIBED IN THE 2016 CBC, SECTIONS 1616A.1.23, 1.24, 1.25, 1.26 AND ASCE 7-05 CHAPTER 13.

- A. ALL PERMANENT EQUIPMENT AND COMPONENTS.
- B. TEMPORARY OR MOVABLE EQUIPMENT THAT IS PERMANENTLY ATTACHED (E.G. HARD WIRED) TO THE BUILDING UTILITY SERVICES SUCH AS ELECTRICITY, GAS OR WATER.
- C. MOVABLE EQUIPMENT WHICH IS STATIONED IN ONE PLACE FOR MORE THAN 8 HOURS AND HEAVIER THAN 400 POUNDS ARE REQUIRED TO BE ANCHORED WITH TEMPORARY ATTACHMENTS.

THE ATTACHMENT OF THE FOLLOWING MECHANICAL AND ELECTRICAL COMPONENT SHALL BE POSITIVELY ATTACHED TO THE STRUCTURE, BUT NEED NOT BE DETAILED ON THE PLANS. 5. WHERE NEW WALL OR CEILING OR OTHER CONSTRUCTION WILL COVER EXISTING OUTLETS, THESE COMPONENTS SHALL HAVE FLEXIBLE CONNECTIONS PROVIDED BETWEEN THE COMPONENT AND ASSOCIATED DUCTWORK, PIPING, AND CONDUIT.

- A. COMPONENTS WEIGHING LESS THAN 400 POUNDS AND HAVE A CENTER OF MASS LOCATED 4 FEET OR LESS ABOVE THE ADJACENT FLOOR OR ROOF LEVEL THAT DIRECTLY SUPPORTS THE COMPONENT.
- B. COMPONENTS WEIGHING LESS THAN 20 POUNDS, OR IN THE CASE OF DISTRIBUTED SYSTEMS, LESS THAN 5 POUNDS PER FOOT, WHICH ARE SUSPENDED FROM A ROOF OR FLOOR OR HUNG FROM A WALL.

FOR THOSE ELEMENTS THAT DO NOT REQUIRE DETAILS ON THE APPROVED DRAWINGS, THE INSTALLATION SHALL BE SUBJECT TO THE APPROVAL OF THE STRUCTURAL ENGINEER OF RECORD. THE PROJECT INSPECTOR WILL VERIFY THAT ALL COMPONENTS AND EQUIPMENT HAVE BEEN ANCHORED IN ACCORDANCE WITH ABOVE REQUIREMENTS.

15. PIPING, DUCTWORK, AND ELECTRICAL DISTRIBUTION SYSTEM BRACING NOTES:

A. PIPING, DUCTWORK, AND ELECTRICAL DISTRIBUTION SYSTEMS SHALL BE BRACED TO COMPLY WITH THE FORCES AND DISPLACEMENTS PRESCRIBED IN ASCE 7-05 SECTION 13.3 AS DEFINED IN ASCE 7-05 SECTION 13.6.8, 13.6.7, 13.6.5.6, AND 2016 CBC, SECTIONS 1616A.1.23, 1.24, 1.25, 1.26.

B. THE BRACING AND ATTACHMENTS TO THE STRUCTURE SHALL BE DETAILED ON THE APPROVED DRAWINGS OR THEY SHALL COMPLY WITH ONE OF THE OSHPD PRE-APPROVALS (OPA #) AS MODIFIED TO SATISFY ANCHORAGE REQUIREMENTS OF ACI 318, APPENDIX D.

C. COPIES OF THE MANUAL SHALL BE AVAILABLE ON THE JOBSITE PRIOR TO THE START OF HANGING AND BRACING OF THE PIPE, DUCTWORK, AND ELECTRICAL DISTRIBUTION SYSTEMS.

D. THE STRUCTURAL ENGINEER OF RECORD SHALL VERIFY THE ADEQUACY OF THE STRUCTURE TO SUPPORT THE HANGER AND BRACE LOADS.

- 16. THE CONTRACTOR SHALL INSTALL ALL CONDUITS AND WIRES WITH A MINIMUM NUMBER OF BENDS AND IN SUCH A MANNER AS TO CONFORM TO THE STRUCTURE. AVOID OBSTRUCTIONS, PRESERVE HEAD ROOM, KEEP OPENINGS AND PASSAGEWAYS CLEAR AND MEET ALL STRUCTURAL CODE REQUIREMENTS.
- 17. PROVIDE TYPEWRITTEN DIRECTORY CARD IN ALL PANELS, IDENTIFY LOAD SERVED BY EACH CIRCUIT BREAKER.
- 18. EXPOSED CONDUITS BELOW 8 FEET SHALL BE RIGID GALVANIZED STEEL (RGS) UON.
- 19. REFER TO ARCHITECTURAL REFLECTED CEILING PLANS FOR EXACT LOCATIONS OF CEILING MOUNTED FIXTURES.
- 20. ALL CONDUIT PENETRATIONS OF FIRE RATED WALLS, FLOORS AND ROOF SHALL BE FIRE STOPPED. FIRE STOP MATERIALS SHALL BE TESTED ASSEMBLY APPROVED BY THE OSHPD FIRE MARSHAL.
- 21. CONTRACTOR SHALL COMPLY WITH ALL GROUNDING AND BONDING REQUIREMENTS OF C.E.C. 517-13, 517-14, 517-19, 517-20, 517-78, 517-82.
- 22. LOCATIONS OF DISCONNECT SWITCHES AND CONNECTIONS FOR MECHANICAL AND PLUMBING EQUIPMENT ARE SHOWN DIAGRAMMATICALLY. VERIFY ACTUAL CONNECTION LOCATIONS WITH EQUIPMENT SHOP DRAWINGS AND LOCATE DISCONNECT SWITCHES TO PROVIDE CODE REQUIRED CLEARANCES AND ACCESS. PROVIDE ANGLE IRON SUPPORT BRACKETS.
- 23. THE CONTRACTOR SHALL OBTAIN BUILDING AND LICENSING PERMITS AND PAY ALL FEES, EXPENSES, AND INCIDENTAL COSTS ASSOCIATED WITH PROVIDING A COMPLETE AND OPERABLE INSTALLATION INCLUDING ALL CHARGES AND EXPENSES ASSOCIATED WITH FEDERAL, STATE, AND LOCAL AGENCIES.
- 24. THE CONTRACTOR SHALL COORDINATE HIS WORK WITH OTHER TRADES AND INCLUDE THE COSTS FOR SUCH COORDINATION IN THE BID.
- 25. THE CONTRACTOR SHALL PROVIDE AN AS-BUILT SET OF DOCUMENTS AT PROJECT COMPLETION SHOWING CHANGES TO THE CONTRACT DOCUMENTS.
- 26. THE CONTRACTOR SHALL PROVIDE CONNECTION AND TERMINATION TO OWNER FURNISHED EQUIPMENT.
- 27. REFERENCE CEC 110.16 AND 110.24. CONTRACTOR TO PROVIDE ARC FLASH LABELS ON ALL ELECTRICAL EQUIPMENT AFFECTED BY SCOPE OF WORK.

DEMOLITION NOTES

1. DRAWINGS OF EXISTING CONDITIONS HAVE BEEN COMPILED FROM EXISTING DATA SUPPLIED BY THE OWNER TO THE ARCHITECT. THE ARCHITECT MAKES NO WARRANTY, EITHER EXPRESSED OR IMPLIED, FOR THE ACCURACY OR COMPLETENESS OF THE EXISTING INFORMATION RECORDED. FIELD VERIFY ALL EXISTING CONDITIONS NOTIFY THE ARCHITECT IMMEDIATELY OF ANY DISCREPANCIES.

2. THE OWNER RESERVES THE RIGHT TO SALVAGE ANY DEMO ITEM. VERIFY ITEMS TO BE SALVAGED WITH THE OWNER PRIOR TO THE START OF DEMOLITION. REMOVE, PROTECT, AND TURN OVER SUCH ITEMS BY DIRECTED BY THE OWNER.

ALL EXISTING ELECTRICAL, LIGHTING, TELEPHONE, DATA, AND PUBLIC ADDRESS CONDUIT AND WIRING SHALL REMAIN EXCEPT WHERE INDICATED OTHERWISE ON THESE PLANS. RECONNECT EXISTING OUTLETS, DEVICES AND CIRCUITS IN ADJACENT SPACES DISRUPTED BY REMOVAL OF EXISTING OUTLETS, DEVICES OR CIRCUITS IN THIS CONTRACT.

4. PROTECT ALL EXISTING CONDUIT, WIRE AND SIGNAL SYSTEMS CABLES PASSING THRU REMODEL AREAS THAT SERVE ADJACENT AREAS.

EQUIPMENT OR DEVICES MAKING THEM INACCESSIBLE, RELOCATE THE EXISTING OUTLET, EQUIPMENT OR DEVICE AS REQUIRED OR MAKE OTHER PROVISIONS TO PROVIDE ACCESS.

RECONNECT EXISTING OUTLETS, LIGHTS, ETC. THAT ARE TO REMAIN THAT ARE DISRUPTED BY REMOVAL OF OTHER EXISTING OUTLETS IN THE CONDUIT RUN AS REQUIRED TO PROVIDE CONTINUITY OF THE CIRCUITS.

REMOVE ALL EXISTING CONDUITS IN CEILING SPACES FOR SYSTEMS, EQUIPMENT AND DEVICES OR OUTLETS BEING REMOVED THAT ARE NOT BEING REUSED AND ALL ABANDONED EXISTING CONDUITS. REMOVE ALL EXISTING CONDUITS IN WALLS OR FLOORS FOR DEVICES BEING REMOVED THAT INTERFERE WITH NEW CONSTRUCTION. REMOVE WIRE FROM ABANDONED CONDUITS.

8. REMOVE ALL ABANDONED SIGNAL SYSTEM CABLES IN CEILING SPACE.

9. THE WORD "ELECTRICAL" USED IN THE CONTEXT OF THESE DEMOLITION PLANS INCLUDES LIGHTING, ELECTRICAL DEVICES & EQUIPMENT, AND ALL SIGNAL SYSTEMS.

10. REFER TO LIGHTING, POWER & SIGNAL PLANS FOR ADDITIONAL EXISTING ELECTRICAL TO REMAIN.

11. WHERE EXISTING DEVICES OR EQUIPMENT ARE INDICATED TO BE REMOVED IN WALLS THAT ARE TO REMAIN, ALSO REMOVE OUTLET BOX OR BACKBOX AND PATCH WALL FINISH TO MATCH SURROUNDING AREA.

12. WHERE EXISTING OUTLETS ARE REMOVED AND THE EXISTING CIRCUIT IS NOT SERVING REMAINING OUTLETS. REMOVE EXISTING WIRE AND CONDUIT BACK TO THE SERVING PANELBOARD AND UPDATE THE PANELBOARD CIRCUIT DIRECTORY INDICATING "SPARE" FOR ALL UNUSED CIRCUIT BREAKERS.

SITE MAP



PROJECT LOCATION -

SHEET INDEX

	<u>SHEET</u>	DESCRIPTION
2	E0.1	GENERAL NOTES, LEGEND, AND SHEET INDEX
$\tilde{\mathbf{C}}$	E0.2	PARTIAL SINGLE LINE DIAGRAM & SCHEDULE
8	E0.3	PANEL SCHEDULES & LOAD SUMMARIES
	ED2.1	PARTIAL DEMOLITION FLOOR PLANS
	E2.1	PARTIAL RENOVATION FLOOR PLANS

5 ARCHITE

5151 Shoreham Place, Suite 100 San Diego, Ca 92122

P: 619-299-3917 F: 619-299-5084 www.sfeirarch.com

TCMC PHARMACY **USP 800** UPGRADE

Tri City Madical Center

MEP: P2S ENGINEERING, INC. 9665 CHESAPEAKE DRIVE, SUITE 23 SAN DIEGO, CA 92123 TEL(619)618–2347 STRUCTURAL: SUN STRUCTURAL ENGINEERING 2091 LAS PALMAS DRIVE, SUITE D CARLSBAD, CA 92011 TEL(760)438–1188	OWNER: TRI-CITY MEDICAL CENTER 4002 VISTA WAY OCEANSIDE, CALIFORNIA 92056 TEL (760) 940-7709 ARCHITECT: SFEIR ARCHITECTS 5151 SHOREHAM PLACE, SUITE 100 SAN DIEGO, CALIFORNIA 92122 TEL(619)299-3917 FAX(619)299-508 MEP: P2S ENGINEERING, INC. 9665 CHESAPEAKE DRIVE, SUITE 230 SAN DIEGO, CA 92123 TEL(619)618-2347 STRUCTURAL: SUN STRUCTURAL ENGINEERING 2091 LAS PALMAS DRIVE, SUITE D CARLISBAD, CA 92011 TEL(760)438-1188 OKENERSAND OCARLISBAD, CA 92011 TEL(760)438-1188 MEP: OSHPD COMMENTS 0SHPD COMMENTS 10-09-17 3 OSHPD COMMENTS 10-09-17 3 OSHPD COMMENTS 12-11-17 4 DESIGN CHANGES 5-15-18 4-05-18	Inconeir	ta Way	
4002 VISTA WAY OCEANSIDE, CALIFORNIA 92056 TEL (760) 940–7709 ARCHITECT: SFEIR ARCHITECTS 5151 SHOREHAM PLACE, SUITE 100 SAN DIEGO, CALIFORNIA 92122 TEL(619)299–3917 FAX(619)299–5 MEP: P2S ENGINEERING, INC. 9665 CHESAPEAKE DRIVE, SUITE 230 SAN DIEGO, CA 92123 TEL(619)618–2347 STRUCTURAL: SUN STRUCTURAL ENGINEERING 2091 LAS PALMAS DRIVE, SUITE D CARLSBAD, CA 92011 TEL(760)438–1188	4002 VISTA WAY OCEANSIDE, CALIFORNIA 92056 TEL (760) 940–7709 ARCHITECT: SFEIR ARCHITECTS 5151 SHOREHAM PLACE, SUITE 100 SAN DIEGO, CALIFORNIA 92122 TEL(619)299–3917 FAX(619)299–508 MEP: P2S ENGINEERING, INC. 9665 CHESAPEAKE DRIVE, SUITE 230 SAN DIEGO, CA 92123 TEL(619)618–2347 STRUCTURAL: SUN STRUCTURAL ENGINEERING 2031 LAS PALMAS DRIVE, SUITE D CARLSBAD, CA 92011 TEL(760)438–1188 Image: Structure of the structure of t	Oceansic	ie, California 92056	
5151 SHOREHAM PLACE, SUITE 100 SAN DIEGO, CALIFORNIA 92122 TEL(619)299–3917 FAX(619)299–5 MEP: P2S ENGINEERING, INC. 9665 CHESAPEAKE DRIVE, SUITE 230 SAN DIEGO, CA 92123 TEL(619)618–2347 STRUCTURAL: SUN STRUCTURAL ENGINEERING 2091 LAS PALMAS DRIVE, SUITE D CARLSBAD, CA 92011 TEL(760)438–1188 Image: Comparison of the second seco	5151 SHOREHAM PLACE, SUITE 100 SAN DEGO, CALIFORNIA 92122 TEL(619)299–3917 FAX(619)299–508 MEP: P2S ENGINEERING, INC. 9665 CHESAPEAKE DRIVE, SUITE 230 SAN DEGO, CA 92123 TEL(619)618–2347 STRUCTURAL: SUN STRUCTURAL ENGINEERING 2091 LAS PALMAS DRIVE, SUITE D CARLSBAD, CA 92011 TEL(760)438–1188 Image: Construction of the structure of the	OWNER:	4002 VISTA WAY Oceanside, california	
9665 CHESAPEAKE DRIVE, SUITE 23 SAN DIEGO, CA 92123 TEL(619)618–2347 STRUCTURAL: SUN STRUCTURAL ENGINEERING 2091 LAS PALMAS DRIVE, SUITE D CARLSBAD, CA 92011 TEL(760)438–1188	9665 CHESAPEAKE DRIVE, SUITE 230 SAN DIEGO, CA 92123 TEL(619)618–2347 STRUCTURAL: SUN STRUCTURAL ENGINEERING 2091 LAS PALMAS DRIVE, SUITE D CARLSBAD, CA 92011 TEL(760)438–1188	ARCHITECT:	5151 SHOREHAM PLACE SAN DIEGO, CALIFORNIA	92122
2091 LAS PALMAS DRIVE, SUITE D CARLSBAD, CA 92011 TEL(760)438–1188	2091 LAS PALMAS DRIVE, SUITE D CARLSBAD, CA 92011 TEL(760)438–1188	MEP:	9665 CHESAPEAKE DRIV SAN DIEGO, CA 92123	ve, suite 230
$\begin{array}{c c} & & & & & & & & & & & & & & & & & & &$	No. C 28543 Total Image: Construction of the second sec	STRUCTURAL	2091 LAS PALMAS DRIV Carlsbad, ca 92011	
	REV: DESCRIPTION: DATE: P25 Engineering, Inc. 9665 Chesapeake Dr., Suite #2 San Diego, CA 92123	1 OSHPD 2 DESIGN 3 OSHPD 4 DESIGN 5 OSHPD	COMMENTS CHANGES COMMENTS CHANGES COMMENTS	10-09-17 10-09-17 12-11-17 12-11-17 5-15-18
	P2S Engineering, Inc. 9665 Chesapeake Dr., Suite #2 San Diego, CA 92123			
	P2S Engineering, Inc. 9665 Chesapeake Dr., Suite #2 San Diego, CA 92123			
REV: DESCRIPTION: DATE:	P2S Engineering, Inc. 9665 Chesapeake Dr., Suite #2 San Diego, CA 92123		PTION:	
oshpd approval stamp:			P2S Engine 9665 Chesapeak San Diego, CA 9 T 619.618.2347 www.p2seng.co	ering, Inc. (e Dr., Suite #2 (2123 F 619.330.06

 
GENERAL NOTES, LEGEND, SYMBOLS, AND SHEET INDEX

PROJECT TITLE TCMC USP 800

PROJECT # 01667.00 DRAWN BY: FC CHECKED BY



07/31/17 **100% CONSTRUCTION DOCUMENT**




		INTERIOR LUMINA	IRE	SC	HE	DUL	E		
	TYPE	DESCRIPTION	TOTAL V-A	NO.	LAMP: V-A	S TYPE	VOLTAGE	MTG.	REMARKS
	R1 74	RECESSED FLANGED 1X4 CLEANROOM FIXTURE WITH PATTERN 12, 0.125" THICK ACRYLIC LENS, IP65 MINIMUM, COLD ROLLED STEEL HOUSING, DIE-FORMED STEEL OVERLAPPING DOOR, AND WHITE POWDER COAT FINISH. TWO (2) LED MODULES, STANDARD OUTPUT, 4000K. EATON FAIL-SAFE CLMF-12-4-OLS-A12125-LD4-2STD-40-UNV-EDC1	74	-	74	LED	UNV	R	NOTES 1, 2
	R2 38	R	NOTES 1, 2						
3	X1 3	LED EDGE LIT CEILING MOUNTED EXIT SIGN WITH 90-MIN INTEGRAL EMERGENCY BATTERY BACKUP. PROVIDE WITH INTEGRAL BATTERY TEST SWITCH. SIGN LETTER COLOR TO MATCH BUILDING STANDARD. PROVIDE DIRECTION ARROWS AS INDICATED ON DRAWINGS. 3VA,LED,120/277V,UNV, LITHONIA LPP 1-RC-120/277 ELN	3	-	3	LED	UNV	S	
Σ•3	D1 31	RECESSED 4" LED DOWNLIGHT. CLEAR TRIM, SEMI-SPECULAR FINISH. WET LOCATION LISTED, 3500K, 2500 LUMENS. LITHONIA #LDN4-35/25-L04-AR-LSS-MVOLT-WL	31	-	31	LED	UNV	R	
	D2 21	RECESSED 4" LED DOWNLIGHT. CLEAR TRIM, SEMI-SPECULAR FINISH. WET LOCATION LISTED, 3500K, 1500 LUMENS. LITHONIA #LDN4-35/15-L04-AR-LSS-MVOLT-WL	21	-	21	LED	UNV	R	
		GENERAL NOTES:							ABBREVIATIONS:
	1	. ALL LUMINARIES SHALL MATCH EXISTING FIXTURE COLOR TEMPERATURE.							P = PENDANT R = RECESSED S = SURFACE W = WALL PO = POLE
		KEY NOTES:							

KEY NOTES:

PROVIDE COMPLETE WITH ALL MOUNTING HARDWARE REQUIRED FOR A COMPLETE
1. INSTALLATION.
2. REFER TO ARCHITECTURAL PLANS FOR CEILING TYPE.




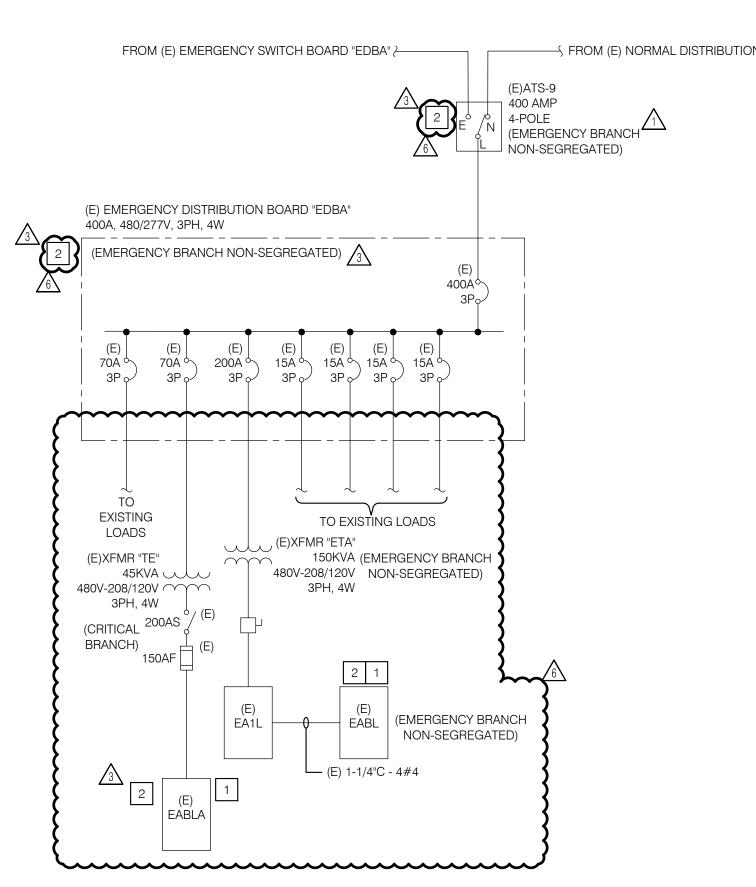



All rights reserved. No part of this work m


PARTIAL SINGLE LINE DIAGRAM

		SFEIF	२ ऽ
ARKS	ILIZE (E) PANEL FOR NEW LOADS.	5151 Shoreham Place, Suite 100 San Diego, Ca 92122	-
	R/ACO INDICATING THAT EXISTING AUTOMATIC ANSFER SWITCH AND DOWNSTREAM DISTRIBUTION IS IN-SEGREGATED EMERGENCY BRANCH.	P: 619-299-3917 F: 619-299-5084 www.sfeirarch.com	_
<u>3</u>		TCMC PHARMACY USP 800	
		UPGRADE	
		Tri-City Medical Cent	ter
I <u>ONS:</u> NT		4002 Vista Way Oceanside, California 92056	_
SED CE		OWNER: TRI-CITY MEDICAL CENTER 4002 VISTA WAY OCEANSIDE, CALIFORNIA 92056 TEL (760) 940-7709 ARCHITECT: SFEIR ARCHITECTS 5151 SHOREHAM PLACE, SUITE 100 SAN DIEGO, CALIFORNIA 92122	
		TEL(619)299-3917 FAX(619)299-508 MEP: P2S ENGINEERING, INC. 9665 CHESAPEAKE DRIVE, SUITE 230 SAN DIEGO, CA 92123 TEL(619)618-2347	4
		STRUCTURAL: SUN STRUCTURAL ENGINEERING 2091 LAS PALMAS DRIVE, SUITE D CARLSBAD, CA 92011 TEL(760)438–1188	
JTION BOARD "DBH"		SED MARCA SED MARCA	
		$ \begin{array}{c c} & & & & & & \\ \hline & & & & \\ \hline \\ \hline$	
		Image: Constraint of the second state of the second sta	
		REV: DESCRIPTION: DATE:	
		P2S Engineering, Inc. 9665 Chesapeake Dr., Suite #23 San Diego, CA 92123 T 619.618.2347 F 619.330.06 www.p2seng.com	
		oshpd approval stamp: OSHPD #: \$171641-37-00	_
		PARTIAL SINGLE LINE	
		DIAGRAM & SCHEDULE	
		PROJECT TITLE: TCMC USP 800 PROJECT #: 01667.00 SHEET NUMBER:	
		DRAWN BY: EC CHECKED BY: RS SCALE: EC	
any means, graphic, electronic, or mechanical, including photocopying, r	recording, taping, or information and retrieval systems without written permission of 14 A O 10 9/0	OF OF CONSTRUCTION DOCUMEN	Ŧ

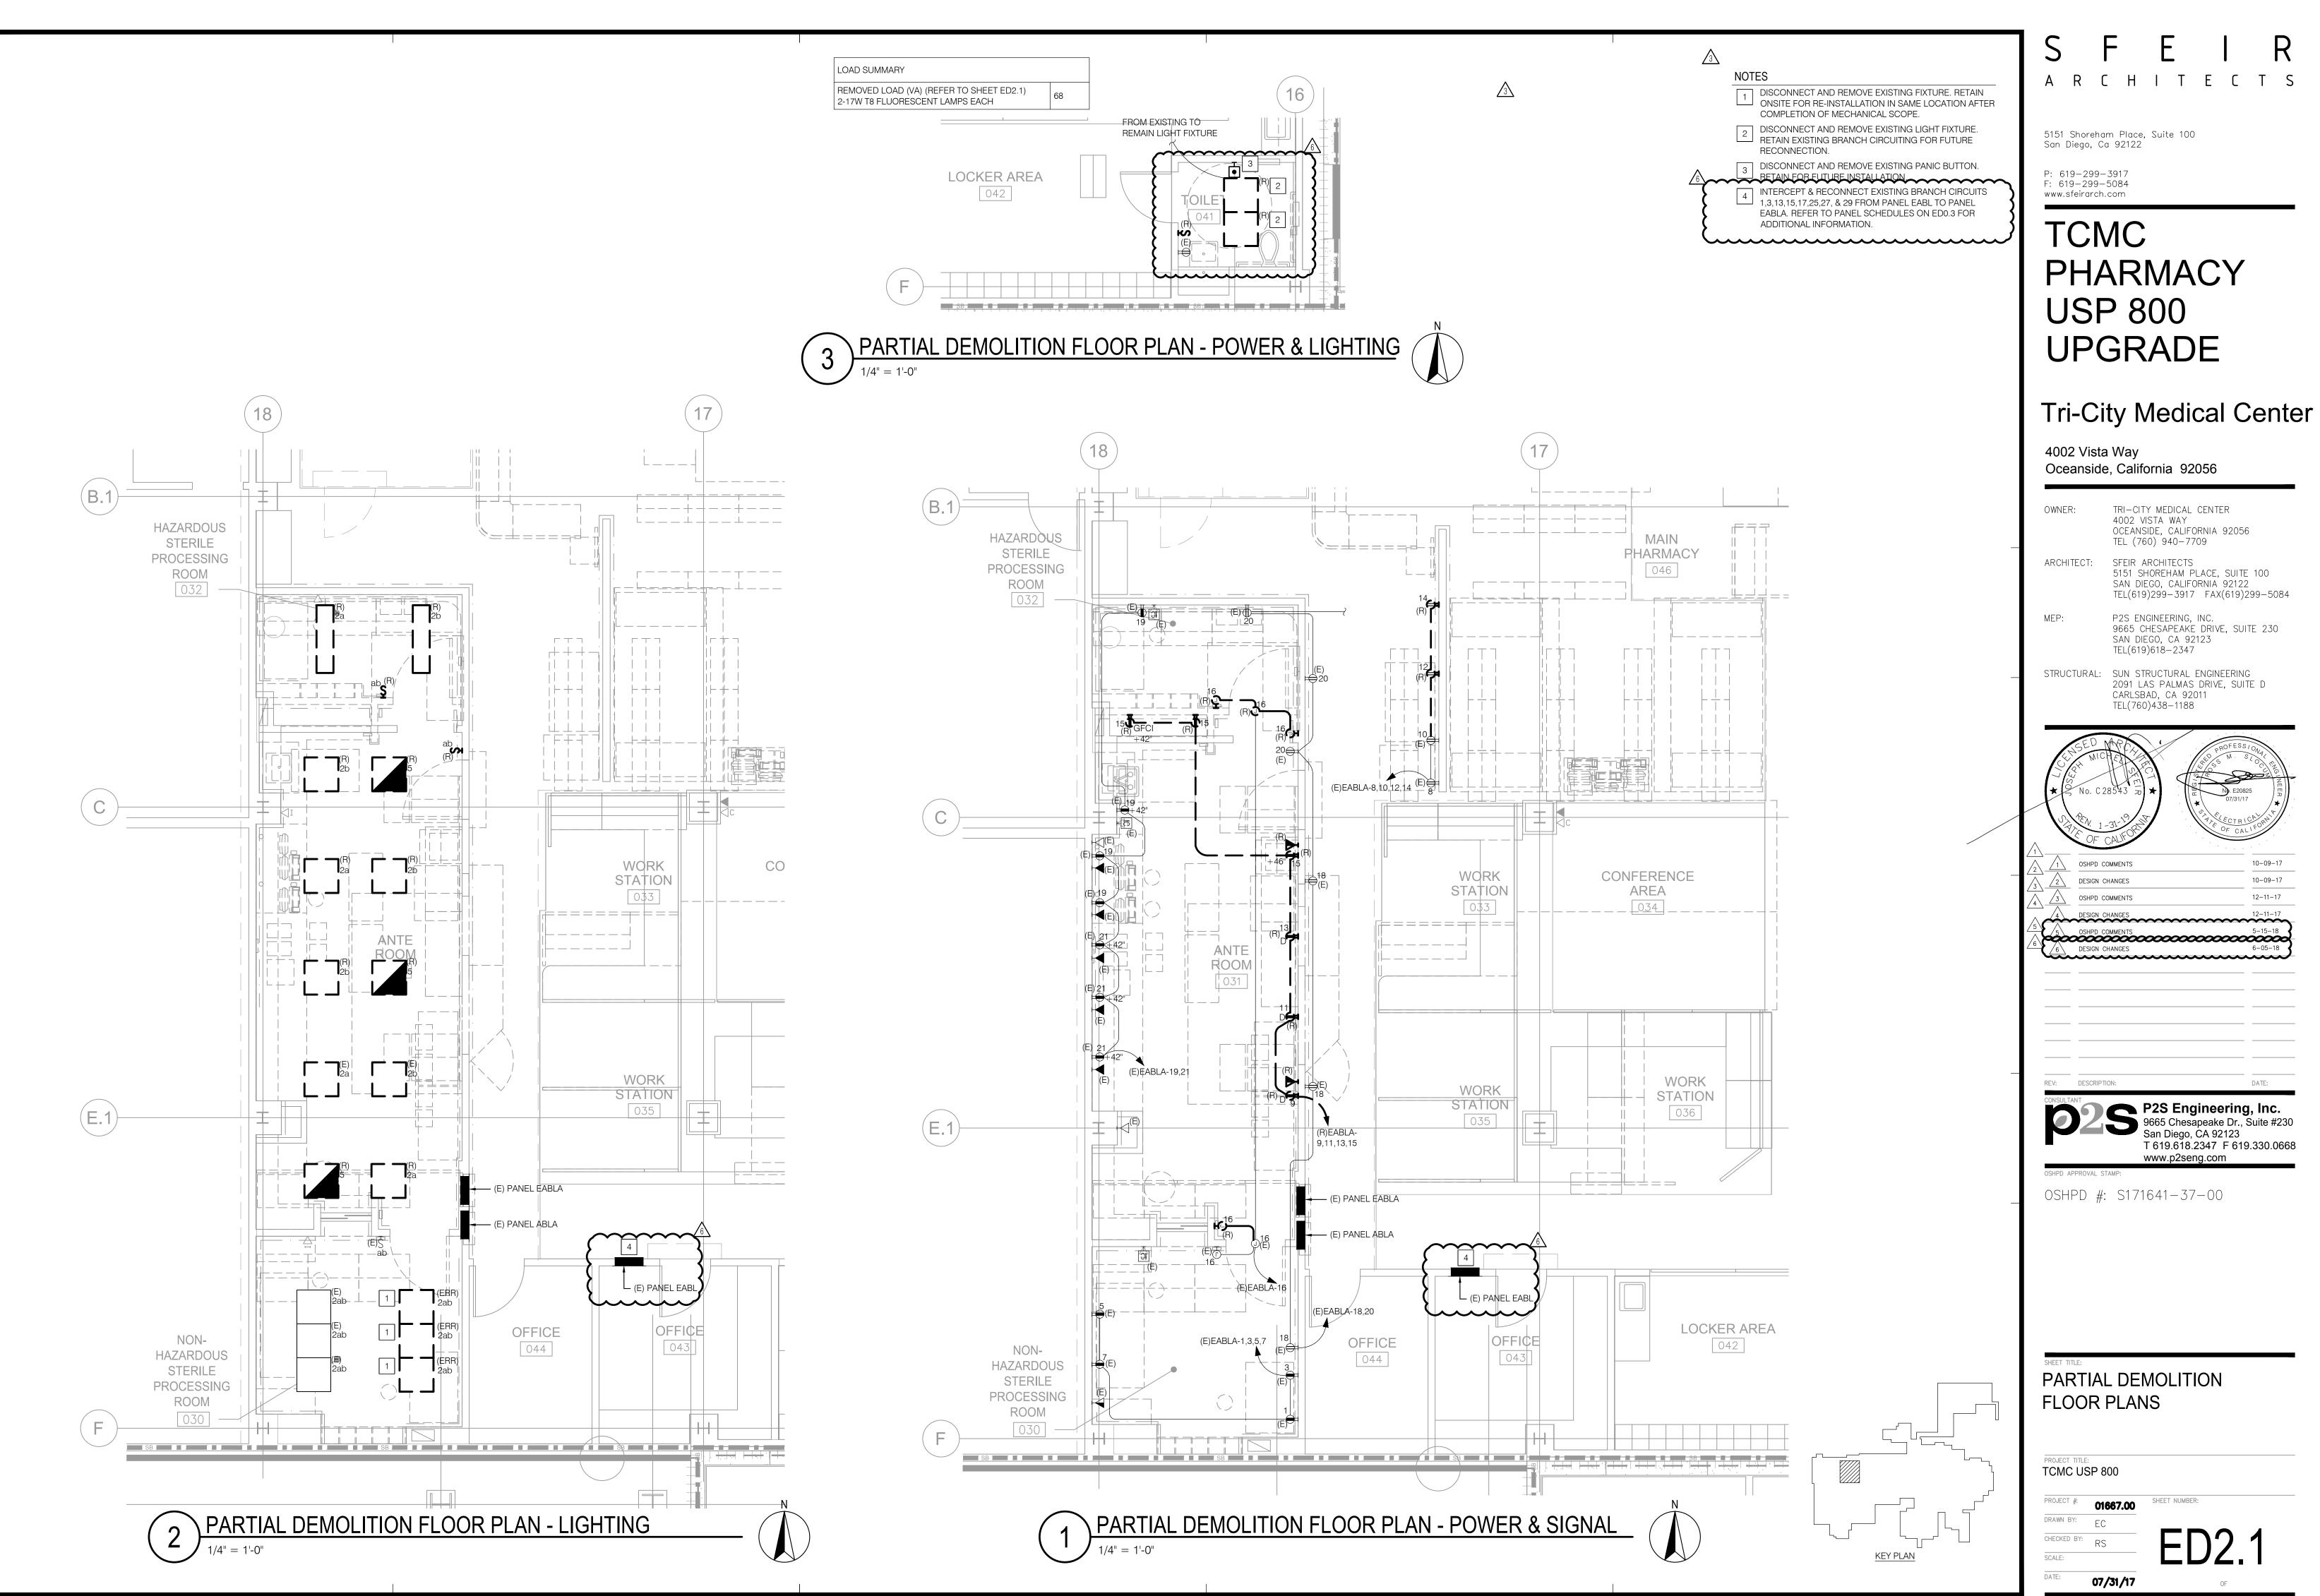

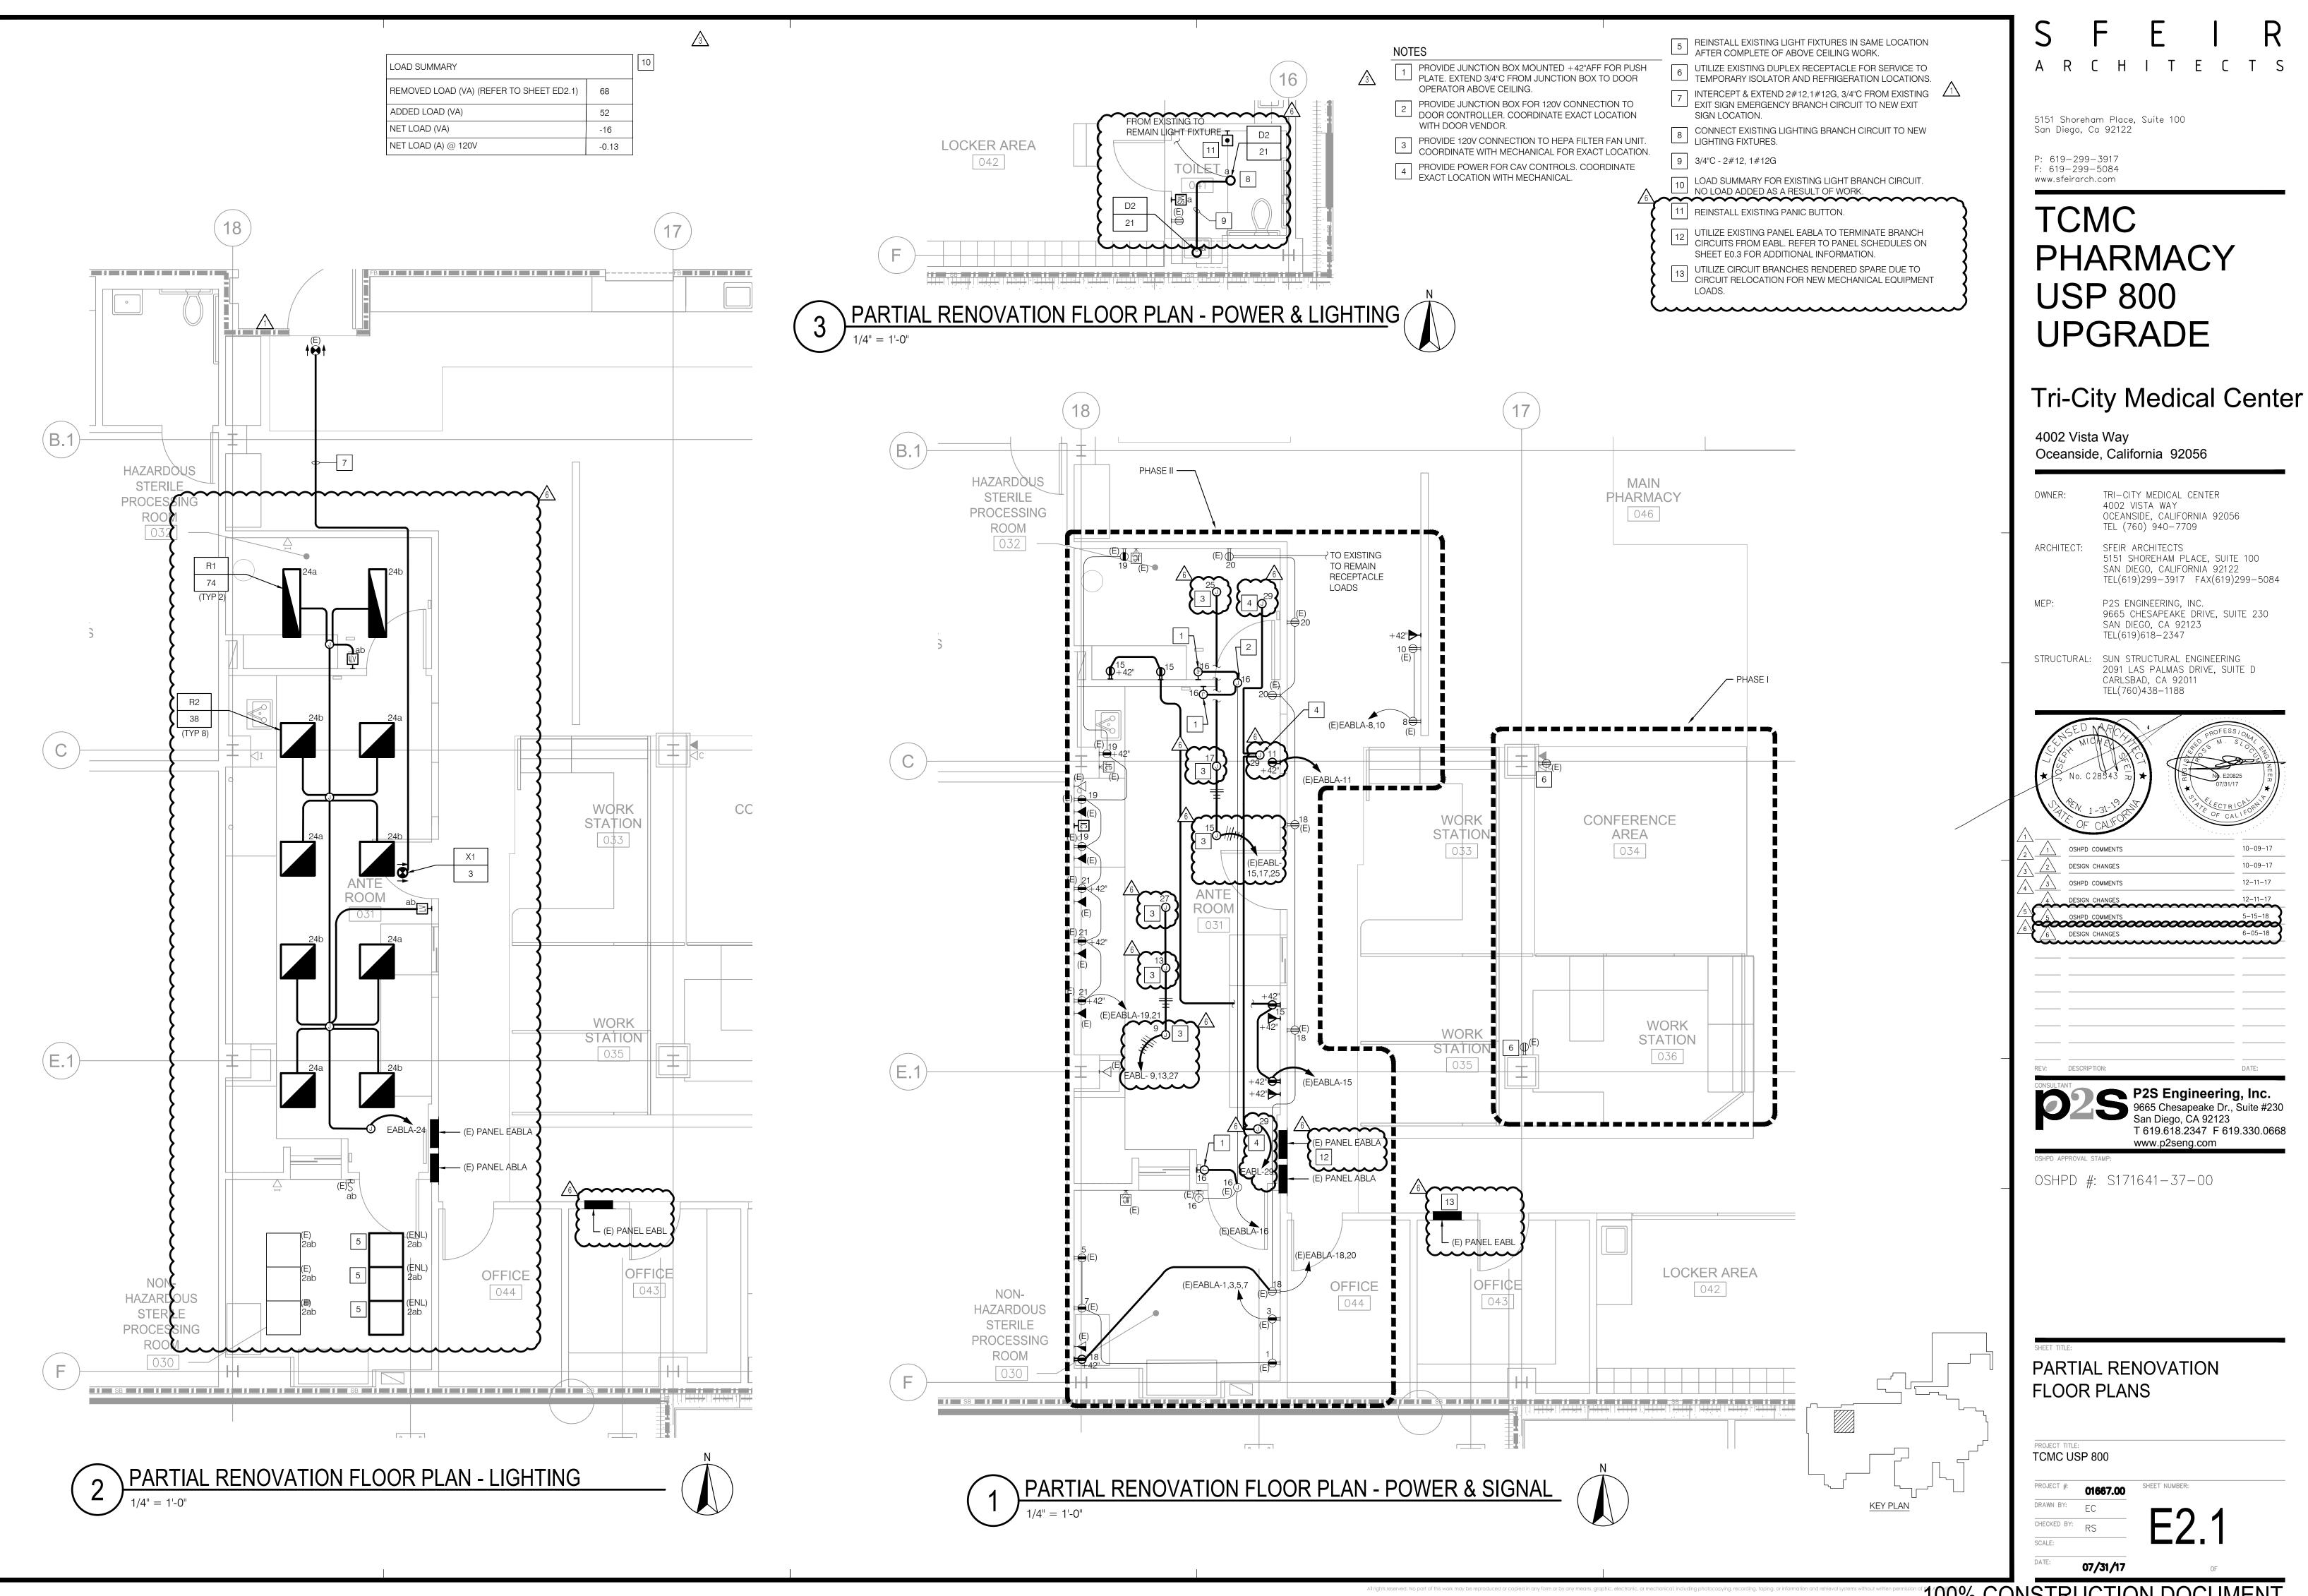

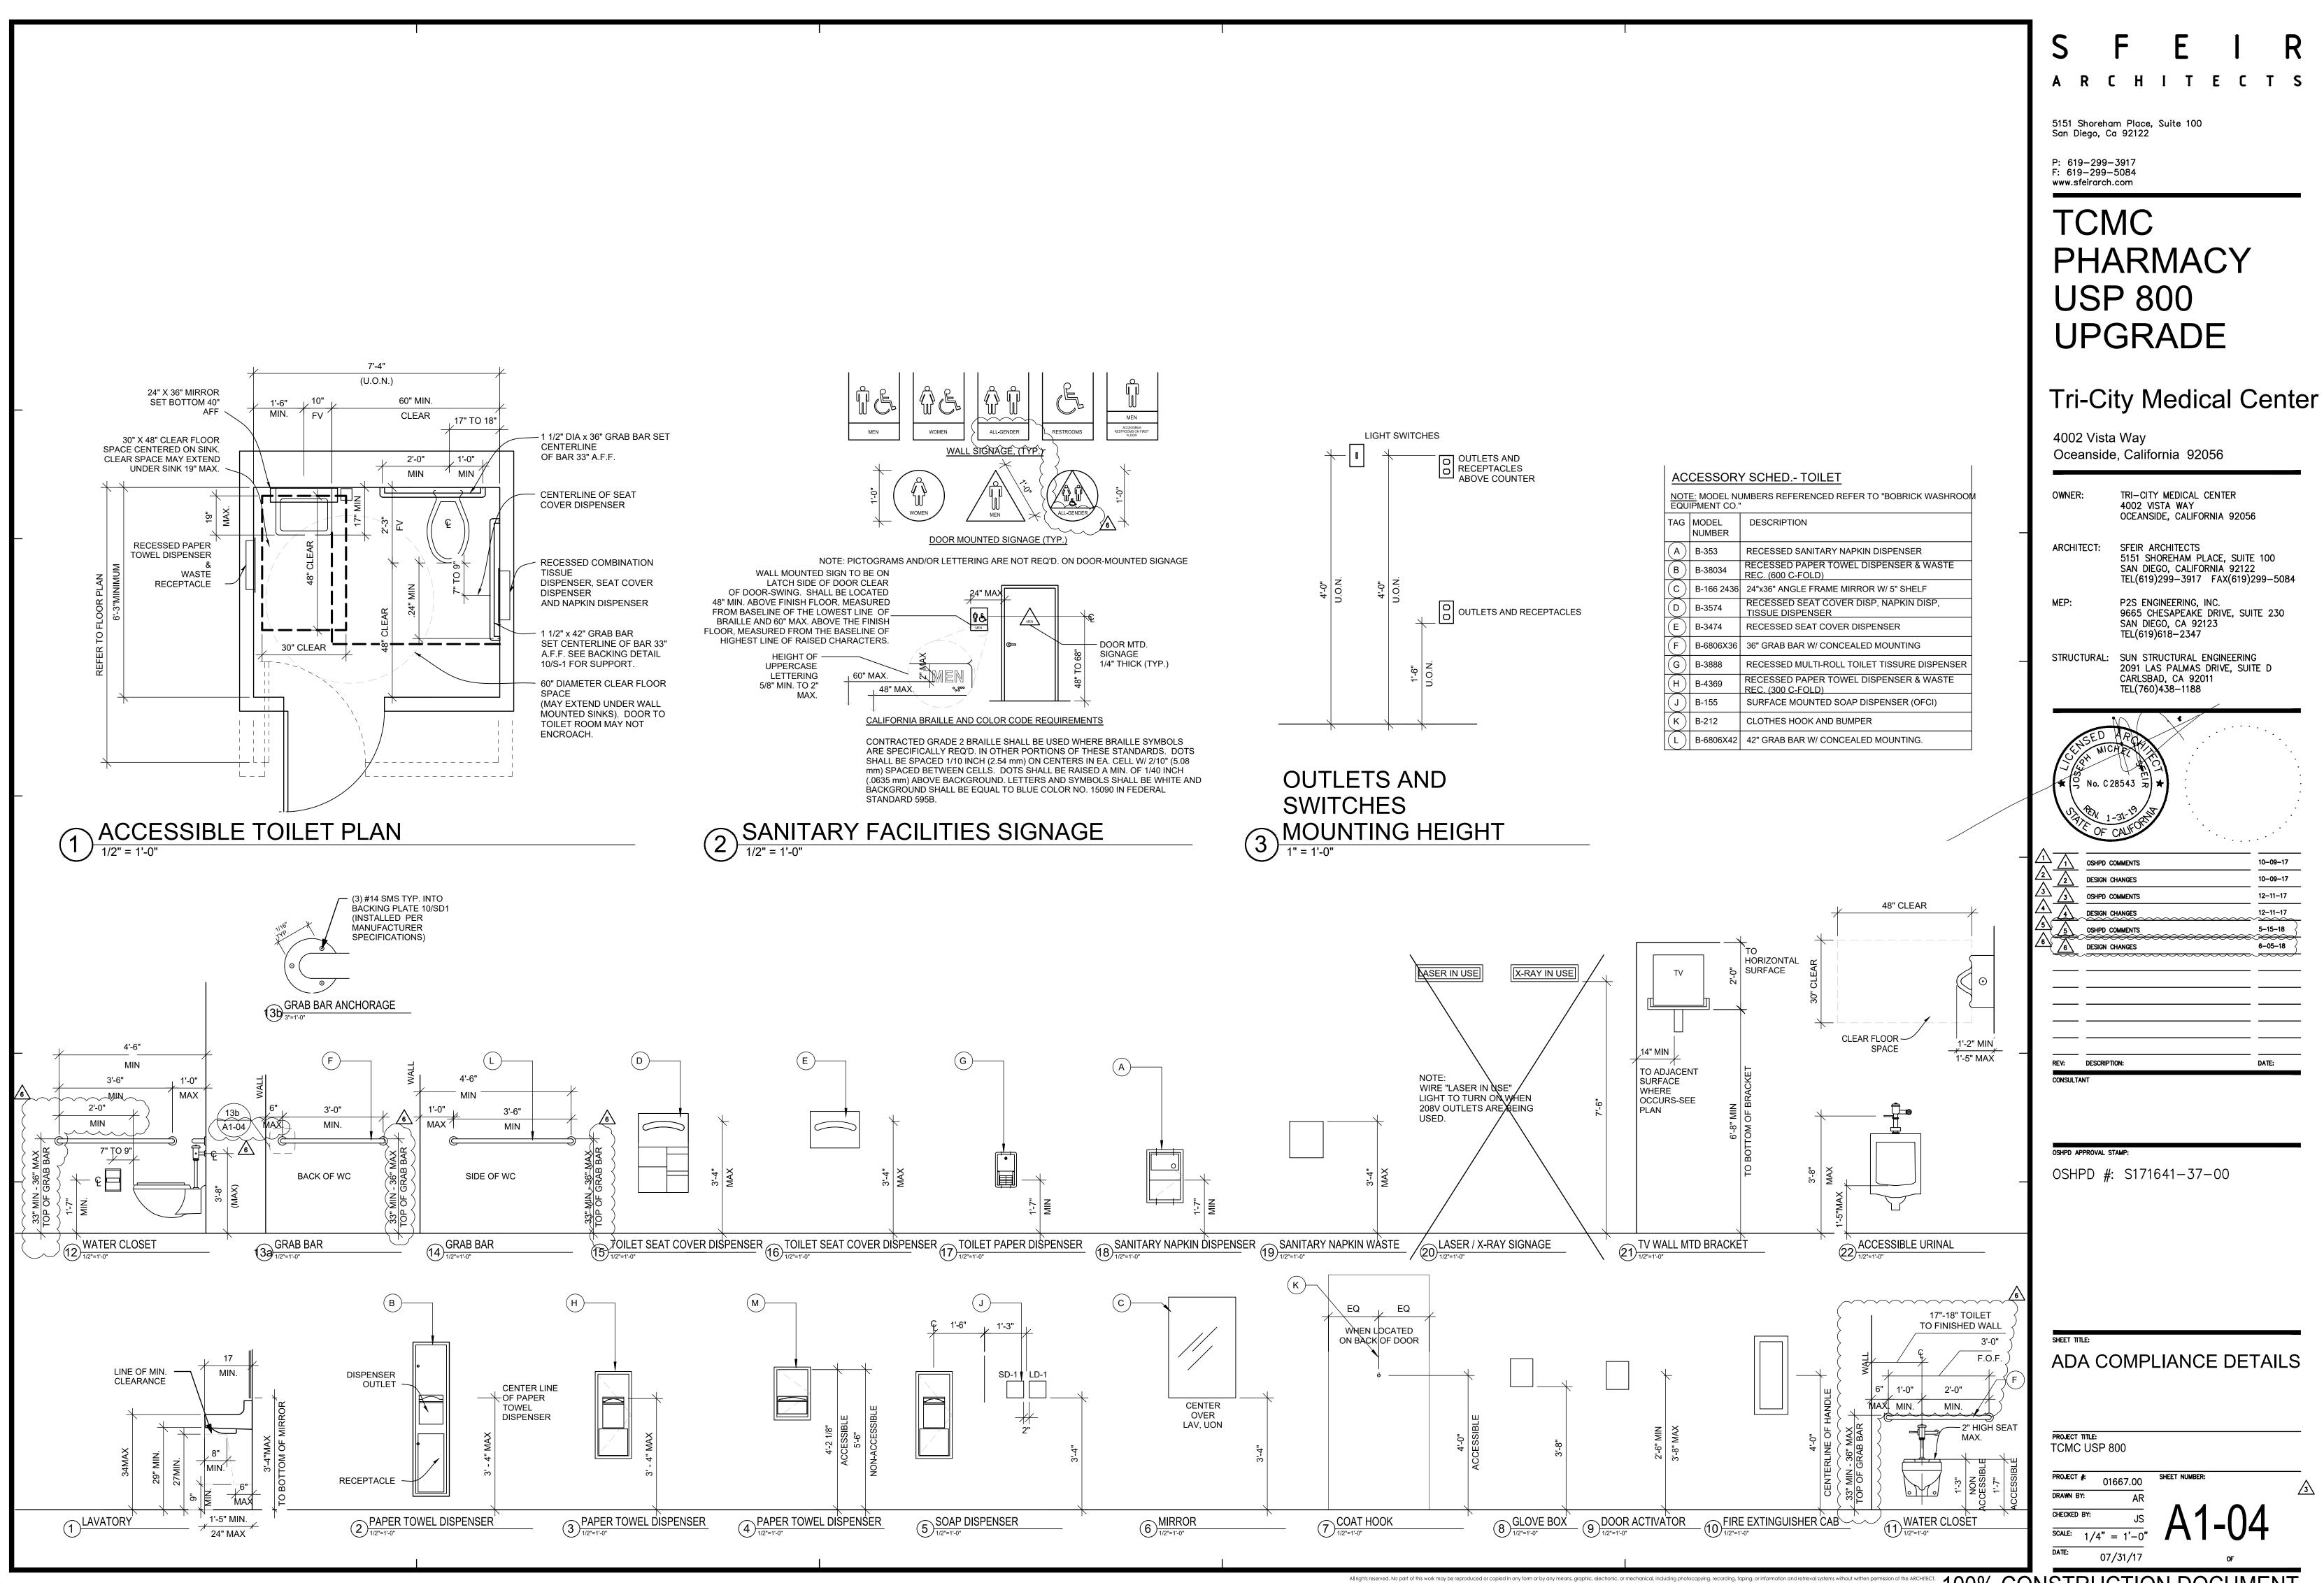

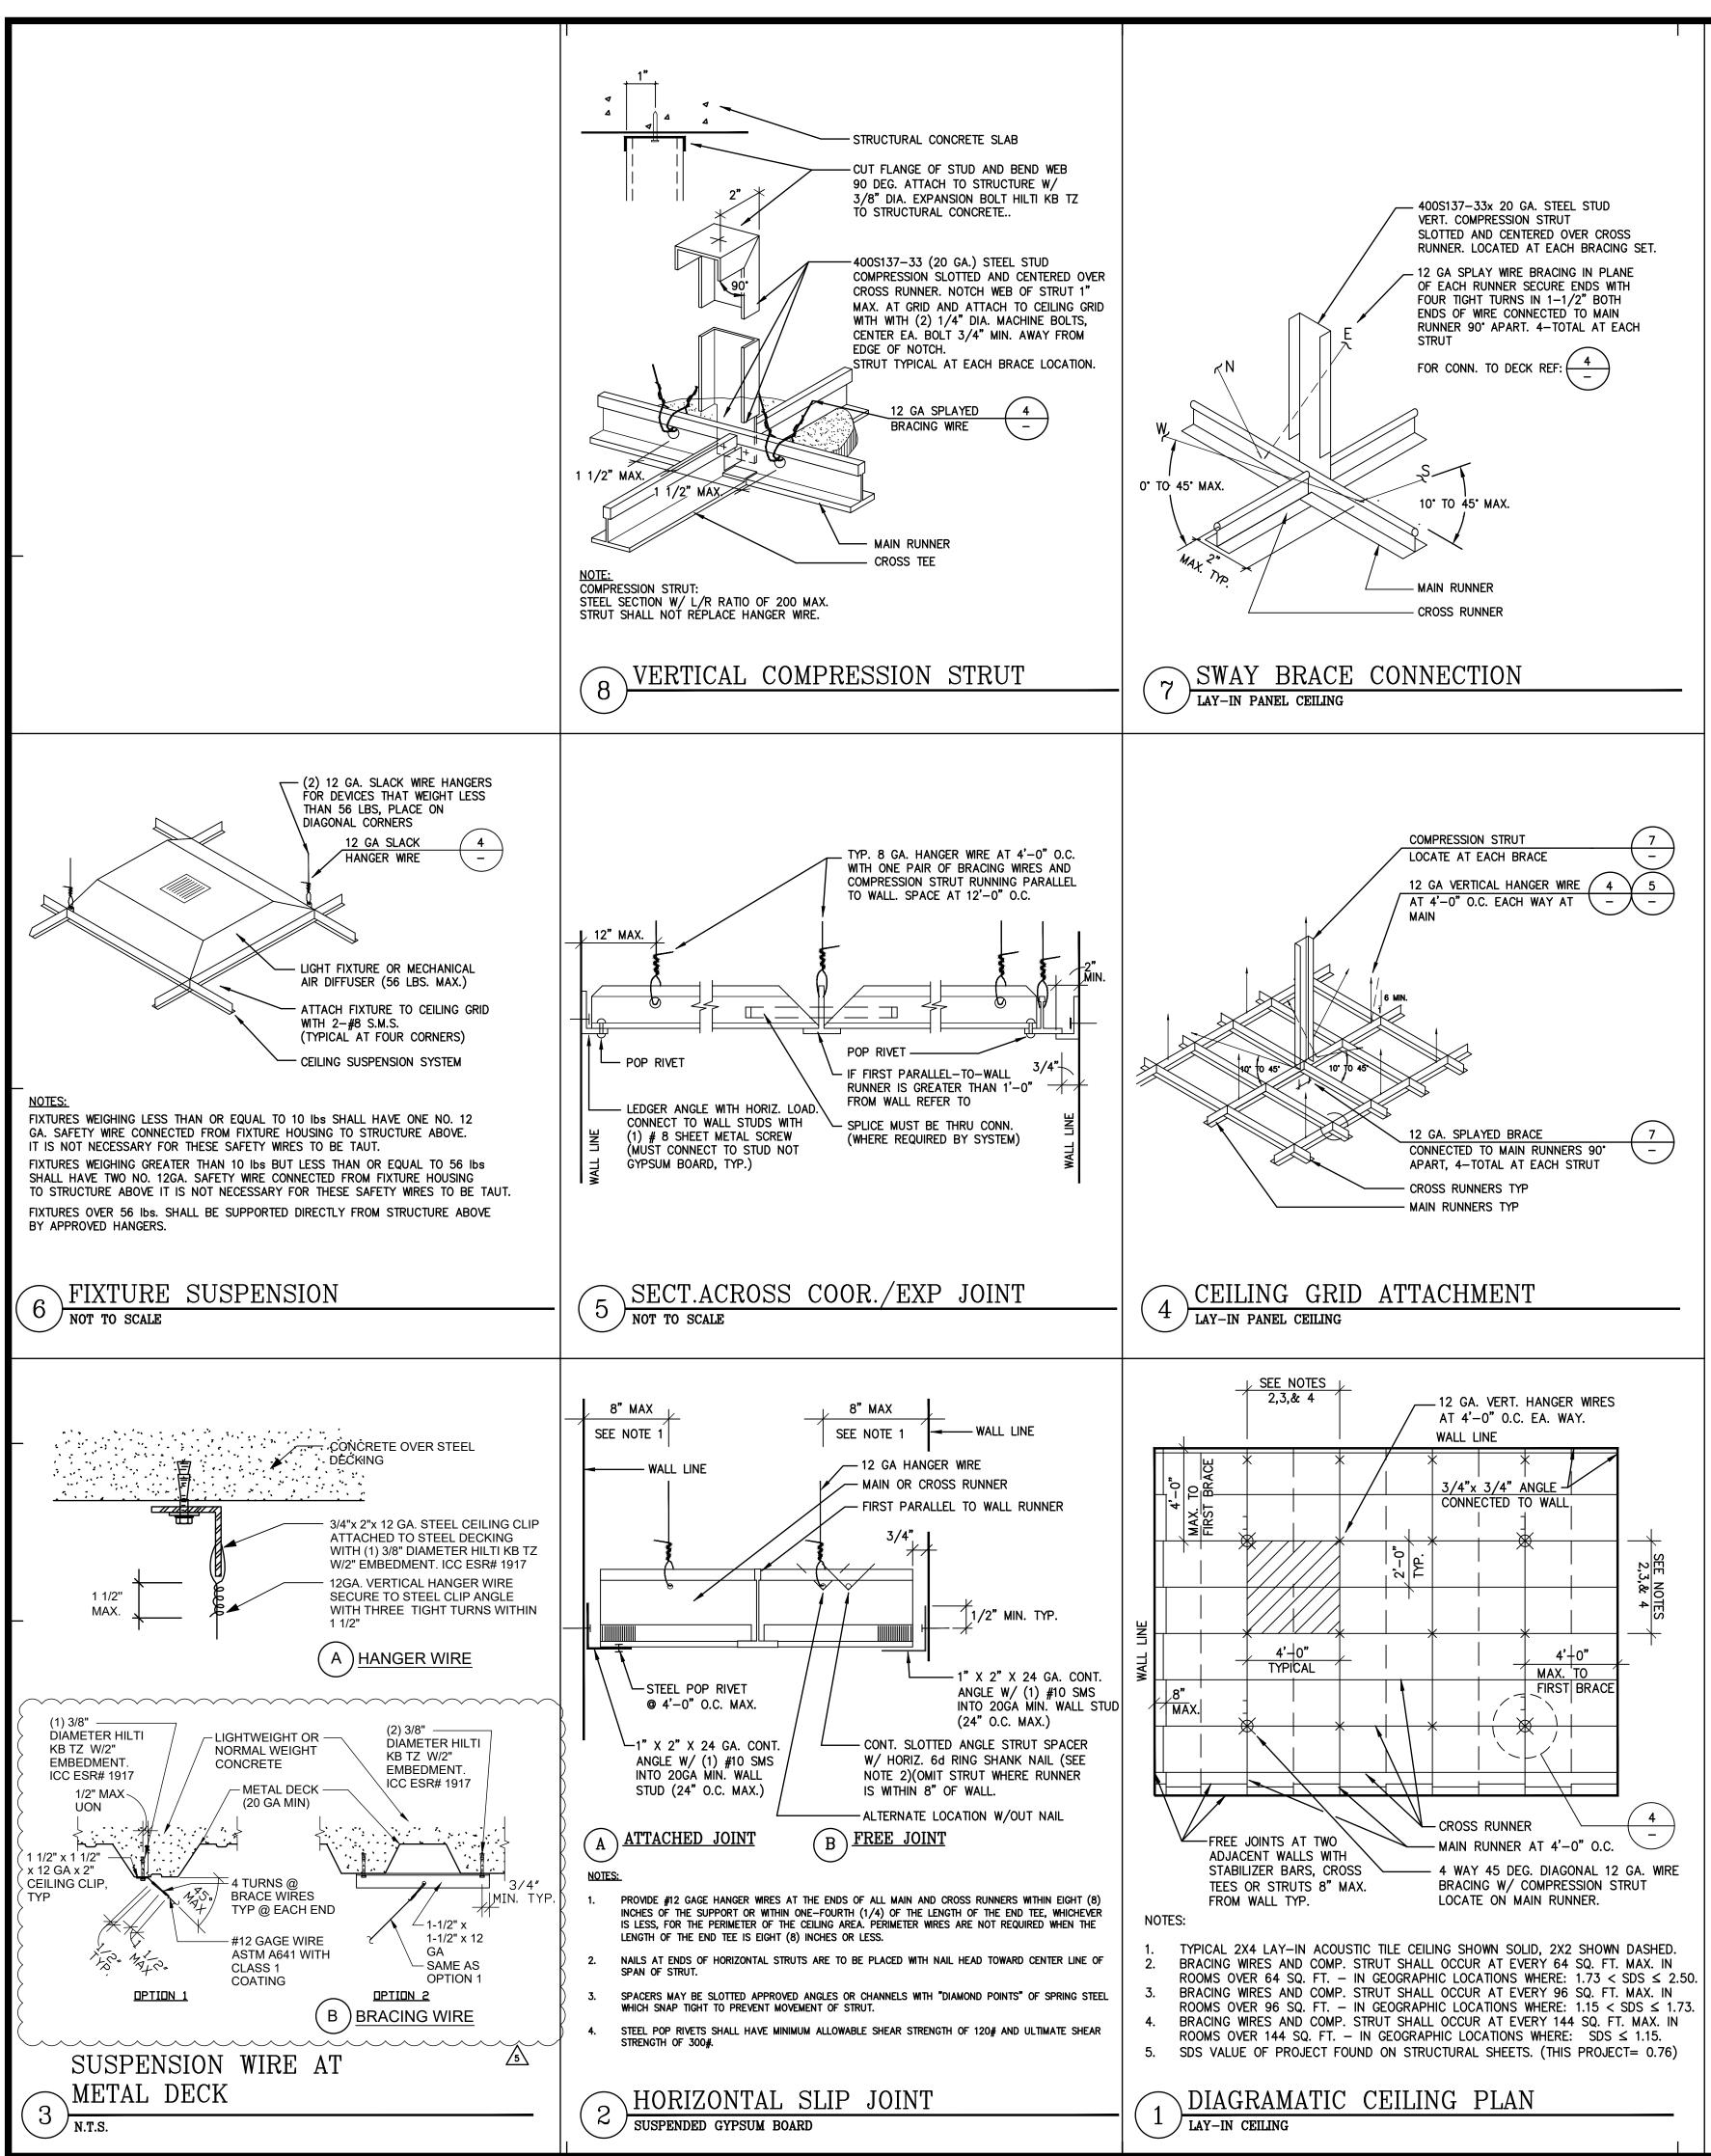

GENERAL NOTES:

- . THE GENERAL CONTRACTOR SHALL VERIFY ALL EXISTING CONDITIONS AND MEASUREMENTS IN THE FIELD PRIOR TO STARTING CONSTRUCTION.
- REFER TO GENERAL NOTES ON SHEET A0-00 FOR INFORMATION NOT INDIC ON THIS SHEET.

GENERAL NOTES:

METAL SUSPENSION SYSTEMS FOR LAY-IN PANEL CEILINGS

- CONSTRUCTION, WORKMANSHIP AND MATERIAL SHALL CONFORM TO THE CALIFORNIA BUILDING STANDARDS CODE (CBSC 2016).
- 2. THE CONTRACTOR SHALL NOTIFY OSHPD AND THE REGISTERED DESIGN PROFESSIONAL (RDP) IN RESPONSIBLE CHARGE WHERE A CONFLICT OR DISCREPANCY OCCURS BETWEEN THE CONSTRUCTION DRAWINGS AND ANY OTHER PORTION OF THE CONSTRUCTION DOCUMENTS, FIELD CONDITIONS, WHERE ANY CONDITIONS ARISE NOT COVERED BY THESE DOCUMENTS WHE WORK WILL NOT COMPLY WITH CODE REQUIREMENTS.
- . THE INTENT OF THE DRAWINGS AND SPECIFICATIONS IS TO CONSTRUCT T HOSPITAL BUILDING IN ACCORDANCE WITH THE CALIFORNIA BUILDING STANDARD CODE, 2016 (CBSC 2016). SHOULD ANY CONDITION DEVELOP I COVERED BY THE APPROVED CONSTRUCTION DOCUMENTS WHEREIN THE W WILL NOT COMPLY WITH CBSC 2016, A CHANGE ORDER DETAILING AND SPECIFYING THE REQUIRED WORK SHALL BE SUBMITTED TO AND APPROVE OSHPD BEFORE PROCEEDING WITH THE WORK.
- 4. GALVANIZED METAL STUDS, TRACKS AND SHEET STEEL SHALL CONFORM STM A653-11 MATERIAL, OR OTHER EQUIVALENT ASTM LISTED MATERIALS SECTION A2.1 OF THE AISI SIOO-07/S2-10; NORTH AMERICAN SPECIFICA FOR THE DESIGN OF COLD-FORMED STEEL STRUCTURAL MEMBERS WITH SUPPLEMENT 2, DATED 2010, WITH A MINIMUM YIELD STRENGTH OF 33 KS FOR 43 MIL (18 GAGE) AND LIGHTER AND MINIMUM YIELD STRENGTH OF 5 KSI FOR HEAVIER GAGES. METAL STUDS AND TRACKS SHALL BE OF SIZE, THICKNESS AND SECTION PROPERTIES SHOWN ON TABLES 1-1, 1-2 AND OF THE AISI MANUAL, COLD-FORMED STEEL DESIGN, 2008 EDITION. THE F IN RESPONSIBLE CHARGE SHALL OBTAIN OSHPD APPROVAL FOR ANY SUBSTITUTIONS.
- ELECTRICAL METALLIC TUBE (EMT) SHALL BE ANSI C80.3/UL 797 CARBO STEEL WITH G90 GALVANIZING. EMT SHALL HAVE MINIMUM YIELD STRENGT (Fy =) 30 KSI AND MINIMUM ULTIMATE STRENGTH OF (Fu =) 48 KSI.
- THESE OPD REFER TO FASTENER TYPE AND SIZE BUT DO NOT SPECIFY OF ENDORSE A SPECIFIC MANUFACTURER. THE RDP IN RESPONSIBLE CHARGE SHALL SELECT A MANUFACTURER AND SELECTED FASTENER CAPACITIES SHALL MATCH OR EXCEED THE STRENGTHS LISTED HEREIN. THE FOLLOWIN REQUIREMENTS SHALL ALSO BE MET:
- SHEET METAL SCREWS SHALL COMPLY WITH ASTM C 1513–10, ASME B18.6.4–98 (R2005) AND ICC–ES AC 118 AND ALLOWABLE STRENGTH SHALL BE BASED ON INFORMATION PROVIDED IN CL1.31 AND CL1.32. PENETRATION OF SCREWS THROUGH JOINED MATERIAL SHALL NOT BE LESS THAN THREE EXPOSED THREADS.
- b. WELDING SHALL BE IN ACCORDANCE WITH AWS D1.3 USING E60XX SERIES ELECTRODES. FIELD WELDING SHALL HAVE SPECIAL INSPECTI ACCORDANCE WITH 2016 CBC SECTION 1705A.2.
- c. POST- INSTALLED ANCHORS (E.G. EXPANSION ANCHORS, SCREW ANCHORS AND POWER ACTUATED FASTENERS) SHALL HAVE SPECIAL INSPECTION AND TESTING IN ACCORDANCE WITH THE 2016 CBC SECTIONS 1705A.3 & 1913A.7. FOR QUALIFICATION, DESIGN AND US POST-INSTALLED ANCHORS IN CONCRETE SEE THE 2016 CBC SECTI 1616A.1.19 AND 1908A.1.1. LISTING OF CURRENT ICC-ES EVALUATIO REPORTS (OR REPORTS FROM OTHER TESTING AGENCIES ACCEPTAB OSHPD) SHALL BE REQUIRED FOR FASTENER USED.

POWER-ACTUATED FASTENERS (PAF), POWDER DRIVEN FASTENERS (PDF), POWER DRIVEN PINS (PDP) AND SHOT PINS ALL REPRESENT THE SAME FASTENER AND WILL HEREAFTER BE REFERRED TO AS POWER ACTUATED FASTENERS (PAF). PAF'S SHALL SATISFY THE CURRENT AC70-ACCEPTANCE CRITERIA FOR FASTENERS POWER-DRIVEN INTO CONCRETE, STEEL AND MASONRY ELEMENTS AND THE 2016 CBC SECTION 1908A.1.1. LISTING OF CURRENT ICC ES EVALUATION REPORTS (OR REPORTS FROM OTHER TESTING AGENCIES ACCEPTABLE TO OSHPD) SHALL BE REQUIRED FOR FASTENERS USED.

e. FOR PAF INSTALLED IN STEEL THE FASTENER PENETRATION SHALL F THE ENTIRE POINTED END OF THE FASTENER DRIVEN THROUGH THE STEEL MEMBER, EXCEPT AS NOTED IN CURRENT REPORTS FROM TES AGENCIES ACCEPTABLE TO OSHPD.

DESIGN CRITERIA a. BUILDING CODE: 2016 CALIFORNIA BUILDING CODE (2016 CBC), ASCI 7-10, AISI S100-07/S2-10, ASTM E580-11b, C635-12, AND C636-

- FOR LOAD COMBINATIONS, ALLOWABLE STRESS DESIGN SHALL BEIN ACCORDANCE WITH 2016 CBC SECTION 1605A.3.1.b. FASTENER CAPACITIES TABLES WERE DEVELOPED BASED ON ICC
- REPORTS BY SEVERAL MANUFACTURERS. c. THE DESIGN ASSUMES THAT BUILDING ELEMENTS AND SUPPORTS, WHICH THE COMPONENTS ADDRESSED IN THIS DOCUMENT ARE ANCHORED, HAVE SUFFICIENT CAPACITY TO CARRY THE LOADS
- IMPOSED BY THE COMPONENTS IN COMBINATION WITH ALL OTHER L EVALUATION OF THE CAPACITY OF THESE SUPPORTING BUILDING ELEMENTS IS BEYOND THE SCOPE OF THE OPD. d. THIS OPD IS LIMITED TO CEILING ASSEMBLIES HAVING MAXIMUM DE/
- WEIGHT OF 4 PSF, INCLUDING LIGHTING FIXTURES (LUMINERIES) AND MECHANICAL SERVICES, EACH WEIGHING LESS THAN 56 LBS AND ATTACHED TO CEILING FRAMING SYSTEM. HEAVIER SYSTEM AND THO SUPPORTING LATERAL FORCES FROM PARTITION WALLS ARE OUTSIDE SCOPE OF THIS OPD AND WILL REQUIRE PROJECT SPECIFIC DESIGN.
- THE RDP IN RESPONSIBLE CHARGE SHALL VERIFY THE FIRE RESISTANCE ACOUSTICAL RATINGS FOR ALL CEILING ASSEMBLIES.
- "CEILING WIRE" SHALL CONFORM WITH GALVANIZED SOFT ANNEALED MILD STEEL WIRE AS DEFINED IN ASTM A641 (CLASS 1 COATING) WITH 70 KSI MINIMUM TENSILE STRENGTH:
- a. FOUR (4) TWISTS OF WIRE WITHIN 1.5" DEVELOPS THE ALLOWABLE
- FOR THE WIRE. b. THREE (3) TWISTS WITHIN 3" MAY BE USED TO DEVELOP THE MAXIN 50% OF ALLOWABLE LOAD.
- SUSPENSION SYSTEM COMPONENTS SHALL COMPLY WITH ASTM C635 AND E580 SECTION 5.1:
 a. THE CEILING GRID SYSTEM SHALL BE RATED HEAVY DUTY AS DEFINITION
- BY ASTM C635.
 HANGER AND BRACING WIRES SHALL BE #12 GAGE (0.106" DIAMETE SOFT ANNEALED, AND GALVANIZED STEEL WIRES WITH CLASS 1 COA THEY MAY BE USED FOR UP TO AND INCLUDING 4'-0"x 4'-0" GRID SPACING ALONG AND ATTACHED TO MAIN RUNNERS. SPLICES ARE NOT STRAIL TO THE AND AND ATTACHED TO MAIN RUNNERS.
- PERMITTED IN ANY HANGER WIRE. c. MAIN RUNNERS AND CROSS RUNNERS ALONG WITH THEIR SPLICES, INTERSECTION CONNECTORS, AND EXPANSION DEVICES SHALL BE DESIGNED AND CONSTRUCTED TO CARRY A MEAN ULTIMATE TEST LOAD OF NOT LESS THAN 180 LBS. IN COMPRESSION & TENS
- SUSPENSION SYSTEM INSTALLATION, SHALL COMPLY WITH ASTM C636 AND

IN ACCORDANCE WITH ASTM 580 SECTION 5.1.2.

- E580 SECTION 5.2: a. PROVIDE #12 GAGE HANGER WIRES AT THE ENDS OF ALL MAIN AND CROSS RUNNERS WITHIN EIGHT (8) INCHES OF THE SUPPORT OR WI ONE-FOURTH (1/4) OF THE LENGTH OF THE END TEE, WHICHEVER I LESS, FOR THE PERIMETER OF THE CEILING AREA. PERIMETER WIRES NOT REQUIRED WHEN THE LENGTH OF THE END TEE IS EIGHT (8) IN OR LESS.
- b. CEILING GRID MEMBERS SHALL BE ATTACHED TO TWO (2) ADJACEN WALLS, IN ACCORDANCE WITH ASTM E580 SECTION 5.2.3. CEILING O MEMBERS SHALL BE AT LEAST 3/4" INCH CLEAR OF OTHER WALLS WALLS RUN DIAGONAL TO THE CEILING GRID SYSTEM RUNNERS, ONE OF MAIN AND CROSS RUNNERS SHOULD BE FREE, AND A MINIMUM 3/4 INCH CLEAR OF WALL.

All rights reserved. No part of this work may be reproduced or copied in any form or by any means, graphi

I	C.	THE WIDTH OF THE PERIMETER SUPPORTING CLOSURE ANGLE SHALL BE NOT LESS THAN TWO (2) INCHES. USE OF ANGLES WITH SMALLER WIDTHS IN CONJUNCTION WITH PERIMETER CLIPS SHALL REQUIRE AN ALTERNATE METHOD OF COMPLIANCE WITH ADEQUATE JUSTIFICATION AND ARE OUTSIDE THE SCOPE OF THIS OPD.	S F E I R
ATED	d.	AT THE PERIMETER OF THE CEILING AREA WHERE MAIN OR CROSS RUNNERS ARE NOT CONNECTED TO THE ADJACENT WALL, PROVIDE INTERCONNECTION BETWEEN THE RUNNERS AT THE FREE END TO PREVENT LATERAL SPREADING. A METAL STRUT OR A #16 GAGE WIRE WITH A POSITIVE MECHANICAL CONNECTION TO RUNNER MAY BE USED. WHERE THE PERPENDICULAR DISTANCE FROM THE WALL TO THE FIRST PARALLEL RUNNER IS EIGHT (8) INCHES OR LESS, THIS	A R C H I T E C T S 5151 Shoreham Place, Suite 100 San Diego, Ca 92122 P: 619-299-3917
2016	12.	INTERCONNECTION IS NOT REQUIRED. EXPANSION JOINTS, SEISMIC SEPARATIONS, AND PENETRATIONS: a. EXPANSION JOINTS SHALL BE PROVIDED IN THE CEILING AT INTERSECTIONS OF CORRIDORS AND AT JUNCTIONS OF CORRIDORS WITH LOBBIES OR OTHER SIMILAR AREAS.	F: 619-299-5084 www.sfeirarch.com
OR EREIN THE NOT VORK ED BY TO A		 b. FOR CEILING AREAS EXCEEDING 2500 SQUARE FEET, A SEISMIC SEPARATION JOINT SHALL BE PROVIDED TO DIVIDE THE CEILING INTO AREAS NOT EXCEEDING 2500 SQ. FT. c. PENETRATIONS THROUGH THE CEILING FOR SPRINKLER HEADS AND OTHER SIMILAR DEVICES THAT ARE NOT INTEGRALLY TIED TO THE CEILING SYSTEM IN THE LATERAL DIRECTION SHALL HAVE A TWO (2) INCH OVERSIZED RING, SLEEVE OR ADAPTER THROUGH THE CEILING TILE TO ALLOW FREE MOVEMENT OF ONE (1) INCH IN ALL HORIZONTAL DIRECTIONS. A FLEXIBLE SPRINKLER HOSE FITTING THAT CAN ACCOMMODATE ONE (1) INCH OF CEILING MOVEMENT SHALL BE PERMITTED TO BE USED IN LIEU OF THE OVERSIZED RING, SLEEVE OR ADAPTER. SUCH FLEXIBLE SPRINKLER HOSE SHALL BE ADEQUATELY SUPPORTED FROM SOFFIT SO AS NOT TO EXCEED THE MAXIMUM TRIBUTARY WEIGHT OF THE CEILING. 	PHARMACY USP 800 UPGRADE
S IN TION	13.	LATERAL FORCE BRACING: LATERAL FORCE BRACING IS REQUIRED IN ACCORDANCE WITH THIS SECTION FOR ALL CEILING AREAS, UON.	Tri-City Medical Center
50 , , RDP		EXCEPTION: LATERAL FORCE BRACING MAY BE OMITTED FOR SUSPENDED ACOUSTICAL CEILING SYSTEMS WITH A CEILING AREA OF 144 SQ. FT. OR LESS, WHEN PERIMETER SUPPORT IN ACCORDANCE WITH ASTM E580 ARE PROVIDED AND PERIMETER WALLS ARE DESIGNED TO CARRY THE CEILING LATERAL	4002 Vista Way Oceanside, California 92056
N TH OF OR		 FORCES. a. PROVIDE LATERAL-FORCE BRACING ASSEMBLIES CONSISTING OF A STRUT AND FOUR (4) #12 GAGE BRACING WIRES ORIENTED 90 DEGREES FROM EACH OTHER. b. LATERAL-FORCE BRACING ASSEMBLIES SHALL BE SPACED IN ACCORDANCE WITH 1/A5-70 FROM EACH WALL AND AT THE EDGES OF - ANY CHANGE OF ELEVATION OF THE CEILING. 	OWNER: TRI-CITY MEDICAL CENTER 4002 VISTA WAY OCEANSIDE, CALIFORNIA 92056 ARCHITECT: SFEIR ARCHITECTS
NG		 c. THE SLOPE OF BRACING WIRES MAY BE FROM 10 TO 45 DEGREES BUT MAY NOT EXCEED 45 DEGREES FROM THE PLANE OF THE CEILING AND WIRES SHALL BE TAUT. d. STRUTS SHALL BE ADEQUATE TO RESIST THE VERTICAL COMPONENT INDUCED BY THE BRACING WIRES, AND SHALL NOT BE MORE THAN 1 (HORIZONTAL) IN 6 (VERTICAL) OUT OF PLUMB. 	MEP: P2S ENGINEERING, INC. 9665 CHESAPEAKE DRIVE, SUITE 230
ION IN	14.	 ATTACHMENT OF HANGER AND BRACING WIRES: a. FASTEN #12 HANGER WIRES WITH NOT LESS THAN THREE (3) TIGHT T URN IN 3 INCHES. HANGER WIRE LOOPS SHALL BE TIGHTLY WRAPPED AND SHARPLY BENT TO PREVENT ANY VERTICAL MOVEMENT OR — ROTATION OF THE MEMBER WITHIN THE LOOPS. b. FASTEN #12 BRACING WIRES WITH FOUR (4) TIGHT TURNS. MAKE ALL 	SAN DIEGO, CA 92123 TEL(619)618–2347 STRUCTURAL: SUN STRUCTURAL ENGINEERING 2091 LAS PALMAS DRIVE, SUITE D CARLSBAD, CA 92011
L SE OF IONS		TIGHT TURNS WITHIN A DISTANCE OF 1 1/2" INCHES. c. HANGER OR BRACING WIRE ANCHORED TO THE STRUCTURE SHOULD BE INSTALLED IN SUCH A MANNER THAT THE DIRECTION OF THE ANCHOR ALIGNS AS CLOSELY AS POSSIBLE WITH THE DIRECTION OF THE WIRE.	TEL(760)438–1188
IUNS IN LE TO		 d. SEPARATE ALL CEILING HANGER AND BRACING WIRES AT LEAST SIX (6) INCHES FROM ALL UNBRACED DUCTS, PIPES CONDUITS, ETC. e. HANGER WIRES SHALL NOT BE ATTACHED TO OR BEND AROUND INTERFERING MATERIAL OR EQUIPMENT. PROVIDE TRAPEZE OR OTHER SUPPLEMENTARY SUPPORT MEMBERS AT OBSTRUCTIONS TO TYPICAL HANGER SPACING. PROVIDE ADDITIONAL HANGERS, STRUTS OR BRACES AS REQUIRED AT ALL CEILING BREAKS, SOFFITS, OR DISCONTINUOUS AREAS. 	× SED P V
HAVE		 f. HANGER WIRES THAT ARE MORE THAN 1 (HORIZONTAL) IN 6 (VERTICAL) OUT OF PLUMB SHALL REQUIRE PROJECT SPECIFIC DESIGN. g. WHEN DRILLED-IN CONCRETE ANCHORS OR PAF ARE USED IN REINFORCED CONCRETE FOR HANGER WIRES, 1 OUT OF 10 WIRE/ ANCHOR ASSEMBLIES SHALL BE FIELD TESTED FOR 200 LBS. IN TENSION. WHEN DRILLED-IN CONCRETE ANCHORS ARE USED FOR BRACING WIRES, 1 OUT OF 2 WIRE/ANCHOR ASSEMBLIES SHALL BE FIELD 	$\frac{1}{2} \frac{1}{2} \frac{1}$
STING	15.	TESTED FOR 440 LBS. CEILING FIXTURES, TERMINALS, AND DEVICES: a. CEILING PANELS SHALL NOT SUPPORT ANY LIGHT FIXTURES, AIR	$\begin{array}{c c} \hline 3 \\ \hline 4 \\ \hline 4 \\ \hline 5 \\ \hline 5$
5–08. 70		 TERMINALS/GRILLS, OR OTHER DEVICES (REFERRED TO ALL BY COMMON TERM FIXTURES HERE AFTER). b. ALL FIXTURES SHALL BE MOUNTED IN A MANNER THAT WILL NOT COMPROMISE CEILING PERFORMANCE. c. ALL FIXTURES SHALL BE ATTACHED TO THE SUSPENDED CEILING SYSTEM BY MECHANICAL MEANS, UNLESS INDEPENDENTLY SUPPORTED. THE ATTACHMENT DEVICE SHALL HAVE THE CAPACITY OF 100% OF FIXTURE 	6 6 05-18 6-05-18
OADS.		 WEIGHT ACTING IN ANY DIRECTION. A MINIMUM OF TWO ATTACHMENT DEVICES ARE REQUIRED FOR EACH FIXTURE. d. SURFACE MOUNTED FIXTURES SHALL BE ATTACHED TO THE MAIN RUNNER WITH POSITIVE CLAMPING DEVICES MADE OF MATERIAL WITH A MINIMUM 14 GAGE. A NO.12 GAUGE SAFETY WIRES SHALL BE ATTACHED BETWEEN THE CLAMPING DEVICE AND TO THE STRUCTURE ABOVE. IN NO 	REV: DESCRIPTION: DATE:
) DSE E THE		 CASE SHALL THE FIXTURES EXCEED THE DESIGN CAPACITY OF THE SUPPORTING MEMBERS. e. ALL FIXTURES WEIGHING LESS THAN OR EQUAL TO 10 LB. SHALL HAVE ONE NO. 12 GAUGE SAFETY WIRE CONNECTED FROM FIXTURE HOUSING TO STRUCTURE ABOVE. IT IS NOT NECESSARY FOR THESE SAFETY 	CONSULTANT
AND		 WIRES TO BE TAUT. f. ALL FIXTURES WEIGHING GREATER THAN 10 LB BUT LESS THAN OR EQUAL TO 56 LB. SHALL HAVE TWO NO. 12 GAUGE SAFETY WIRE CONNECTED FROM FIXTURE HOUSING TO STRUCTURE ABOVE. IT IS NOT NECESSARY FOR THESE SAFETY WIRES TO BE TAUT. g. ALL FIXTURES WEIGHING GREATER THAN 56 LB. SHALL BE SUPPORTED — 	oshpd approval stamp: OSHPD #: S171641—37—00
LOAD MUM		DIRECTLY FROM STRUCTURE ABOVE BY APPROVED HANGERS. h. PENDENT-HUNG FIXTURES SHALL BE SUPPORTED DIRECTLY FROM THE STRUCTURE ABOVE USING NO LESS THAN NO. 9-GAUGE WIRE OR AN APPROVED ALTERNATE SUPPORT. THE CEILING SUSPENSION SYSTEM SHALL NOT PROVIDE ANY DIRECT SUPPORT.	
) IED ER),		i. ALL RECESSED OR DROP-IN FIXTURES SHALL BE SUPPORTED DIRECTLY FROM FIXTURE HOUSING TO THE STRUCTURE ABOVE WITH A MINIMUM OF TWO NO. 12 GAUGE WIRES LOCATED AT DIAGONALLY OPPOSITE CORNERS. LEVELING OR POSITIONING OF FIXTURES MAY BE PROVIDED BY CEILING GRID. FIXTURE SUPPORT WIRES MAY BE SLIGHTLY LOOSE TO ALLOW THE FIXTURE TO SEAT IN THE GRID SYSTEM. FIXTURES SHALL NOT BE CURPORTED FROM MANY PUNNERS OF DROPS OF DUNNERS IN THE MELONIT.	
ATÍNG. D NOT	16.	SUPPORTED FROM MAIN RUNNERS OR CROSS RUNNERS IF THE WEIGHT OF THE FIXTURES CAUSES TOTAL DEAD LOAD TO EXCEED THE DEFLECTION CAPABILITY OF THE CEILING SUSPENSION SYSTEM.	SHEET TITLE:
sion, ID		a. CEILINGS THAT ARE PART OF A FIRE RATED ASSEMBLY: PROVIDE A DETAIL AND DESIGN NUMBER FOR RATED CEILING ASSEMBLIES FROM AN APPROVED TESTING AGENCY. THE COMPONENTS AND INSTALLATION DETAILS CONFORM IN EVERY RESPECT WITH THE LISTED DETAIL AND NUMBER. DETAILS SHALL CLEARLY DEPICT ALL COMPONENTS, INCLUDING INSULATION MATERIALS, FRAMING AND ATTACHMENT OF THE DESIGN SO THAT THE ASSEMBLY CAN BE CONSTRUCTED AND INSPECTED ACCORDINGLY. POP RIVETS, SCREWS, OR OTHER ATTACHMENTS ARE NOT	LAY-IN CEILING DETAILS
ITHIN IS S ARE NCHES T		 ACCEPTABLE UNLESS SPECIFICALLY DETAILED ON THE DRAWINGS AND APPROVED BY APPROVED TESTING AGENCY. b. METAL AND OTHER PANELS: METAL PANELS AND PANELS WEIGHING MORE THAN 1/2 PSF, OTHER THAN MINERAL FIBER ACOUSTICAL TILE, ARE TO BE POSITIVELY ATTACHED TO THE CEILING SUSPENSION RUNNERS. c. BUILDING EXIT WAYS: CEILINGS IN EXIT WAYS SHALL BE INSTALLED IN 	TCMC USP 800 PROJECT #: 01667.00 DRAWN BY: MK
I GRID 5. IF E END OF I		ACCORDANCE WITH SECTION 13.5.6.2.2(1) OF ASCE 7–10 AS AMENDED BY 2016 CBC SECTION 1616A.1.20. SPLICES OR INTERSECTION OF RUNNERS SHALL BE ATTACHED WITH THROUGH CONNECTORS SUCH AS POP RIVETS, SCREWS, PINS, PLATES WITH END TABS OR OTHER APPROVED CONNECTORS.	CHECKED BY: JS SCALE: AS SHOWN DATE: 07/31/17 AS SHOWN
electronic, or med	chanical, inclu	uding photocopying, recording, taping, or information and retrieval systems without written permission of the ARCHITECT.	DNSTRUCTION DOCUMENT

(NON-SEGREGATED)

	(E)EABL													
BUS AMPS MAIN	: 208/120 VOLTS : 100 AMPS : 100A MCB : EMERGENCY BRANCH	3 PHASE, 4 WIRE									A.I.C. RATING : LOCATION : FED FROM : MOUNTING :	PHARMACY 046 EA1L		
											PANEL OPTIONS:			
LOAD TYPE	LOAD SERVED	VOLT-AMPSABC	СКТ	BKR/ POLE	ABC	BKR/ POLE	скт	VC A	DLT-AMP B	s C	LOAD SERVED	LOAD TYPE		_
RECEPTACLE	(E) COMPUTER MED REC.		1	30/2	*	20/1	2				(E) MEDICAL RECORDS			F
	-		3	-	_*_	20/1	4				(E) MEDICAL RECORDS		~	
	(E) MEDICAL RECORDS		5	20/1	*	20/1	6				(E) MEDICAL RECORDS		~	
	(E) HP PRINTER		7	20/1	*	20/1	8				(E) REF		~	~
	(E) SPARE		9	30/1	_ * _	20/1	10				(E) DOOR HOLDERS		3	
	(E) POWER POLE		11	20/1	*	20/1	12				(E) PHARMACY			
1	(R) MEDICAL RECORDS		13		*	20/1	14				(E) PHARMACY		3	
	(R) MEDICAL RECORDS			20/1	_*_	20/1	16				(E) MED REC LOUNGE			
	(R) MEDICAL RECORDS		17		*	20/1	18				(E) PHARMACY		~	
4	(E) PNEUMATIC SYSTEM		19		*	20/1	20				(E) DOOR STRIKE		A	
			21		_*_	20/1	22				(E) SINGLE OUTLET SOUTH WALL			
	(E) DICTATION		23	4	*	20/1	24				(E) REF		•	0000
	(R) MEDICAL RECORDS		25		*	20/1	26				(E) MED REC OFFICE			
	(R) MEDICAL RECORDS		27	+	_*_	20/1	28				(E) OKI PRINTER		. /	2
	(R) MEDICAL RECORDS		27	1	*	20/1	30				(E) SINGLE OUTLET SOUTH WALL		~	
	(N) WEDICAE RECORDS		29	20/1		20/1	30				(E) SINGLE COTLET SCOTT WALL			
													. 7	1
													7	7 2
PANEL CALCULA	TIONS						ΙΟΔΓ	SUMM	ARY					- I
LOAD TYPE:	LOAD (VA)	DEMAND FACTOR		DEMA			PHAS				0.0	KVA		F
RECEPTACLE	0	PER CEC ART. 220.44					PHAS					KVA		l F
LIGHTING	0	125%			0	VA	PHAS	ЕC			0.0	KVA		l r
MOTOR	0	100%			0	VA								ľ
MISC	0	100%				VA	TOTA		IECTED L	OAD	0.0	KVA		
	0	0%				VA			ND LOAI			KVA		
0 ELEVATOR(S)	0	0%				VA			VOLTAG			VOLTS		
0 X-RAY(S)	0	PER CEC ART. 517.73(2	2)					E CAPAC			0%			
25% OF LARGES			,					LAMPS				AMPS		i I

PANEL:	(E)EABL												
	: 208/120 VOLTS	3 PHAS	e, 4 wire	Ξ									A.I.C. RATING : 10kA
BUS AMPS	: 100 AMPS			_									LOCATION : PHARMA
	: 100A MCB												FED FROM : EA1L
BRANCH TYPE	: EMERGENCY BRANCH												MOUNTING : FLUSH
		_								_			PANEL OPTIONS: -
			OLT-AM			BKR/		BKR/	-		OLT-AMP	1996	
LOAD TYPE	LOAD SERVED	A	B	C	CKT		ABC	-		A	B	C	LOAD SERVED LOAD
RECEPTACLE	(E) COMPUTER MED REC.				1	30/2	*	20/1	2	3403340340340			(E) MEDICAL RECORDS
	-	-			3	-	_ * _	20/1	4				(E) MEDICAL RECORDS
	(E) MEDICAL RECORDS				5	20/1	*	20/1	6				(E) MEDICAL RECORDS
]	(E) HP PRINTER				7	20/1	*	20/1	8				(E) REF
MOTOR	(E) FAN FILTER FF-7		1,176		9	20/1	_ * -	20/1	10				(E) DOOR HOLDERS
	(E) POWER POLE				11	20/1	*	20/1	12				(E) PHARMACY
MOTOR	(E) FAN FILTER FF-8	1,176			13	20/1	*	20/1	14				(E) PHARMACY
MOTOR	(E) FAN FILTER FF-3		1,176		15	20/1	- * -	20/1	16				(E) MED REC LOUNGE
MOTOR	(E) FAN FILTER FF-5			1,176	17	20/1	*	20/1	18				(E) PHARMACY
	(E) PNEUMATIC SYSTEM				19	20/1	*	20/1	20				(E) DOOR STRIKE
	(E) DICTATION			, III III III III	21	20/1	- * -	20/1	22				(E) SINGLE OUTLET SOUTH WALL
	(E) DICTATION				23	20/1	*	20/1	24				(E) REF
MOTOR	(E) FAN FILTER FF-2	1,176			25	20/1	*	20/1	26				(E) MED REC OFFICE
MOTOR	(E) FAN FILTER FF-6		1,176		27	20/1	- * -	20/1	28				(E) OKI PRINTER
MOTOR	(E) CAV-1,CAV-2,CAV-4			300	29	20/1	*	20/1	30				(E) SINGLE OUTLET SOUTH WALL
PANEL CALCULAT	FIONS:								LOA	D SUMN	1ARY:		
LOAD TYPE:	LOAD (VA)	DEMAN	ID FACTO	OR		DEMA	ND LOA	AD.	PHA	SE A			2.4 KVA
RECEPTACLE	0	PER CEC ART. 220.44					0	VA	PHA	SE B			3.5 KVA
LIGHTING	0	125%				0	VA	РНА	SE C			1.5 KVA	
MOTOR	7,356	100%					7,356	VA					
MISC	0	100%					VA	тот	AL CONI	NECTED I	OAD	7.4 KVA	
	0	0%						VA			AND LOA		7.7 KVA
0 ELEVATOR(S)	0	0%						VA			E VOLTAC		208 VOLTS
0 X-RAY(S)	0		C ART. 51	7,73(2)				VA	1	RE CAPA			0%
25% OF LARGEST	-						294			EL AMPS			21 AMPS

(DEMOLITION)

(CRITICAL BRANCH)

PANEL: (E)EABLA VOLTAGE: 208/120 VOLTS

3 PHASE, 4 WIRE

		VOLTACE	: 208/120 VOLTS	3 PHASE		-									A.I.C. RATING :	1044
		BUS AMPS	: 225 AMPS	3 PHASE	2, 4 VVIRE	-									LOCATION :	PHAR
			: 150A MCB												FED FROM :	
		BRANCH TYPE	: EMERGENCY BRANCH												MOUNTING : PANEL OPTIONS:	
				V	OLT-AM	ος		BKR/		BKR/	1	V	OLT-AM	PC	PANEL OF HONS:	-
		LOAD TYPE	LOAD SERVED	A	B	C	скт	POLE	ABC				B	C	LOAD SERVED	LO
			(E) LOAD [016] RM 030				1	20/1	*	20/1	2				(E) LOAD	
			(E) LOAD [008] RM 030				3	20/1	_ * _	20/1	4				(E) LOAD	
			(E) LOAD [009] RM 030				5	20/1	*	20/1					(E) LOAD	
			(E) LOAD [023] RM 030				7	20/1	*	20/1	8	1,044			LAB FREEZER [013] RM 046	
3 –			SPARE				9	20/1	_ * _	20/1	10		540		PYXIS SUPPLY [010,011] RM 046	
	1	MISC	REFRIGERATOR [005] RM 031			960	11	20/1	*	20/1	12				MEDICAL RECORDS	
3 –			SPARE				13	20/1	*	20/1					MEDICAL RECORDS	
	1	MISC	U/C REF [006], REC RM 031,032		900		15	****	_ * _	20/1					(E) LOAD	
			(E) LOAD				17	20/1	*	20/1	18			180	(E) LOAD + PRINTER [025]	R
			(E) LOAD [001,002,003] 031,032				19	20/1	*	20/1	20	<u> </u>			(E) LOAD	
			(E) LOAD [018,026,038] RM 032				21	20/1	_ * _	20/1	22				MEDICAL RECORDS	
			(E) LOAD				23	20/1	*	20/1	24			455	LIGHTING RM 031, 032	
7	7 2		MEDICAL RECORDS				25	20/1	*	20/1	26	<u> </u>			(E) LOAD	
	-		(E) LOAD				27	20/1	_ * _	20/1	28				(E) LOAD	
_		_	(E) LOAD				29	20/1	*	15/3	30				(E) BSC FAN @ ROOF	
7	7 1		MEDICAL RECORDS				31	20/1	*	-	32				-	
			(E) LOAD				33	20/2	_ * _	-	34		1		-	
_			(E) LOAD				35	-	*	20/1	36				(E) LOAD	
	7 2		MEDICAL RECORDS				37	20/1	*		38				SPACE	
			SPACE				39		_ * _		40				SPACE	
			SPACE				41		*		42				SPACE	
		PANEL CALCULA	TIONS:						*	,	LOA	D SUMM	1ARY:	<u>^</u>	, , , , , , , , , , , , , , , , , , ,	
		LOAD TYPE:	LOAD (VA)	DEMAN	D FACTO	OR		DEMA		٩D	PHA	SE A			1.0	KVA
		RECEPTACLE	180	PER CEC	CART. 22	0.44			180	VA	PHA	SE B			1.4	KVA
		LIGHTING	455	125%					569	VA	PHA	SE C			1.6	KVA
		MOTOR	0	100%					0	VA						
		MISC	3,444	100%					3,444	VA	TOT	AL CON	NECTED	load	4.1	KVA
			0	0%						VA	TOT	AL DEM	AND LOA	٨D		KVA
		0 ELEVATOR(S)	0	0%						VA			E VOLTA	GE		VOLTS
		0 X-RAY(S)	0	PER CEC	CART. 51	7.73(2)				VA		RE CAPA			0%	
		25% OF LARGES							0	VA	PAN	EL AMPS	5		12	AMPS
		PROJECT NAME:														
		PROJECT #: 2017	-8730													

LOAD SUMMARY: (E)	EABLA			
72-HR METER READING X 1	.25	=	24.7	KVA
DATE OF RECORDING:	(5/9/17 - 5/11/17)			
REMOVED LOAD				
CKT #8		=	0.96	KVA
CKT #9		=	0.54	KVA
CKT #10		=	1.04	KVA
CKT #12		=	1.04	KVA
CKT #13		=	0.96	KVA
CKT #14		=	1.02	KVA
CKT #15		=	0.54	KVA
ADDED LOAD		=	4.2	KVA
TOTAL LOAD (KVA)		=	23	KVA
TOTAL LOAD (A) @	208/120 VOLTS	=	63	A
MAIN BUS RATING / MAIN C		=	150	A

LOAD SUMMARY: (E)DIST BOARD EDBA	
METER RECORDING X 1 25	

METER RECORDING X 1.25 DATE OF RECORDING: (5/9/17 - 5/11/17)

REMOVED LOAD

ADDED LOAD

TOTAL LOAD (KVA)

TOTAL LOAD (A) @ 208/120 VOLTS MAIN BUS RATING / MAIN CB RATING

LOAD SUMMARY: (E)EABL			
72-HR METER READING X 1.25		18.6	KVA
DATE OF RECORDING: (6/19/18 - 6/19/18)			
REMOVED LOAD	=	0.0	KVA
ADDED LOAD	=	7.7	KVA
TOTAL LOAD (KVA)	=	26	KVA
TOTAL LOAD (A) @ 208/120 VOLTS	=	73	А
MAIN BUS RATING / MAIN CB RATING	=	100	Δ

LOAD SUMMARY: (E)DIST BOARD EA1L

METER RECORDING X 1.25 DATE OF RECORDING: (6/19/18 - 6/19/18) REMOVED LOAD

ADDED LOAD

TOTAL LOAD (KVA) TOTAL LOAD (A) @ 208/120 V MAIN BUS RATING / MAIN CB RATING 208/120 VOLTS



		S F E I R A R C H I T E C T S
ING : 10kA ON : PHARMACY 046 OM : EDBA ING : FLUSH ONS: - LOAD TYPE OAD OAD OAD 1046 MISC 1 0AD DRDS OAD I 0AD I 025] RECEPTACLE I 0AD I 0AD I 032 LIGHTING I 0AD I 1 7	 NOTES UTILIZE (E) 20A, 1P CIRCUIT BREAKER FOR NEW LOADS. PROVIDE NEW 20A, 1P CIRCUIT BREAKER IN EXISTING SPACE, MANUFACTURER AND KAIC RATING SHALL MATCH custing. CIRCUIT BREAKER RENDERED SPARE AS RESULT OF work. PROVIDE NEW 20A, 2P CIRCUIT BREAKER IN EXISTING SPACE, MANUFACTURER AND KAIC RATING SHALL MATCH custing. PROVIDE NEW 20A, 2P CIRCUIT BREAKER IN EXISTING SPACE, MANUFACTURER AND KAIC RATING SHALL MATCH custing. PROVIDE NEW 20A, 2P CIRCUIT BREAKER IN EXISTING SPACE, MANUFACTURER AND KAIC RATING SHALL MATCH custing. PROVIDE NEW 20A, 2P CIRCUIT BREAKER IN EXISTING SPACE, MANUFACTURER AND KAIC RATING SHALL MATCH custing. PROVIDE NEW 20A, 2P CIRCUIT BREAKER IN EXISTING SHALL MATCH custing. PROVIDE NEW 20A, 2P CIRCUIT BREAKER IN EXISTING SHALL MATCH custing. PROVIDE NEW 20A, 2P CIRCUIT BREAKER IN EXISTING SHALL MATCH custing. PROVIDE NEW 20A, 2P CIRCUIT BREAKER IN EXISTING SHALL MATCH custing. PROVIDE NEW 20A, 2P CIRCUIT BREAKER WITH NEW 20A, 1P CIRCUIT BREAKER, MANUFACTURER AND KAIC RATING SHALL MATCH EXISTING 2#12, 1#12, 3/4"C FROM CEILING SHALL AND CHALL BABLA. PROMINATE EXISTING 2#12, 1#12, 3/4"C FROM CEILING SHALL AND CHALL BABLA. 	5151 Shoreham Place, Suite 100 San Diego, Ca 92122P: 619-299-3917 F: 619-299-5084 www.sfeirarch.comTCOMPACT TCOMPACATIONTOMPACATIONTOMPACATIONDATA TONDATIONDATA TONDATIONDATA TONDATIONDATA TONDATIONDATA PRACTIONDATA TONDATIONDATA <br< th=""></br<>
OAD OAD - - <td></td> <td><section-header><section-header><form></form></section-header></section-header></td>		<section-header><section-header><form></form></section-header></section-header>
		SHEET TITLE: PANEL SCHEDULES & LOAD SUMMARIES PROJECT TITLE: TCMC USP 800 PROJECT # CHECKED BY: EC CHECKED BY: RS SCALE: DTE: 07/31/17